



3 1 街区 画地出来形確認図 (5,659.92㎡)

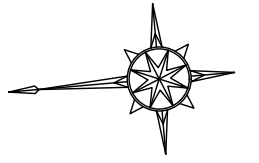

S=1:500

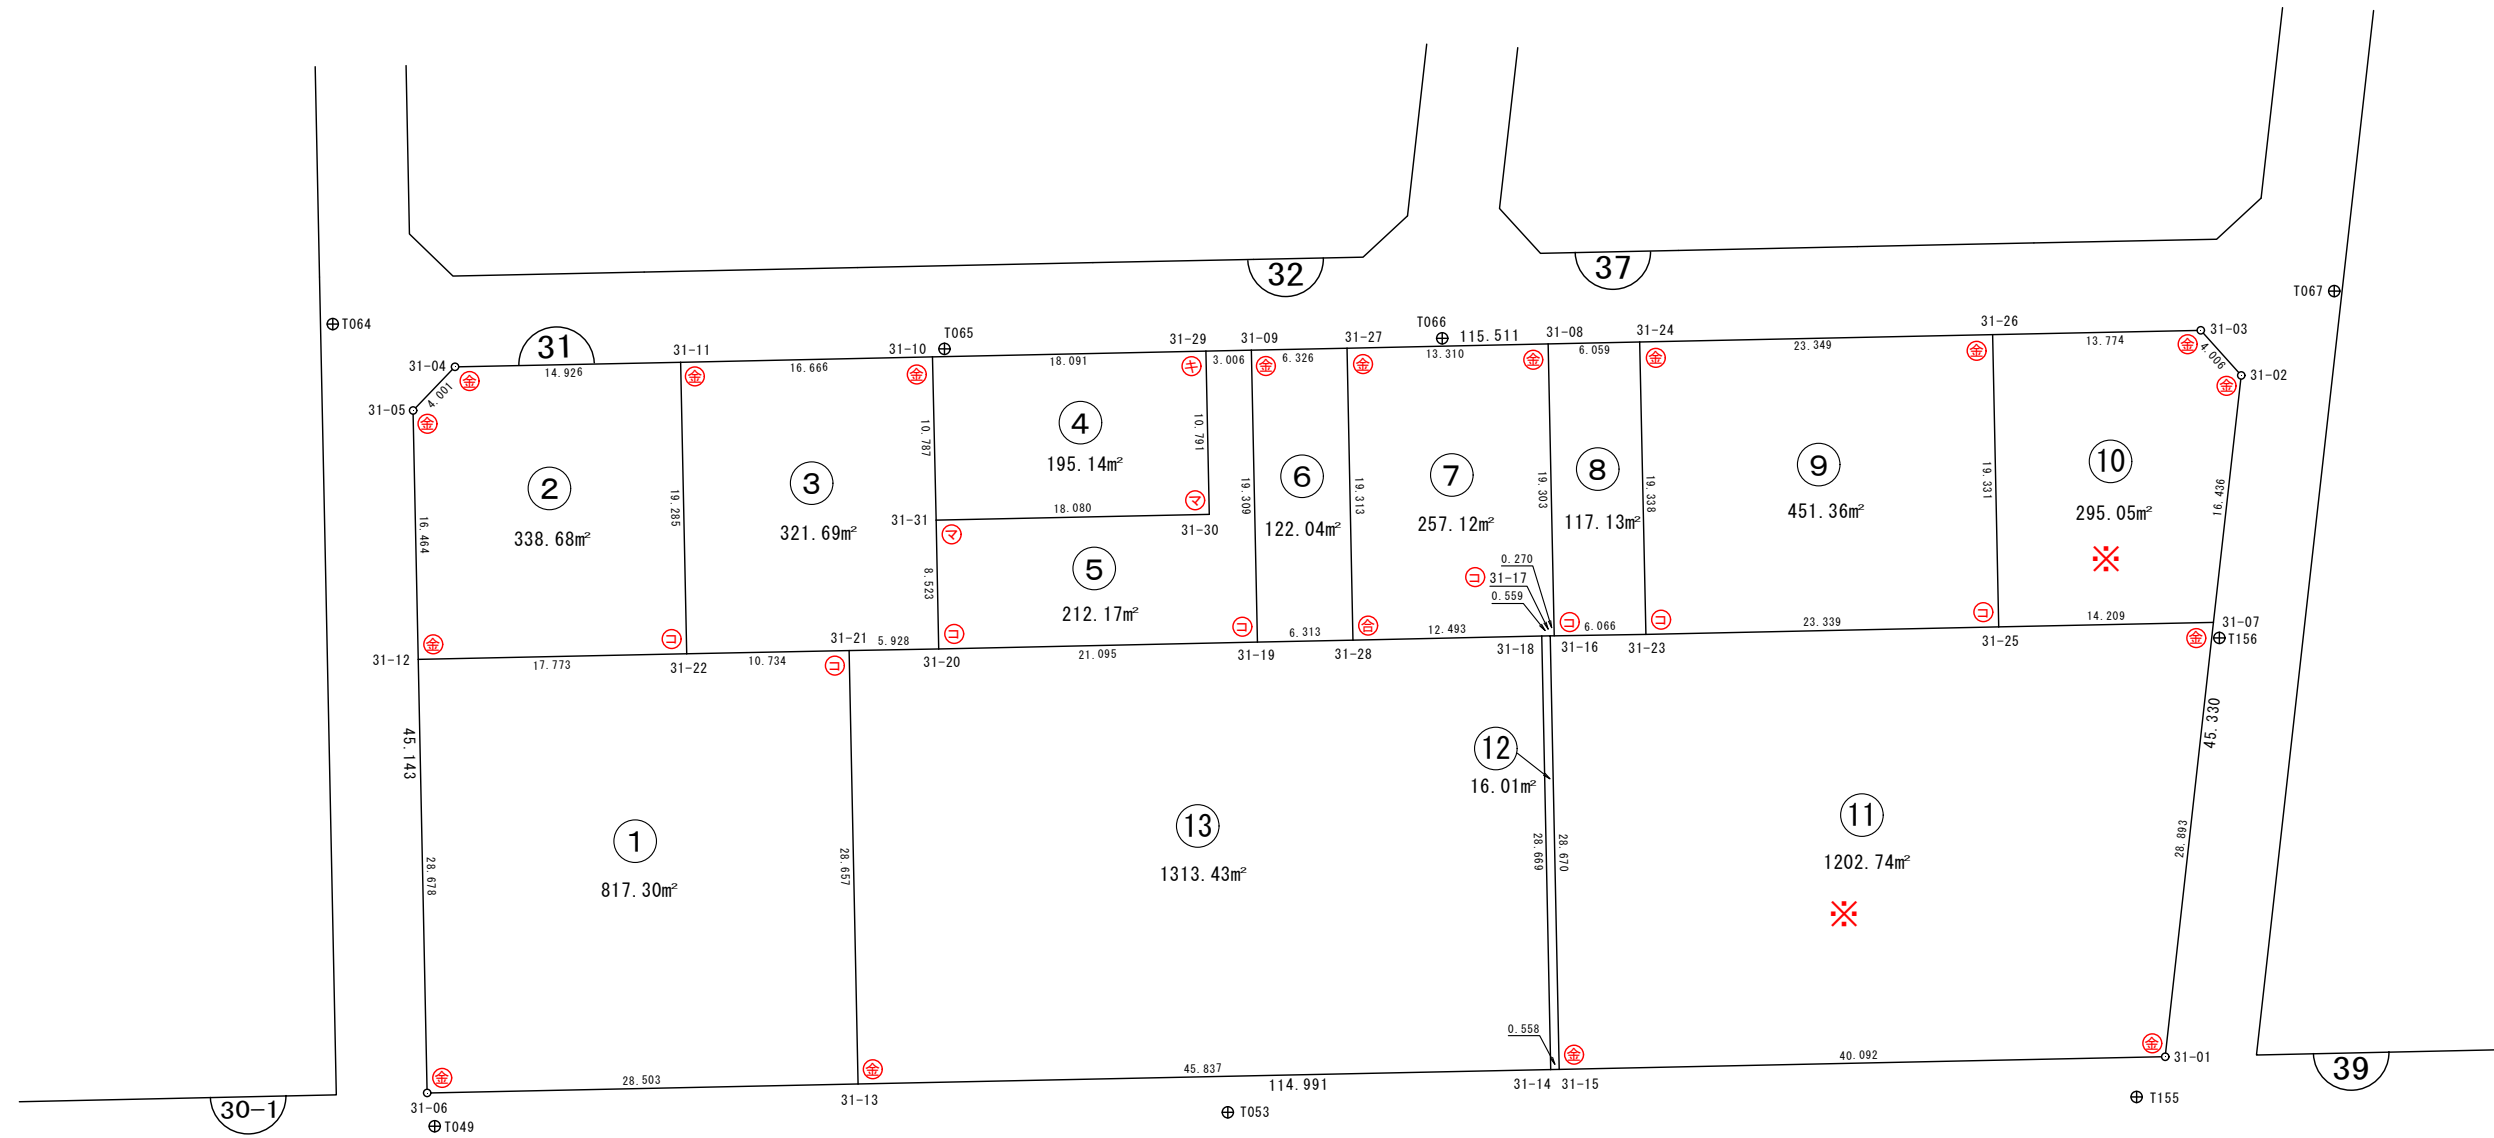


※⑩、⑪画地は分筆しています。次ページで確認してください。

凡 例	
事 項	記 号
金属プレート	⊕
コンクリート杭	⊖
金属板	⊗
合成樹脂杭	⊙
マーキング	⊚
キザミ	⊛



1:500

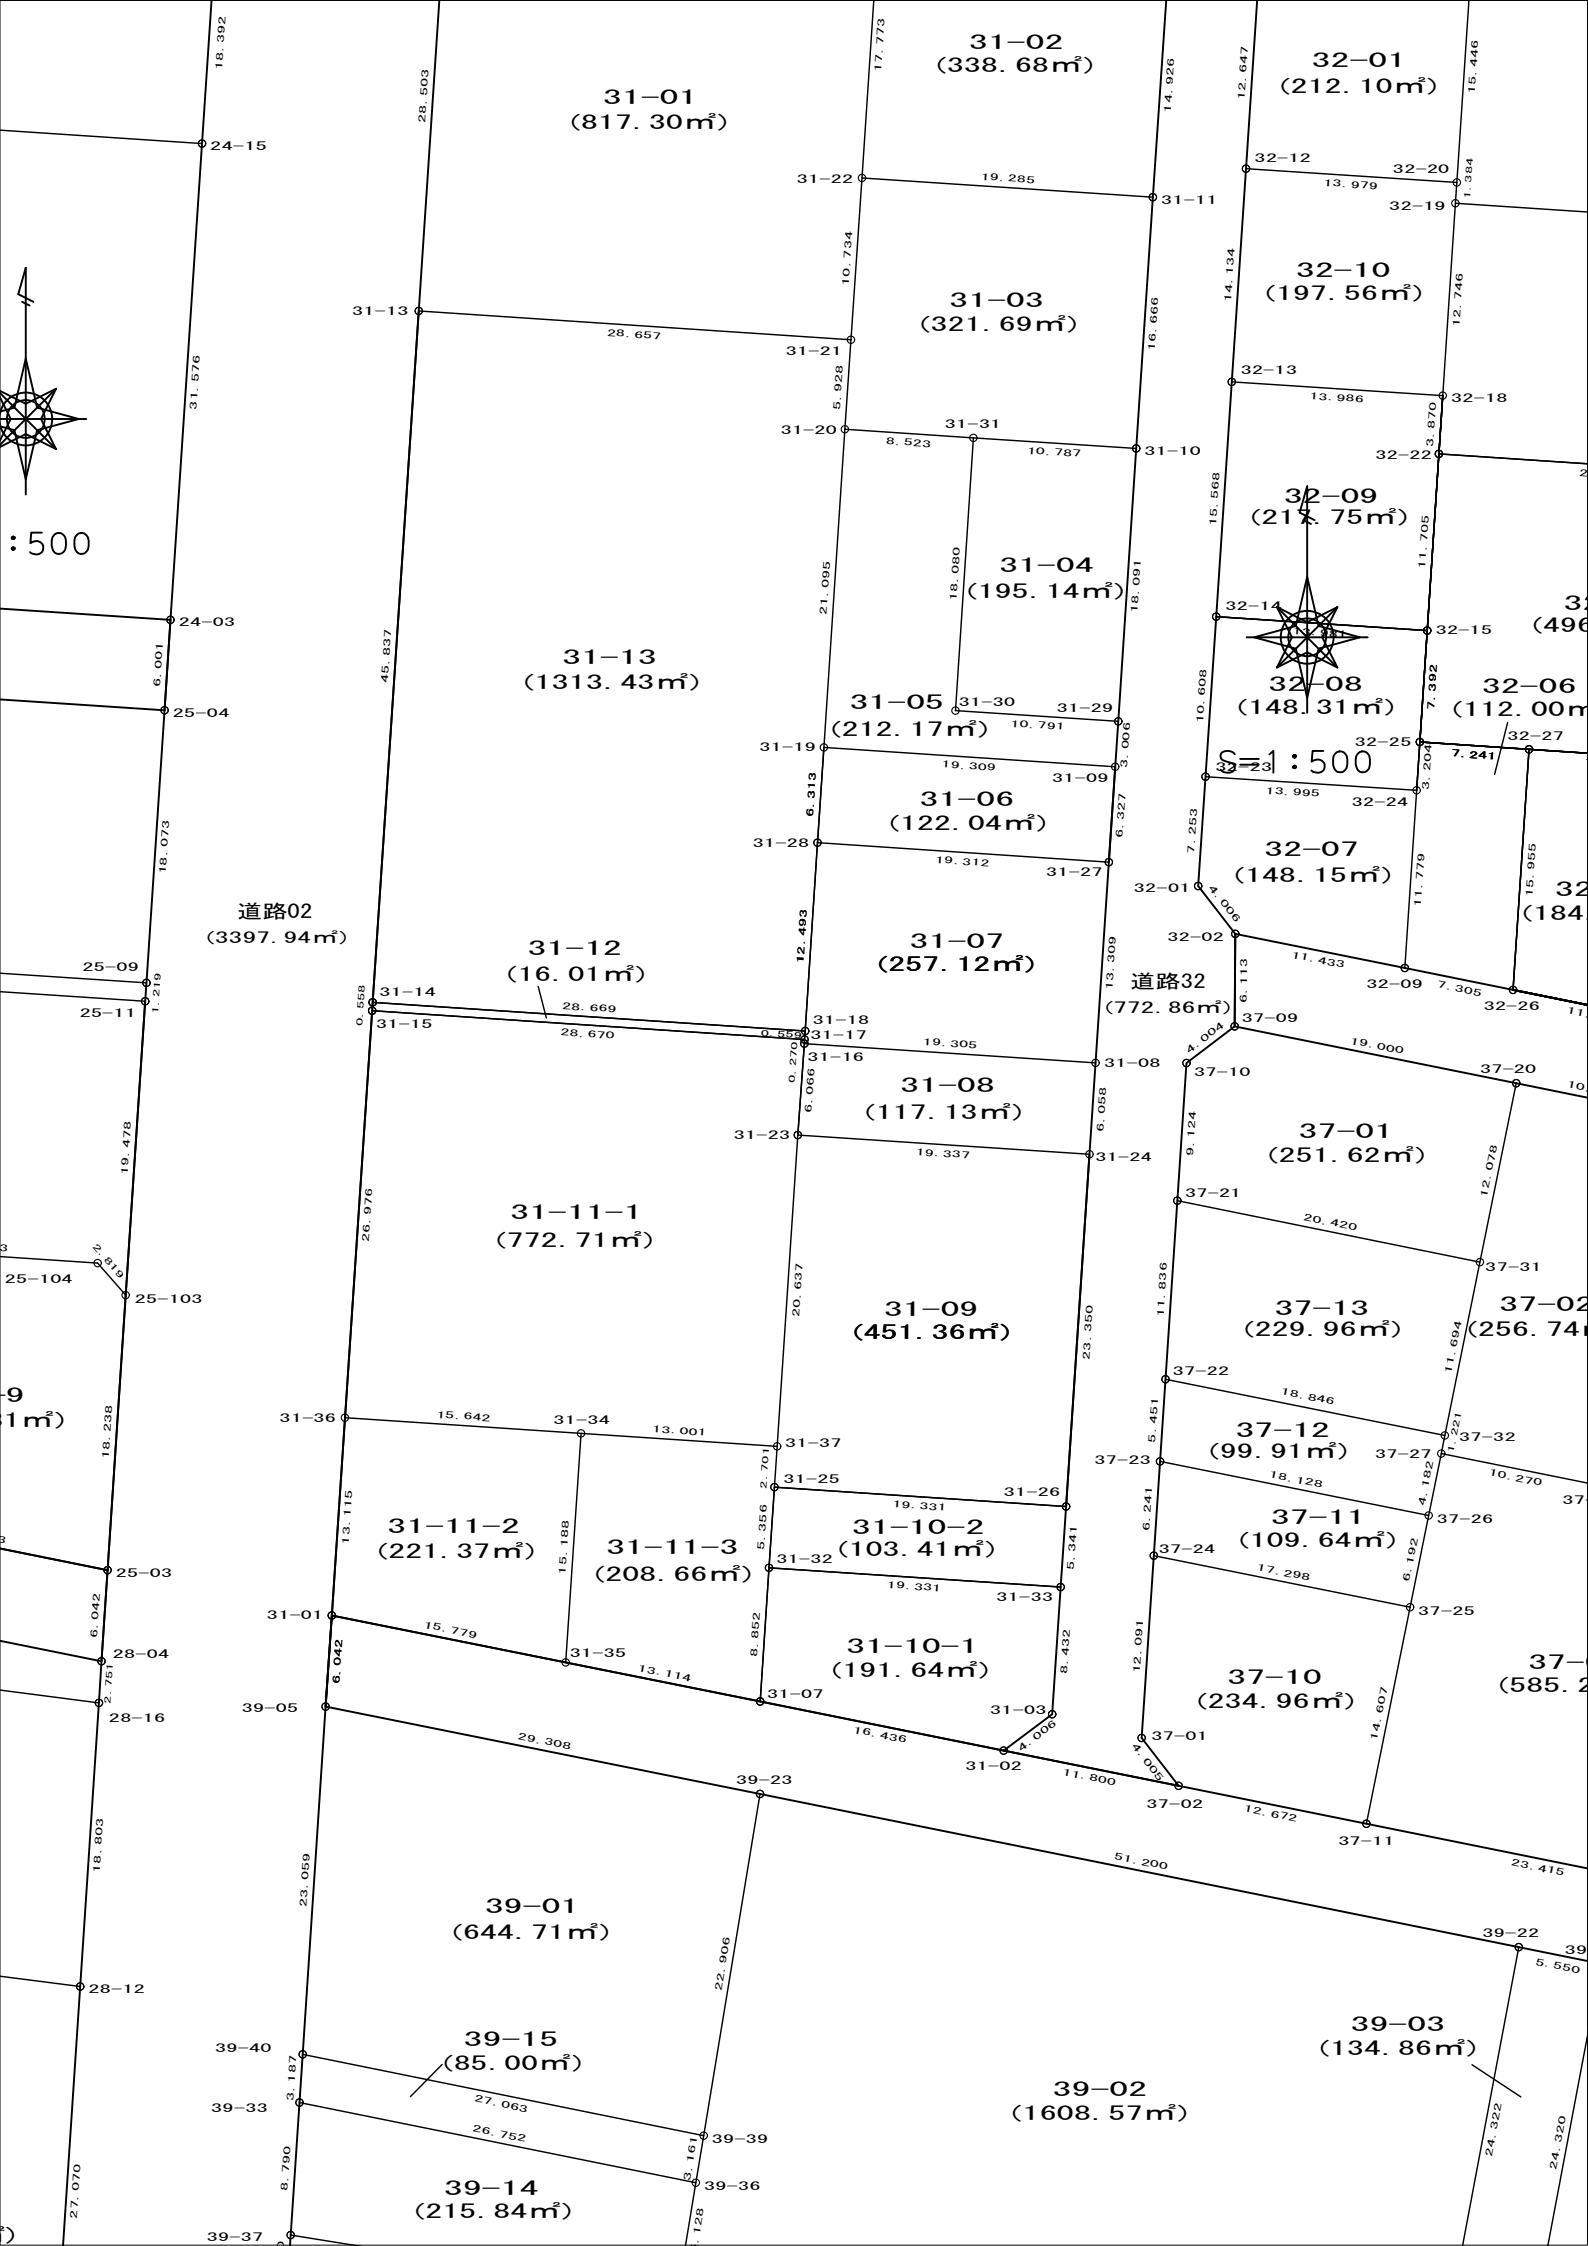

31-01
(817.30m²)

31-02
(338.68m²)

32-01
(212.10m²)

31-03
(321.69m²)

32-10
(197.56m²)

31-13
(1313.43m²)

31-04
(195.14m²)

32-09
(217.75m²)

31-05
(212.17m²)

32-08
(148.31m²)

31-06
(122.04m²)

32-07
(148.15m²)

31-12
(16.01m²)

31-07
(257.12m²)

道路32
(772.86m²)

31-08
(117.13m²)

37-01
(251.62m²)

31-11-1
(772.71m²)

31-09
(451.36m²)

37-13
(229.96m²)

31-11-2
(221.37m²)

31-10-2
(103.41m²)

37-12
(99.91m²)

31-11-3
(208.66m²)

31-10-1
(191.64m²)

37-11
(109.64m²)

39-01
(644.71m²)

39-02
(1608.57m²)

39-03
(134.86m²)

39-15
(85.00m²)

39-14
(215.84m²)

道路02
(3397.94m²)

1:500



画地面積(座標法)計算簿

画地番号：31-01

点名	Xn	Yn	距離	方向角	X _{n+1} -X _{n-1}	Y _{n+1} -Y _{n-1}	X _n *(Y _{n+1} -Y _{n-1})	Y _n *(X _{n+1} -X _{n-1})
31-13	47873.838	-71123.909	28.503	3° 47' 52"	30.348	-26.706	-1278518.717628	-2158468.390332
31-06	47902.279	-71122.021	28.678	93° 48' 24"	26.537	30.503	1461163.216337	-1887365.071277
31-12	47900.375	-71093.406	17.773	183° 48' 59"	-19.638	27.432	1314003.087000	1396132.307028
31-22	47882.641	-71094.589	10.734	183° 52' 41"	-28.444	-1.909	-91407.961669	2022214.489516
31-21	47871.931	-71095.315	28.657	273° 48' 56"	-8.803	-29.320	-1403605.016920	625852.057945
							倍面積	1634.607120
							面積	817.3035600
							地積	817.30

画地面積(座標法)計算簿

画地番号：31-02

点名	Xn	Yn	距離	方向角	X _{n+1} -X _{n-1}	Y _{n+1} -Y _{n-1}	X _n *(Y _{n+1} -Y _{n-1})	Y _n *(X _{n+1} -X _{n-1})
31-22	47882.641	-71094.589	17.773	3° 48' 59"	19.006	-18.061	-864808.379101	-1351223.758534
31-12	47900.375	-71093.406	16.464	93° 49' 51"	16.634	17.611	843573.504125	-1182567.715404
31-05	47899.275	-71076.978	4.001	138° 51' 02"	-4.113	19.061	913008.080775	292339.610514
31-04	47896.262	-71074.345	14.926	183° 50' 29"	-17.906	1.633	78214.595846	1272657.221570
31-11	47881.369	-71075.345	19.285	273° 46' 54"	-13.621	-20.244	-969310.434036	968117.274245
							倍面積	677.367609
							面積	338.6838045
							地積	338.68

画地面積(座標法)計算簿

画地番号：31-03

点名	Xn	Yn	距離	方向角	X _{n+1} -X _{n-1}	Y _{n+1} -Y _{n-1}	X _n *(Y _{n+1} -Y _{n-1})	Y _n *(X _{n+1} -X _{n-1})
31-31	47865.443	-71087.214	8.523	273° 51' 17"	1.277	-19.269	-922319.221167	-90778.372278
31-20	47866.016	-71095.718	5.928	3° 53' 52"	6.488	-8.101	-387762.595616	-461269.018384
31-21	47871.931	-71095.315	10.734	3° 52' 41"	16.625	1.129	54047.410099	-1181959.611875
31-22	47882.641	-71094.589	19.285	93° 46' 54"	9.438	19.970	956216.340770	-670990.730982
31-11	47881.369	-71075.345	16.666	183° 47' 53"	-17.902	18.140	868568.033660	1272390.826190
31-10	47864.739	-71076.449	10.787	273° 44' 30"	-15.926	-11.869	-568106.587191	1131963.526774
							倍面積	643.380555
							面積	321.6902775
							地積	321.69

画地面積(座標法)計算簿

画地番号：31-04

点名	Xn	Yn	距離	方向角	X _{n+1} -X _{n-1}	Y _{n+1} -Y _{n-1}	X _n *(Y _{n+1} -Y _{n-1})	Y _n *(X _{n+1} -X _{n-1})
31-30	47847.402	-71088.410	18.080	3° 47' 34"	18.756	-9.572	-457995.331944	-1333334.217960
31-31	47865.443	-71087.214	10.787	93° 44' 30"	17.337	11.961	572518.563723	-1232439.029118
31-10	47864.739	-71076.449	18.091	183° 46' 52"	-18.756	9.572	458161.281708	1333109.877444
31-29	47846.687	-71077.642	10.791	273° 47' 56"	-17.337	-11.961	-572294.223207	1232273.079354
							倍面積	390.290280
							面積	195.1451400
							地積	195.14

画地面積(座標法)計算簿

画地番号：31-05

点名	Xn	Yn	距離	方向角	X _{n+1} -X _{n-1}	Y _{n+1} -Y _{n-1}	X _n *(Y _{n+1} -Y _{n-1})	Y _n *(X _{n+1} -X _{n-1})
31-19	47844.966	-71097.110	21.095	3° 47' 00"	22.329	-17.875	-855228.767250	-1587527.369190
31-20	47866.016	-71095.718	8.523	93° 51' 17"	20.477	9.896	473682.094336	-1455827.017486
31-31	47865.443	-71087.214	18.080	183° 47' 34"	-18.614	7.308	349800.657444	1323217.401396
31-30	47847.402	-71088.410	10.791	93° 47' 56"	-18.756	9.572	457995.331944	1333334.217960
31-29	47846.687	-71077.642	3.006	183° 49' 59"	-3.715	10.567	505595.941529	264053.440030
31-09	47843.687	-71077.843	19.309	273° 47' 52"	-1.721	-19.468	-931420.898516	122324.967803
							倍面積	424.359487
							面積	212.1797435
							地積	212.17

画地面積(座標法)計算簿

画地番号：31-06

点名	X _n	Y _n	距離	方向角	X _{n+1} -X _{n-1}	Y _{n+1} -Y _{n-1}	X _n *(Y _{n+1} -Y _{n-1})	Y _n *(X _{n+1} -X _{n-1})
31-28	47838.667	-71097.533	6.313	3° 50' 31"	7.592	-18.846	-901567.518282	-539772.470536
31-19	47844.966	-71097.110	19.309	93° 47' 52"	5.020	19.690	942067.380540	-356907.492200
31-09	47843.687	-71077.843	6.327	183° 48' 55"	-7.592	18.846	901662.125202	539622.984056
31-27	47837.374	-71078.264	19.312	273° 50' 20"	-5.020	-19.690	-941917.894060	356812.885280
							倍面積	244.093400
							面積	122.0467000
							地積	122.04

画地面積(座標法)計算簿

画地番号：31-07

点名	Xn	Yn	距離	方向角	X _{n+1} -X _{n-1}	Y _{n+1} -Y _{n-1}	X _n *(Y _{n+1} -Y _{n-1})	Y _n *(X _{n+1} -X _{n-1})
31-16	47825.372	-71098.404	0.270	4° 01' 31"	1.549	-19.244	-920351.458768	-110131.427796
31-17	47825.642	-71098.385	0.559	3° 41' 29"	0.828	0.055	2630.410310	-58869.462780
31-18	47826.200	-71098.349	12.493	3° 44' 41"	13.025	0.852	40747.922400	-926055.995725
31-28	47838.667	-71097.533	19.312	93° 50' 20"	11.174	20.085	960839.626695	-794443.833742
31-27	47837.374	-71078.264	13.309	183° 46' 41"	-14.574	18.392	879824.982608	1035894.619536
31-08	47824.093	-71079.141	19.305	273° 47' 55"	-12.002	-20.140	-963177.233020	853091.850282
							倍面積	514.250225
							面積	257.1251125
							地積	257.12

画地面積(座標法)計算簿

画地番号：31-08

点名	Xn	Yn	距離	方向角	X _{n+1} -X _{n-1}	Y _{n+1} -Y _{n-1}	X _n *(Y _{n+1} -Y _{n-1})	Y _n *(X _{n+1} -X _{n-1})
31-23	47819.321	-71098.836	6.066	4° 05' 01"	7.324	-18.864	-902063.671344	-520727.874864
31-16	47825.372	-71098.404	19.305	93° 47' 55"	4.772	19.695	941920.701540	-339281.583888
31-08	47824.093	-71079.141	6.058	183° 46' 35"	-7.324	18.864	902153.690352	520583.628684
31-24	47818.048	-71079.540	19.337	273° 46' 28"	-4.772	-19.695	-941776.455360	339191.564880
倍面積								234.265188
面積								117.1325940
地積								117.13

画地面積(座標法)計算簿

画地番号：31-09

点名	Xn	Yn	距離	方向角	X _{n+1} -X _{n-1}	Y _{n+1} -Y _{n-1}	X _n *(Y _{n+1} -Y _{n-1})	Y _n *(X _{n+1} -X _{n-1})
31-25	47796.033	-71100.381	2.701	3° 47' 55"	3.980	-19.110	-913382.190630	-282979.516380
31-37	47798.729	-71100.202	20.637	3° 47' 43"	23.288	1.545	73849.036305	-1655781.504176
31-23	47819.321	-71098.836	19.337	93° 46' 28"	19.319	20.662	988042.810502	-1373558.412684
31-24	47818.048	-71079.540	23.350	183° 48' 40"	-24.572	17.744	848483.443712	1746566.456880
31-26	47794.749	-71081.092	19.331	273° 48' 30"	-22.015	-20.841	-996090.363909	1564850.240380
							倍面積	902.735980
							面積	451.3679900
							地積	451.36

画地面積(座標法)計算簿

画地番号：31-10-1

点名	Xn	Yn	距離	方向角	X _{n+1} -X _{n-1}	Y _{n+1} -Y _{n-1}	X _n *(Y _{n+1} -Y _{n-1})	Y _n *(X _{n+1} -X _{n-1})
31-32	47790.688	-71100.737	8.852	183° 48' 07"	-7.564	-19.877	-949935.505376	537805.974668
31-07	47781.855	-71101.324	16.436	101° 25' 07"	-12.087	15.524	741765.517020	859401.703188
31-02	47778.601	-71085.213	4.006	53° 07' 38"	-0.850	19.316	922891.456916	60422.431050
31-03	47781.005	-71082.008	8.432	3° 48' 52"	10.818	3.766	179943.264830	-768965.162544
31-33	47789.419	-71081.447	19.331	273° 45' 50"	9.683	-18.729	-895048.028451	-688281.651301
							倍面積	-383.295061
							面積	191.6475305
							地積	191.64

画地面積(座標法)計算簿

画地番号：31-10-2

点名	X _n	Y _n	距離	方向角	X _{n+1} -X _{n-1}	Y _{n+1} -Y _{n-1}	X _n *(Y _{n+1} -Y _{n-1})	Y _n *(X _{n+1} -X _{n-1})
31-25	47796.033	-71100.381	5.356	183° 48' 38"	-4.061	-19.645	-938953.068285	288738.647241
31-32	47790.688	-71100.737	19.331	93° 45' 50"	-6.614	18.934	904868.886592	470260.274518
31-33	47789.419	-71081.447	5.341	3° 48' 38"	4.061	19.645	938823.136255	-288661.756267
31-26	47794.749	-71081.092	19.331	273° 48' 30"	6.614	-18.934	-904945.777566	-470130.342488
							倍面積	-206.823004
							面積	103.4115020
							地積	103.41

画地面積(座標法)計算簿

画地番号：31-11-1

点名	Xn	Yn	距離	方向角	X _{n+1} -X _{n-1}	Y _{n+1} -Y _{n-1}	X _n *(Y _{n+1} -Y _{n-1})	Y _n *(X _{n+1} -X _{n-1})
31-15	47827.545	-71126.992	26.976	183° 48' 24"	-25.014	-30.398	-1453861.712910	1779170.577888
31-36	47800.628	-71128.783	15.642	93° 48' 04"	-27.954	13.817	660461.277076	1988333.999982
31-34	47799.591	-71113.175	13.001	93° 48' 05"	-1.899	28.581	1366160.110371	135043.919325
31-37	47798.729	-71100.202	20.637	3° 47' 43"	19.730	14.339	685385.975131	-1402806.985460
31-23	47819.321	-71098.836	6.066	4° 05' 01"	26.643	1.798	85979.139158	-1894286.287548
31-16	47825.372	-71098.404	0.270	4° 01' 31"	6.321	0.451	21569.242772	-449413.011684
31-17	47825.642	-71098.385	28.670	273° 48' 21"	2.173	-28.588	-1367239.453496	-154496.790605
							倍面積	-1545.421898
							面積	772.7109490
							地積	772.71

画地面積(座標法)計算簿

画地番号：31-11-2

点名	Xn	Yn	距離	方向角	X _{n+1} -X _{n-1}	Y _{n+1} -Y _{n-1}	X _n *(Y _{n+1} -Y _{n-1})	Y _n *(X _{n+1} -X _{n-1})
31-36	47800.628	-71128.783	13.115	183° 48' 12"	-12.050	-16.478	-787658.748184	857101.835150
31-01	47787.541	-71129.653	15.779	101° 20' 54"	-16.192	14.601	697745.886141	1151731.341376
31-35	47784.436	-71114.182	15.188	3° 48' 06"	12.050	16.478	787391.936408	-856925.893100
31-34	47799.591	-71113.175	15.642	273° 48' 04"	16.192	-14.601	-697921.828191	-1151464.529600
倍面積								-442.753826
面積								221.3769130
地積								221.37

画地面積(座標法)計算簿

画地番号：31-11-3

点名	Xn	Yn	距離	方向角	X _{n+1} -X _{n-1}	Y _{n+1} -Y _{n-1}	X _n *(Y _{n+1} -Y _{n-1})	Y _n *(X _{n+1} -X _{n-1})
31-34	47799.591	-71113.175	15.188	183° 48' 06"	-14.293	-13.980	-668238.282180	1016420.610275
31-35	47784.436	-71114.182	13.114	101° 21' 01"	-17.736	11.851	566293.351036	1261281.131952
31-07	47781.855	-71101.324	8.852	3° 48' 07"	6.252	13.445	642427.040475	-444525.477648
31-32	47790.688	-71100.737	5.356	3° 48' 38"	14.178	0.943	45066.618784	-1008066.249186
31-25	47796.033	-71100.381	2.701	3° 47' 55"	8.041	0.535	25570.877655	-571718.163621
31-37	47798.729	-71100.202	13.001	273° 48' 05"	3.558	-12.794	-611536.938826	-252974.518716
							倍面積	-417.333056
							面積	208.6665280
							地積	208.66

画地面積(座標法)計算簿

画地番号：31-12

点名	X _n	Y _n	距離	方向角	X _{n+1} -X _{n-1}	Y _{n+1} -Y _{n-1}	X _n *(Y _{n+1} -Y _{n-1})	Y _n *(X _{n+1} -X _{n-1})
31-15	47827.545	-71126.992	0.558	3° 48' 02"	2.460	-28.570	-1366432.960650	-174972.400320
31-14	47828.102	-71126.955	28.669	93° 48' 14"	-1.345	28.643	1369940.325586	95665.754475
31-18	47826.200	-71098.349	0.559	183° 41' 29"	-2.460	28.570	1366394.534000	174901.938540
31-17	47825.642	-71098.385	28.670	273° 48' 21"	1.345	-28.643	-1369869.863806	-95627.327825
倍面積								32.035130
面積								16.0175650
地積								16.01

画地面積(座標法)計算簿

画地番号：31-13

点名	Xn	Yn	距離	方向角	X _{n+1} -X _{n-1}	Y _{n+1} -Y _{n-1}	X _n *(Y _{n+1} -Y _{n-1})	Y _n *(X _{n+1} -X _{n-1})
31-14	47828.102	-71126.955	28.669	93° 48' 14"	-47.638	25.560	1222486.287120	3388345.882290
31-18	47826.200	-71098.349	12.493	3° 44' 41"	10.565	29.422	1407142.456400	-751154.057185
31-28	47838.667	-71097.533	6.313	3° 50' 31"	18.766	1.239	59272.108413	-1334216.304278
31-19	47844.966	-71097.110	21.095	3° 47' 00"	27.349	1.815	86838.613290	-1944434.861390
31-20	47866.016	-71095.718	5.928	3° 53' 52"	26.965	1.795	85919.498720	-1917096.035870
31-21	47871.931	-71095.315	28.657	273° 48' 56"	7.822	-28.191	-1349557.606821	-556107.553930
31-13	47873.838	-71123.909	45.837	183° 48' 37"	-43.829	-31.640	-1514728.234320	3117289.807561
							倍面積	-2626.877198
							面積	1313.4385990
							地積	1313.43