



36街区 画地出来形確認図 (4740.63m²)

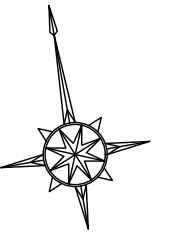

S=1:500

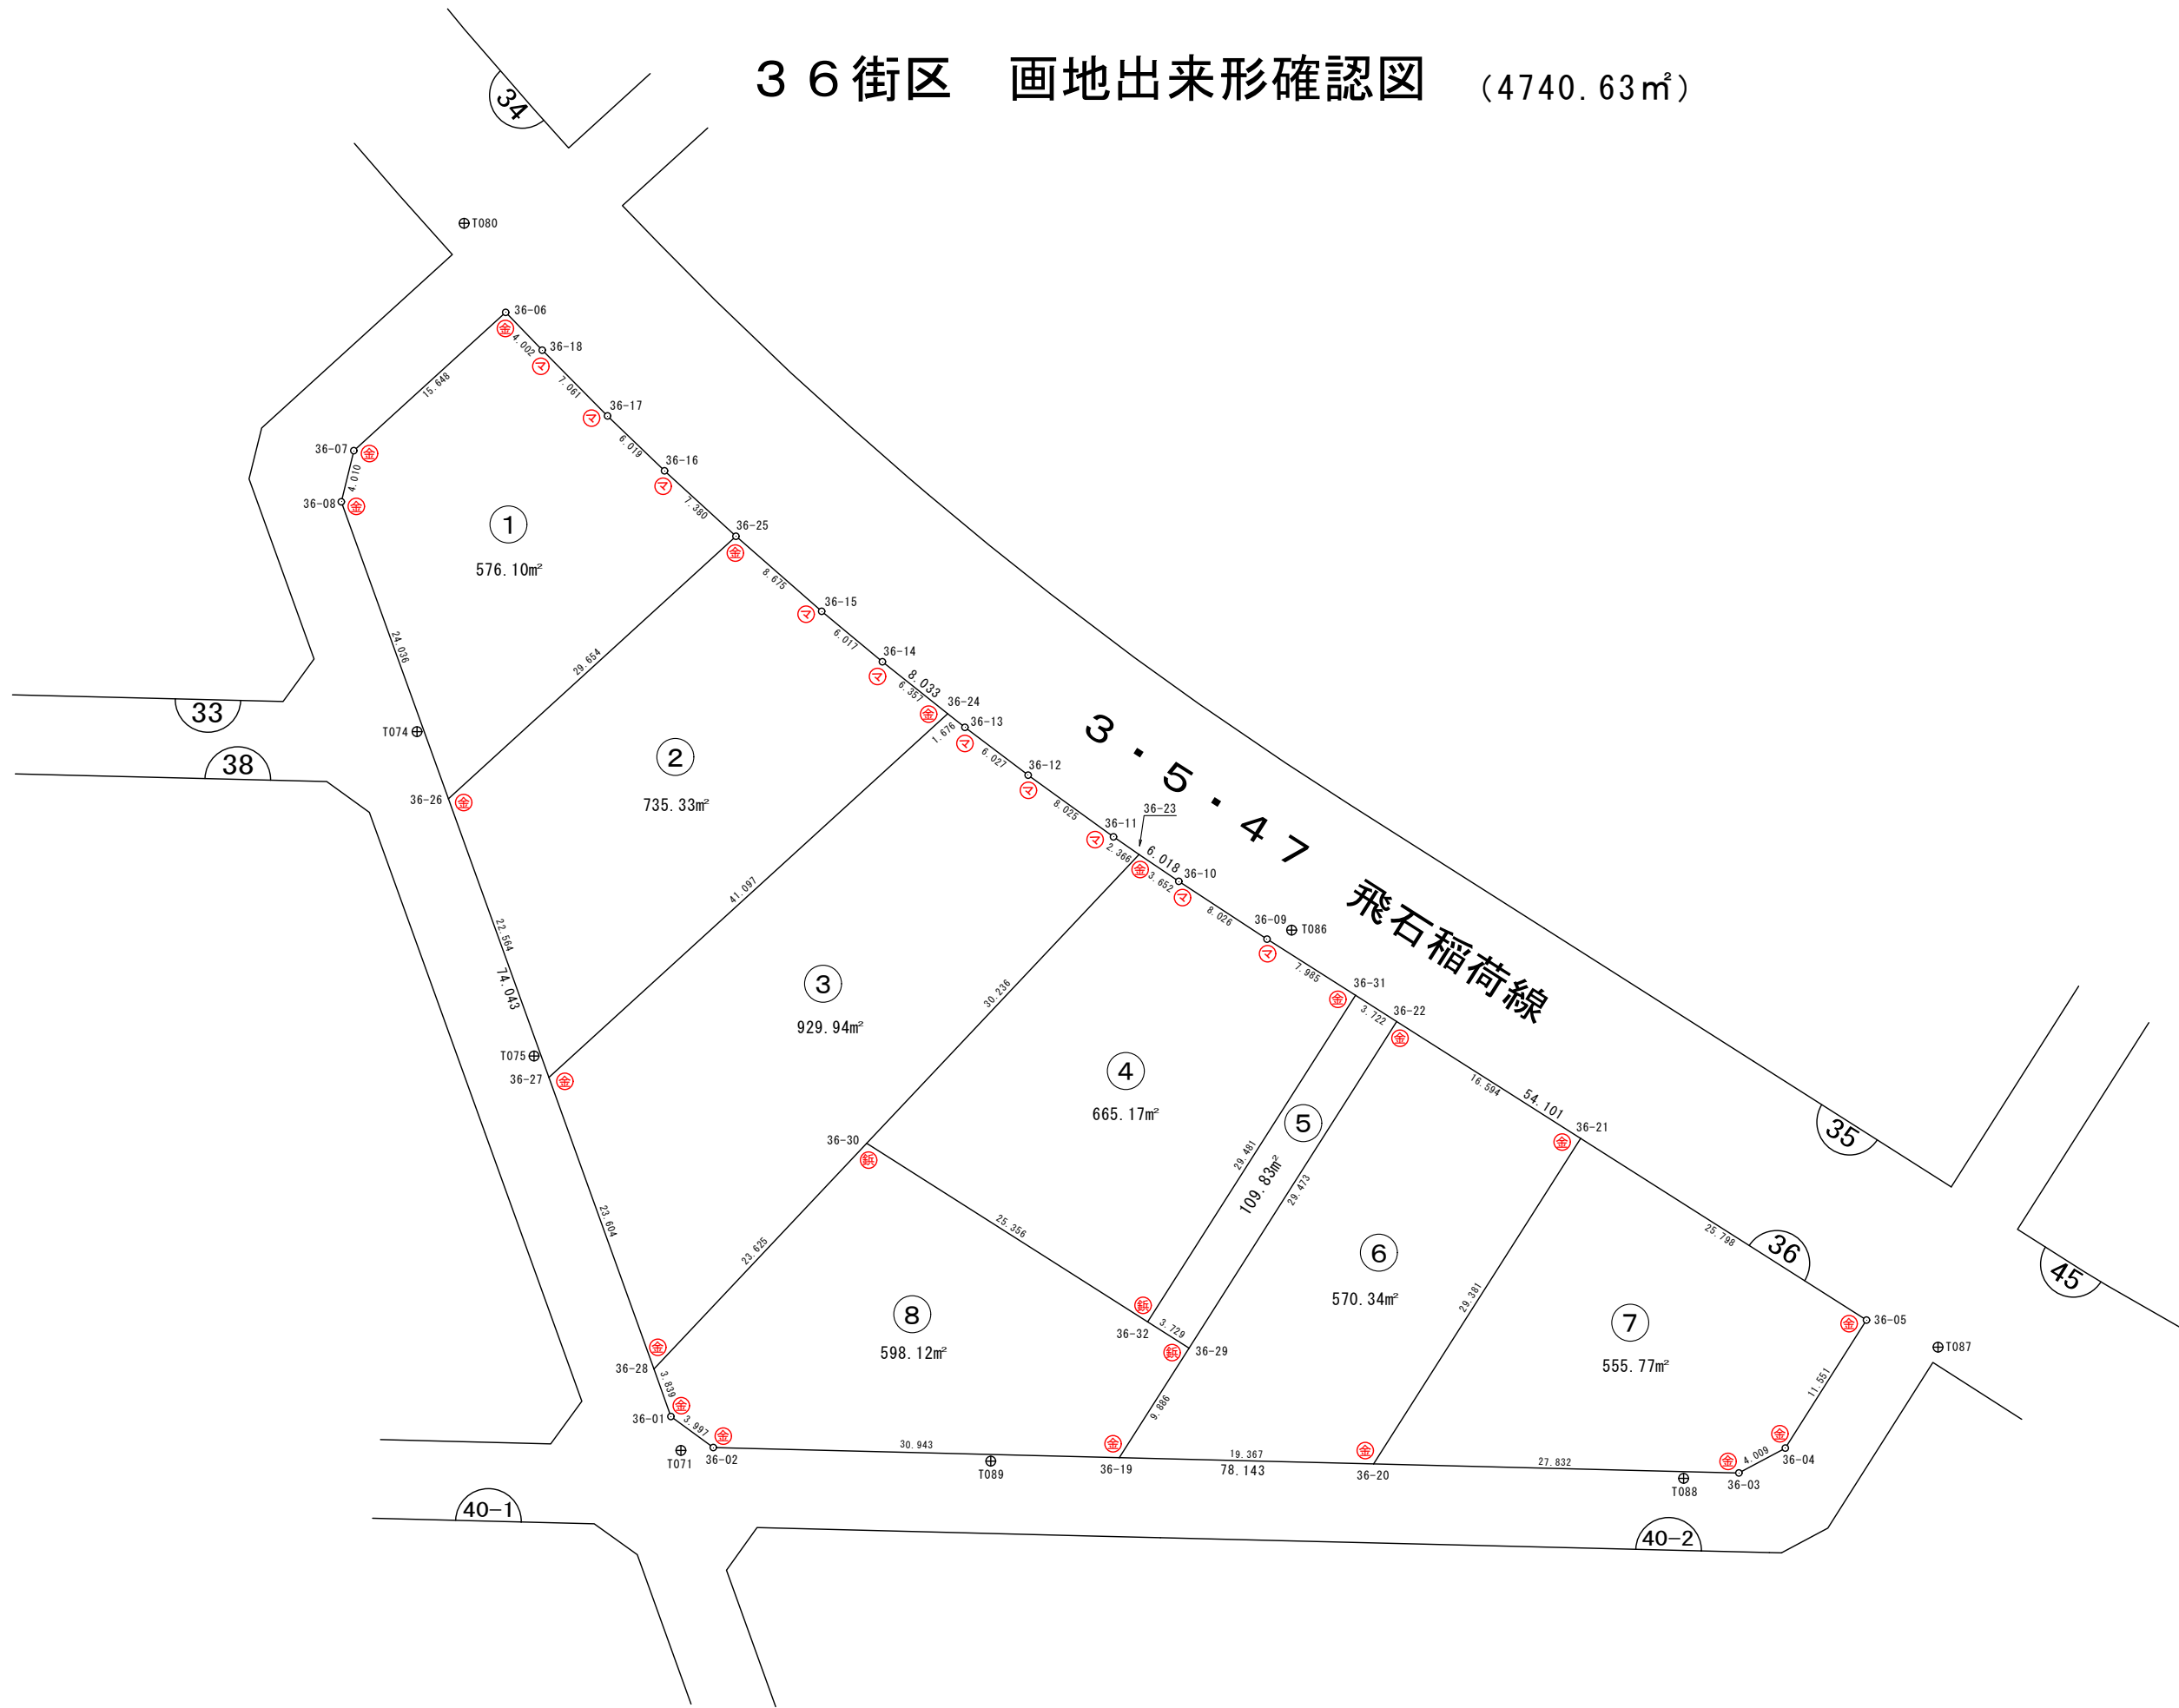

凡 例	
事 項	記 号
金属プレート	⊕
コンクリート杭	⊖
金属 鈎	⊗
合成樹脂杭	⊕
マーキング	⊗

画地面積(座標法)計算簿

画地番号：36-01

点名	X _n	Y _n	距離	方向角	X _{n+1} -X _{n-1}	Y _{n+1} -Y _{n-1}	X _n *(Y _{n+1} -Y _{n-1})	Y _n *(X _{n+1} -X _{n-1})
36-26	47800.151	-70944.855	24.036	350° 10' 00"	7.799	-29.147	-1393231.001197	-553298.924145
36-08	47823.834	-70948.960	4.010	23° 48' 37"	27.352	-2.486	-118890.051324	-1940595.953920
36-07	47827.503	-70947.341	15.648	57° 40' 04"	12.038	14.841	709807.972023	-854064.090958
36-06	47835.872	-70934.119	4.002	146° 01' 12"	5.050	15.459	739494.745248	-358217.300950
36-18	47832.553	-70931.882	7.061	145° 13' 14"	-9.119	6.265	299670.944545	646827.831958
36-17	47826.753	-70927.854	6.019	143° 53' 09"	-10.663	7.576	362335.480728	756303.707202
36-16	47821.890	-70924.306	7.380	142° 29' 53"	-10.718	8.041	384535.817490	760166.711708
36-25	47816.035	-70919.813	29.654	237° 36' 48"	-21.739	-20.549	-982571.703215	1541725.814807
							倍面積	1152.204298
							面積	576.1021490
							地積	576.10

画地面積(座標法)計算簿

画地番号：36-02

点名	Xn	Yn	距離	方向角	X _{n+1} -X _{n-1}	Y _{n+1} -Y _{n-1}	X _n *(Y _{n+1} -Y _{n-1})	Y _n *(X _{n+1} -X _{n-1})
36-27	47777.919	-70940.995	22.564	350° 09' 01"	0.235	-38.575	-1843033.225425	-16671.133825
36-26	47800.151	-70944.855	29.654	57° 36' 48"	38.116	21.182	1012502.798482	-2704134.093180
36-25	47816.035	-70919.813	8.675	141° 11' 41"	9.123	30.479	1457384.930765	-647001.453999
36-15	47809.274	-70914.376	6.017	139° 44' 19"	-11.353	9.326	445869.289324	805090.910728
36-14	47804.682	-70910.487	6.357	138° 33' 53"	-9.358	8.096	387026.705472	663580.337346
36-24	47799.916	-70906.280	41.097	237° 38' 23"	-26.763	-30.508	-1458279.837328	1897664.771640
							倍面積	1470.661290
							面積	735.3306450
							地積	735.33

画地面積(座標法)計算簿

画地番号：36-03

点名	X _n	Y _n	距離	方向角	X _{n+1} -X _{n-1}	Y _{n+1} -Y _{n-1}	X _n *(Y _{n+1} -Y _{n-1})	Y _n *(X _{n+1} -X _{n-1})
36-28	47754.659	-70936.979	23.604	350° 12' 15"	9.146	-22.962	-1096542.479958	-648789.609934
36-27	47777.919	-70940.995	41.097	57° 38' 23"	45.257	30.699	1466734.335381	-3210576.610715
36-24	47799.916	-70906.280	1.676	138° 07' 10"	20.749	35.834	1712862.189944	-1471234.403720
36-13	47798.668	-70905.161	6.027	137° 05' 27"	-5.663	5.223	249652.442964	401535.926743
36-12	47794.253	-70901.057	8.025	135° 51' 30"	-10.174	9.693	463269.694329	721347.353918
36-11	47788.494	-70895.468	2.366	134° 35' 21"	-7.420	7.274	347613.505356	526044.372560
36-23	47786.833	-70893.783	30.236	233° 19' 24"	-19.721	-22.565	-1078309.886645	1398096.294543
36-30	47768.773	-70918.033	23.625	233° 18' 55"	-32.174	-43.196	-2063419.918508	2281716.793742
							倍面積	1859.882863
							面積	929.9414315
							地積	929.94

画地面積(座標法)計算簿

画地番号：36-04

点名	Xn	Yn	距離	方向角	X _{n+1} -X _{n-1}	Y _{n+1} -Y _{n-1}	X _n *(Y _{n+1} -Y _{n-1})	Y _n *(X _{n+1} -X _{n-1})
36-32	47751.664	-70899.318	25.356	312° 25' 59"	-4.639	-38.620	-1844169.263680	328901.936202
36-30	47768.773	-70918.033	30.236	53° 19' 24"	35.169	5.535	264400.158555	-2494116.302577
36-23	47786.833	-70893.783	3.652	134° 04' 46"	15.519	26.874	1284223.350042	-1100200.618377
36-10	47784.292	-70891.159	8.026	133° 12' 28"	-8.036	8.474	404924.090408	569681.353724
36-09	47778.797	-70885.309	7.985	132° 24' 23"	-10.880	11.746	561209.749562	771232.161920
36-31	47773.412	-70879.413	29.481	222° 27' 59"	-27.133	-14.009	-669257.728708	1923171.112929
							倍面積	1330.356179
							面積	665.1780895
							地積	665.17

画地面積(座標法)計算簿

画地番号：36-05

点名	Xn	Yn	距離	方向角	X _{n+1} -X _{n-1}	Y _{n+1} -Y _{n-1}	X _n *(Y _{n+1} -Y _{n-1})	Y _n *(X _{n+1} -X _{n-1})
36-29	47749.152	-70896.562	3.729	312° 20' 53"	-19.234	-22.651	-1081566.041952	1363624.473508
36-32	47751.664	-70899.318	29.481	42° 27' 59"	24.260	17.149	818893.285936	-1720017.454680
36-31	47773.412	-70879.413	3.722	132° 28' 28"	19.234	22.651	1082115.555212	-1363294.629642
36-22	47770.898	-70876.667	29.473	222° 27' 17"	-24.260	-17.149	-819223.129802	1719467.941420
							倍面積	219.669394
							面積	109.8346970
							地積	109.83

画地面積(座標法)計算簿

画地番号：36-06

点名	Xn	Yn	距離	方向角	X _{n+1} -X _{n-1}	Y _{n+1} -Y _{n-1}	X _n *(Y _{n+1} -Y _{n-1})	Y _n *(X _{n+1} -X _{n-1})
36-20	47738.023	-70884.254	19.367	281° 25' 36"	-17.840	-38.818	-1853094.576814	1264575.091360
36-19	47741.860	-70903.238	9.886	42° 28' 29"	11.129	-12.308	-587606.812880	-789082.135702
36-29	47749.152	-70896.562	29.473	42° 27' 17"	29.038	26.571	1268742.717792	-2058694.367356
36-22	47770.898	-70876.667	16.594	132° 26' 17"	10.548	32.142	1535452.203516	-747607.083516
36-21	47759.700	-70864.420	29.381	222° 27' 28"	-32.875	-7.587	-362352.843900	2329667.807500
							倍面積	1140.687714
							面積	570.3438570
							地積	570.34

画地面積(座標法)計算簿

画地番号：36-07

点名	Xn	Yn	距離	方向角	X _{n+1} -X _{n-1}	Y _{n+1} -Y _{n-1}	X _n *(Y _{n+1} -Y _{n-1})	Y _n *(X _{n+1} -X _{n-1})
36-03	47732.512	-70856.973	27.832	281° 25' 14"	4.260	-31.090	-1484003.798080	-301850.704980
36-20	47738.023	-70884.254	29.381	42° 27' 28"	27.188	-7.447	-355505.057281	-1927201.097752
36-21	47759.700	-70864.420	25.798	132° 25' 37"	4.272	38.877	1856753.856900	-302732.802240
36-05	47742.295	-70845.377	11.551	222° 23' 10"	-25.937	11.256	537387.272520	1837516.543249
36-04	47733.763	-70853.164	4.009	251° 49' 05"	-9.783	-11.596	-553520.715748	693156.503412
							倍面積	1111.558311
							面積	555.7791555
							地積	555.77

画地面積(座標法)計算簿

画地番号：36-08

点名	X _n	Y _n	距離	方向角	X _{n+1} -X _{n-1}	Y _{n+1} -Y _{n-1}	X _n *(Y _{n+1} -Y _{n-1})	Y _n *(X _{n+1} -X _{n-1})
36-02	47747.985	-70933.569	3.997	316° 17' 50"	9.015	-33.093	-1580124.067605	-639466.124535
36-01	47750.875	-70936.331	3.839	350° 16' 57"	6.674	-3.410	-162830.483750	-473429.073094
36-28	47754.659	-70936.979	23.625	53° 18' 55"	17.898	18.298	873814.750382	-1269630.050142
36-30	47768.773	-70918.033	25.356	132° 25' 59"	-2.995	37.661	1799019.759953	212399.508835
36-32	47751.664	-70899.318	3.729	132° 20' 53"	-19.621	21.471	1025275.977744	1391115.518478
36-29	47749.152	-70896.562	9.886	222° 28' 29"	-9.804	-3.920	-187176.675840	695069.893848
36-19	47741.860	-70903.238	30.943	281° 25' 00"	-1.167	-37.007	-1766783.013020	82744.078746
							倍面積	1196.247864
							面積	598.1239320
							地積	598.12