


# 43街区 画地出来形確認図 (6854.68m<sup>2</sup>)

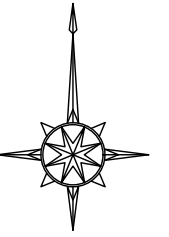


S=1:500



※⑧画地は分筆しています。次ページで確認してください。

凡 例	
事 項	記 号
金属プレート	⊕
コンクリート杭	⊖
金属 鈎	⊗
合成樹脂杭	⊕
マーキング	⊗

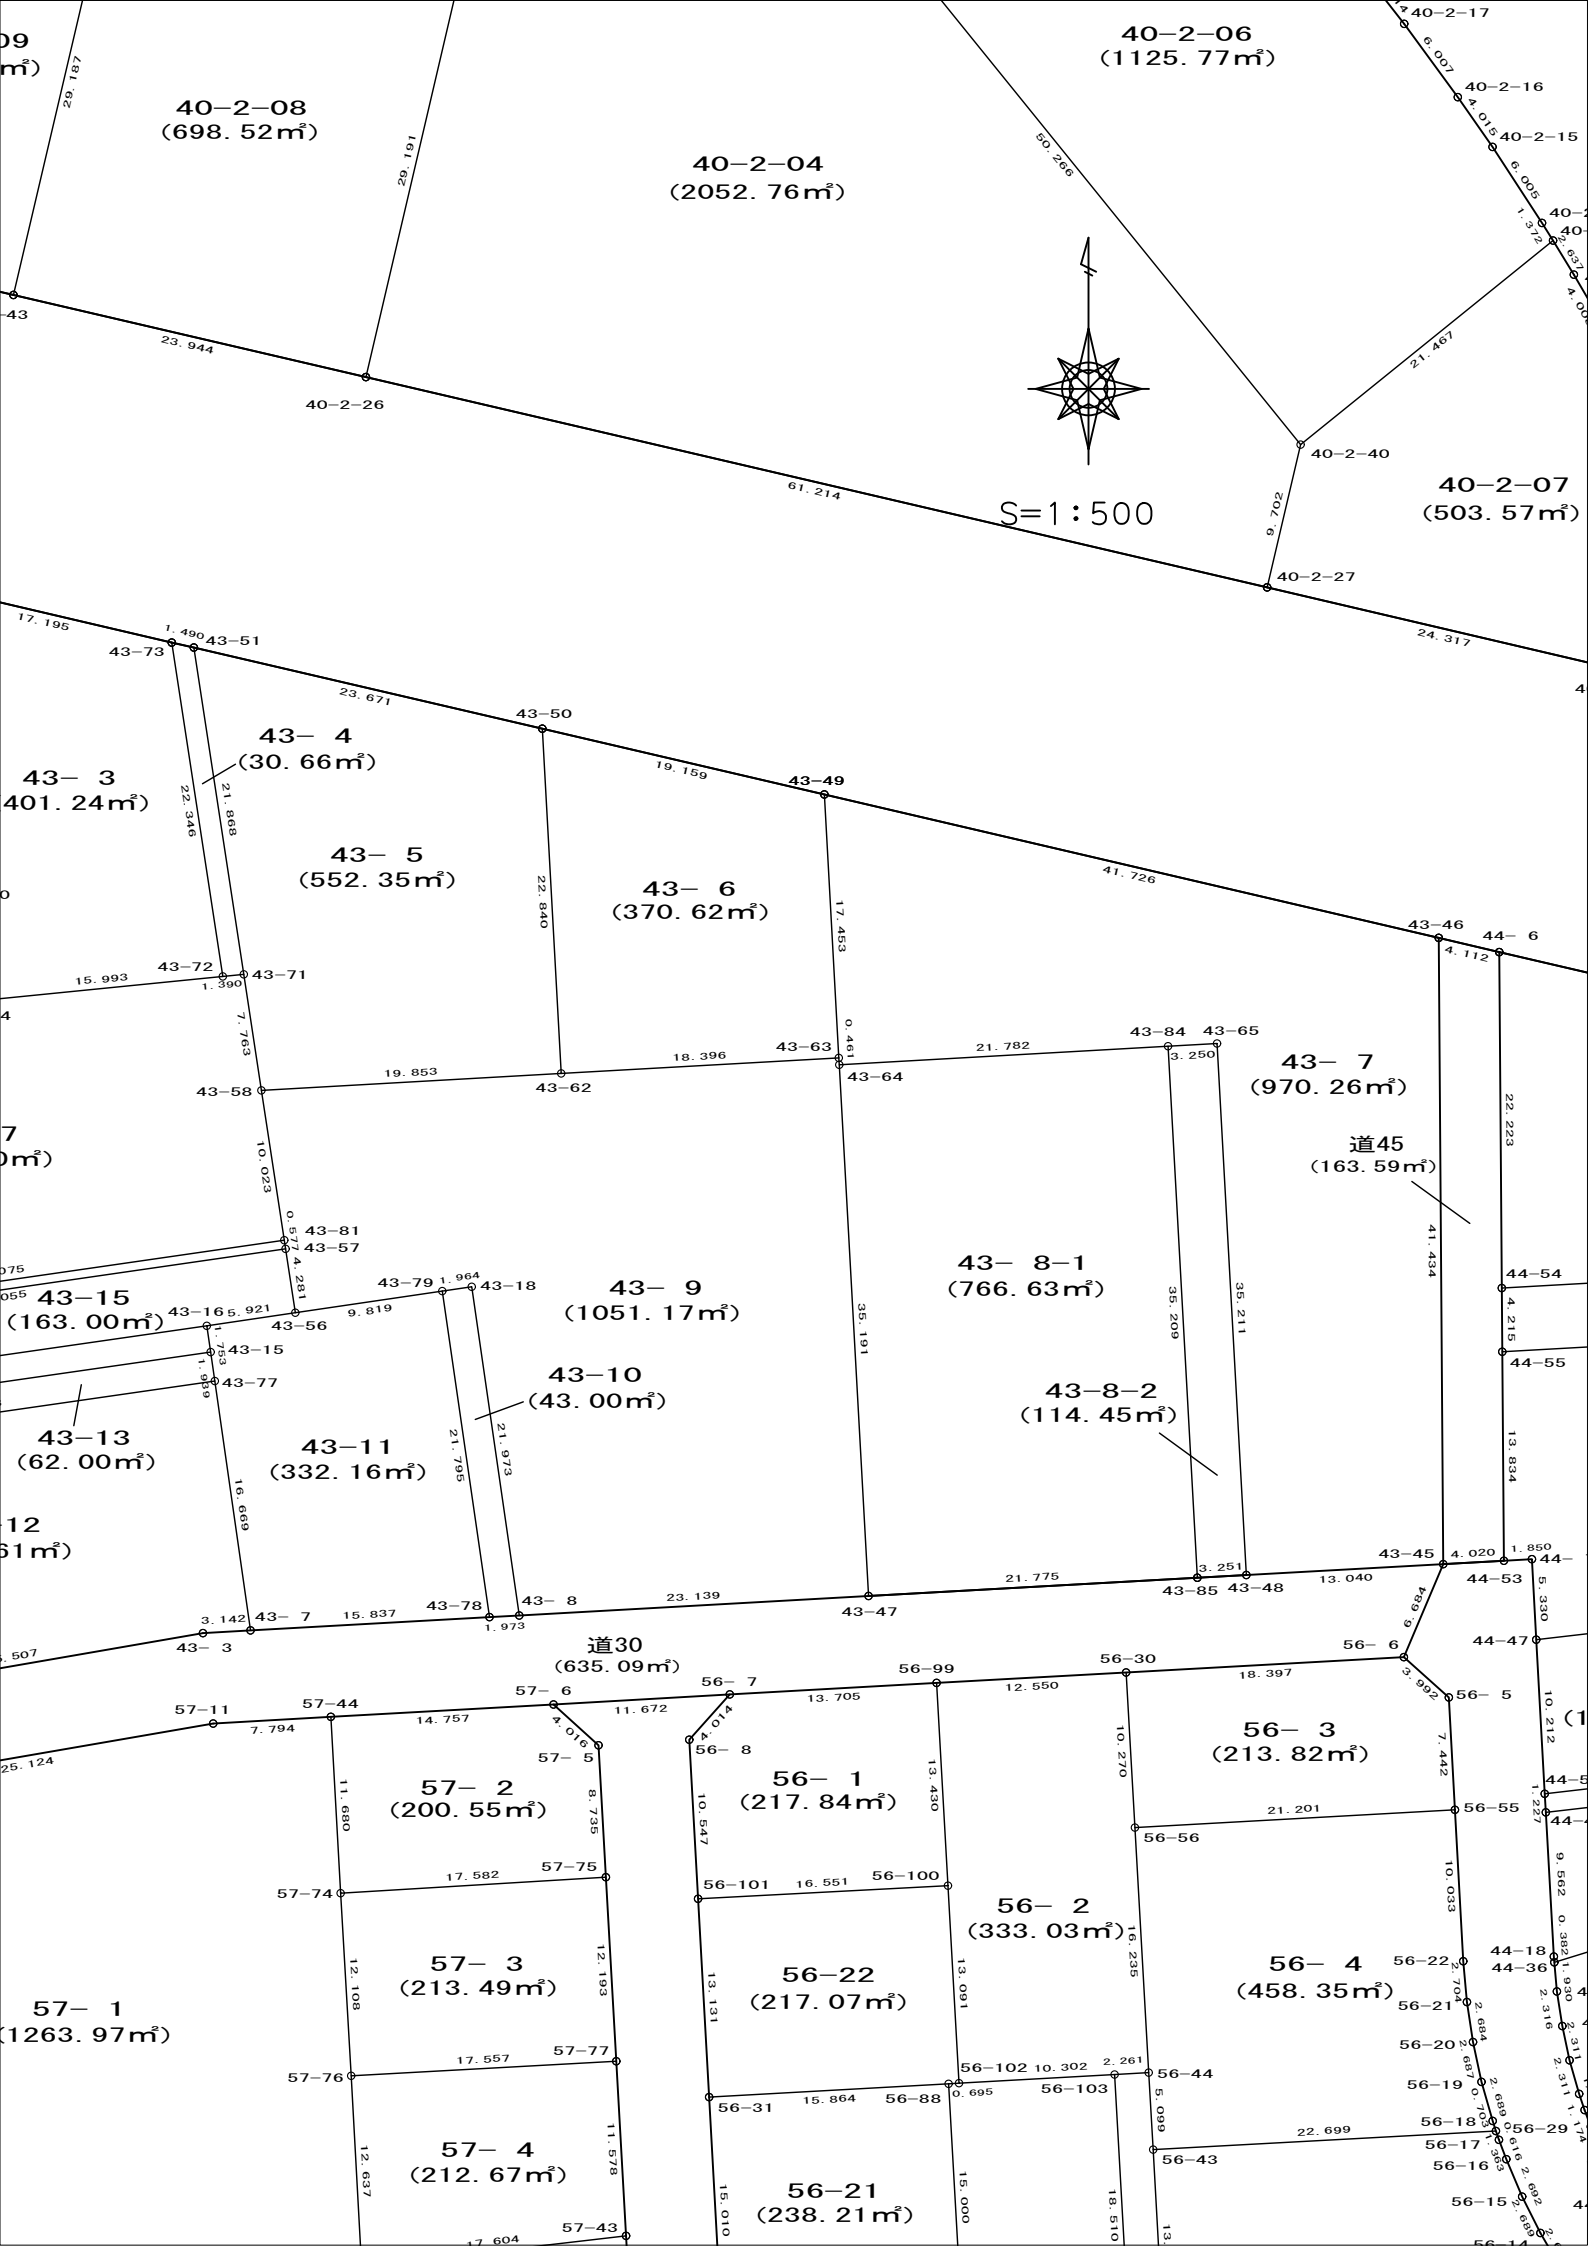

## 画地面積(座標法)計算簿

画地番号：43- 1

点名	Xn	Yn	距離	方向角	X <sub>n+1</sub> -X <sub>n-1</sub>	Y <sub>n+1</sub> -Y <sub>n-1</sub>	X <sub>n</sub> *(Y <sub>n+1</sub> -Y <sub>n-1</sub> )	Y <sub>n</sub> *(X <sub>n+1</sub> -X <sub>n-1</sub> )
43- 6	47662.659	-70921.056	35.549	170° 12' 22"	-30.910	-11.600	-552886.844400	2192169.840960
43-70	47627.628	-70915.009	16.145	84° 16' 12"	-33.419	22.112	1053142.110336	2369908.685771
43-83	47629.240	-70898.944	29.636	351° 20' 05"	30.910	11.600	552499.184000	-2191486.359040
43-82	47658.538	-70903.409	18.121	283° 08' 40"	33.419	-22.112	-1053825.592256	-2369521.025371
							倍面積	-1071.142320
							面積	535.5711600
							地積	535.57

## 画地面積(座標法)計算簿

画地番号：43- 2

点名	Xn	Yn	距離	方向角	X <sub>n+1</sub> -X <sub>n-1</sub>	Y <sub>n+1</sub> -Y <sub>n-1</sub>	X <sub>n</sub> *(Y <sub>n+1</sub> -Y <sub>n-1</sub> )	Y <sub>n</sub> *(X <sub>n+1</sub> -X <sub>n-1</sub> )
43-82	47658.538	-70903.409	29.636	171° 20' 05"	-28.088	-0.748	-35648.586424	1991534.951992
43-83	47629.240	-70898.944	4.975	84° 16' 03"	-28.801	9.416	448476.923840	2041960.486144
43-74	47629.737	-70893.993	27.909	351° 20' 19"	28.088	0.748	35627.043276	-1991270.475384
43-75	47657.328	-70898.196	5.351	283° 04' 04"	28.801	-9.416	-448741.400448	-2041938.942996
<b>倍面積</b>								-286.019756
<b>面積</b>								143.0098780
<b>地積</b>								143.00

## 画地面積(座標法)計算簿

画地番号：43- 3

点名	Xn	Yn	距離	方向角	X <sub>n+1</sub> -X <sub>n-1</sub>	Y <sub>n+1</sub> -Y <sub>n-1</sub>	X <sub>n</sub> *(Y <sub>n+1</sub> -Y <sub>n-1</sub> )	Y <sub>n</sub> *(X <sub>n+1</sub> -X <sub>n-1</sub> )
43-75	47657.328	-70898.196	27.909	171° 20' 19"	-23.680	-12.542	-597718.207776	1678869.281280
43-74	47629.737	-70893.993	15.993	84° 17' 53"	-26.002	20.117	958167.419229	1843385.605986
43-72	47631.326	-70878.079	22.346	351° 19' 17"	23.680	12.542	597392.090692	-1678392.910720
43-73	47653.417	-70881.451	17.195	283° 08' 47"	26.002	-20.117	-958643.789789	-1843059.488902
							倍面積	-802.487644
							面積	401.2438220
							地積	401.24

## 画地面積(座標法)計算簿

画地番号：43- 4

点名	Xn	Yn	距離	方向角	X <sub>n+1</sub> -X <sub>n-1</sub>	Y <sub>n+1</sub> -Y <sub>n-1</sub>	X <sub>n</sub> *(Y <sub>n+1</sub> -Y <sub>n-1</sub> )	Y <sub>n</sub> *(X <sub>n+1</sub> -X <sub>n-1</sub> )
43-73	47653.417	-70881.451	22.346	171° 19' 17"	-21.756	1.920	91494.560640	1542096.847956
43-72	47631.326	-70878.079	1.390	84° 15' 53"	-21.952	4.756	226534.586456	1555915.590208
43-71	47631.465	-70876.695	21.868	351° 18' 36"	21.756	-1.920	-91452.412800	-1541993.376420
43-51	47653.082	-70879.999	1.490	282° 59' 30"	21.952	-4.756	-226638.057992	-1555957.738048
							倍面積	-61.323696
							面積	30.6618480
							地積	30.66

## 画地面積(座標法)計算簿

画地番号：43- 5

点名	Xn	Yn	距離	方向角	X <sub>n+1</sub> -X <sub>n-1</sub>	Y <sub>n+1</sub> -Y <sub>n-1</sub>	X <sub>n</sub> *(Y <sub>n+1</sub> -Y <sub>n-1</sub> )	Y <sub>n</sub> *(X <sub>n+1</sub> -X <sub>n-1</sub> )
43-51	47653.082	-70879.999	21.868	171° 18' 36"	-16.247	-19.750	-941148.369500	1151587.343753
43-71	47631.465	-70876.695	7.763	171° 19' 04"	-29.292	4.476	213198.437340	2076120.149940
43-58	47623.790	-70875.523	19.853	86° 46' 50"	-6.560	20.994	999813.847260	464943.430880
43-62	47624.905	-70855.701	22.840	356° 52' 40"	23.922	18.578	884775.485090	-1695010.079322
43-50	47647.712	-70856.945	23.671	283° 06' 44"	28.177	-24.298	-1157744.106176	-1996536.139265
							倍面積	-1104.705986
							面積	552.3529930
							地積	552.35

## 画地面積(座標法)計算簿

画地番号：43- 6

点名	Xn	Yn	距離	方向角	X <sub>n+1</sub> -X <sub>n-1</sub>	Y <sub>n+1</sub> -Y <sub>n-1</sub>	X <sub>n</sub> *(Y <sub>n+1</sub> -Y <sub>n-1</sub> )	Y <sub>n</sub> *(X <sub>n+1</sub> -X <sub>n-1</sub> )
43-63	47625.938	-70837.334	17.453	356° 52' 36"	18.461	17.416	829453.336208	-1307728.022974
43-49	47643.366	-70838.285	19.159	283° 06' 39"	21.774	-19.611	-934334.050626	-1542432.817590
43-50	47647.712	-70856.945	22.840	176° 52' 40"	-18.461	-17.416	-829832.552192	1308090.061645
43-62	47624.905	-70855.701	18.396	86° 46' 51"	-21.774	19.611	933972.011955	1542812.033574
<b>倍面積</b>								-741.254655
<b>面積</b>								370.6273275
<b>地積</b>								370.62



## 画地面積(座標法)計算簿

画地番号：43- 7

点名	Xn	Yn	距離	方向角	X <sub>n+1</sub> -X <sub>n-1</sub>	Y <sub>n+1</sub> -Y <sub>n-1</sub>	X <sub>n</sub> *(Y <sub>n+1</sub> -Y <sub>n-1</sub> )	Y <sub>n</sub> *(X <sub>n+1</sub> -X <sub>n-1</sub> )
43-49	47643.366	-70838.285	17.453	176° 52' 36"	-7.941	-39.683	-1890631.692978	562526.821185
43-63	47625.938	-70837.334	0.461	176° 53' 45"	-17.889	0.976	46482.915488	1267209.067926
43-64	47625.477	-70837.309	21.782	86° 46' 06"	0.767	21.773	1036949.510721	-54332.216003
43-84	47626.705	-70815.561	3.250	86° 46' 20"	1.411	24.993	1190334.238065	-99920.756571
43-65	47626.888	-70812.316	35.211	176° 50' 30"	-34.975	5.185	246945.414280	2476660.752100
43-48	47591.730	-70810.376	13.040	86° 51' 09"	-34.442	14.961	712019.872530	2438850.970192
43-45	47592.446	-70797.355	41.434	359° 35' 26"	42.149	12.725	605613.875350	-2984037.715895
43-46	47633.879	-70797.651	41.726	283° 08' 30"	50.920	-40.930	-1949654.667470	-3605016.388920
							倍面積	-1940.534014
							面積	970.2670070
							地積	970.26

## 画地面積(座標法)計算簿

画地番号：43- 8-1

点名	Xn	Yn	距離	方向角	X <sub>n+1</sub> -X <sub>n-1</sub>	Y <sub>n+1</sub> -Y <sub>n-1</sub>	X <sub>n</sub> *(Y <sub>n+1</sub> -Y <sub>n-1</sub> )	Y <sub>n</sub> *(X <sub>n+1</sub> -X <sub>n-1</sub> )
43-64	47625.477	-70837.309	35.191	176° 49' 54"	-36.366	-19.803	-943127.321031	2576069.579094
43-47	47590.339	-70835.364	21.775	86° 48' 53"	-33.928	23.687	1127272.359893	2403302.229792
43-85	47591.549	-70813.622	35.209	356° 50' 35"	36.366	19.803	942455.444847	-2575208.177652
43-84	47626.705	-70815.561	21.782	266° 46' 06"	33.928	-23.687	-1128133.761335	-2402630.353608
							倍面積	-1533.277626
							面積	766.6388130
							地積	766.63

## 画地面積(座標法)計算簿

画地番号：43- 8-2

点名	Xn	Yn	距離	方向角	X <sub>n+1</sub> -X <sub>n-1</sub>	Y <sub>n+1</sub> -Y <sub>n-1</sub>	X <sub>n</sub> *(Y <sub>n+1</sub> -Y <sub>n-1</sub> )	Y <sub>n</sub> *(X <sub>n+1</sub> -X <sub>n-1</sub> )
43-84	47626.705	-70815.561	35.209	176° 50' 35"	-35.339	-1.306	-62200.476730	2502551.110179
43-85	47591.549	-70813.622	3.251	86° 48' 30"	-34.975	5.185	246762.181565	2476706.429450
43-48	47591.730	-70810.376	35.211	356° 50' 30"	35.339	1.306	62154.799380	-2502367.877464
43-65	47626.888	-70812.316	3.250	266° 46' 20"	34.975	-5.185	-246945.414280	-2476660.752100
							倍面積	-228.910065
							面積	114.4550325
							地積	114.45

## 画地面積(座標法)計算簿

画地番号：43- 9

点名	Xn	Yn	距離	方向角	X <sub>n+1</sub> -X <sub>n-1</sub>	Y <sub>n+1</sub> -Y <sub>n-1</sub>	X <sub>n</sub> *(Y <sub>n+1</sub> -Y <sub>n-1</sub> )	Y <sub>n</sub> *(X <sub>n+1</sub> -X <sub>n-1</sub> )
43-47	47590.339	-70835.364	35.191	356° 49' 54"	36.429	21.158	1006916.392562	-2580461.475156
43-64	47625.477	-70837.309	0.461	356° 53' 45"	35.599	-1.970	-93822.189690	-2521737.363091
43-63	47625.938	-70837.334	18.396	266° 46' 51"	-0.572	-18.392	-875936.251696	40518.955048
43-62	47624.905	-70855.701	19.853	266° 46' 50"	-2.148	-38.189	-1818747.497045	152198.045748
43-58	47623.790	-70875.523	10.023	171° 19' 27"	-11.024	-18.310	-871991.594900	781331.765552
43-81	47613.881	-70874.011	0.577	171° 20' 12"	-10.480	1.599	76134.595719	742759.635280
43-57	47613.310	-70873.924	4.281	171° 19' 16"	-4.803	0.733	34900.556230	340407.456972
43-56	47609.078	-70873.278	9.819	81° 37' 35"	-2.802	10.361	493277.657158	198586.924956
43-79	47610.508	-70863.563	1.964	81° 37' 51"	1.716	11.659	555090.912772	-121601.874108
43-18	47610.794	-70861.619	21.973	171° 45' 09"	-21.460	5.096	242624.606224	1520690.343740
43- 8	47589.048	-70858.467	23.139	86° 48' 06"	-20.455	26.255	1249450.455240	1449409.942485
							倍面積	-2102.357426
							面積	1051.1787130
							地積	1051.17

## 画地面積(座標法)計算簿

画地番号：43-10

点名	Xn	Yn	距離	方向角	X <sub>n+1</sub> -X <sub>n-1</sub>	Y <sub>n+1</sub> -Y <sub>n-1</sub>	X <sub>n</sub> *(Y <sub>n+1</sub> -Y <sub>n-1</sub> )	Y <sub>n</sub> *(X <sub>n+1</sub> -X <sub>n-1</sub> )
43- 8	47589.048	-70858.467	21.973	351° 45' 09"	21.856	-1.182	-56250.254736	-1548682.654752
43-18	47610.794	-70861.619	1.964	261° 37' 51"	21.460	-5.096	-242624.606224	-1520690.343740
43-79	47610.508	-70863.563	21.795	171° 45' 14"	-21.856	1.182	56275.620456	1548794.032928
43-78	47588.938	-70860.437	1.973	86° 48' 15"	-21.460	5.096	242513.228048	1520664.978020
							倍面積	-86.012456
							面積	43.0062280
							地積	43.00

## 画地面積(座標法)計算簿

画地番号：43-11

点名	Xn	Yn	距離	方向角	X <sub>n+1</sub> -X <sub>n-1</sub>	Y <sub>n+1</sub> -Y <sub>n-1</sub>	X <sub>n</sub> *(Y <sub>n+1</sub> -Y <sub>n-1</sub> )	Y <sub>n</sub> *(X <sub>n+1</sub> -X <sub>n-1</sub> )
43-79	47610.508	-70863.563	9.819	261° 37' 35"	20.140	-12.841	-611366.533228	-1427192.158820
43-56	47609.078	-70873.278	5.921	261° 37' 45"	-2.292	-15.573	-741416.171694	162441.553176
43-16	47608.216	-70879.136	1.753	171° 50' 15"	-2.598	-5.609	-267034.483544	184143.995328
43-15	47606.480	-70878.887	1.939	171° 50' 56"	-3.656	0.524	24945.795520	259133.210872
43-77	47604.560	-70878.612	16.669	171° 51' 14"	-18.421	2.637	125533.224720	1305654.911652
43-7	47588.059	-70876.250	15.837	86° 49' 06"	-15.622	18.175	864912.972325	1107228.777500
43-78	47588.938	-70860.437	21.795	351° 45' 14"	22.449	12.687	603760.856406	-1590745.950213
							倍面積	-664.339495
							面積	332.1697475
							地積	332.16

## 画地面積(座標法)計算簿

画地番号：43-12

点名	Xn	Yn	距離	方向角	X <sub>n+1</sub> -X <sub>n-1</sub>	Y <sub>n+1</sub> -Y <sub>n-1</sub>	X <sub>n</sub> *(Y <sub>n+1</sub> -Y <sub>n-1</sub> )	Y <sub>n</sub> *(X <sub>n+1</sub> -X <sub>n-1</sub> )
43- 7	47588.059	-70876.250	16.669	351° 51' 14"	16.671	0.776	36928.333784	-1181577.963750
43-77	47604.560	-70878.612	31.943	261° 48' 26"	11.949	-33.979	-1617555.344240	-846928.534788
43-76	47600.008	-70910.229	14.368	170° 11' 41"	-18.711	-29.170	-1388492.233360	1326801.294819
43- 1	47585.849	-70907.782	4.001	125° 23' 52"	-16.477	5.709	271667.611941	1168347.524014
43- 2	47583.531	-70904.520	25.507	80° 09' 45"	2.040	28.394	1351086.779214	-144645.220800
43- 3	47587.889	-70879.388	3.142	86° 53' 57"	4.528	28.270	1345309.622030	-320941.868864
							倍面積	-1055.230631
							面積	527.6153155
							地積	527.61

## 画地面積(座標法)計算簿

画地番号：43-13

点名	Xn	Yn	距離	方向角	X <sub>n+1</sub> -X <sub>n-1</sub>	Y <sub>n+1</sub> -Y <sub>n-1</sub>	X <sub>n</sub> *(Y <sub>n+1</sub> -Y <sub>n-1</sub> )	Y <sub>n</sub> *(X <sub>n+1</sub> -X <sub>n-1</sub> )
43-15	47606.480	-70878.887	31.998	261° 48' 26"	-2.640	-31.947	-1520884.216560	187120.261680
43-14	47601.920	-70910.559	1.940	170° 12' 27"	-6.472	-31.342	-1491939.376640	458933.137848
43-76	47600.008	-70910.229	31.943	81° 48' 26"	2.640	31.947	1520677.455576	-187203.004560
43-77	47604.560	-70878.612	1.939	351° 50' 56"	6.472	31.342	1492022.119520	-458726.376864
							倍面積	-124.018104
							面積	62.0090520
							地積	62.00



## 画地面積(座標法)計算簿

画地番号：43-14

点名	Xn	Yn	距離	方向角	X <sub>n+1</sub> -X <sub>n-1</sub>	Y <sub>n+1</sub> -Y <sub>n-1</sub>	X <sub>n</sub> *(Y <sub>n+1</sub> -Y <sub>n-1</sub> )	Y <sub>n</sub> *(X <sub>n+1</sub> -X <sub>n-1</sub> )
43-13	47603.649	-70910.858	1.754	170° 11' 19"	-6.296	-31.423	-1495849.462527	446454.761968
43-14	47601.920	-70910.559	31.998	81° 48' 26"	2.831	31.971	1521880.984320	-200747.792529
43-15	47606.480	-70878.887	1.753	351° 50' 15"	6.296	31.423	1495938.421040	-446253.472552
43-16	47608.216	-70879.136	32.049	261° 48' 27"	-2.831	-31.971	-1522082.273736	200658.834016
							倍面積	-112.330903
							面積	56.1654515
							地積	56.16

## 画地面積(座標法)計算簿

画地番号：43-15

点名	Xn	Yn	距離	方向角	X <sub>n+1</sub> -X <sub>n-1</sub>	Y <sub>n+1</sub> -Y <sub>n-1</sub>	X <sub>n</sub> *(Y <sub>n+1</sub> -Y <sub>n-1</sub> )	Y <sub>n</sub> *(X <sub>n+1</sub> -X <sub>n-1</sub> )
43-16	47608.216	-70879.136	5.921	81° 37' 45"	5.429	37.580	1789116.757280	-384802.829344
43-56	47609.078	-70873.278	4.281	351° 19' 16"	5.094	5.212	248138.514536	-361028.478132
43-57	47613.310	-70873.924	38.055	261° 46' 42"	-1.210	-38.310	-1824065.906100	85757.448040
43-55	47607.868	-70911.588	4.281	170° 11' 01"	-9.661	-36.934	-1758348.996712	685076.851668
43-13	47603.649	-70910.858	32.049	81° 48' 27"	0.348	32.452	1544833.617348	-24676.978584
							倍面積	-326.013648
							面積	163.0068240
							地積	163.00

## 画地面積(座標法)計算簿

画地番号：43-16

点名	Xn	Yn	距離	方向角	X <sub>n+1</sub> -X <sub>n-1</sub>	Y <sub>n+1</sub> -Y <sub>n-1</sub>	X <sub>n</sub> *(Y <sub>n+1</sub> -Y <sub>n-1</sub> )	Y <sub>n</sub> *(X <sub>n+1</sub> -X <sub>n-1</sub> )
43-80	47608.437	-70911.695	0.578	169° 21' 00"	-6.013	-37.577	-1788982.237149	426392.022035
43-55	47607.868	-70911.588	38.055	81° 46' 42"	4.873	37.771	1798196.782228	-345552.168324
43-57	47613.310	-70873.924	0.577	351° 20' 12"	6.013	37.577	1789165.349870	-426164.905012
43-81	47613.881	-70874.011	38.075	261° 46' 47"	-4.873	-37.771	-1798423.899251	345369.055603
							倍面積	-44.004302
							面積	22.0021510
							地積	22.00

## 画地面積(座標法)計算簿

画地番号：43-17

点名	X <sub>n</sub>	Y <sub>n</sub>	距離	方向角	X <sub>n+1</sub> -X <sub>n-1</sub>	Y <sub>n+1</sub> -Y <sub>n-1</sub>	X <sub>n</sub> *(Y <sub>n+1</sub> -Y <sub>n-1</sub> )	Y <sub>n</sub> *(X <sub>n+1</sub> -X <sub>n-1</sub> )
43-70	47627.628	-70915.009	19.475	170° 12' 09"	-20.803	-12.751	-607299.884628	1475244.932227
43-80	47608.437	-70911.695	38.075	81° 46' 47"	-13.747	40.998	1951850.700126	974823.071165
43-81	47613.881	-70874.011	10.023	351° 19' 27"	15.353	36.172	1722289.303532	-1088128.690883
43-58	47623.790	-70875.523	7.763	351° 19' 04"	17.584	-2.684	-127822.252360	-1246275.196432
43-71	47631.465	-70876.695	1.390	264° 15' 53"	7.536	-2.556	-121746.024540	-534126.773520
43-72	47631.326	-70878.079	15.993	264° 17' 53"	-1.728	-17.298	-823926.677148	122477.320512
43-74	47629.737	-70893.993	4.975	264° 16' 03"	-2.086	-20.865	-993794.462505	147884.869398
43-83	47629.240	-70898.944	16.145	264° 16' 12"	-2.109	-21.016	-1000976.107840	149525.872896
							倍面積	-1425.405363
							面積	712.7026815
							地積	712.70