



# 44街区 画地出来形確認図 (2840.07m<sup>2</sup>)

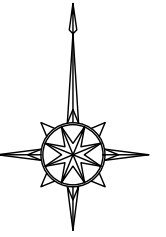

S=1:500

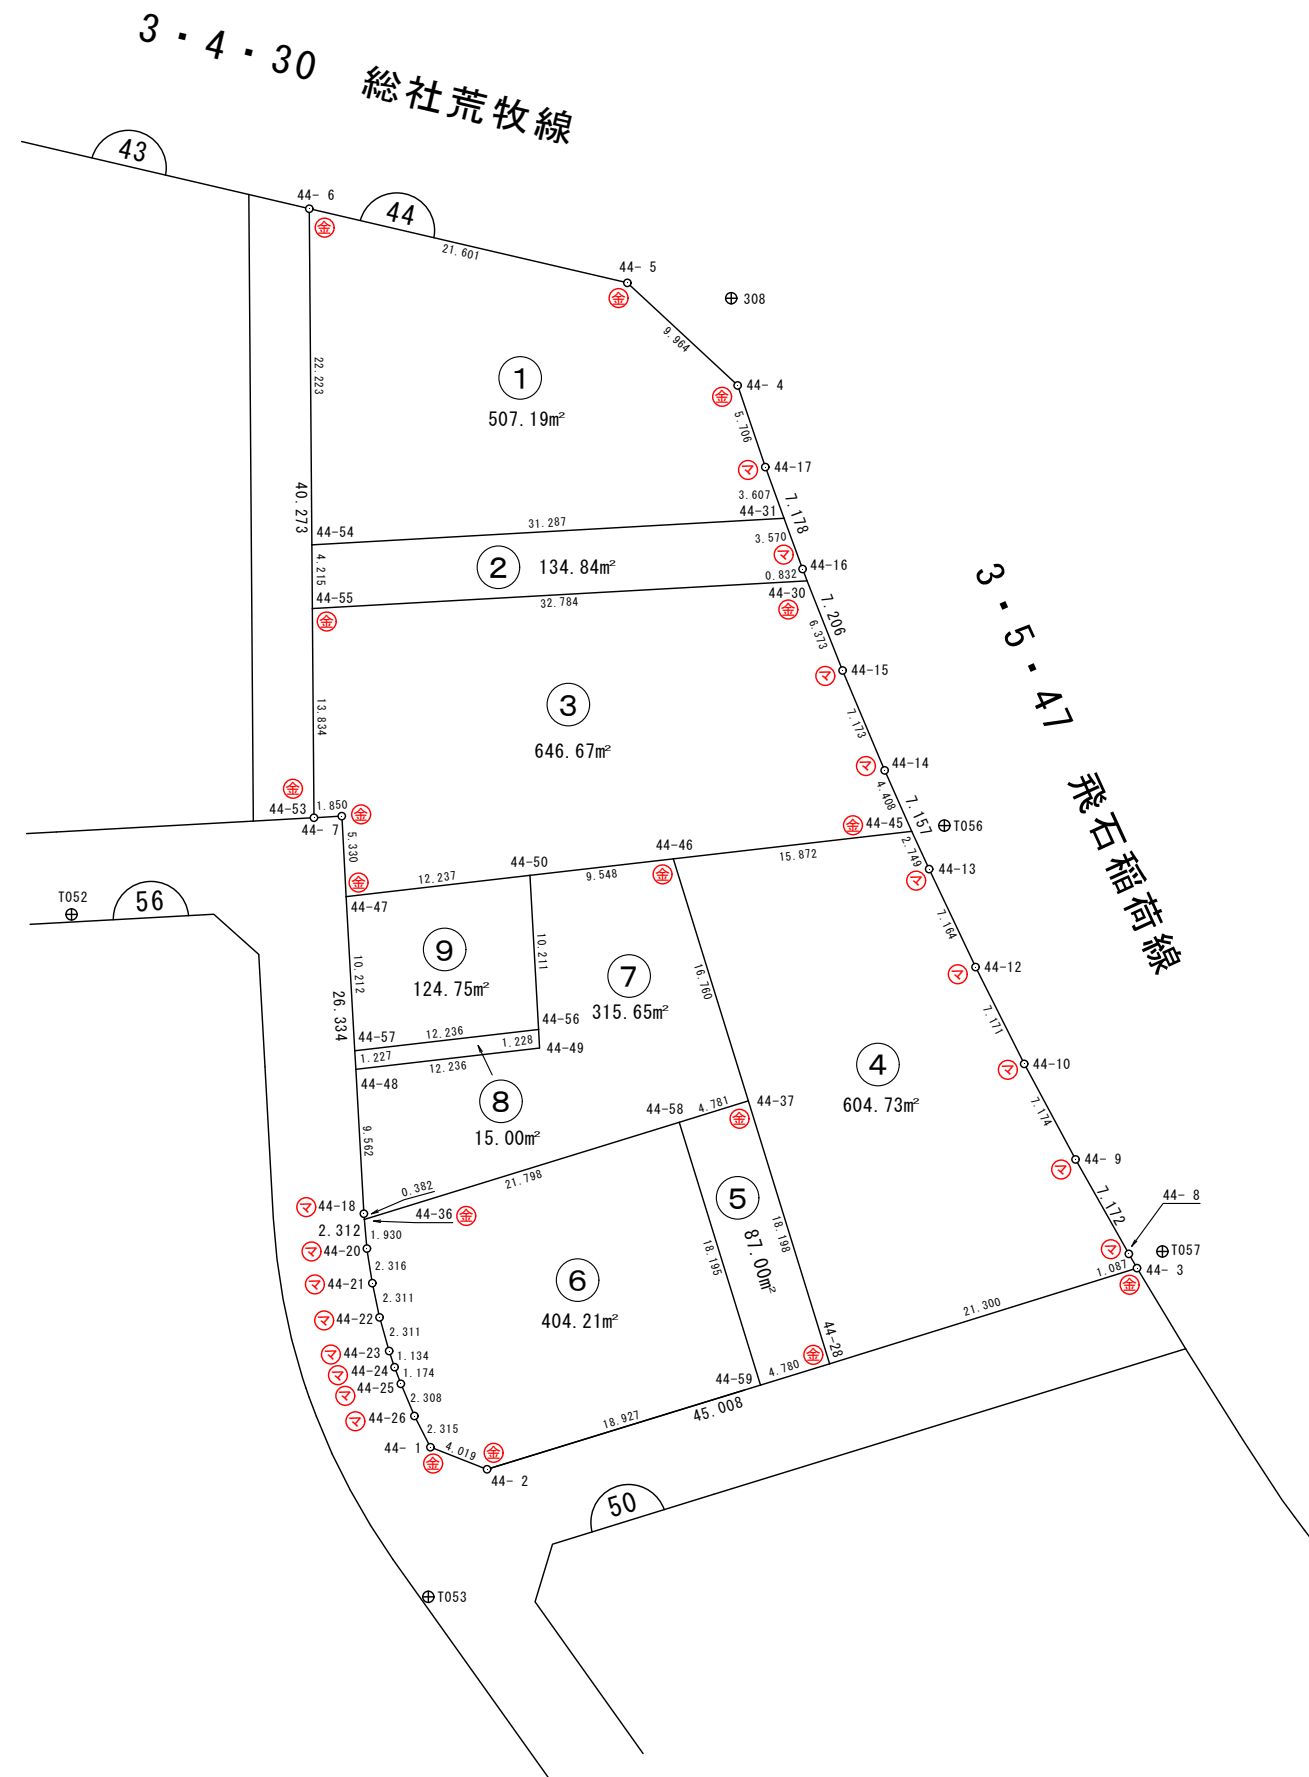

凡 例	
事 項	記 号
金属プレート	⊕
コンクリート杭	⊙
金属 鈎	⊗
合成樹脂杭	⊕
マーキング	⊗

## 画地面積(座標法)計算簿

画地番号：44- 1

点名	Xn	Yn	距離	方向角	X <sub>n+1</sub> -X <sub>n-1</sub>	Y <sub>n+1</sub> -Y <sub>n-1</sub>	X <sub>n</sub> *(Y <sub>n+1</sub> -Y <sub>n-1</sub> )	Y <sub>n</sub> *(X <sub>n+1</sub> -X <sub>n-1</sub> )
44- 6	47632.940	-70793.647	22.223	179° 34' 19"	-17.326	-20.873	-994242.356620	1226570.727922
44-54	47610.717	-70793.481	31.287	86° 47' 50"	-20.475	31.405	1495214.567385	1449496.523475
44-31	47612.465	-70762.242	3.607	339° 56' 52"	5.137	30.002	1428469.174930	-363505.637154
44-17	47615.854	-70763.479	5.706	341° 17' 08"	8.794	-3.068	-146085.440072	-622294.034326
44- 4	47621.259	-70765.310	9.964	312° 54' 35"	12.189	-9.129	-434734.473411	-862558.363590
44- 5	47628.043	-70772.608	21.601	283° 06' 10"	11.681	-28.337	-1349635.854491	-826694.834048
							倍面積	-1014.382279
							面積	507.1911395
							地積	507.19

## 画地面積(座標法)計算簿

画地番号：44- 2

点名	Xn	Yn	距離	方向角	X <sub>n+1</sub> -X <sub>n-1</sub>	Y <sub>n+1</sub> -Y <sub>n-1</sub>	X <sub>n</sub> *(Y <sub>n+1</sub> -Y <sub>n-1</sub> )	Y <sub>n</sub> *(X <sub>n+1</sub> -X <sub>n-1</sub> )
44-55	47606.502	-70793.450	32.784	86° 47' 48"	-2.383	32.764	1559779.431528	168700.791350
44-30	47608.334	-70760.717	0.832	338° 53' 18"	2.609	32.433	1544081.096622	-184614.710653
44-16	47609.111	-70761.017	3.570	339° 56' 10"	4.131	-1.525	-72603.894275	-292313.761227
44-31	47612.465	-70762.242	31.287	266° 47' 50"	1.606	-32.464	-1545691.063760	-113644.160652
44-54	47610.717	-70793.481	4.215	179° 34' 43"	-5.963	-31.208	-1485835.256136	422141.527203
							倍面積	-269.686021
							面積	134.8430105
							地積	134.84

## 画地面積(座標法)計算簿

画地番号：44- 3

点名	Xn	Yn	距離	方向角	X <sub>n+1</sub> -X <sub>n-1</sub>	Y <sub>n+1</sub> -Y <sub>n-1</sub>	X <sub>n</sub> *(Y <sub>n+1</sub> -Y <sub>n-1</sub> )	Y <sub>n</sub> *(X <sub>n+1</sub> -X <sub>n-1</sub> )
44-30	47608.334	-70760.717	32.784	266° 47' 48"	4.096	-35.074	-1669814.706716	-289835.896832
44-55	47606.502	-70793.450	13.834	179° 32' 55"	-15.666	-32.624	-1553114.521248	1109050.187700
44-53	47592.668	-70793.341	1.850	86° 39' 13"	-13.726	1.956	93091.258608	971709.398566
44- 7	47592.776	-70791.494	5.330	176° 56' 07"	-5.215	2.132	101467.798432	369177.641210
44-47	47587.453	-70791.209	12.237	83° 24' 44"	-3.919	12.442	592083.090226	277430.748071
44-50	47588.857	-70779.052	9.548	83° 24' 31"	2.500	21.642	1029918.043194	-176947.630000
44-46	47589.953	-70769.567	15.872	83° 26' 16"	2.910	25.254	1201836.673062	-205939.439970
44-45	47591.767	-70753.798	4.408	336° 02' 44"	5.843	13.979	665285.310893	-413414.441714
44-14	47595.796	-70755.588	7.173	337° 07' 51"	10.639	-4.578	-217893.554088	-752768.700732
44-15	47602.406	-70758.376	6.373	338° 27' 02"	12.538	-5.129	-244152.740374	-887168.518288
<b>倍面積</b>								-1293.348011
<b>面積</b>								646.6740055
<b>地積</b>								646.67

## 画地面積(座標法)計算簿

画地番号：44- 4

点名	Xn	Yn	距離	方向角	X <sub>n+1</sub> -X <sub>n-1</sub>	Y <sub>n+1</sub> -Y <sub>n-1</sub>	X <sub>n</sub> *(Y <sub>n+1</sub> -Y <sub>n-1</sub> )	Y <sub>n</sub> *(X <sub>n+1</sub> -X <sub>n-1</sub> )
44-45	47591.767	-70753.798	15.872	263° 26' 16"	0.682	-16.921	-805300.289407	-48254.090236
44-46	47589.953	-70769.567	16.760	162° 47' 51"	-17.825	-10.812	-514542.571836	1261467.531775
44-37	47573.942	-70764.610	18.198	162° 49' 04"	-33.397	10.333	491581.542686	2363325.680170
44-28	47556.556	-70759.234	21.300	72° 43' 34"	-11.061	25.716	1222964.394096	782667.887274
44- 3	47562.881	-70738.894	1.087	330° 16' 29"	7.269	19.801	941792.606681	-514201.020486
44- 8	47563.825	-70739.433	7.172	330° 31' 32"	7.188	-4.068	-193489.640100	-508475.044404
44- 9	47570.069	-70742.962	7.174	331° 46' 40"	12.566	-6.922	-329280.017618	-888956.060492
44-10	47576.391	-70746.355	7.171	333° 17' 31"	12.728	-6.616	-314765.402856	-900459.606440
44-12	47582.797	-70749.578	7.164	334° 38' 38"	12.880	-6.291	-299343.375927	-911254.564640
44-13	47589.271	-70752.646	2.749	335° 13' 29"	8.970	-4.220	-200826.723620	-634651.234620
							倍面積	-1209.477901
							面積	604.7389505
							地積	604.73

## 画地面積(座標法)計算簿

画地番号：44- 5

点名	Xn	Yn	距離	方向角	X <sub>n+1</sub> -X <sub>n-1</sub>	Y <sub>n+1</sub> -Y <sub>n-1</sub>	X <sub>n</sub> *(Y <sub>n+1</sub> -Y <sub>n-1</sub> )	Y <sub>n</sub> *(X <sub>n+1</sub> -X <sub>n-1</sub> )
44-28	47556.556	-70759.234	18.198	342° 49' 04"	18.793	-0.807	-38378.140692	-1329778.284562
44-37	47573.942	-70764.610	4.781	252° 50' 59"	15.976	-9.945	-473122.853190	-1130535.409360
44-58	47572.532	-70769.179	18.195	162° 48' 53"	-18.793	0.807	38391.033324	1329965.180947
44-59	47555.149	-70763.803	4.780	72° 53' 03"	-15.976	9.945	472935.956805	1130522.516728
<b>倍面積</b>								-174.003753
<b>面積</b>								87.0018765
<b>地積</b>								87.00

## 画地面積(座標法)計算簿

画地番号：44- 6

点名	Xn	Yn	距離	方向角	X <sub>n+1</sub> -X <sub>n-1</sub>	Y <sub>n+1</sub> -Y <sub>n-1</sub>	X <sub>n</sub> *(Y <sub>n+1</sub> -Y <sub>n-1</sub> )	Y <sub>n</sub> *(X <sub>n+1</sub> -X <sub>n-1</sub> )
44-59	47555.149	-70763.803	18.195	342° 48' 53"	22.954	12.713	604568.609237	-1624312.334062
44-58	47572.532	-70769.179	21.798	252° 50' 28"	10.952	-26.204	-1246590.628528	-775064.048408
44-36	47566.101	-70790.007	1.930	175° 05' 45"	-8.354	-20.663	-982858.344963	591379.718478
44-20	47564.178	-70789.842	2.316	171° 03' 30"	-4.211	0.525	24971.193450	298096.024662
44-21	47561.890	-70789.482	2.311	167° 57' 57"	-4.549	0.842	40047.111380	322021.353618
44-22	47559.629	-70789.000	2.311	164° 07' 46"	-4.484	1.114	52981.426706	317417.876000
44-23	47557.406	-70788.368	1.134	161° 27' 12"	-3.299	0.993	47224.504158	233530.826032
44-24	47556.330	-70788.007	1.174	159° 12' 15"	-2.174	0.778	36998.824740	153893.127218
44-25	47555.232	-70787.590	2.308	157° 04' 42"	-3.224	1.316	62582.685312	228219.190160
44-26	47553.106	-70786.691	2.315	152° 50' 14"	-4.186	1.956	93013.875336	296313.088526
44- 1	47551.046	-70785.634	4.019	111° 25' 13"	-3.528	4.799	228197.469754	249731.716752
44- 2	47549.578	-70781.892	18.927	72° 52' 56"	4.103	21.831	1038054.837318	-290418.102876
							倍面積	-808.436100
							面積	404.2180500
							地積	404.21

## 画地面積(座標法)計算簿

画地番号：44- 7

点名	Xn	Yn	距離	方向角	X <sub>n+1</sub> -X <sub>n-1</sub>	Y <sub>n+1</sub> -Y <sub>n-1</sub>	X <sub>n</sub> *(Y <sub>n+1</sub> -Y <sub>n-1</sub> )	Y <sub>n</sub> *(X <sub>n+1</sub> -X <sub>n-1</sub> )
44-37	47573.942	-70764.610	16.760	342° 47' 51"	17.421	-0.388	-18458.689496	-1232790.270810
44-46	47589.953	-70769.567	9.548	263° 24' 31"	14.915	-14.442	-687294.101226	-1055528.091805
44-50	47588.857	-70779.052	10.211	176° 48' 41"	-11.292	-8.917	-424349.837869	799237.055184
44-56	47578.661	-70778.484	1.228	176° 49' 41"	-11.423	0.636	30260.028396	808502.622732
44-49	47577.434	-70778.416	12.236	263° 24' 42"	-2.631	-12.088	-575116.022192	186218.012496
44-48	47576.030	-70790.572	9.562	176° 48' 39"	-10.952	-11.624	-553023.772720	775298.344544
44-18	47566.482	-70790.040	0.382	175° 02' 59"	-9.929	0.565	26875.062330	702874.307160
44-36	47566.101	-70790.007	21.798	72° 50' 28"	6.050	20.861	992276.432961	-428279.542350
44-58	47572.532	-70769.179	4.781	72° 50' 59"	7.841	25.397	1208199.595204	-554901.132539
							倍面積	-631.304612
							面積	315.6523060
							地積	315.65



## 画地面積(座標法)計算簿

画地番号：44- 8

点名	Xn	Yn	距離	方向角	X <sub>n+1</sub> -X <sub>n-1</sub>	Y <sub>n+1</sub> -Y <sub>n-1</sub>	X <sub>n</sub> *(Y <sub>n+1</sub> -Y <sub>n-1</sub> )	Y <sub>n</sub> *(X <sub>n+1</sub> -X <sub>n-1</sub> )
44-48	47576.030	-70790.572	12.236	83° 24' 42"	0.178	12.224	581569.390720	-12600.721816
44-49	47577.434	-70778.416	1.228	356° 49' 41"	2.631	12.088	575116.022192	-186218.012496
44-56	47578.661	-70778.484	12.236	263° 24' 25"	-0.178	-12.224	-581601.552064	12598.570152
44-57	47577.256	-70790.640	1.227	176° 49' 31"	-2.631	-12.088	-575113.870528	186250.173840
							倍面積	-30.009680
							面積	15.0048400
							地積	15.00

## 画地面積(座標法)計算簿

画地番号：44- 9

点名	Xn	Yn	距離	方向角	X <sub>n+1</sub> -X <sub>n-1</sub>	Y <sub>n+1</sub> -Y <sub>n-1</sub>	X <sub>n</sub> *(Y <sub>n+1</sub> -Y <sub>n-1</sub> )	Y <sub>n</sub> *(X <sub>n+1</sub> -X <sub>n-1</sub> )
44-47	47587.453	-70791.209	10.212	176° 48' 22"	-11.601	-11.588	-551443.405364	821248.815609
44-57	47577.256	-70790.640	12.236	83° 24' 25"	-8.792	12.725	605420.582600	622391.306880
44-56	47578.661	-70778.484	10.211	356° 48' 41"	11.601	11.588	551341.523668	-821101.192884
44-50	47588.857	-70779.052	12.237	263° 24' 44"	8.792	-12.725	-605568.205325	-622289.425184
<b>倍面積</b>								-249.504421
<b>面積</b>								124.7522105
<b>地積</b>								124.75