


60街区 画地出来形確認図 (4338.81m²)

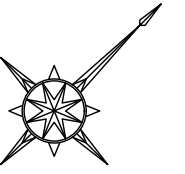


S=1:500



※⑥、⑦、⑧、⑨画地は分筆しています。次ページで確認してください。

| 凡 例 | |
|---------|-----|
| 事 項 | 記 号 |
| 金属プレート | ⊕ |
| コンクリート杭 | ⊖ |
| 金属 錐 | ⊗ |
| 合成樹脂杭 | ⊙ |
| マーキング | ⊚ |

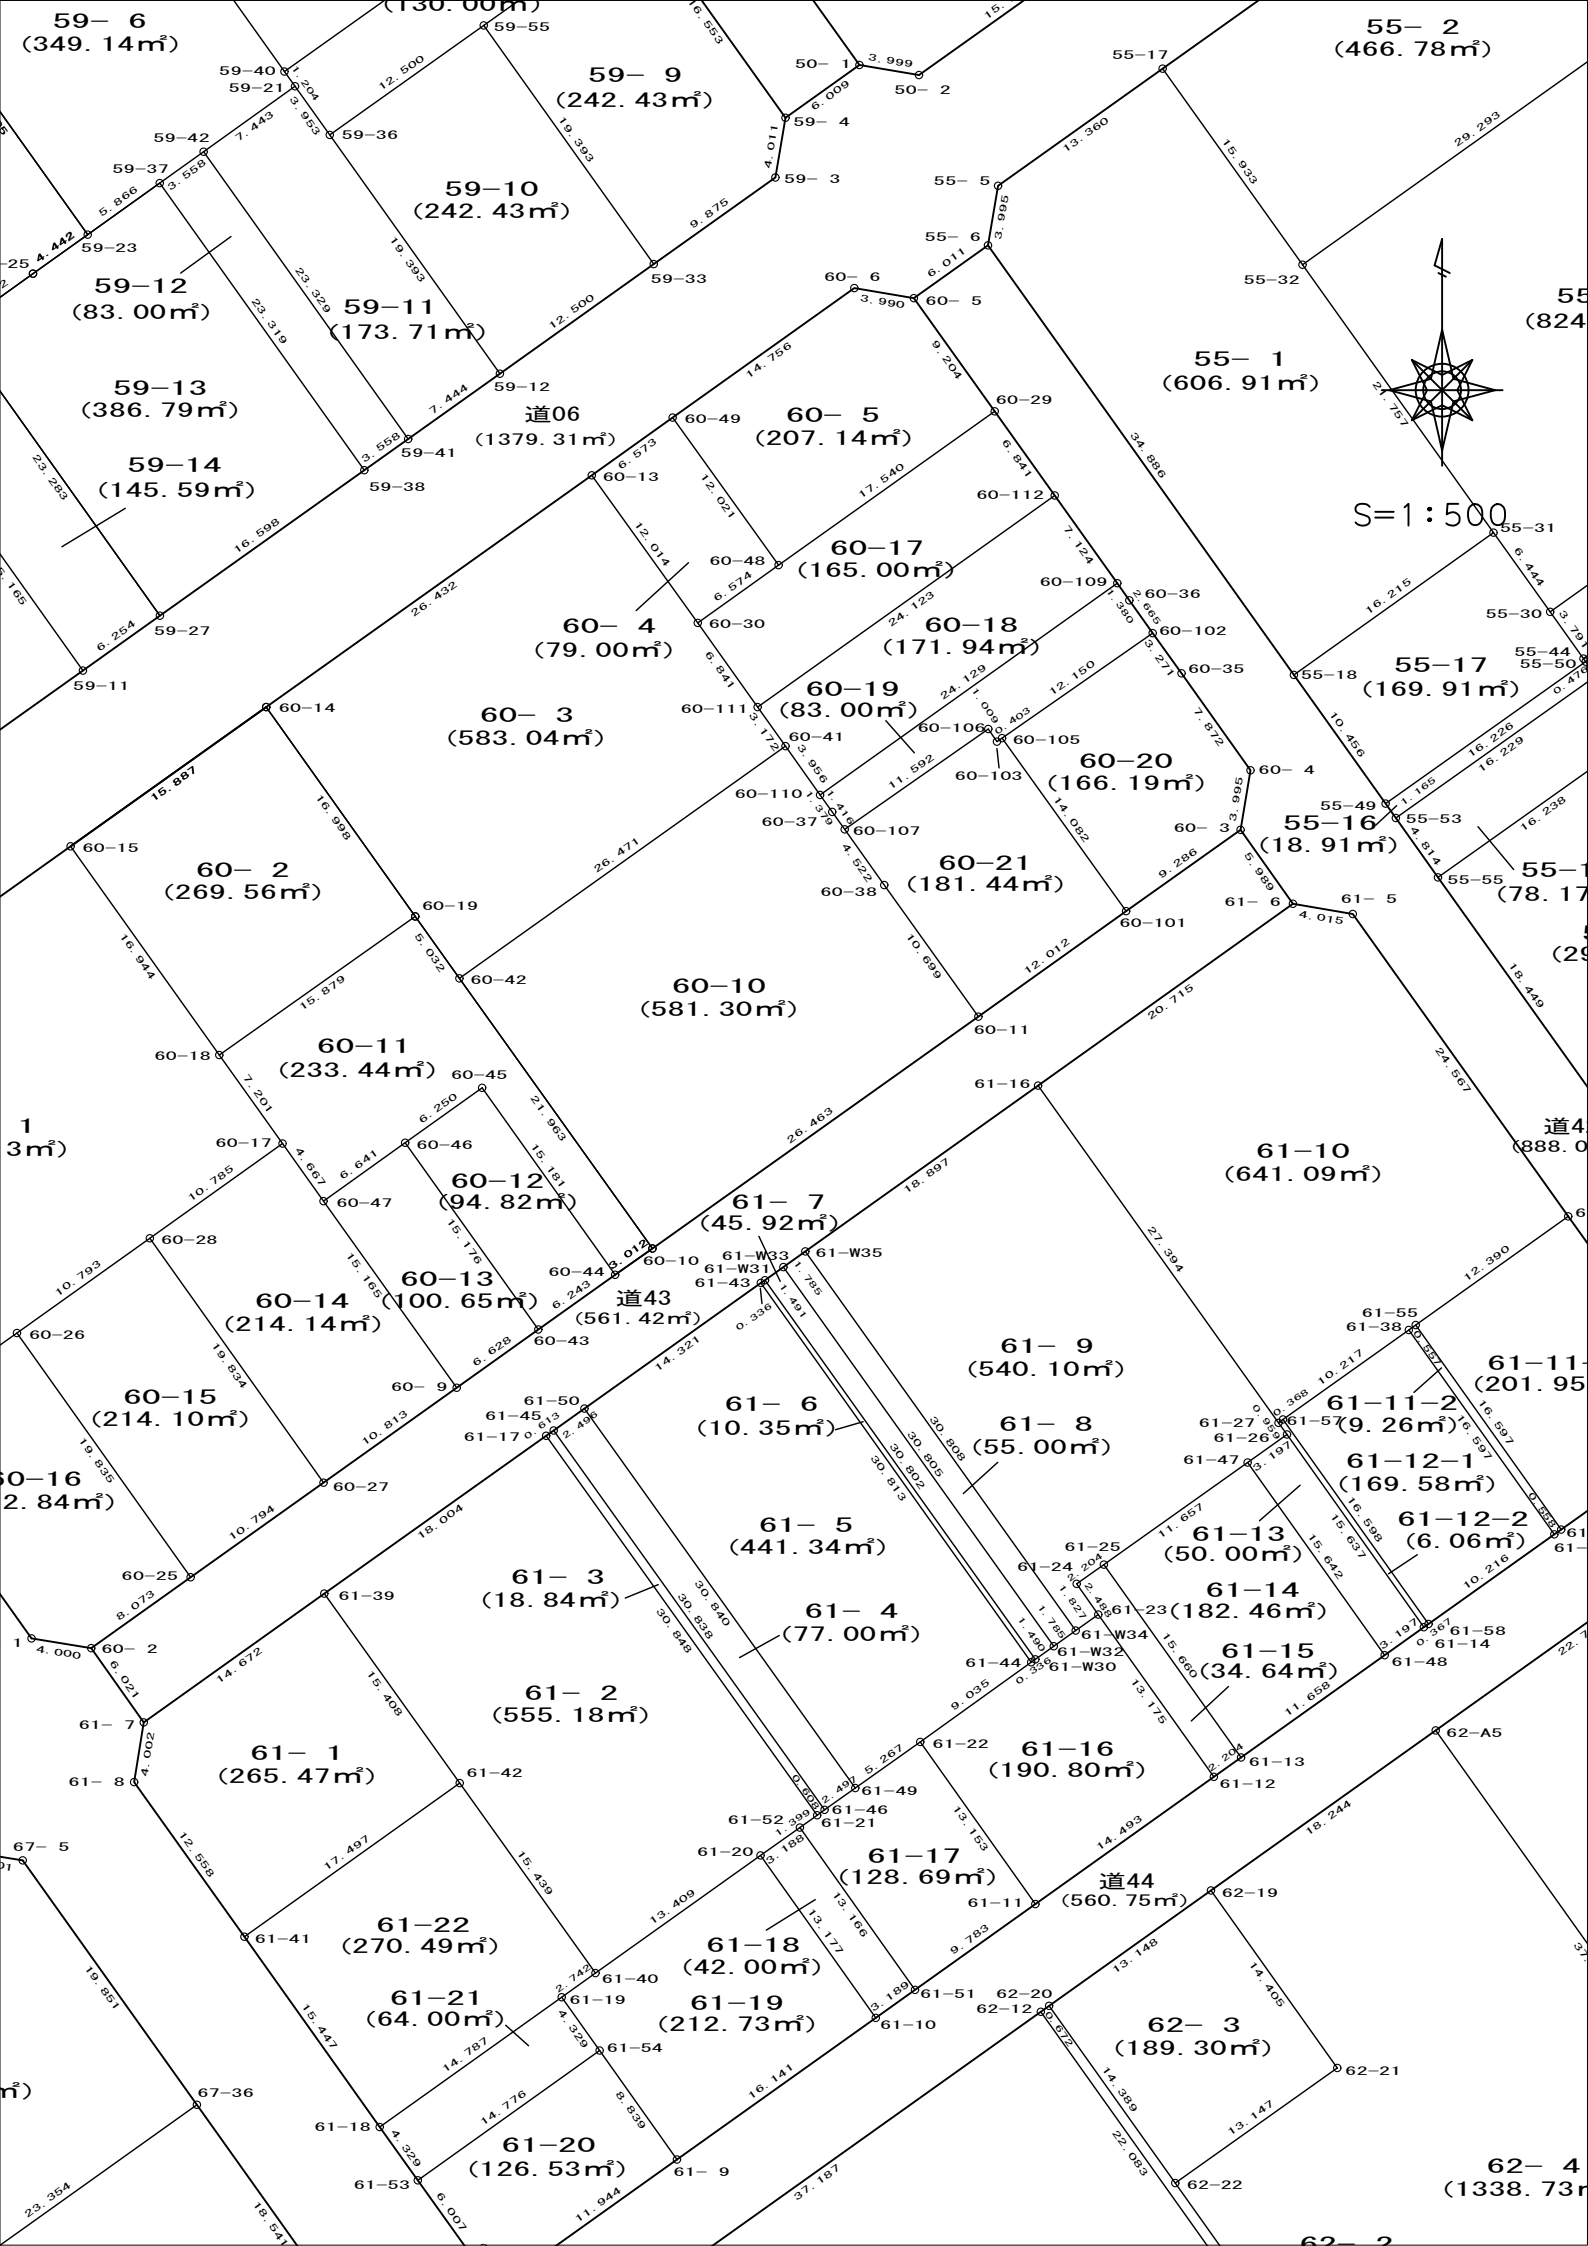

59-6
(349.14m²)

59-9
(242.43m²)

55-2
(466.78m²)

59-10
(242.43m²)

59-12
(83.00m²)

59-11
(173.71m²)

59-13
(386.79m²)

59-14
(145.59m²)

道06
(1379.31m²)

60-5
(207.14m²)

55-1
(606.91m²)

60-4
(79.00m²)

60-17
(165.00m²)

60-18
(171.94m²)

60-3
(583.04m²)

60-19
(83.00m²)

60-20
(166.19m²)

55-17
(169.91m²)

60-2
(269.56m²)

60-21
(181.44m²)

60-10
(581.30m²)

60-11
(233.44m²)

61-10
(641.09m²)

1
(3m²)

60-12
(94.82m²)

61-7
(45.92m²)

60-14
(214.14m²)

道43
(561.42m²)

61-9
(540.10m²)

61-6
(10.35m²)

61-8
(55.00m²)

60-16
(2.84m²)

60-13
(100.65m²)

61-5
(441.34m²)

61-13
(50.00m²)


61-3
(18.84m²)

61-4
(77.00m²)

61-14
(182.46m²)

61-2
(555.18m²)

61-1
(265.47m²)

61-16
(190.80m²)

61-15
(34.64m²)


61-22
(270.49m²)

61-17
(128.69m²)

道44
(560.75m²)

61-21
(64.00m²)

61-18
(42.00m²)

61-19
(212.73m²)

62-3
(189.30m²)


61-20
(126.53m²)

62-4
(1338.73m²)

画地面積(座標法)計算簿

画地番号：60- 1

| 点名 | Xn | Yn | 距離 | 方向角 | X _{n+1} -X _{n-1} | Y _{n+1} -Y _{n-1} | X _n *(Y _{n+1} -Y _{n-1}) | Y _n *(X _{n+1} -X _{n-1}) |
|-------|-----------|------------|--------|--------------|------------------------------------|------------------------------------|---|---|
| 60- 7 | 47365.579 | -70779.327 | 3.970 | 189° 37' 34" | -21.147 | -24.854 | -1177224.100466 | 1496770.428069 |
| 60- 8 | 47361.664 | -70779.991 | 21.325 | 144° 31' 33" | -21.282 | 11.712 | 554699.808768 | 1506339.768462 |
| 60-16 | 47344.297 | -70767.615 | 10.939 | 54° 40' 16" | -11.041 | 21.301 | 1008480.870397 | 781345.237215 |
| 60-26 | 47350.623 | -70758.690 | 10.793 | 54° 30' 49" | 12.592 | 17.714 | 838768.935822 | -890993.424480 |
| 60-28 | 47356.889 | -70749.901 | 10.785 | 54° 30' 49" | 12.527 | 17.571 | 832107.896619 | -886284.009827 |
| 60-17 | 47363.150 | -70741.119 | 7.201 | 324° 26' 34" | 12.120 | 4.594 | 217586.311100 | -857382.362280 |
| 60-18 | 47369.009 | -70745.307 | 16.944 | 324° 32' 27" | 19.661 | -14.018 | -664018.768162 | -1390923.480927 |
| 60-15 | 47382.811 | -70755.137 | 29.700 | 234° 32' 08" | -3.430 | -34.020 | -1611963.230220 | 242690.119910 |
| | | | | | | | 倍面積 | -1562.276142 |
| | | | | | | | 面積 | 781.1380710 |
| | | | | | | | 地積 | 781.13 |

画地面積(座標法)計算簿

画地番号：60- 2

| 点名 | Xn | Yn | 距離 | 方向角 | X _{n+1} -X _{n-1} | Y _{n+1} -Y _{n-1} | X _n *(Y _{n+1} -Y _{n-1}) | Y _n *(X _{n+1} -X _{n-1}) |
|-------|-----------|------------|--------|--------------|------------------------------------|------------------------------------|---|---|
| 60-15 | 47382.811 | -70755.137 | 16.944 | 144° 32' 27" | -23.021 | -3.109 | -147313.159399 | 1628854.008877 |
| 60-18 | 47369.009 | -70745.307 | 15.879 | 54° 43' 25" | -4.631 | 22.794 | 1079729.191146 | 327621.516717 |
| 60-19 | 47378.180 | -70732.343 | 16.998 | 324° 33' 58" | 23.021 | 3.109 | 147298.761620 | -1628329.268203 |
| 60-14 | 47392.030 | -70742.198 | 15.887 | 234° 31' 49" | 4.631 | -22.794 | -1080253.931820 | -327607.118938 |
| | | | | | | | 倍面積 | -539.138453 |
| | | | | | | | 面積 | 269.5692265 |
| | | | | | | | 地積 | 269.56 |

画地面積(座標法)計算簿

画地番号：60- 3

| 点名 | Xn | Yn | 距離 | 方向角 | X _{n+1} -X _{n-1} | Y _{n+1} -Y _{n-1} | X _n *(Y _{n+1} -Y _{n-1}) | Y _n *(X _{n+1} -X _{n-1}) |
|--------|-----------|------------|--------|--------------|------------------------------------|------------------------------------|---|---|
| 60-14 | 47392.030 | -70742.198 | 16.998 | 144° 33' 58" | -29.182 | -11.677 | -553396.734310 | 2064398.822036 |
| 60-19 | 47378.180 | -70732.343 | 5.032 | 144° 28' 42" | -17.946 | 12.779 | 605445.762220 | 1269362.627478 |
| 60-42 | 47374.084 | -70729.419 | 26.471 | 54° 32' 32" | 11.260 | 24.486 | 1160001.820824 | -796413.257940 |
| 60-41 | 47389.440 | -70707.857 | 3.172 | 324° 34' 17" | 17.941 | 19.723 | 934661.925120 | -1268569.662437 |
| 60-111 | 47392.025 | -70709.696 | 6.841 | 324° 34' 20" | 8.160 | -5.805 | -275110.705125 | -576991.119360 |
| 60-30 | 47397.600 | -70713.662 | 12.014 | 324° 20' 29" | 15.337 | -10.970 | -519951.672000 | -1084535.434094 |
| 60-13 | 47407.362 | -70720.666 | 26.432 | 234° 32' 49" | -5.570 | -28.536 | -1352816.482032 | 393914.109620 |
| | | | | | | | 倍面積 | -1166.085303 |
| | | | | | | | 面積 | 583.0426515 |
| | | | | | | | 地積 | 583.04 |

画地面積(座標法)計算簿

画地番号：60- 4

| 点名 | Xn | Yn | 距離 | 方向角 | X _{n+1} -X _{n-1} | Y _{n+1} -Y _{n-1} | X _n *(Y _{n+1} -Y _{n-1}) | Y _n *(X _{n+1} -X _{n-1}) |
|-------|-----------|------------|--------|--------------|------------------------------------|------------------------------------|---|---|
| 60-13 | 47407.362 | -70720.666 | 12.014 | 144° 20' 29" | -13.580 | 1.653 | 78364.369386 | 960386.644280 |
| 60-30 | 47397.600 | -70713.662 | 6.574 | 54° 33' 09" | -5.949 | 12.360 | 585834.336000 | 420675.575238 |
| 60-48 | 47401.413 | -70708.306 | 12.021 | 324° 20' 10" | 13.580 | -1.653 | -78354.535689 | -960218.795480 |
| 60-49 | 47411.180 | -70715.315 | 6.573 | 234° 29' 30" | 5.949 | -12.360 | -586002.184800 | -420685.408935 |
| | | | | | | | 倍面積 | -158.015103 |
| | | | | | | | 面積 | 79.0075515 |
| | | | | | | | 地積 | 79.00 |

画地面積(座標法)計算簿

画地番号：60- 5

| 点名 | Xn | Yn | 距離 | 方向角 | X _{n+1} -X _{n-1} | Y _{n+1} -Y _{n-1} | X _n *(Y _{n+1} -Y _{n-1}) | Y _n *(X _{n+1} -X _{n-1}) |
|-------|-----------|------------|--------|--------------|------------------------------------|------------------------------------|---|---|
| 60-49 | 47411.180 | -70715.315 | 12.021 | 144° 20' 10" | -18.332 | -5.007 | -237387.778260 | 1296353.154580 |
| 60-48 | 47401.413 | -70708.306 | 17.540 | 54° 32' 05" | 0.410 | 21.295 | 1009413.089835 | -28990.405460 |
| 60-29 | 47411.590 | -70694.020 | 9.204 | 324° 30' 26" | 17.671 | 8.942 | 423954.437780 | -1249234.027420 |
| 60- 5 | 47419.084 | -70699.364 | 3.990 | 279° 32' 08" | 8.155 | -9.279 | -440001.680436 | -576553.313420 |
| 60- 6 | 47419.745 | -70703.299 | 14.756 | 234° 31' 07" | -7.904 | -15.951 | -756392.352495 | 558838.875296 |
| | | | | | | | 倍面積 | -414.283576 |
| | | | | | | | 面積 | 207.1417880 |
| | | | | | | | 地積 | 207.14 |

画地面積(座標法)計算簿

画地番号：60-10

| 点名 | X _n | Y _n | 距離 | 方向角 | X _{n+1} -X _{n-1} | Y _{n+1} -Y _{n-1} | X _n *(Y _{n+1} -Y _{n-1}) | Y _n *(X _{n+1} -X _{n-1}) |
|--------|----------------|----------------|--------|--------------|------------------------------------|------------------------------------|---|---|
| 60-11 | 47371.550 | -70695.097 | 10.699 | 324° 25' 19" | 24.045 | 15.337 | 726537.462350 | -1699863.607365 |
| 60-38 | 47380.252 | -70701.322 | 4.522 | 324° 34' 38" | 12.387 | -8.846 | -419125.709192 | -875777.275614 |
| 60-107 | 47383.937 | -70703.943 | 1.416 | 324° 34' 14" | 4.839 | -3.442 | -163095.511154 | -342136.380177 |
| 60-37 | 47385.091 | -70704.764 | 1.379 | 324° 37' 00" | 2.279 | -1.620 | -76763.847420 | -161136.157156 |
| 60-110 | 47386.216 | -70705.563 | 3.956 | 324° 34' 00" | 4.349 | -3.093 | -146565.566088 | -307498.493487 |
| 60-41 | 47389.440 | -70707.857 | 26.471 | 234° 32' 32" | -12.132 | -23.856 | -1130522.480640 | 857827.721124 |
| 60-42 | 47374.084 | -70729.419 | 21.963 | 144° 28' 55" | -33.233 | -8.802 | -416986.687368 | 2350550.781627 |
| 60-10 | 47356.207 | -70716.659 | 26.463 | 54° 33' 55" | -2.534 | 34.322 | 1625359.736654 | 179196.013906 |
| | | | | | | | 倍面積 | -1162.602858 |
| | | | | | | | 面積 | 581.3014290 |
| | | | | | | | 地積 | 581.30 |

画地面積(座標法)計算簿

画地番号：60-11

| 点名 | Xn | Yn | 距離 | 方向角 | X _{n+1} -X _{n-1} | Y _{n+1} -Y _{n-1} | X _n *(Y _{n+1} -Y _{n-1}) | Y _n *(X _{n+1} -X _{n-1}) |
|-------|-----------|------------|--------|--------------|------------------------------------|------------------------------------|---|---|
| 60-18 | 47369.009 | -70745.307 | 7.201 | 144° 26' 34" | -15.030 | -8.776 | -415710.422984 | 1063301.964210 |
| 60-17 | 47363.150 | -70741.119 | 4.667 | 144° 33' 59" | -9.662 | 6.894 | 326521.556100 | 683500.691778 |
| 60-47 | 47359.347 | -70738.413 | 6.641 | 54° 24' 44" | 0.062 | 8.107 | 383942.226129 | -4385.781606 |
| 60-46 | 47363.212 | -70733.012 | 6.250 | 54° 31' 58" | 7.492 | 10.492 | 496934.820304 | -529931.725904 |
| 60-45 | 47366.839 | -70727.921 | 15.181 | 144° 34' 08" | -8.743 | 13.892 | 658020.127388 | 618374.213303 |
| 60-44 | 47354.469 | -70719.120 | 3.012 | 54° 46' 11" | -10.632 | 11.262 | 533306.029878 | 751885.683840 |
| 60-10 | 47356.207 | -70716.659 | 21.963 | 324° 28' 55" | 19.615 | -10.299 | -487721.575893 | -1387107.266285 |
| 60-42 | 47374.084 | -70729.419 | 5.032 | 324° 28' 42" | 21.973 | -15.684 | -743015.133456 | -1554137.523687 |
| 60-19 | 47378.180 | -70732.343 | 15.879 | 234° 43' 25" | -5.075 | -15.888 | -752744.523840 | 358966.640725 |
| | | | | | | | 倍面積 | -466.896374 |
| | | | | | | | 面積 | 233.4481870 |
| | | | | | | | 地積 | 233.44 |

画地面積(座標法)計算簿

画地番号：60-12

| 点名 | Xn | Yn | 距離 | 方向角 | X _{n+1} -X _{n-1} | Y _{n+1} -Y _{n-1} | X _n *(Y _{n+1} -Y _{n-1}) | Y _n *(X _{n+1} -X _{n-1}) |
|------------|-----------|------------|--------|--------------|------------------------------------|------------------------------------|---|---|
| 60-46 | 47363.212 | -70733.012 | 15.176 | 144° 32' 32" | -15.989 | 3.713 | 175859.606156 | 1130950.128868 |
| 60-43 | 47350.850 | -70724.208 | 6.243 | 54° 34' 35" | -8.743 | 13.892 | 657798.008200 | 618341.750544 |
| 60-44 | 47354.469 | -70719.120 | 15.181 | 324° 34' 08" | 15.989 | -3.713 | -175827.143397 | -1130728.009680 |
| 60-45 | 47366.839 | -70727.921 | 6.250 | 234° 31' 58" | 8.743 | -13.892 | -658020.127388 | -618374.213303 |
| 倍面積 | | | | | | | | -189.656429 |
| 面積 | | | | | | | | 94.8282145 |
| 地積 | | | | | | | | 94.82 |

画地面積(座標法)計算簿

画地番号：60-13

| 点名 | Xn | Yn | 距離 | 方向角 | X _{n+1} -X _{n-1} | Y _{n+1} -Y _{n-1} | X _n *(Y _{n+1} -Y _{n-1}) | Y _n *(X _{n+1} -X _{n-1}) |
|-------|-----------|------------|--------|--------------|------------------------------------|------------------------------------|---|---|
| 60-47 | 47359.347 | -70738.413 | 15.165 | 144° 29' 33" | -16.210 | 3.407 | 161353.295229 | 1146669.674730 |
| 60- 9 | 47347.002 | -70729.605 | 6.628 | 54° 30' 42" | -8.497 | 14.205 | 672564.163410 | 600989.453685 |
| 60-43 | 47350.850 | -70724.208 | 15.176 | 324° 32' 32" | 16.210 | -3.407 | -161324.345950 | -1146439.411680 |
| 60-46 | 47363.212 | -70733.012 | 6.641 | 234° 24' 44" | 8.497 | -14.205 | -672794.426460 | -601018.402964 |
| | | | | | | | 倍面積 | -201.313771 |
| | | | | | | | 面積 | 100.6568855 |
| | | | | | | | 地積 | 100.65 |

画地面積(座標法)計算簿

画地番号：60-14

| 点名 | Xn | Yn | 距離 | 方向角 | X _{n+1} -X _{n-1} | Y _{n+1} -Y _{n-1} | X _n *(Y _{n+1} -Y _{n-1}) | Y _n *(X _{n+1} -X _{n-1}) |
|-------|-----------|------------|--------|--------------|------------------------------------|------------------------------------|---|---|
| 60- 9 | 47347.002 | -70729.605 | 15.165 | 324° 29' 33" | 18.624 | -0.004 | -189.388008 | -1317268.163520 |
| 60-47 | 47359.347 | -70738.413 | 4.667 | 324° 33' 59" | 16.148 | -11.514 | -545295.521358 | -1142283.893124 |
| 60-17 | 47363.150 | -70741.119 | 10.785 | 234° 30' 49" | -2.458 | -11.488 | -544107.867200 | 173881.670502 |
| 60-28 | 47356.889 | -70749.901 | 19.834 | 144° 35' 31" | -22.427 | 2.710 | 128337.169190 | 1586708.029727 |
| 60-27 | 47340.723 | -70738.409 | 10.813 | 54° 30' 13" | -9.887 | 20.296 | 960827.314008 | 699390.649783 |
| | | | | | | | 倍面積 | -428.293368 |
| | | | | | | | 面積 | 214.1466840 |
| | | | | | | | 地積 | 214.14 |

画地面積(座標法)計算簿

画地番号：60-15

| 点名 | Xn | Yn | 距離 | 方向角 | X _{n+1} -X _{n-1} | Y _{n+1} -Y _{n-1} | X _n *(Y _{n+1} -Y _{n-1}) | Y _n *(X _{n+1} -X _{n-1}) |
|-------|-----------|------------|--------|--------------|------------------------------------|------------------------------------|---|---|
| 60-26 | 47350.623 | -70758.690 | 19.835 | 144° 35' 37" | -22.433 | 2.703 | 127988.733969 | 1587329.692770 |
| 60-25 | 47334.456 | -70747.198 | 10.794 | 54° 30' 33" | -9.900 | 20.281 | 959990.102136 | 700397.260200 |
| 60-27 | 47340.723 | -70738.409 | 19.834 | 324° 35' 31" | 22.433 | -2.703 | -127961.974269 | -1586874.729097 |
| 60-28 | 47356.889 | -70749.901 | 10.793 | 234° 30' 49" | 9.900 | -20.281 | -960445.065809 | -700424.019900 |
| | | | | | | | 倍面積 | -428.203973 |
| | | | | | | | 面積 | 214.1019865 |
| | | | | | | | 地積 | 214.10 |

画地面積(座標法)計算簿

画地番号：60-16

| 点名 | Xn | Yn | 距離 | 方向角 | X _{n+1} -X _{n-1} | Y _{n+1} -Y _{n-1} | X _n *(Y _{n+1} -Y _{n-1}) | Y _n *(X _{n+1} -X _{n-1}) |
|-------|-----------|------------|--------|--------------|------------------------------------|------------------------------------|---|---|
| 60-25 | 47334.456 | -70747.198 | 19.835 | 324° 35' 37" | 20.848 | -4.914 | -232601.516784 | -1474937.583904 |
| 60-26 | 47350.623 | -70758.690 | 10.939 | 234° 40' 16" | 9.841 | -20.417 | -966757.669791 | -696336.268290 |
| 60-16 | 47344.297 | -70767.615 | 17.040 | 144° 31' 06" | -20.202 | 0.966 | 45734.590902 | 1429647.358230 |
| 60- 1 | 47330.421 | -70757.724 | 4.000 | 99° 17' 34" | -14.522 | 13.839 | 655005.696219 | 1027543.667928 |
| 60- 2 | 47329.775 | -70753.776 | 8.073 | 54° 33' 50" | 4.035 | 10.526 | 498193.211650 | -285491.486160 |
| | | | | | | | 倍面積 | -425.687804 |
| | | | | | | | 面積 | 212.8439020 |
| | | | | | | | 地積 | 212.84 |

画地面積(座標法)計算簿

画地番号：60-17

| 点名 | Xn | Yn | 距離 | 方向角 | X _{n+1} -X _{n-1} | Y _{n+1} -Y _{n-1} | X _n *(Y _{n+1} -Y _{n-1}) | Y _n *(X _{n+1} -X _{n-1}) |
|--------|-----------|------------|--------|--------------|------------------------------------|------------------------------------|---|---|
| 60-111 | 47392.025 | -70709.696 | 24.123 | 54° 32' 23" | 8.420 | 23.615 | 1119162.670375 | -595375.640320 |
| 60-112 | 47406.020 | -70690.047 | 6.841 | 324° 30' 01" | 19.565 | 15.676 | 743136.769520 | -1383050.769555 |
| 60-29 | 47411.590 | -70694.020 | 17.540 | 234° 32' 05" | -4.607 | -18.259 | -865688.221810 | 325687.350140 |
| 60-48 | 47401.413 | -70708.306 | 6.574 | 234° 33' 09" | -13.990 | -19.642 | -931058.554146 | 989209.200940 |
| 60-30 | 47397.600 | -70713.662 | 6.841 | 144° 34' 20" | -9.388 | -1.390 | -65882.664000 | 663859.858856 |
| | | | | | | | 倍面積 | -330.000061 |
| | | | | | | | 面積 | 165.0000305 |
| | | | | | | | 地積 | 165.00 |

画地面積(座標法)計算簿

画地番号：60-18

| 点名 | Xn | Yn | 距離 | 方向角 | X _{n+1} -X _{n-1} | Y _{n+1} -Y _{n-1} | X _n *(Y _{n+1} -Y _{n-1}) | Y _n *(X _{n+1} -X _{n-1}) |
|--------|-----------|------------|--------|--------------|------------------------------------|------------------------------------|---|---|
| 60-112 | 47406.020 | -70690.047 | 24.123 | 234° 32' 23" | -8.193 | -23.784 | -1127504.779680 | 579163.555071 |
| 60-111 | 47392.025 | -70709.696 | 3.172 | 144° 34' 17" | -16.580 | -17.810 | -844051.965250 | 1172366.759680 |
| 60-41 | 47389.440 | -70707.857 | 3.956 | 144° 34' 00" | -5.809 | 4.133 | 195860.555520 | 410741.941313 |
| 60-110 | 47386.216 | -70705.563 | 24.129 | 54° 31' 44" | 10.778 | 21.945 | 1039890.510120 | -762064.558014 |
| 60-109 | 47400.218 | -70685.912 | 7.124 | 324° 31' 23" | 19.804 | 15.516 | 735461.782488 | -1399863.801248 |
| | | | | | | | 倍面積 | -343.896802 |
| | | | | | | | 面積 | 171.9484010 |
| | | | | | | | 地積 | 171.94 |

画地面積(座標法)計算簿

画地番号：60-19

| 点名 | Xn | Yn | 距離 | 方向角 | X _{n+1} -X _{n-1} | Y _{n+1} -Y _{n-1} | X _n *(Y _{n+1} -Y _{n-1}) | Y _n *(X _{n+1} -X _{n-1}) |
|--------|-----------|------------|--------|--------------|------------------------------------|------------------------------------|---|---|
| 60-109 | 47400.218 | -70685.912 | 1.380 | 144° 31' 30" | 12.878 | 20.452 | 969429.258536 | -910293.174736 |
| 60-36 | 47399.094 | -70685.111 | 2.665 | 144° 38' 05" | -3.298 | 2.344 | 111103.476336 | 233119.496078 |
| 60-102 | 47396.920 | -70683.568 | 12.150 | 235° 06' 43" | -9.124 | -8.424 | -399271.654080 | 644916.874432 |
| 60-105 | 47389.970 | -70693.535 | 0.403 | 235° 12' 21" | -7.180 | -10.298 | -488021.911060 | 507579.581300 |
| 60-103 | 47389.740 | -70693.866 | 1.009 | 325° 32' 18" | 0.602 | -0.902 | -42745.545480 | -42557.707332 |
| 60-106 | 47390.572 | -70694.437 | 11.592 | 235° 05' 09" | -5.803 | -10.077 | -477554.794044 | 410239.817911 |
| 60-107 | 47383.937 | -70703.943 | 1.416 | 324° 34' 14" | -5.481 | -10.327 | -489333.917399 | 387528.311583 |
| 60-37 | 47385.091 | -70704.764 | 1.379 | 324° 37' 00" | 2.279 | -1.620 | -76763.847420 | -161136.157156 |
| 60-110 | 47386.216 | -70705.563 | 24.129 | 54° 31' 44" | 15.127 | 18.852 | 893324.944032 | -1069563.051501 |
| | | | | | | | 倍面積 | 166.009421 |
| | | | | | | | 面積 | 83.0047105 |
| | | | | | | | 地積 | 83.00 |

画地面積(座標法)計算簿

画地番号：60-20

| 点名 | Xn | Yn | 距離 | 方向角 | X _{n+1} -X _{n-1} | Y _{n+1} -Y _{n-1} | X _n *(Y _{n+1} -Y _{n-1}) | Y _n *(X _{n+1} -X _{n-1}) |
|--------|-----------|------------|--------|--------------|------------------------------------|------------------------------------|---|---|
| 60-102 | 47396.920 | -70683.568 | 3.271 | 144° 25' 47" | 4.289 | 11.870 | 562601.440400 | -303161.823152 |
| 60-35 | 47394.259 | -70681.665 | 7.872 | 144° 30' 26" | -9.071 | 6.474 | 306830.432766 | 641153.383215 |
| 60- 4 | 47387.849 | -70677.094 | 3.995 | 189° 27' 02" | -10.351 | 3.915 | 185523.428835 | 731578.599994 |
| 60- 3 | 47383.908 | -70677.750 | 9.286 | 234° 37' 02" | -9.318 | -8.227 | -389827.411116 | 658575.274500 |
| 60-101 | 47378.531 | -70685.321 | 14.082 | 324° 19' 08" | 6.062 | -15.785 | -747870.111835 | -428494.415902 |
| 60-105 | 47389.970 | -70693.535 | 12.150 | 55° 06' 43" | 18.389 | 1.753 | 83074.617410 | -1299983.415115 |
| | | | | | | | 倍面積 | 332.396460 |
| | | | | | | | 面積 | 166.1982300 |
| | | | | | | | 地積 | 166.19 |

画地面積(座標法)計算簿

画地番号：60-21

| 点名 | Xn | Yn | 距離 | 方向角 | X _{n+1} -X _{n-1} | Y _{n+1} -Y _{n-1} | X _n *(Y _{n+1} -Y _{n-1}) | Y _n *(X _{n+1} -X _{n-1}) |
|--------|-----------|------------|--------|--------------|------------------------------------|------------------------------------|---|---|
| 60-106 | 47390.572 | -70694.437 | 1.009 | 145° 32' 18" | 5.803 | 10.077 | 477554.794044 | -410239.817911 |
| 60-103 | 47389.740 | -70693.866 | 0.403 | 55° 12' 21" | -0.602 | 0.902 | 42745.545480 | 42557.707332 |
| 60-105 | 47389.970 | -70693.535 | 14.082 | 144° 19' 08" | -11.209 | 8.545 | 404947.293650 | 792403.833815 |
| 60-101 | 47378.531 | -70685.321 | 12.012 | 234° 28' 10" | -18.420 | -1.562 | -74005.265422 | 1302023.612820 |
| 60-11 | 47371.550 | -70695.097 | 10.699 | 324° 25' 19" | 1.721 | -16.001 | -757992.171550 | -121666.261937 |
| 60-38 | 47380.252 | -70701.322 | 4.522 | 324° 34' 38" | 12.387 | -8.846 | -419125.709192 | -875777.275614 |
| 60-107 | 47383.937 | -70703.943 | 11.592 | 55° 05' 09" | 10.320 | 6.885 | 326238.406245 | -729664.691760 |
| | | | | | | | 倍面積 | 362.893255 |
| | | | | | | | 面積 | 181.4466275 |
| | | | | | | | 地積 | 181.44 |