



67街区 画地出来形確認図 (3588.53m²)

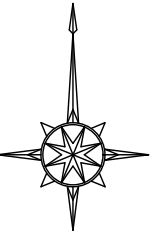


S=1:500

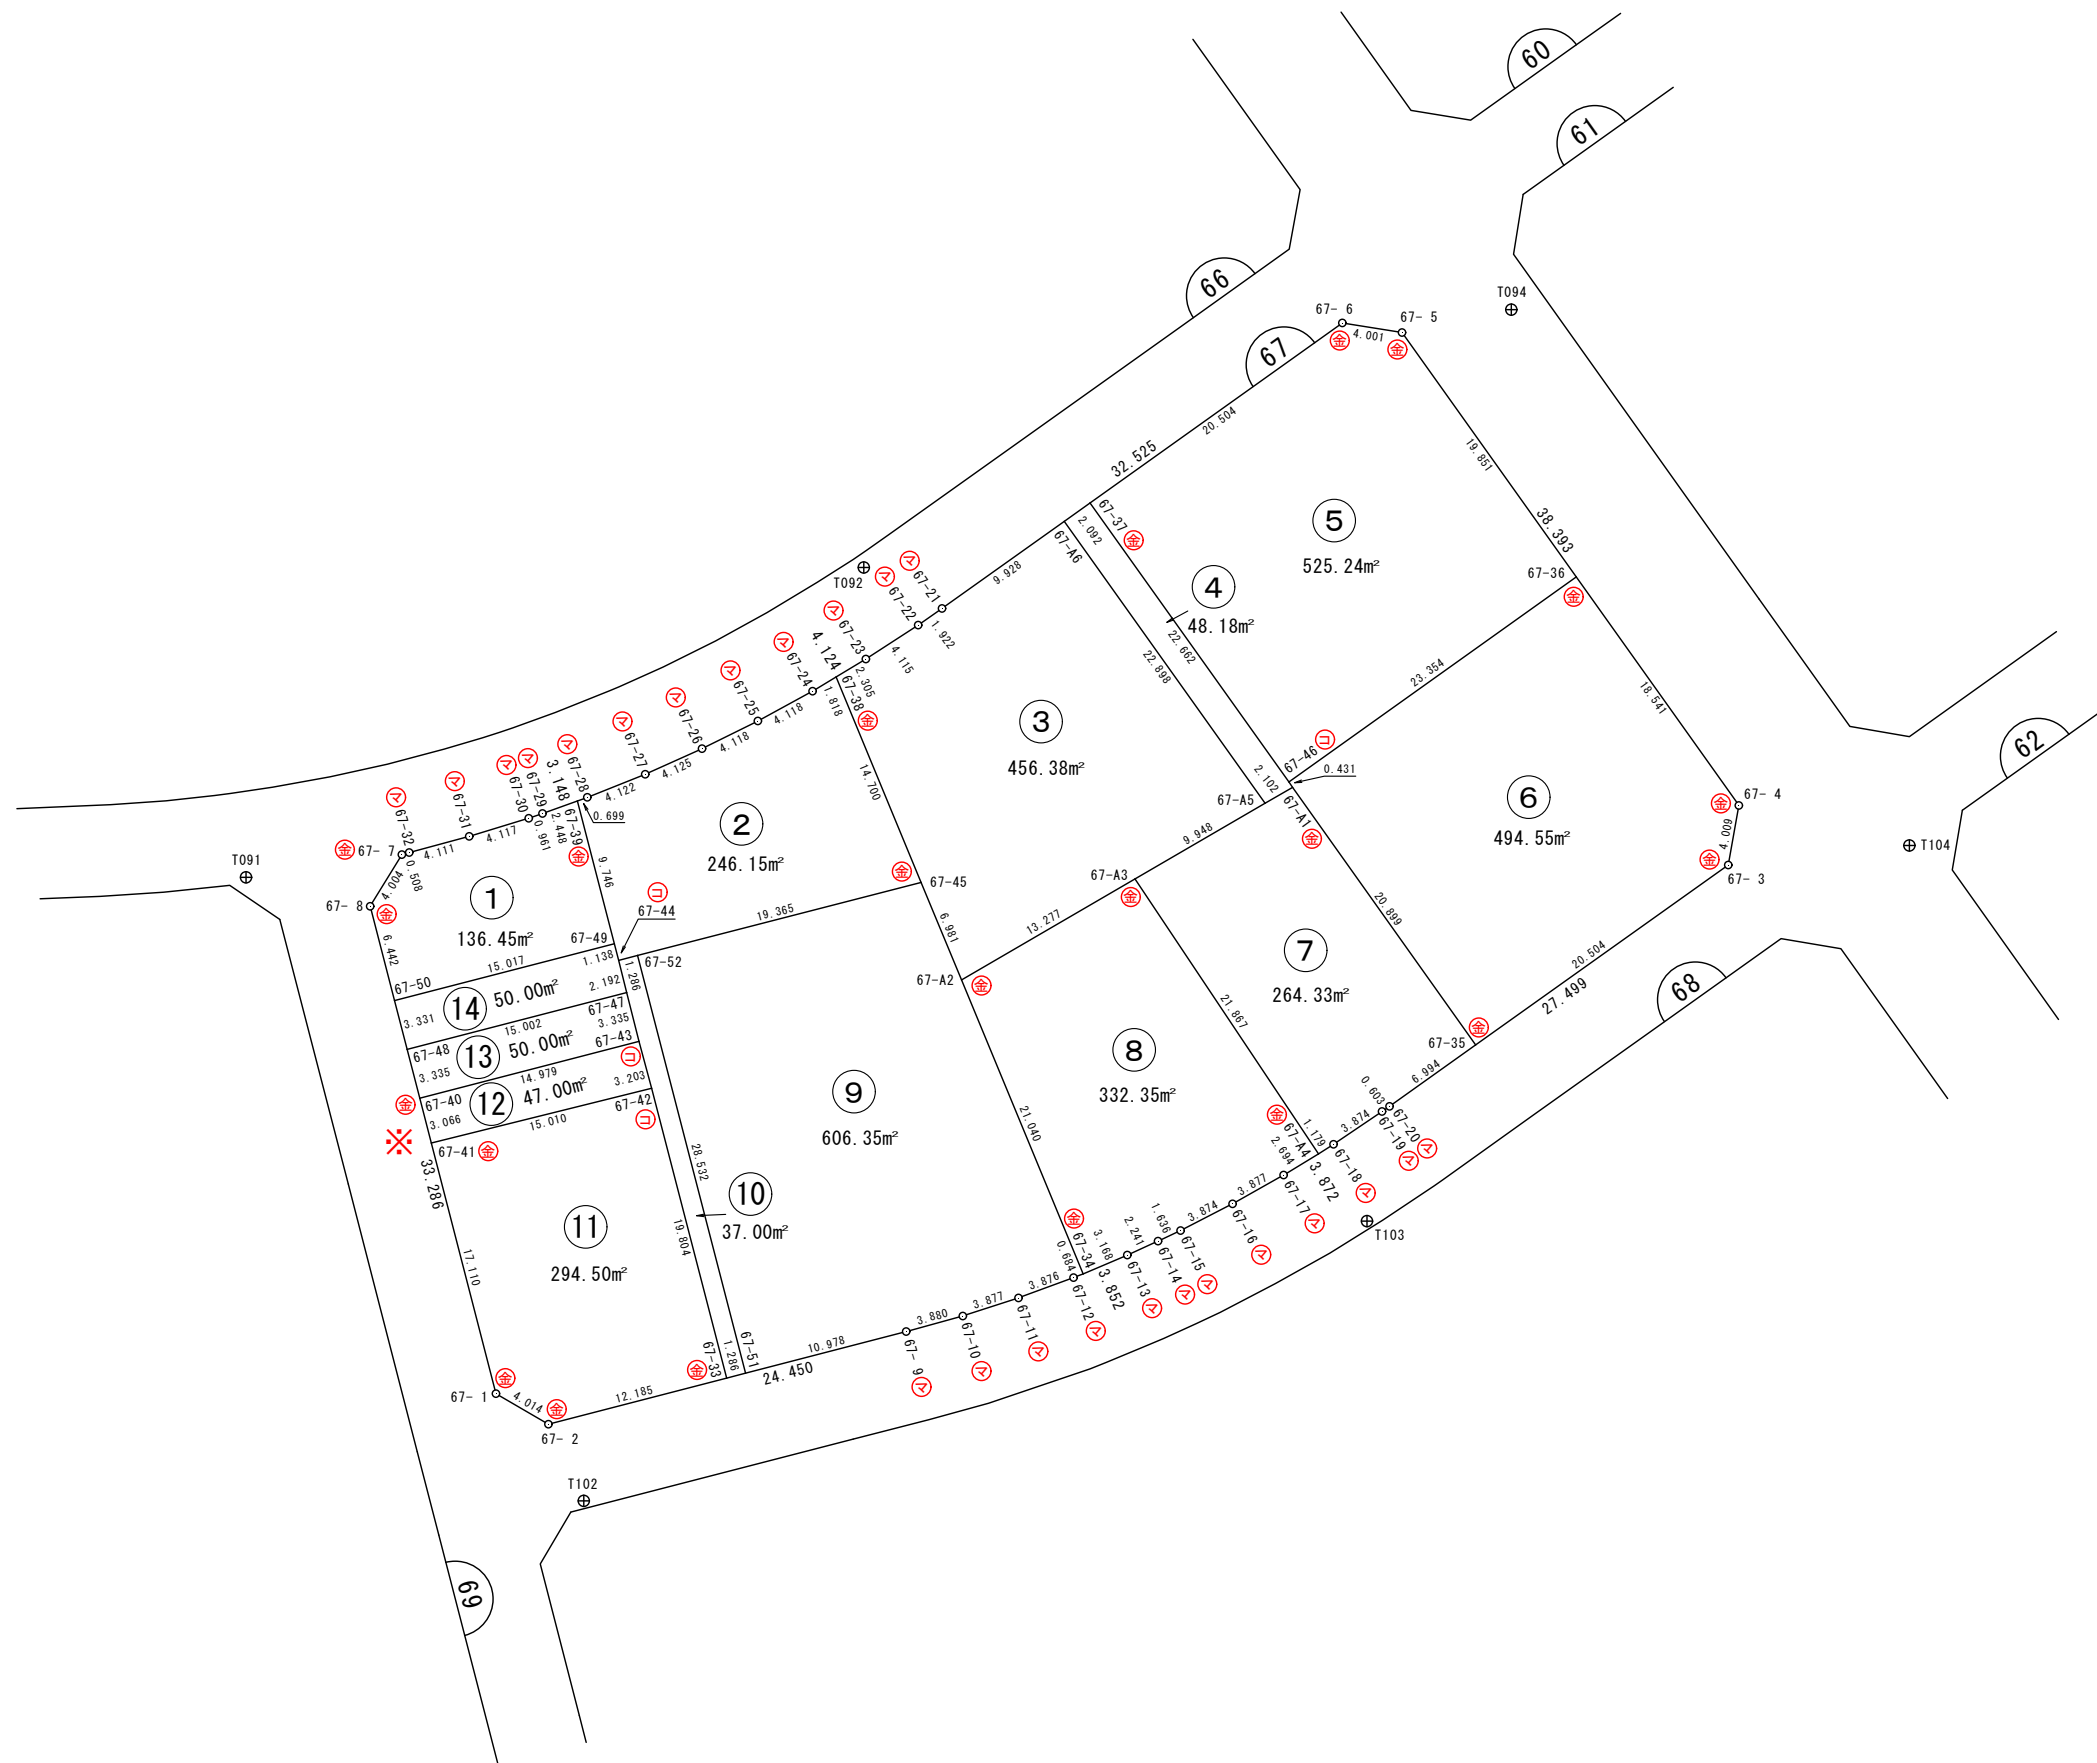

※⑫画地は分筆しています。次ページで確認してください。

凡 例	
事 項	記 号
金属プレート	⊕
コンクリート杭	⊖
金属板	⊗
合成樹脂杭	⊙
マーキング	⊚

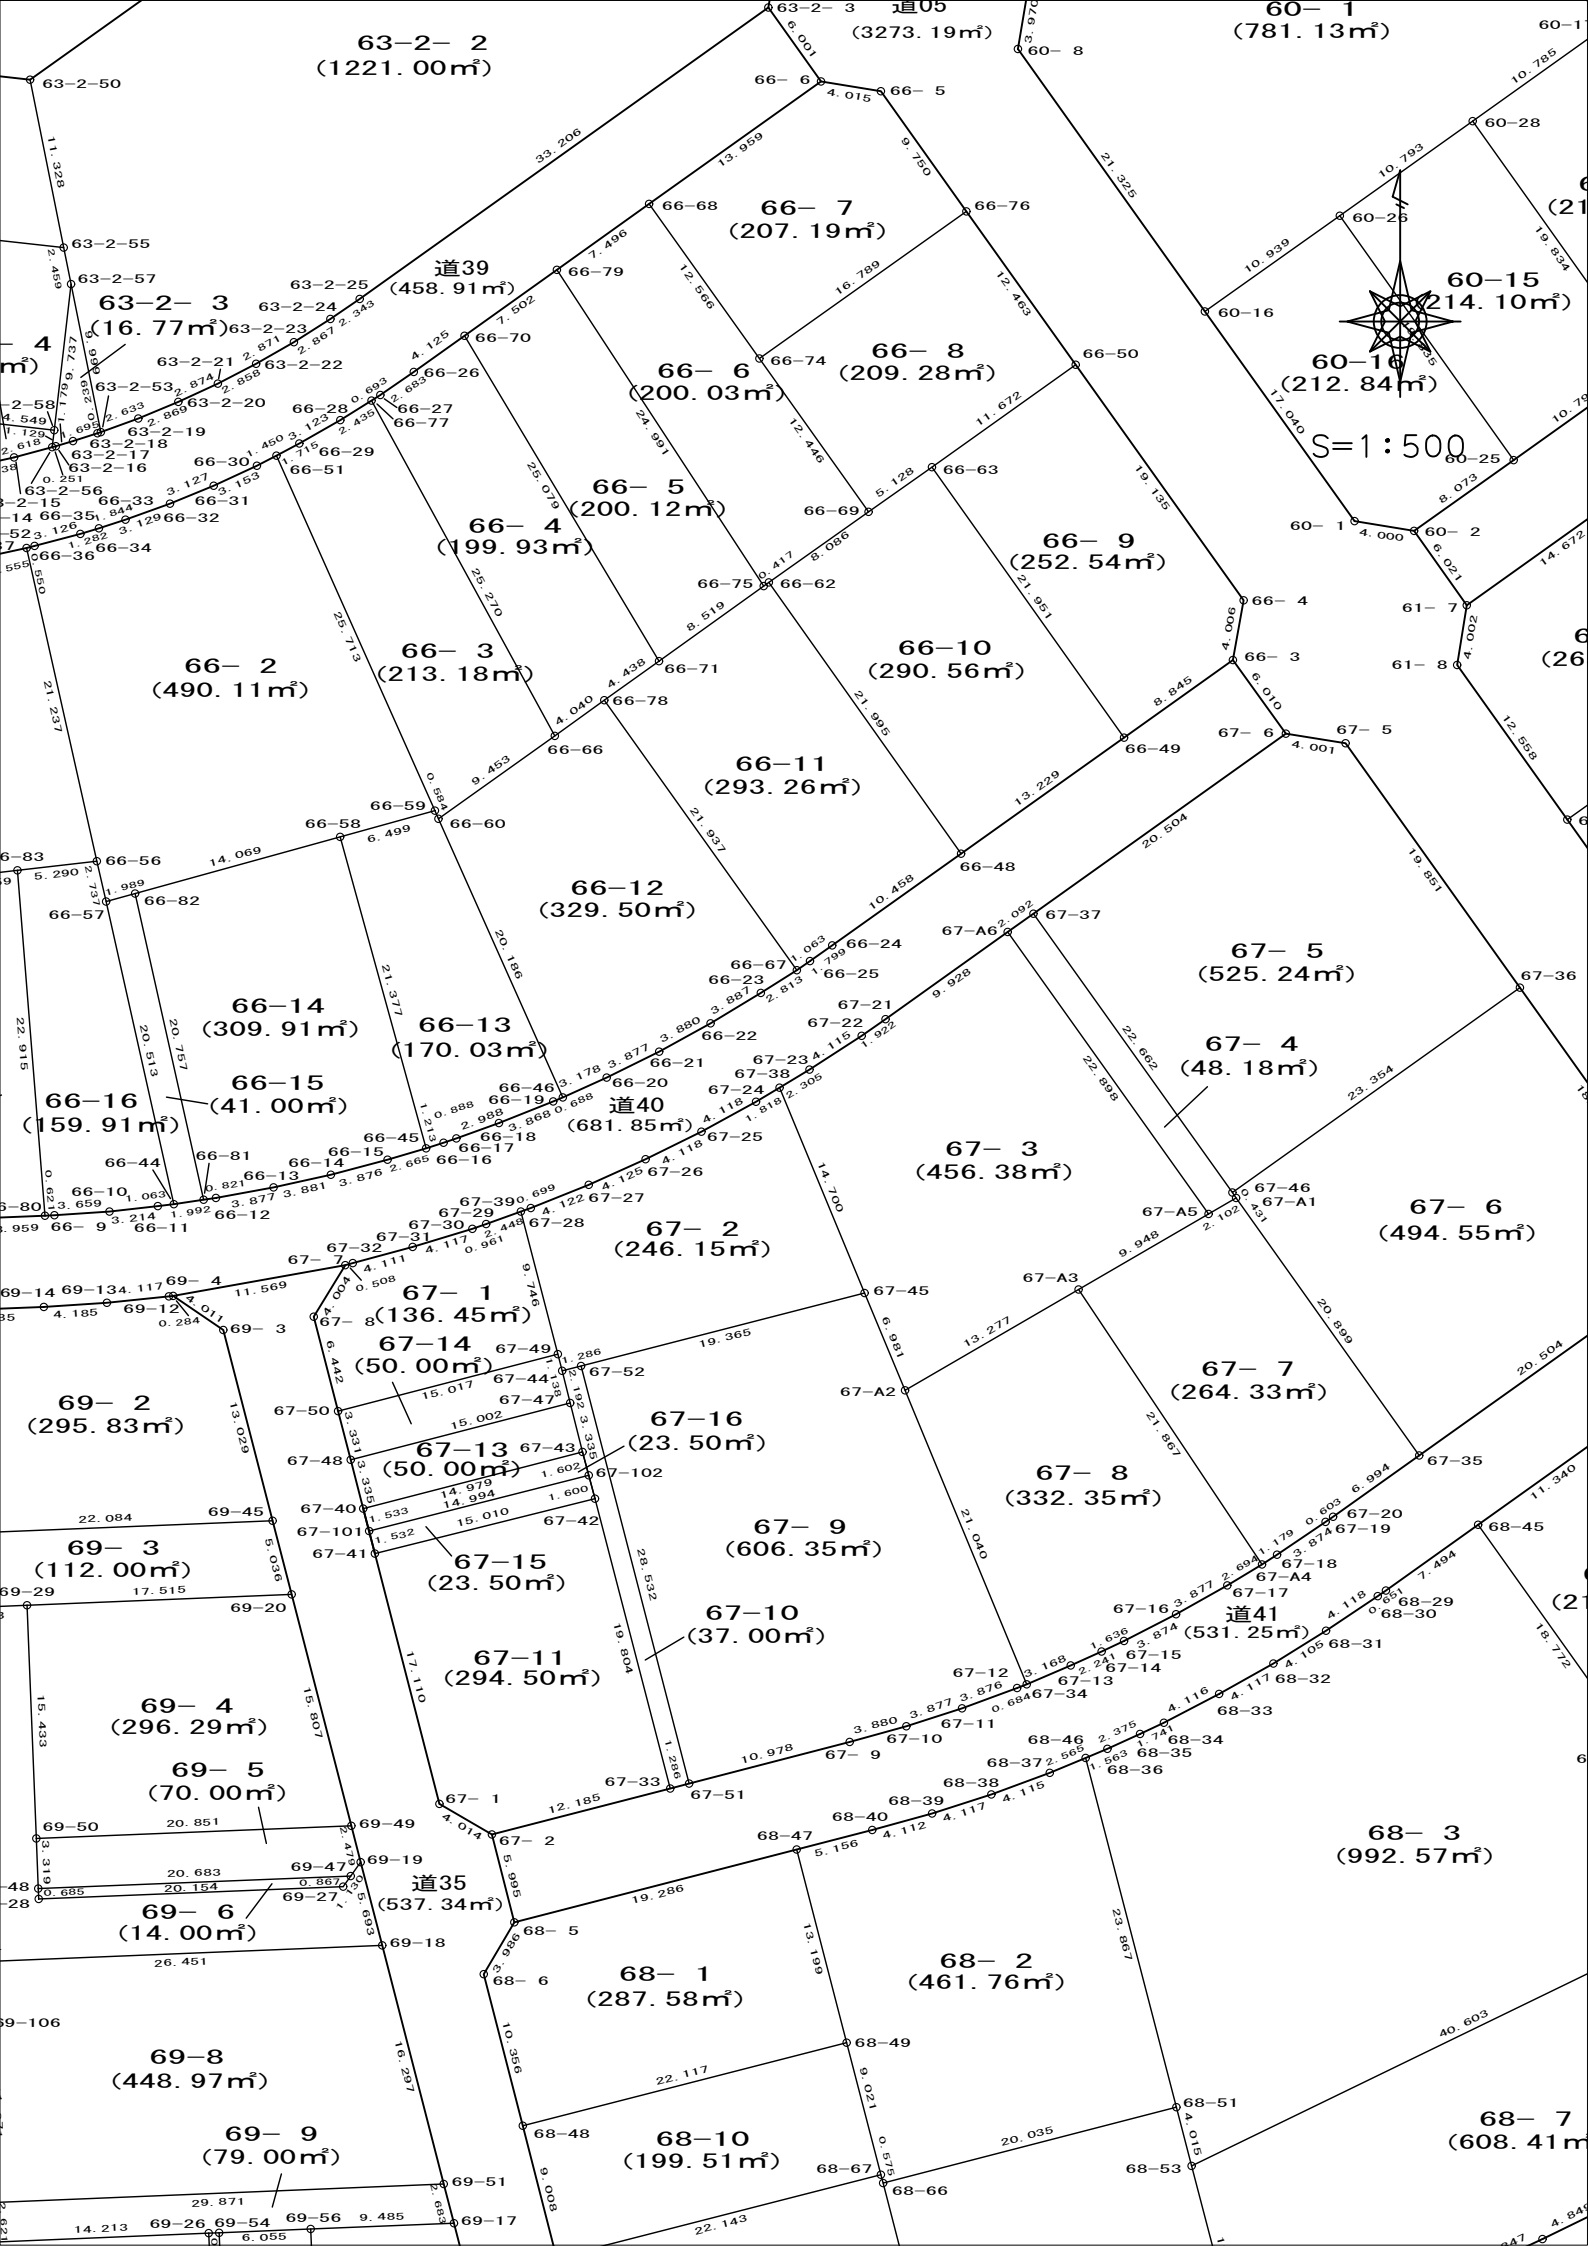

画地面積(座標法)計算簿

画地番号：67- 1

点名	Xn	Yn	距離	方向角	X _{n+1} -X _{n-1}	Y _{n+1} -Y _{n-1}	X _n *(Y _{n+1} -Y _{n-1})	Y _n *(X _{n+1} -X _{n-1})
67- 7	47281.202	-70824.473	4.004	211° 31' 50"	-3.550	-2.584	-122174.625968	251426.879150
67- 8	47277.789	-70826.567	6.442	165° 30' 39"	-9.651	-0.482	-22787.894298	683547.198117
67-50	47271.551	-70824.955	15.017	75° 29' 47"	-2.477	16.151	763482.820201	175433.413535
67-49	47275.312	-70810.416	9.746	345° 29' 00"	13.196	12.096	571842.173952	-934414.249536
67-39	47284.747	-70812.859	2.448	250° 15' 46"	8.608	-4.748	-224507.978756	-609557.090272
67-29	47283.920	-70815.164	0.961	251° 07' 54"	-1.138	-3.215	-152017.802800	80587.656632
67-30	47283.609	-70816.074	4.117	253° 06' 51"	-1.507	-4.850	-229325.503650	106719.823518
67-31	47282.413	-70820.014	4.111	254° 51' 31"	-2.270	-7.909	-373956.604417	160761.431780
67-32	47281.339	-70823.983	0.508	254° 22' 46"	-1.211	-4.459	-210827.490601	85767.843413
							倍面積	-272.906337
							面積	136.4531685
							地積	136.45

画地面積(座標法)計算簿

画地番号：67- 2

点名	Xn	Yn	距離	方向角	X _{n+1} -X _{n-1}	Y _{n+1} -Y _{n-1}	X _n *(Y _{n+1} -Y _{n-1})	Y _n *(X _{n+1} -X _{n-1})
67-39	47284.747	-70812.859	9.746	165° 29' 00"	-9.675	1.786	84450.558142	685114.410825
67-49	47275.312	-70810.416	1.138	165° 29' 59"	-10.537	2.728	128967.051136	746129.353392
67-44	47274.210	-70810.131	1.286	75° 33' 12"	-0.781	1.531	72376.815510	55302.712311
67-52	47274.531	-70808.885	19.365	75° 33' 04"	5.153	19.999	945443.345469	-364878.184405
67-45	47279.363	-70790.132	14.700	337° 32' 42"	18.418	13.138	621156.271094	-1303812.651176
67-38	47292.949	-70795.747	1.818	238° 59' 35"	12.649	-7.174	-339279.616126	-895495.403803
67-24	47292.012	-70797.306	4.118	241° 20' 38"	-2.912	-5.173	-244641.578076	206161.755072
67-25	47290.037	-70800.920	4.118	243° 41' 02"	-3.801	-7.306	-345501.010322	269114.296920
67-26	47288.211	-70804.612	4.125	245° 44' 24"	-3.521	-7.453	-352439.036583	249303.038852
67-27	47286.516	-70808.373	4.122	248° 13' 56"	-3.224	-7.590	-358904.656440	228286.194552
67-28	47284.987	-70812.202	0.699	249° 55' 58"	-1.769	-4.486	-212120.451682	125266.785338
							倍面積	-492.307878
							面積	246.1539390
							地積	246.15

画地面積(座標法)計算簿

画地番号：67- 3

点名	Xn	Yn	距離	方向角	X _{n+1} -X _{n-1}	Y _{n+1} -Y _{n-1}	X _n *(Y _{n+1} -Y _{n-1})	Y _n *(X _{n+1} -X _{n-1})
67-38	47292.949	-70795.747	14.700	157° 32' 42"	-14.778	3.642	172240.920258	1046219.549166
67-45	47279.363	-70790.132	6.981	157° 23' 27"	-20.031	8.299	392371.433537	1417997.134092
67-A2	47272.918	-70787.448	13.277	59° 47' 55"	0.234	14.159	669337.245962	-16564.262832
67-A3	47279.597	-70775.973	9.948	59° 50' 32"	11.677	20.077	949232.468969	-826451.036721
67-A5	47284.595	-70767.371	22.898	324° 31' 39"	23.646	-4.686	-221575.612170	-1673365.254666
67-A6	47303.243	-70780.659	9.928	234° 30' 38"	12.884	-21.372	-1010964.909396	-911938.010556
67-21	47297.479	-70788.743	1.922	234° 59' 45"	-6.867	-9.659	-456846.349661	486106.298181
67-22	47296.376	-70790.318	4.115	237° 06' 33"	-3.338	-5.031	-237948.067656	236298.081484
67-23	47294.141	-70793.774	2.305	238° 51' 41"	-3.427	-5.429	-256759.891489	242610.263498
							倍面積	-912.761646
							面積	456.3808230
							地積	456.38

画地面積(座標法)計算簿

画地番号：67- 4

点名	Xn	Yn	距離	方向角	X _{n+1} -X _{n-1}	Y _{n+1} -Y _{n-1}	X _n *(Y _{n+1} -Y _{n-1})	Y _n *(X _{n+1} -X _{n-1})
67-46	47286.005	-70765.800	22.662	324° 30' 55"	18.807	-13.402	-633727.039010	-1330892.400600
67-37	47304.458	-70778.955	2.092	234° 30' 36"	17.238	-14.859	-702896.941422	-1220087.626290
67-A6	47303.243	-70780.659	22.898	144° 31' 39"	-19.863	11.584	547960.766912	1405916.229717
67-A5	47284.595	-70767.371	2.102	59° 50' 58"	-17.592	15.106	714281.092070	1244939.590632
67-A1	47285.651	-70765.553	0.431	325° 05' 42"	1.410	1.571	74285.757721	-99779.429730
							倍面積	-96.363729
							面積	48.1818645
							地積	48.18

画地面積(座標法)計算簿

画地番号：67- 5

点名	Xn	Yn	距離	方向角	X _{n+1} -X _{n-1}	Y _{n+1} -Y _{n-1}	X _n *(Y _{n+1} -Y _{n-1})	Y _n *(X _{n+1} -X _{n-1})
67-37	47304.458	-70778.955	22.662	144° 30' 55"	-30.356	-3.541	-167505.085778	2148565.957980
67-46	47286.005	-70765.800	23.354	54° 30' 55"	-4.896	32.172	1521285.352860	346469.356800
67-36	47299.562	-70746.783	19.851	324° 30' 39"	29.721	7.492	354368.318504	-2102665.137543
67- 5	47315.726	-70758.308	4.001	279° 07' 50"	16.799	-15.476	-732258.175576	-1188668.816092
67- 6	47316.361	-70762.259	20.504	234° 30' 50"	-11.268	-20.647	-976940.905567	797349.134412
							倍面積	-1050.495557
							面積	525.2477785
							地積	525.24

画地面積(座標法)計算簿

画地番号：67- 6

点名	Xn	Yn	距離	方向角	X _{n+1} -X _{n-1}	Y _{n+1} -Y _{n-1}	X _n *(Y _{n+1} -Y _{n-1})	Y _n *(X _{n+1} -X _{n-1})
67-46	47286.005	-70765.800	0.431	145° 05' 42"	-13.911	-18.770	-887558.313850	984423.043800
67-A1	47285.651	-70765.553	20.899	144° 34' 56"	-17.386	12.359	584403.360709	1230329.904458
67-35	47268.619	-70753.441	20.504	54° 33' 21"	-5.141	28.817	1362139.793723	363743.440181
67- 3	47280.510	-70736.736	4.009	10° 08' 29"	15.838	17.411	823200.959610	-1120328.424768
67- 4	47284.457	-70736.030	18.541	324° 33' 13"	19.052	-10.047	-475066.939479	-1347662.843560
67-36	47299.562	-70746.783	23.354	234° 30' 55"	1.548	-29.770	-1408107.960740	-109516.020084
							倍面積	-989.100027
							面積	494.5500135
							地積	494.55

画地面積(座標法)計算簿

画地番号：67- 7

点名	Xn	Yn	距離	方向角	X _{n+1} -X _{n-1}	Y _{n+1} -Y _{n-1}	X _n *(Y _{n+1} -Y _{n-1})	Y _n *(X _{n+1} -X _{n-1})
67-A3	47279.597	-70775.973	21.867	146° 17' 02"	-23.187	3.536	167180.654992	1641082.485951
67-A4	47261.408	-70763.835	1.179	57° 11' 09"	-17.550	13.129	620495.025632	1241905.304250
67-18	47262.047	-70762.844	3.874	55° 58' 25"	2.807	4.202	198595.121494	-198631.303108
67-19	47264.215	-70759.633	0.603	55° 15' 25"	2.512	3.707	175208.445005	-177748.198096
67-20	47264.559	-70759.137	6.994	54° 31' 10"	4.404	6.192	292662.149328	-311623.239348
67-35	47268.619	-70753.441	20.899	324° 34' 56"	21.092	-6.416	-303275.459504	-1492331.577572
67-A1	47285.651	-70765.553	2.102	239° 50' 58"	15.976	-13.930	-658689.118430	-1130550.474728
67-A5	47284.595	-70767.371	9.948	239° 50' 32"	-6.054	-10.420	-492705.479900	428425.664034
							倍面積	-528.661383
							面積	264.3306915
							地積	264.33

画地面積(座標法)計算簿

画地番号：67- 8

点名	Xn	Yn	距離	方向角	X _{n+1} -X _{n-1}	Y _{n+1} -Y _{n-1}	X _n *(Y _{n+1} -Y _{n-1})	Y _n *(X _{n+1} -X _{n-1})
67-A2	47272.918	-70787.448	21.040	157° 31' 14"	-26.121	-3.430	-162146.108740	1849038.929208
67-34	47253.476	-70779.403	3.168	66° 55' 21"	-18.200	10.960	517898.096960	1288185.134600
67-13	47254.718	-70776.488	2.241	65° 30' 57"	2.171	4.955	234147.127690	-153655.755448
67-14	47255.647	-70774.448	1.636	64° 54' 25"	1.623	3.522	166434.388734	-114866.929104
67-15	47256.341	-70772.966	3.874	62° 46' 01"	2.467	4.927	232831.992107	-174596.907122
67-16	47258.114	-70769.521	3.877	60° 38' 44"	3.674	6.825	322536.628050	-260007.220154
67-17	47260.015	-70766.141	2.694	58° 51' 53"	3.294	5.686	268720.445290	-233103.668454
67-A4	47261.408	-70763.835	21.867	326° 17' 02"	19.582	-9.832	-464674.163456	-1385697.416970
67-A3	47279.597	-70775.973	13.277	239° 47' 55"	11.510	-23.613	-1116413.123961	-814631.449230
倍面積								-664.717326
面積								332.3586630
地積								332.35

画地面積(座標法)計算簿

画地番号：67- 9

点名	Xn	Yn	距離	方向角	X _{n+1} -X _{n-1}	Y _{n+1} -Y _{n-1}	X _n *(Y _{n+1} -Y _{n-1})	Y _n *(X _{n+1} -X _{n-1})
67-34	47253.476	-70779.403	21.040	337° 31' 14"	19.685	-7.405	-349911.989780	-1393292.548055
67-A2	47272.918	-70787.448	6.981	337° 23' 27"	25.887	-10.729	-507191.137222	-1832474.666376
67-45	47279.363	-70790.132	19.365	255° 33' 04"	1.613	-21.437	-1013527.704631	-114184.482916
67-52	47274.531	-70808.885	28.532	165° 29' 31"	-32.455	-11.605	-548620.932255	2298102.362675
67-51	47246.908	-70801.737	10.978	75° 27' 22"	-24.866	17.775	839813.789700	1760555.992242
67- 9	47249.665	-70791.110	3.880	74° 37' 28"	3.786	14.369	678930.436385	-268015.142460
67-10	47250.694	-70787.368	3.877	72° 03' 04"	2.224	7.431	351119.907114	-157431.106432
67-11	47251.889	-70783.679	3.876	69° 42' 50"	2.539	7.325	346120.086925	-179719.760981
67-12	47253.233	-70780.043	0.684	69° 12' 32"	1.587	4.276	202054.824308	-112327.928241
							倍面積	-1212.719456
							面積	606.3597280
							地積	606.35

画地面積(座標法)計算簿

画地番号：67-10

点名	Xn	Yn	距離	方向角	X _{n+1} -X _{n-1}	Y _{n+1} -Y _{n-1}	X _n *(Y _{n+1} -Y _{n-1})	Y _n *(X _{n+1} -X _{n-1})
67-43	47268.849	-70808.784	1.602	164° 59' 33"	-4.783	1.228	58046.146572	338678.413872
67-102	47267.301	-70808.369	1.600	164° 58' 27"	-3.094	0.830	39231.859830	219081.093686
67-42	47265.755	-70807.954	19.804	165° 27' 36"	-20.716	5.387	254620.622185	1466857.575064
67-33	47246.585	-70802.982	1.286	75° 27' 21"	-18.847	6.217	293732.018945	1334423.801754
67-51	47246.908	-70801.737	28.532	345° 29' 31"	27.946	-5.903	-278898.497924	-1978625.342202
67-52	47274.531	-70808.885	1.286	255° 33' 12"	27.302	-8.394	-396822.413214	-1933224.178270
67-44	47274.210	-70810.131	2.192	165° 54' 01"	-2.447	-0.712	-33659.237520	173272.390557
67-47	47272.084	-70809.597	3.335	165° 53' 35"	-5.361	1.347	63675.497148	379610.249517
							倍面積	-74.003978
							面積	37.0019890
							地積	37.00

画地面積(座標法)計算簿

画地番号：67-11

点名	Xn	Yn	距離	方向角	X _{n+1} -X _{n-1}	Y _{n+1} -Y _{n-1}	X _n *(Y _{n+1} -Y _{n-1})	Y _n *(X _{n+1} -X _{n-1})
67-41	47262.128	-70822.520	17.110	165° 32' 32"	-20.196	-10.294	-486516.345632	1430331.613920
67- 1	47245.559	-70818.248	4.014	120° 14' 39"	-18.591	7.740	365680.626660	1316582.048568
67- 2	47243.537	-70814.780	12.185	75° 30' 52"	1.026	15.266	721219.835842	-72655.964280
67-33	47246.585	-70802.982	19.804	345° 27' 36"	22.218	6.826	322505.189210	-1573100.654076
67-42	47265.755	-70807.954	15.010	256° 01' 03"	15.543	-19.538	-923478.321190	-1100568.029022
							倍面積	-589.015110
							面積	294.5075550
							地積	294.50

画地面積(座標法)計算簿

画地番号：67-13

点名	Xn	Yn	距離	方向角	X _{n+1} -X _{n-1}	Y _{n+1} -Y _{n-1}	X _n *(Y _{n+1} -Y _{n-1})	Y _n *(X _{n+1} -X _{n-1})	
67-40	47265.097	-70823.286	14.979	75° 29' 40"	0.523	15.337	724904.792689	-37040.578578	
67-43	47268.849	-70808.784	3.335	345° 53' 35"	6.987	13.689	647063.273961	-494740.973808	
67-47	47272.084	-70809.597	15.002	255° 29' 36"	-0.523	-15.337	-725011.952308	37033.419231	
67-48	47268.326	-70824.121	3.335	165° 30' 05"	-6.987	-13.689	-647056.114614	494848.133427	
								倍面積	-100.000272
								面積	50.0001360
								地積	50.00

画地面積(座標法)計算簿

画地番号：67-14

点名	Xn	Yn	距離	方向角	X _{n+1} -X _{n-1}	Y _{n+1} -Y _{n-1}	X _n *(Y _{n+1} -Y _{n-1})	Y _n *(X _{n+1} -X _{n-1})
67-48	47268.326	-70824.121	15.002	75° 29' 36"	0.533	15.358	725946.950708	-37749.256493
67-47	47272.084	-70809.597	2.192	345° 54' 01"	5.884	13.990	661336.455160	-416643.668748
67-44	47274.210	-70810.131	1.138	345° 29' 59"	3.228	-0.819	-38717.577990	-228575.102868
67-49	47275.312	-70810.416	15.017	255° 29' 47"	-2.659	-14.824	-700809.225088	188284.896144
67-50	47271.551	-70824.955	3.331	165° 30' 03"	-6.986	-13.705	-647856.606455	494783.135630
							倍面積	-100.003665
							面積	50.0018325
							地積	50.00

画地面積(座標法)計算簿

画地番号：67-15

点名	Xn	Yn	距離	方向角	X _{n+1} -X _{n-1}	Y _{n+1} -Y _{n-1}	X _n *(Y _{n+1} -Y _{n-1})	Y _n *(X _{n+1} -X _{n-1})
67-101	47263.612	-70822.903	1.532	165° 31' 43"	-5.173	-14.151	-668827.373412	366366.877219
67-41	47262.128	-70822.520	15.010	76° 01' 03"	2.143	14.949	706521.551472	-151772.660360
67-42	47265.755	-70807.954	1.600	344° 58' 27"	5.173	14.151	668857.699005	-366289.546042
67-102	47267.301	-70808.369	14.994	255° 45' 29"	-2.143	-14.949	-706598.882649	151742.334767
							倍面積	-47.005584
							面積	23.5027920
							地積	23.50

画地面積(座標法)計算簿

画地番号：67-16

点名	Xn	Yn	距離	方向角	X _{n+1} -X _{n-1}	Y _{n+1} -Y _{n-1}	X _n *(Y _{n+1} -Y _{n-1})	Y _n *(X _{n+1} -X _{n-1})
67-40	47265.097	-70823.286	1.533	165° 32' 16"	-5.237	-14.119	-667335.904543	370901.548782
67-101	47263.612	-70822.903	14.994	75° 45' 29"	2.204	14.917	705031.300204	-156093.678212
67-102	47267.301	-70808.369	1.602	344° 59' 33"	5.237	14.119	667367.022819	-370823.428453
67-43	47268.849	-70808.784	14.979	255° 29' 40"	-2.204	-14.917	-705109.420533	156062.559936
							倍面積	-47.002053
							面積	23.5010265
							地積	23.50