



# 69街区 画地出来形確認図 (4227.18m<sup>2</sup>)

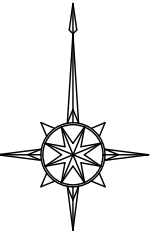


S=1:500

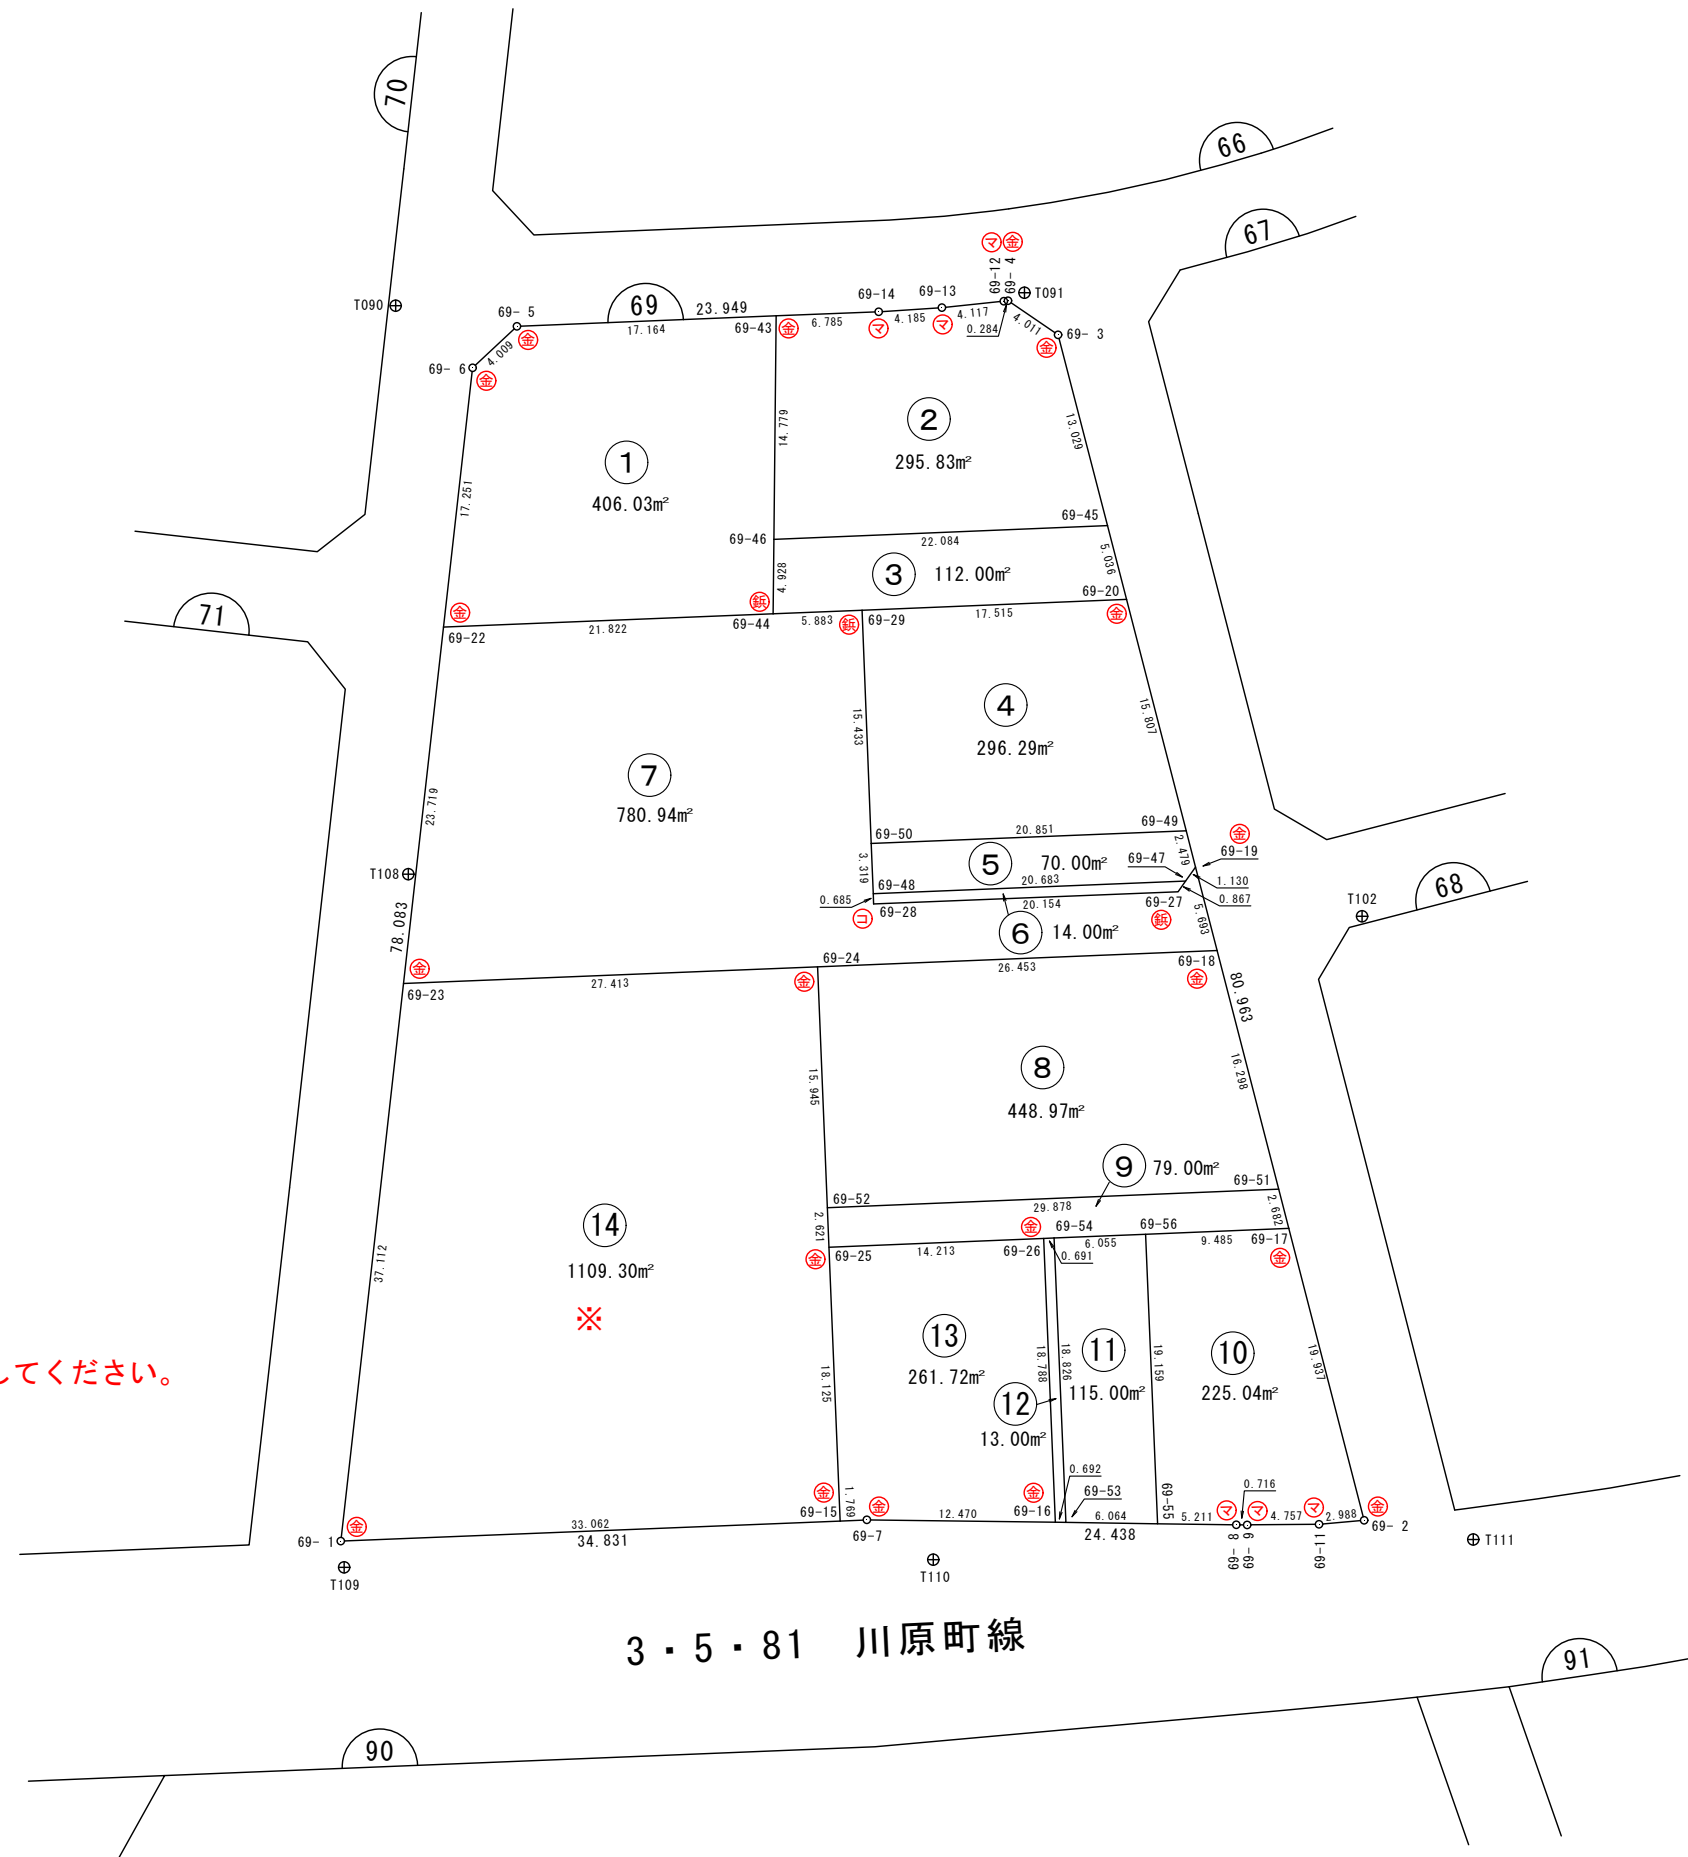

※⑭画地は分筆しています。次ページで確認してください。

| 凡 例     |     |
|---------|-----|
| 事 項     | 記 号 |
| 金属プレート  | ⊕   |
| コンクリート杭 | ⊖   |
| 金属 鈎    | ⊗   |
| 合成樹脂杭   | ⊙   |
| マーキング   | ⊚   |

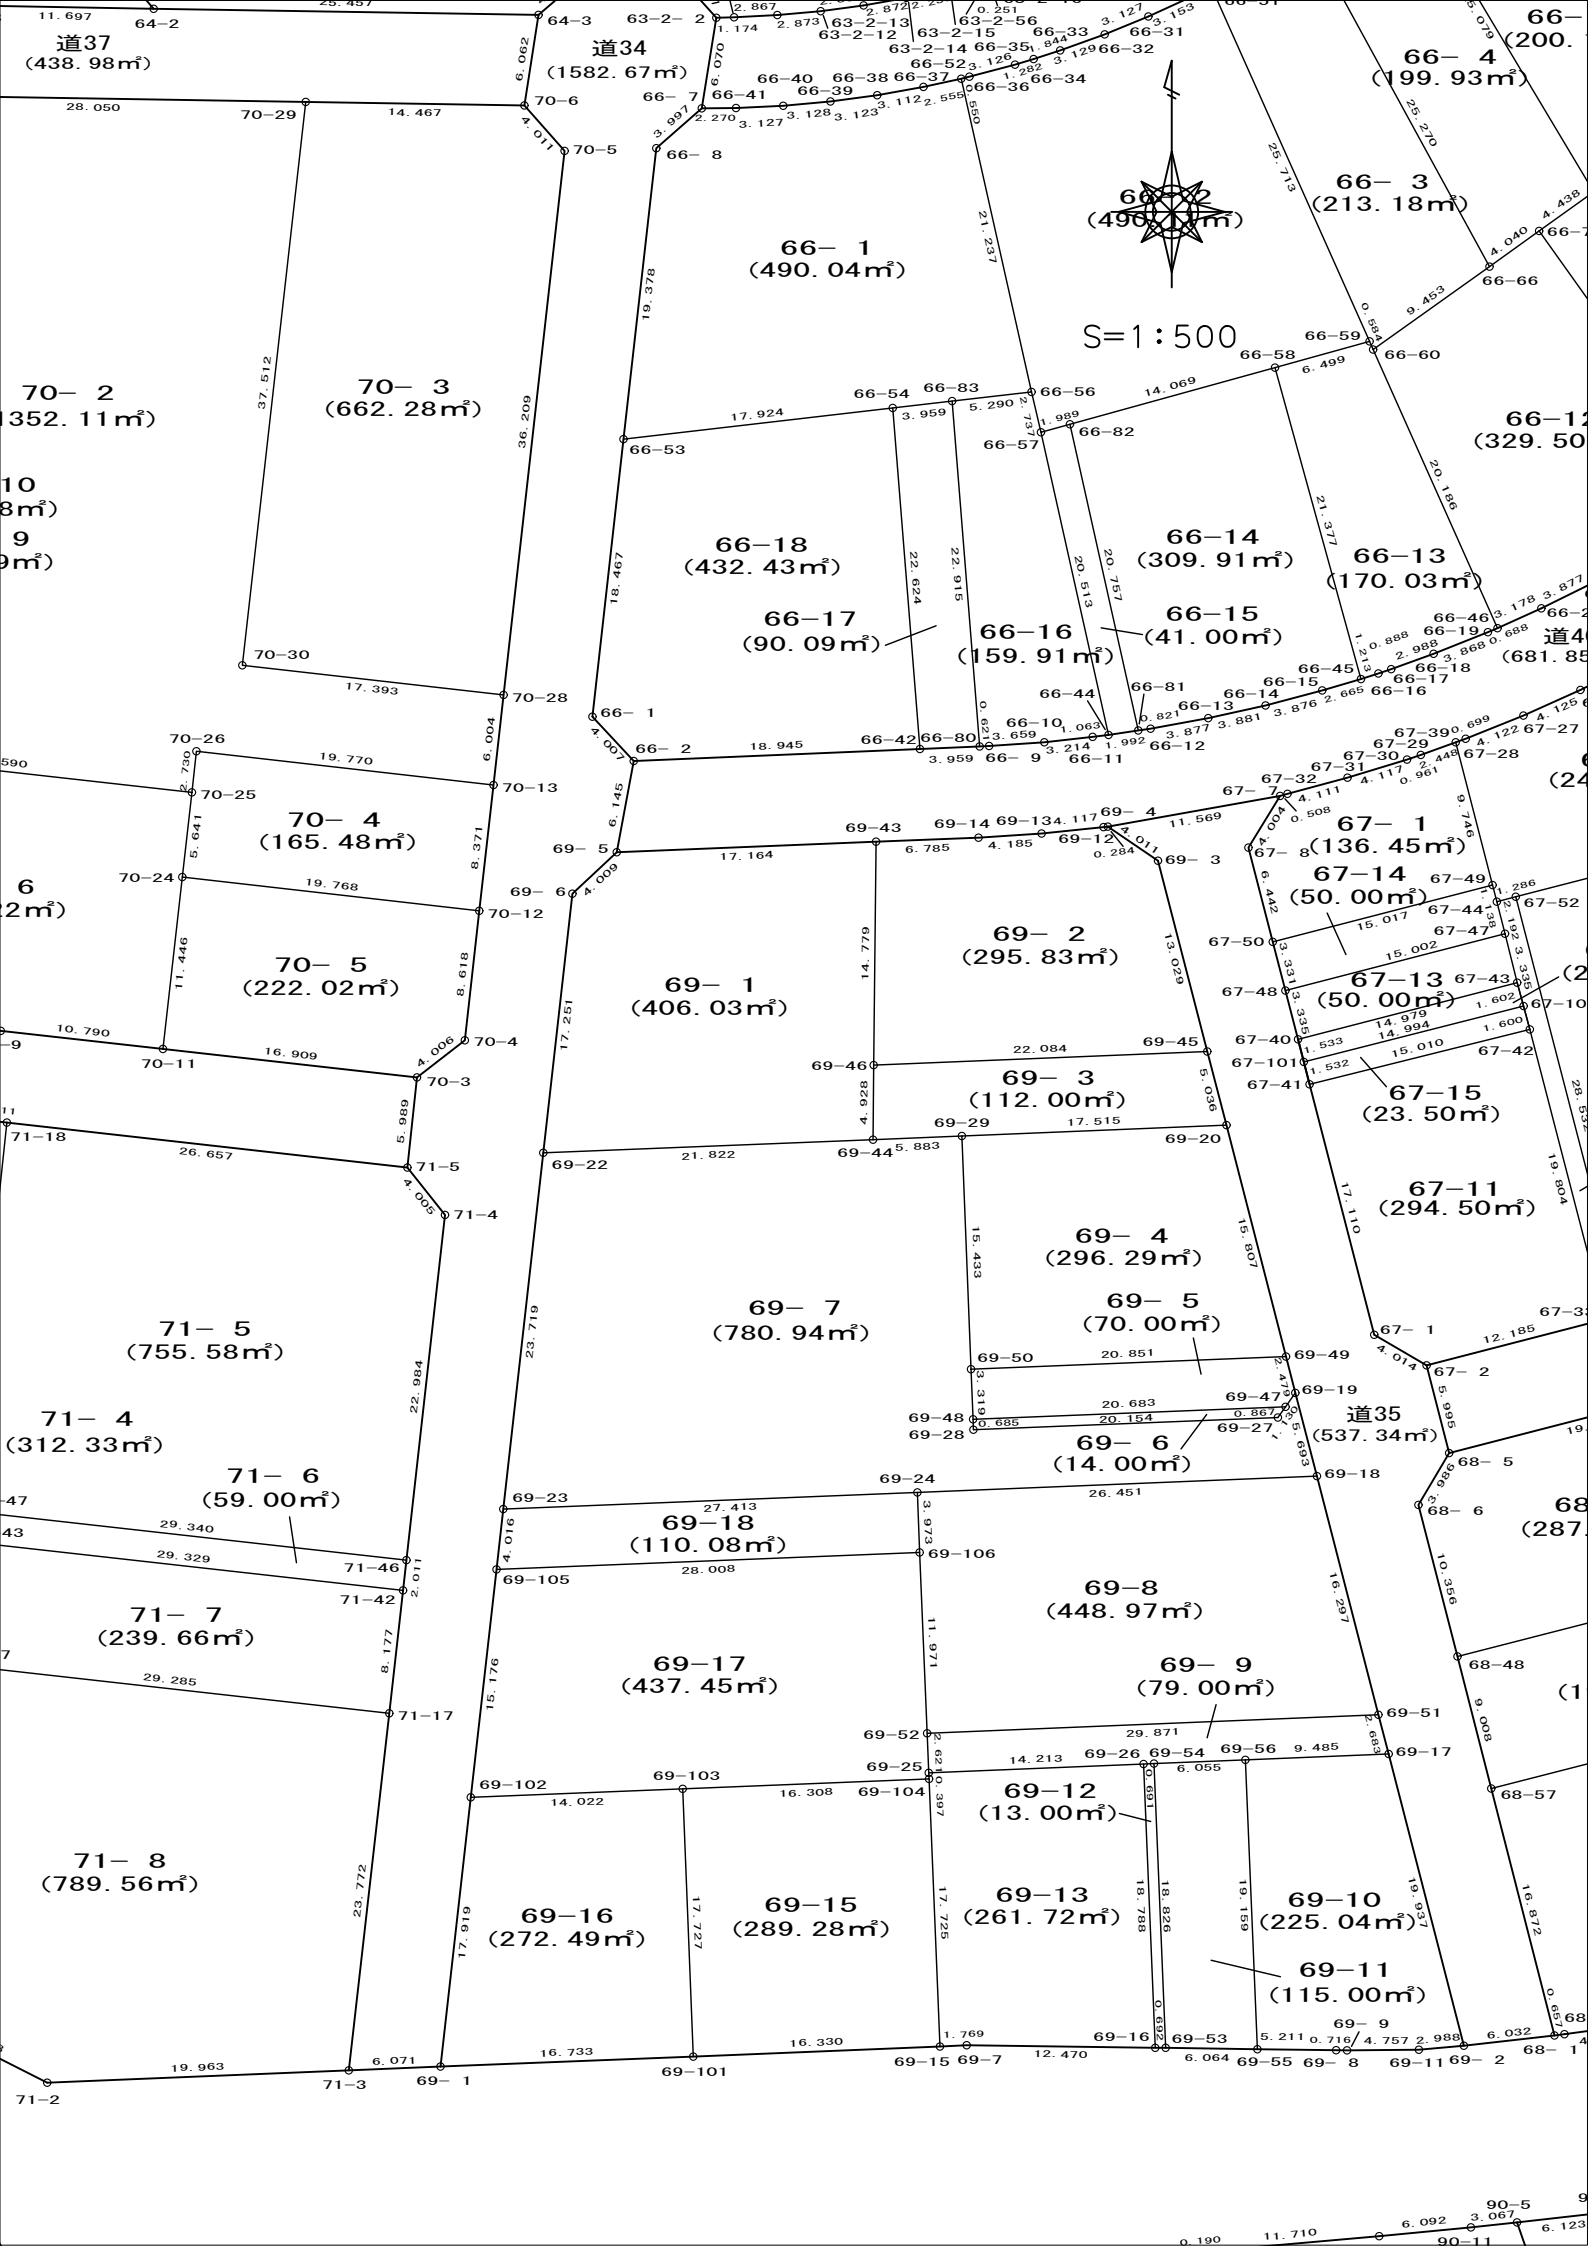

## 画地面積(座標法)計算簿

画地番号：69- 1

| 点名    | Xn        | Yn         | 距離     | 方向角          | X <sub>n+1</sub> -X <sub>n-1</sub> | Y <sub>n+1</sub> -Y <sub>n-1</sub> | X <sub>n</sub> *(Y <sub>n+1</sub> -Y <sub>n-1</sub> ) | Y <sub>n</sub> *(X <sub>n+1</sub> -X <sub>n-1</sub> ) |
|-------|-----------|------------|--------|--------------|------------------------------------|------------------------------------|-------------------------------------------------------|-------------------------------------------------------|
| 69-43 | 47278.171 | -70851.198 | 17.164 | 267° 40' 22" | 14.082                             | -16.999                            | -803681.628829                                        | -997726.570236                                        |
| 69- 5 | 47277.474 | -70868.348 | 4.009  | 226° 59' 27" | -3.432                             | -20.082                            | -949426.232868                                        | 243220.170336                                         |
| 69- 6 | 47274.739 | -70871.280 | 17.251 | 186° 24' 12" | -19.879                            | -4.856                             | -229566.132584                                        | 1408850.175120                                        |
| 69-22 | 47257.595 | -70873.204 | 21.822 | 87° 43' 04"  | -16.275                            | 19.881                             | 939528.246195                                         | 1153461.395100                                        |
| 69-44 | 47258.464 | -70851.399 | 4.928  | 0° 34' 53"   | 5.797                              | 21.855                             | 1032833.730720                                        | -410725.560003                                        |
| 69-46 | 47263.392 | -70851.349 | 14.779 | 0° 35' 07"   | 19.707                             | 0.201                              | 9499.941792                                           | -1396267.534743                                       |
|       |           |            |        |              |                                    |                                    | 倍面積                                                   | -812.075574                                           |
|       |           |            |        |              |                                    |                                    | 面積                                                    | 406.0377870                                           |
|       |           |            |        |              |                                    |                                    | 地積                                                    | 406.03                                                |

## 画地面積(座標法)計算簿

画地番号：69- 2

| 点名    | Xn        | Yn         | 距離     | 方向角          | X <sub>n+1</sub> -X <sub>n-1</sub> | Y <sub>n+1</sub> -Y <sub>n-1</sub> | X <sub>n</sub> *(Y <sub>n+1</sub> -Y <sub>n-1</sub> ) | Y <sub>n</sub> *(X <sub>n+1</sub> -X <sub>n-1</sub> ) |
|-------|-----------|------------|--------|--------------|------------------------------------|------------------------------------|-------------------------------------------------------|-------------------------------------------------------|
| 69- 3 | 47276.913 | -70832.548 | 4.011  | 304° 16' 21" | 14.873                             | -6.580                             | -311082.087540                                        | -1053492.486404                                       |
| 69- 4 | 47279.172 | -70835.863 | 0.284  | 263° 20' 56" | 2.226                              | -3.598                             | -170110.460856                                        | -157680.631038                                        |
| 69-12 | 47279.139 | -70836.146 | 4.117  | 264° 05' 24" | -0.457                             | -4.379                             | -207035.349681                                        | 32372.118722                                          |
| 69-13 | 47278.715 | -70840.242 | 4.185  | 266° 11' 29" | -0.702                             | -8.272                             | -391089.530480                                        | 49729.849884                                          |
| 69-14 | 47278.437 | -70844.418 | 6.785  | 267° 45' 12" | -0.544                             | -10.956                            | -517982.555772                                        | 38539.363392                                          |
| 69-43 | 47278.171 | -70851.198 | 14.779 | 180° 35' 07" | -15.045                            | -6.931                             | -327685.003201                                        | 1065956.273910                                        |
| 69-46 | 47263.392 | -70851.349 | 22.084 | 87° 38' 46"  | -13.872                            | 21.915                             | 1035777.235680                                        | 982849.913328                                         |
| 69-45 | 47264.299 | -70829.283 | 13.029 | 345° 29' 17" | 13.521                             | 18.801                             | 888616.085499                                         | -957682.735443                                        |
|       |           |            |        |              |                                    |                                    | 倍面積                                                   | -591.666351                                           |
|       |           |            |        |              |                                    |                                    | 面積                                                    | 295.8331755                                           |
|       |           |            |        |              |                                    |                                    | 地積                                                    | 295.83                                                |

## 画地面積(座標法)計算簿

画地番号：69- 3

| 点名    | Xn        | Yn         | 距離     | 方向角          | X <sub>n+1</sub> -X <sub>n-1</sub> | Y <sub>n+1</sub> -Y <sub>n-1</sub> | X <sub>n</sub> *(Y <sub>n+1</sub> -Y <sub>n-1</sub> ) | Y <sub>n</sub> *(X <sub>n+1</sub> -X <sub>n-1</sub> ) |
|-------|-----------|------------|--------|--------------|------------------------------------|------------------------------------|-------------------------------------------------------|-------------------------------------------------------|
| 69-29 | 47258.700 | -70845.520 | 17.515 | 87° 37' 52"  | 0.960                              | 23.380                             | 1104908.406000                                        | -68011.699200                                         |
| 69-20 | 47259.424 | -70828.019 | 5.036  | 345° 27' 52" | 5.599                              | 16.237                             | 767351.267488                                         | -396566.078381                                        |
| 69-45 | 47264.299 | -70829.283 | 22.084 | 267° 38' 46" | 3.968                              | -23.330                            | -1102676.095670                                       | -281050.594944                                        |
| 69-46 | 47263.392 | -70851.349 | 4.928  | 180° 34' 53" | -5.835                             | -22.116                            | -1045277.177472                                       | 413417.621415                                         |
| 69-44 | 47258.464 | -70851.399 | 5.883  | 87° 42' 04"  | -4.692                             | 5.829                              | 275469.586656                                         | 332434.764108                                         |
|       |           |            |        |              |                                    |                                    | 倍面積                                                   | -224.012998                                           |
|       |           |            |        |              |                                    |                                    | 面積                                                    | 112.0064990                                           |
|       |           |            |        |              |                                    |                                    | 地積                                                    | 112.00                                                |

## 画地面積(座標法)計算簿

画地番号：69- 4

| 点名         | Xn        | Yn         | 距離     | 方向角          | X <sub>n+1</sub> -X <sub>n-1</sub> | Y <sub>n+1</sub> -Y <sub>n-1</sub> | X <sub>n</sub> *(Y <sub>n+1</sub> -Y <sub>n-1</sub> ) | Y <sub>n</sub> *(X <sub>n+1</sub> -X <sub>n-1</sub> ) |
|------------|-----------|------------|--------|--------------|------------------------------------|------------------------------------|-------------------------------------------------------|-------------------------------------------------------|
| 69-20      | 47259.424 | -70828.019 | 17.515 | 267° 37' 52" | 14.584                             | -21.442                            | -1013336.569408                                       | -1032955.829096                                       |
| 69-29      | 47258.700 | -70845.520 | 15.433 | 177° 44' 46" | -16.146                            | -16.894                            | -798388.477800                                        | 1143871.765920                                        |
| 69-50      | 47243.278 | -70844.913 | 20.851 | 87° 41' 48"  | -14.584                            | 21.442                             | 1012990.366876                                        | 1033202.211192                                        |
| 69-49      | 47244.116 | -70824.078 | 15.807 | 345° 33' 46" | 16.146                             | 16.894                             | 798142.095704                                         | -1143525.563388                                       |
| <b>倍面積</b> |           |            |        |              |                                    |                                    |                                                       | -592.584628                                           |
| <b>面積</b>  |           |            |        |              |                                    |                                    |                                                       | 296.2923140                                           |
| <b>地積</b>  |           |            |        |              |                                    |                                    |                                                       | 296.29                                                |

## 画地面積(座標法)計算簿

画地番号：69- 5

| 点名    | Xn        | Yn         | 距離     | 方向角          | X <sub>n+1</sub> -X <sub>n-1</sub> | Y <sub>n+1</sub> -Y <sub>n-1</sub> | X <sub>n</sub> *(Y <sub>n+1</sub> -Y <sub>n-1</sub> ) | Y <sub>n</sub> *(X <sub>n+1</sub> -X <sub>n-1</sub> ) |
|-------|-----------|------------|--------|--------------|------------------------------------|------------------------------------|-------------------------------------------------------|-------------------------------------------------------|
| 69-48 | 47239.961 | -70844.782 | 20.683 | 87° 41' 41"  | -2.485                             | 20.798                             | 982496.708878                                         | 176049.283270                                         |
| 69-47 | 47240.793 | -70824.115 | 1.130  | 35° 23' 26"  | 1.754                              | 21.322                             | 1007268.188346                                        | -124225.497710                                        |
| 69-19 | 47241.715 | -70823.460 | 2.479  | 345° 33' 57" | 3.323                              | 0.037                              | 1747.943455                                           | -235346.357580                                        |
| 69-49 | 47244.116 | -70824.078 | 20.851 | 267° 41' 48" | 1.563                              | -21.453                            | -1013528.020548                                       | -110698.033914                                        |
| 69-50 | 47243.278 | -70844.913 | 3.319  | 177° 44' 18" | -4.155                             | -20.704                            | -978124.827712                                        | 294360.613515                                         |
|       |           |            |        |              |                                    |                                    | 倍面積                                                   | -140.007581                                           |
|       |           |            |        |              |                                    |                                    | 面積                                                    | 70.0037905                                            |
|       |           |            |        |              |                                    |                                    | 地積                                                    | 70.00                                                 |

## 画地面積(座標法)計算簿

画地番号：69- 6

| 点名    | Xn        | Yn         | 距離     | 方向角          | X <sub>n+1</sub> -X <sub>n-1</sub> | Y <sub>n+1</sub> -Y <sub>n-1</sub> | X <sub>n</sub> *(Y <sub>n+1</sub> -Y <sub>n-1</sub> ) | Y <sub>n</sub> *(X <sub>n+1</sub> -X <sub>n-1</sub> ) |
|-------|-----------|------------|--------|--------------|------------------------------------|------------------------------------|-------------------------------------------------------|-------------------------------------------------------|
| 69-27 | 47240.086 | -70824.617 | 0.867  | 35° 22' 35"  | 1.517                              | 20.640                             | 975035.375040                                         | -107440.943989                                        |
| 69-47 | 47240.793 | -70824.115 | 20.683 | 267° 41' 41" | -0.125                             | -20.165                            | -952610.590845                                        | 8853.014375                                           |
| 69-48 | 47239.961 | -70844.782 | 0.685  | 177° 44' 34" | -1.517                             | -20.640                            | -975032.795040                                        | 107471.534294                                         |
| 69-28 | 47239.276 | -70844.755 | 20.154 | 87° 41' 48"  | 0.125                              | 20.165                             | 952580.000540                                         | -8855.594375                                          |
|       |           |            |        |              |                                    |                                    | 倍面積                                                   | -28.010305                                            |
|       |           |            |        |              |                                    |                                    | 面積                                                    | 14.0051525                                            |
|       |           |            |        |              |                                    |                                    | 地積                                                    | 14.00                                                 |



## 画地面積(座標法)計算簿

画地番号：69- 7

| 点名    | Xn        | Yn         | 距離     | 方向角          | X <sub>n+1</sub> -X <sub>n-1</sub> | Y <sub>n+1</sub> -Y <sub>n-1</sub> | X <sub>n</sub> *(Y <sub>n+1</sub> -Y <sub>n-1</sub> ) | Y <sub>n</sub> *(X <sub>n+1</sub> -X <sub>n-1</sub> ) |
|-------|-----------|------------|--------|--------------|------------------------------------|------------------------------------|-------------------------------------------------------|-------------------------------------------------------|
| 69-19 | 47241.715 | -70823.460 | 1.130  | 215° 23' 26" | 4.589                              | -2.083                             | -98404.492345                                         | -325008.857940                                        |
| 69-47 | 47240.793 | -70824.115 | 0.867  | 215° 22' 35" | -1.629                             | -1.157                             | -54657.597501                                         | 115372.483335                                         |
| 69-27 | 47240.086 | -70824.617 | 20.154 | 267° 41' 48" | -1.517                             | -20.640                            | -975035.375040                                        | 107440.943989                                         |
| 69-28 | 47239.276 | -70844.755 | 0.685  | 357° 44' 34" | -0.125                             | -20.165                            | -952580.000540                                        | 8855.594375                                           |
| 69-48 | 47239.961 | -70844.782 | 3.319  | 357° 44' 18" | 4.002                              | -0.158                             | -7463.913838                                          | -283520.817564                                        |
| 69-50 | 47243.278 | -70844.913 | 15.433 | 357° 44' 46" | 18.739                             | -0.738                             | -34865.539164                                         | -1327562.824707                                       |
| 69-29 | 47258.700 | -70845.520 | 5.883  | 267° 42' 04" | 15.186                             | -6.486                             | -306519.928200                                        | -1075860.066720                                       |
| 69-44 | 47258.464 | -70851.399 | 21.822 | 267° 43' 04" | -1.105                             | -27.684                            | -1308303.317376                                       | 78290.795895                                          |
| 69-22 | 47257.595 | -70873.204 | 23.719 | 186° 24' 44" | -24.440                            | -24.454                            | -1155637.228130                                       | 1732141.105760                                        |
| 69-23 | 47234.024 | -70875.853 | 27.413 | 87° 41' 46"  | -22.469                            | 24.742                             | 1168664.221808                                        | 1592509.541057                                        |
| 69-24 | 47235.126 | -70848.462 | 26.451 | 87° 39' 52"  | 2.180                              | 53.821                             | 2542241.716446                                        | -154449.647160                                        |
| 69-18 | 47236.204 | -70822.032 | 5.693  | 345° 28' 23" | 6.589                              | 25.002                             | 1180999.572408                                        | -466646.368848                                        |
|       |           |            |        |              |                                    |                                    | 倍面積                                                   | -1561.881472                                          |
|       |           |            |        |              |                                    |                                    | 面積                                                    | 780.9407360                                           |
|       |           |            |        |              |                                    |                                    | 地積                                                    | 780.94                                                |

## 画地面積(座標法)計算簿

画地番号：69- 8

| 点名     | X <sub>n</sub> | Y <sub>n</sub> | 距離     | 方向角          | X <sub>n+1</sub> -X <sub>n-1</sub> | Y <sub>n+1</sub> -Y <sub>n-1</sub> | X <sub>n</sub> *(Y <sub>n+1</sub> -Y <sub>n-1</sub> ) | Y <sub>n</sub> *(X <sub>n+1</sub> -X <sub>n-1</sub> ) |
|--------|----------------|----------------|--------|--------------|------------------------------------|------------------------------------|-------------------------------------------------------|-------------------------------------------------------|
| 69-18  | 47236.204      | -70822.032     | 26.451 | 267° 39' 52" | 14.704                             | -30.496                            | -1440515.277184                                       | -1041367.158528                                       |
| 69-24  | 47235.126      | -70848.462     | 3.973  | 177° 47' 37" | -5.049                             | -26.277                            | -1241197.405902                                       | 357713.884638                                         |
| 69-106 | 47231.155      | -70848.309     | 11.971 | 177° 37' 14" | -15.932                            | 0.650                              | 30700.250750                                          | 1128755.258988                                        |
| 69-52  | 47219.194      | -70847.812     | 29.871 | 87° 38' 38"  | -10.733                            | 30.343                             | 1432772.003542                                        | 760409.566196                                         |
| 69-51  | 47220.422      | -70817.966     | 16.297 | 345° 33' 10" | 17.010                             | 25.780                             | 1217342.479160                                        | -1204613.601660                                       |
|        |                |                |        |              |                                    |                                    | 倍面積                                                   | -897.949634                                           |
|        |                |                |        |              |                                    |                                    | 面積                                                    | 448.9748170                                           |
|        |                |                |        |              |                                    |                                    | 地積                                                    | 448.97                                                |

## 画地面積(座標法)計算簿

画地番号：69- 9

| 点名    | Xn        | Yn         | 距離     | 方向角          | X <sub>n+1</sub> -X <sub>n-1</sub> | Y <sub>n+1</sub> -Y <sub>n-1</sub> | X <sub>n</sub> *(Y <sub>n+1</sub> -Y <sub>n-1</sub> ) | Y <sub>n</sub> *(X <sub>n+1</sub> -X <sub>n-1</sub> ) |
|-------|-----------|------------|--------|--------------|------------------------------------|------------------------------------|-------------------------------------------------------|-------------------------------------------------------|
| 69-25 | 47216.575 | -70847.707 | 14.213 | 87° 37' 44"  | -2.031                             | 14.306                             | 675480.321950                                         | 143891.692917                                         |
| 69-26 | 47217.163 | -70833.506 | 0.691  | 87° 40' 47"  | 0.616                              | 14.892                             | 703157.991396                                         | -43633.439696                                         |
| 69-54 | 47217.191 | -70832.815 | 6.055  | 87° 39' 44"  | 0.275                              | 6.741                              | 318291.084531                                         | -19479.024125                                         |
| 69-56 | 47217.438 | -70826.765 | 9.485  | 87° 39' 21"  | 0.635                              | 15.528                             | 733192.377264                                         | -44974.995775                                         |
| 69-17 | 47217.826 | -70817.287 | 2.683  | 345° 20' 32" | 2.984                              | 8.799                              | 415469.650974                                         | -211318.784408                                        |
| 69-51 | 47220.422 | -70817.966 | 29.871 | 267° 38' 38" | 1.368                              | -30.525                            | -1441403.381550                                       | -96878.977488                                         |
| 69-52 | 47219.194 | -70847.812 | 2.621  | 177° 42' 15" | -3.847                             | -29.741                            | -1404346.048754                                       | 272551.532764                                         |
|       |           |            |        |              |                                    |                                    | 倍面積                                                   | -158.004189                                           |
|       |           |            |        |              |                                    |                                    | 面積                                                    | 79.0020945                                            |
|       |           |            |        |              |                                    |                                    | 地積                                                    | 79.00                                                 |

## 画地面積(座標法)計算簿

画地番号：69-10

| 点名    | X <sub>n</sub> | Y <sub>n</sub> | 距離     | 方向角          | X <sub>n+1</sub> -X <sub>n-1</sub> | Y <sub>n+1</sub> -Y <sub>n-1</sub> | X <sub>n</sub> *(Y <sub>n+1</sub> -Y <sub>n-1</sub> ) | Y <sub>n</sub> *(X <sub>n+1</sub> -X <sub>n-1</sub> ) |
|-------|----------------|----------------|--------|--------------|------------------------------------|------------------------------------|-------------------------------------------------------|-------------------------------------------------------|
| 69-17 | 47217.826      | -70817.287     | 9.485  | 267° 39' 21" | 18.919                             | -14.454                            | -682486.457004                                        | -1339792.252753                                       |
| 69-56 | 47217.438      | -70826.765     | 19.159 | 177° 37' 40" | -19.531                            | -8.685                             | -410083.449030                                        | 1383317.547215                                        |
| 69-55 | 47198.295      | -70825.972     | 5.211  | 90° 48' 09"  | -19.216                            | 6.004                              | 283378.563180                                         | 1360991.877952                                        |
| 69- 8 | 47198.222      | -70820.761     | 0.716  | 90° 04' 48"  | -0.074                             | 5.927                              | 279743.861794                                         | 5240.736314                                           |
| 69- 9 | 47198.221      | -70820.045     | 4.757  | 89° 30' 22"  | 0.040                              | 5.473                              | 258315.863533                                         | -2832.801800                                          |
| 69-11 | 47198.262      | -70815.288     | 2.988  | 85° 03' 58"  | 0.298                              | 7.734                              | 365031.358308                                         | -21102.955824                                         |
| 69- 2 | 47198.519      | -70812.311     | 19.937 | 345° 32' 52" | 19.564                             | -1.999                             | -94349.839481                                         | -1385372.052404                                       |
|       |                |                |        |              |                                    |                                    | 倍面積                                                   | -450.098700                                           |
|       |                |                |        |              |                                    |                                    | 面積                                                    | 225.0493500                                           |
|       |                |                |        |              |                                    |                                    | 地積                                                    | 225.04                                                |

## 画地面積(座標法)計算簿

画地番号：69-11

| 点名    | Xn        | Yn         | 距離     | 方向角          | X <sub>n+1</sub> -X <sub>n-1</sub> | Y <sub>n+1</sub> -Y <sub>n-1</sub> | X <sub>n</sub> *(Y <sub>n+1</sub> -Y <sub>n-1</sub> ) | Y <sub>n</sub> *(X <sub>n+1</sub> -X <sub>n-1</sub> ) |
|-------|-----------|------------|--------|--------------|------------------------------------|------------------------------------|-------------------------------------------------------|-------------------------------------------------------|
| 69-54 | 47217.191 | -70832.815 | 18.826 | 177° 37' 43" | -19.057                            | -5.271                             | -248881.813761                                        | 1349860.955455                                        |
| 69-53 | 47198.381 | -70832.036 | 6.064  | 90° 48' 45"  | -18.896                            | 6.843                              | 322978.521183                                         | 1338442.152256                                        |
| 69-55 | 47198.295 | -70825.972 | 19.159 | 357° 37' 40" | 19.057                             | 5.271                              | 248782.212945                                         | -1349730.548404                                       |
| 69-56 | 47217.438 | -70826.765 | 6.055  | 267° 39' 44" | 18.896                             | -6.843                             | -323108.928234                                        | -1338342.551440                                       |
|       |           |            |        |              |                                    |                                    | 倍面積                                                   | -230.007867                                           |
|       |           |            |        |              |                                    |                                    | 面積                                                    | 115.0039335                                           |
|       |           |            |        |              |                                    |                                    | 地積                                                    | 115.00                                                |

## 画地面積(座標法)計算簿

画地番号：69-12

| 点名    | X <sub>n</sub> | Y <sub>n</sub> | 距離     | 方向角          | X <sub>n+1</sub> -X <sub>n-1</sub> | Y <sub>n+1</sub> -Y <sub>n-1</sub> | X <sub>n</sub> *(Y <sub>n+1</sub> -Y <sub>n-1</sub> ) | Y <sub>n</sub> *(X <sub>n+1</sub> -X <sub>n-1</sub> ) |
|-------|----------------|----------------|--------|--------------|------------------------------------|------------------------------------|-------------------------------------------------------|-------------------------------------------------------|
| 69-26 | 47217.163      | -70833.506     | 18.788 | 177° 37' 36" | -18.800                            | 0.087                              | 4107.893181                                           | 1331669.912800                                        |
| 69-16 | 47198.391      | -70832.728     | 0.692  | 90° 49' 40"  | -18.782                            | 1.470                              | 69381.634770                                          | 1330380.297296                                        |
| 69-53 | 47198.381      | -70832.036     | 18.826 | 357° 37' 43" | 18.800                             | -0.087                             | -4106.259147                                          | -1331642.276800                                       |
| 69-54 | 47217.191      | -70832.815     | 0.691  | 267° 40' 47" | 18.782                             | -1.470                             | -69409.270770                                         | -1330381.931330                                       |
|       |                |                |        |              |                                    |                                    | 倍面積                                                   | -26.001966                                            |
|       |                |                |        |              |                                    |                                    | 面積                                                    | 13.0009830                                            |
|       |                |                |        |              |                                    |                                    | 地積                                                    | 13.00                                                 |

## 画地面積(座標法)計算簿

画地番号：69-13

| 点名     | Xn        | Yn         | 距離     | 方向角          | X <sub>n+1</sub> -X <sub>n-1</sub> | Y <sub>n+1</sub> -Y <sub>n-1</sub> | X <sub>n</sub> *(Y <sub>n+1</sub> -Y <sub>n-1</sub> ) | Y <sub>n</sub> *(X <sub>n+1</sub> -X <sub>n-1</sub> ) |
|--------|-----------|------------|--------|--------------|------------------------------------|------------------------------------|-------------------------------------------------------|-------------------------------------------------------|
| 69-16  | 47198.391 | -70832.728 | 18.788 | 357° 37' 36" | 18.610                             | 11.691                             | 551796.389181                                         | -1318197.068080                                       |
| 69-26  | 47217.163 | -70833.506 | 14.213 | 267° 37' 44" | 18.184                             | -14.979                            | -707265.884577                                        | -1288036.473104                                       |
| 69-25  | 47216.575 | -70847.707 | 0.397  | 177° 58' 49" | -0.985                             | -14.187                            | -669861.549525                                        | 69784.991395                                          |
| 69-104 | 47216.178 | -70847.693 | 17.725 | 177° 38' 35" | -18.108                            | 0.743                              | 35081.620254                                          | 1282910.024844                                        |
| 69-15  | 47198.467 | -70846.964 | 1.769  | 87° 12' 49"  | -17.625                            | 2.496                              | 117807.373632                                         | 1248677.740500                                        |
| 69-7   | 47198.553 | -70845.197 | 12.470 | 90° 44' 40"  | -0.076                             | 14.236                             | 671918.600508                                         | 5384.234972                                           |
|        |           |            |        |              |                                    |                                    | 倍面積                                                   | -523.450527                                           |
|        |           |            |        |              |                                    |                                    | 面積                                                    | 261.7252635                                           |
|        |           |            |        |              |                                    |                                    | 地積                                                    | 261.72                                                |

## 画地面積(座標法)計算簿

画地番号：69-15

| 点名         | Xn        | Yn         | 距離     | 方向角          | X <sub>n+1</sub> -X <sub>n-1</sub> | Y <sub>n+1</sub> -Y <sub>n-1</sub> | X <sub>n</sub> *(Y <sub>n+1</sub> -Y <sub>n-1</sub> ) | Y <sub>n</sub> *(X <sub>n+1</sub> -X <sub>n-1</sub> ) |
|------------|-----------|------------|--------|--------------|------------------------------------|------------------------------------|-------------------------------------------------------|-------------------------------------------------------|
| 69-103     | 47215.517 | -70863.988 | 16.308 | 87° 40' 38"  | 18.374                             | 15.588                             | 735995.478996                                         | -1302054.915512                                       |
| 69-104     | 47216.178 | -70847.693 | 17.725 | 177° 38' 35" | -17.050                            | 17.024                             | 803808.214272                                         | 1207953.165650                                        |
| 69-15      | 47198.467 | -70846.964 | 16.330 | 267° 40' 24" | -18.374                            | -15.588                            | -735729.703596                                        | 1301742.116536                                        |
| 69-101     | 47197.804 | -70863.281 | 17.727 | 357° 42' 51" | 17.050                             | -17.024                            | -803495.415296                                        | -1208218.941050                                       |
| <b>倍面積</b> |           |            |        |              |                                    |                                    |                                                       | 578.574376                                            |
| <b>面積</b>  |           |            |        |              |                                    |                                    |                                                       | 289.2871880                                           |
| <b>地積</b>  |           |            |        |              |                                    |                                    |                                                       | 289.28                                                |



## 画地面積(座標法)計算簿

画地番号：69-16

| 点名     | Xn        | Yn         | 距離     | 方向角          | X <sub>n+1</sub> -X <sub>n-1</sub> | Y <sub>n+1</sub> -Y <sub>n-1</sub> | X <sub>n</sub> *(Y <sub>n+1</sub> -Y <sub>n-1</sub> ) | Y <sub>n</sub> *(X <sub>n+1</sub> -X <sub>n-1</sub> ) |
|--------|-----------|------------|--------|--------------|------------------------------------|------------------------------------|-------------------------------------------------------|-------------------------------------------------------|
| 69-102 | 47214.951 | -70877.999 | 14.022 | 87° 41' 12"  | 18.373                             | 16.013                             | 756053.010363                                         | -1302241.475627                                       |
| 69-103 | 47215.517 | -70863.988 | 17.727 | 177° 42' 51" | -17.147                            | 14.718                             | 694917.979206                                         | 1215104.802236                                        |
| 69-101 | 47197.804 | -70863.281 | 16.733 | 267° 44' 22" | -18.373                            | -16.013                            | -755778.435452                                        | 1301971.061813                                        |
| 69- 1  | 47197.144 | -70880.001 | 17.919 | 6° 24' 53"   | 17.147                             | -14.718                            | -694647.565392                                        | -1215379.377147                                       |
|        |           |            |        |              |                                    |                                    | 倍面積                                                   | 544.988725                                            |
|        |           |            |        |              |                                    |                                    | 面積                                                    | 272.4943625                                           |
|        |           |            |        |              |                                    |                                    | 地積                                                    | 272.49                                                |

## 画地面積(座標法)計算簿

画地番号：69-17

| 点名     | Xn        | Yn         | 距離     | 方向角          | X <sub>n+1</sub> -X <sub>n-1</sub> | Y <sub>n+1</sub> -Y <sub>n-1</sub> | X <sub>n</sub> *(Y <sub>n+1</sub> -Y <sub>n-1</sub> ) | Y <sub>n</sub> *(X <sub>n+1</sub> -X <sub>n-1</sub> ) |
|--------|-----------|------------|--------|--------------|------------------------------------|------------------------------------|-------------------------------------------------------|-------------------------------------------------------|
| 69-105 | 47230.032 | -70876.295 | 28.008 | 87° 42' 08"  | 16.204                             | 29.690                             | 1402259.650080                                        | -1148479.484180                                       |
| 69-106 | 47231.155 | -70848.309 | 11.971 | 177° 37' 14" | -10.838                            | 28.483                             | 1345284.987865                                        | 767853.972942                                         |
| 69-52  | 47219.194 | -70847.812 | 2.621  | 177° 42' 15" | -14.580                            | 0.602                              | 28425.954788                                          | 1032961.098960                                        |
| 69-25  | 47216.575 | -70847.707 | 0.397  | 177° 58' 49" | -3.016                             | 0.119                              | 5618.772425                                           | 213676.684312                                         |
| 69-104 | 47216.178 | -70847.693 | 16.308 | 267° 40' 38" | -1.058                             | -16.281                            | -768726.594018                                        | 74956.859194                                          |
| 69-103 | 47215.517 | -70863.988 | 14.022 | 267° 41' 12" | -1.227                             | -30.306                            | -1430913.458202                                       | 86950.113276                                          |
| 69-102 | 47214.951 | -70877.999 | 15.176 | 6° 26' 47"   | 14.515                             | -12.307                            | -581074.401957                                        | -1028794.155485                                       |
|        |           |            |        |              |                                    |                                    | 倍面積                                                   | 874.910981                                            |
|        |           |            |        |              |                                    |                                    | 面積                                                    | 437.4554905                                           |
|        |           |            |        |              |                                    |                                    | 地積                                                    | 437.45                                                |

## 画地面積(座標法)計算簿

画地番号：69-18

| 点名     | Xn        | Yn         | 距離     | 方向角          | X <sub>n+1</sub> -X <sub>n-1</sub> | Y <sub>n+1</sub> -Y <sub>n-1</sub> | X <sub>n</sub> *(Y <sub>n+1</sub> -Y <sub>n-1</sub> ) | Y <sub>n</sub> *(X <sub>n+1</sub> -X <sub>n-1</sub> ) |
|--------|-----------|------------|--------|--------------|------------------------------------|------------------------------------|-------------------------------------------------------|-------------------------------------------------------|
| 69-23  | 47234.024 | -70875.853 | 27.413 | 87° 41' 46"  | 5.094                              | 27.833                             | 1314664.589992                                        | -361041.595182                                        |
| 69-24  | 47235.126 | -70848.462 | 3.973  | 177° 47' 37" | -2.869                             | 27.544                             | 1301044.310544                                        | 203264.237478                                         |
| 69-106 | 47231.155 | -70848.309 | 28.008 | 267° 42' 08" | -5.094                             | -27.833                            | -1314584.737115                                       | 360901.286046                                         |
| 69-105 | 47230.032 | -70876.295 | 4.016  | 6° 19' 05"   | 2.869                              | -27.544                            | -1300904.001408                                       | -203344.090355                                        |
|        |           |            |        |              |                                    |                                    | 倍面積                                                   | 220.162013                                            |
|        |           |            |        |              |                                    |                                    | 面積                                                    | 110.0810065                                           |
|        |           |            |        |              |                                    |                                    | 地積                                                    | 110.08                                                |