



79街区 画地出来形確認図 (3358.00m²)

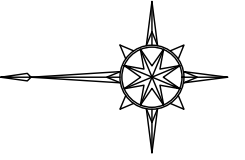


S=1:500

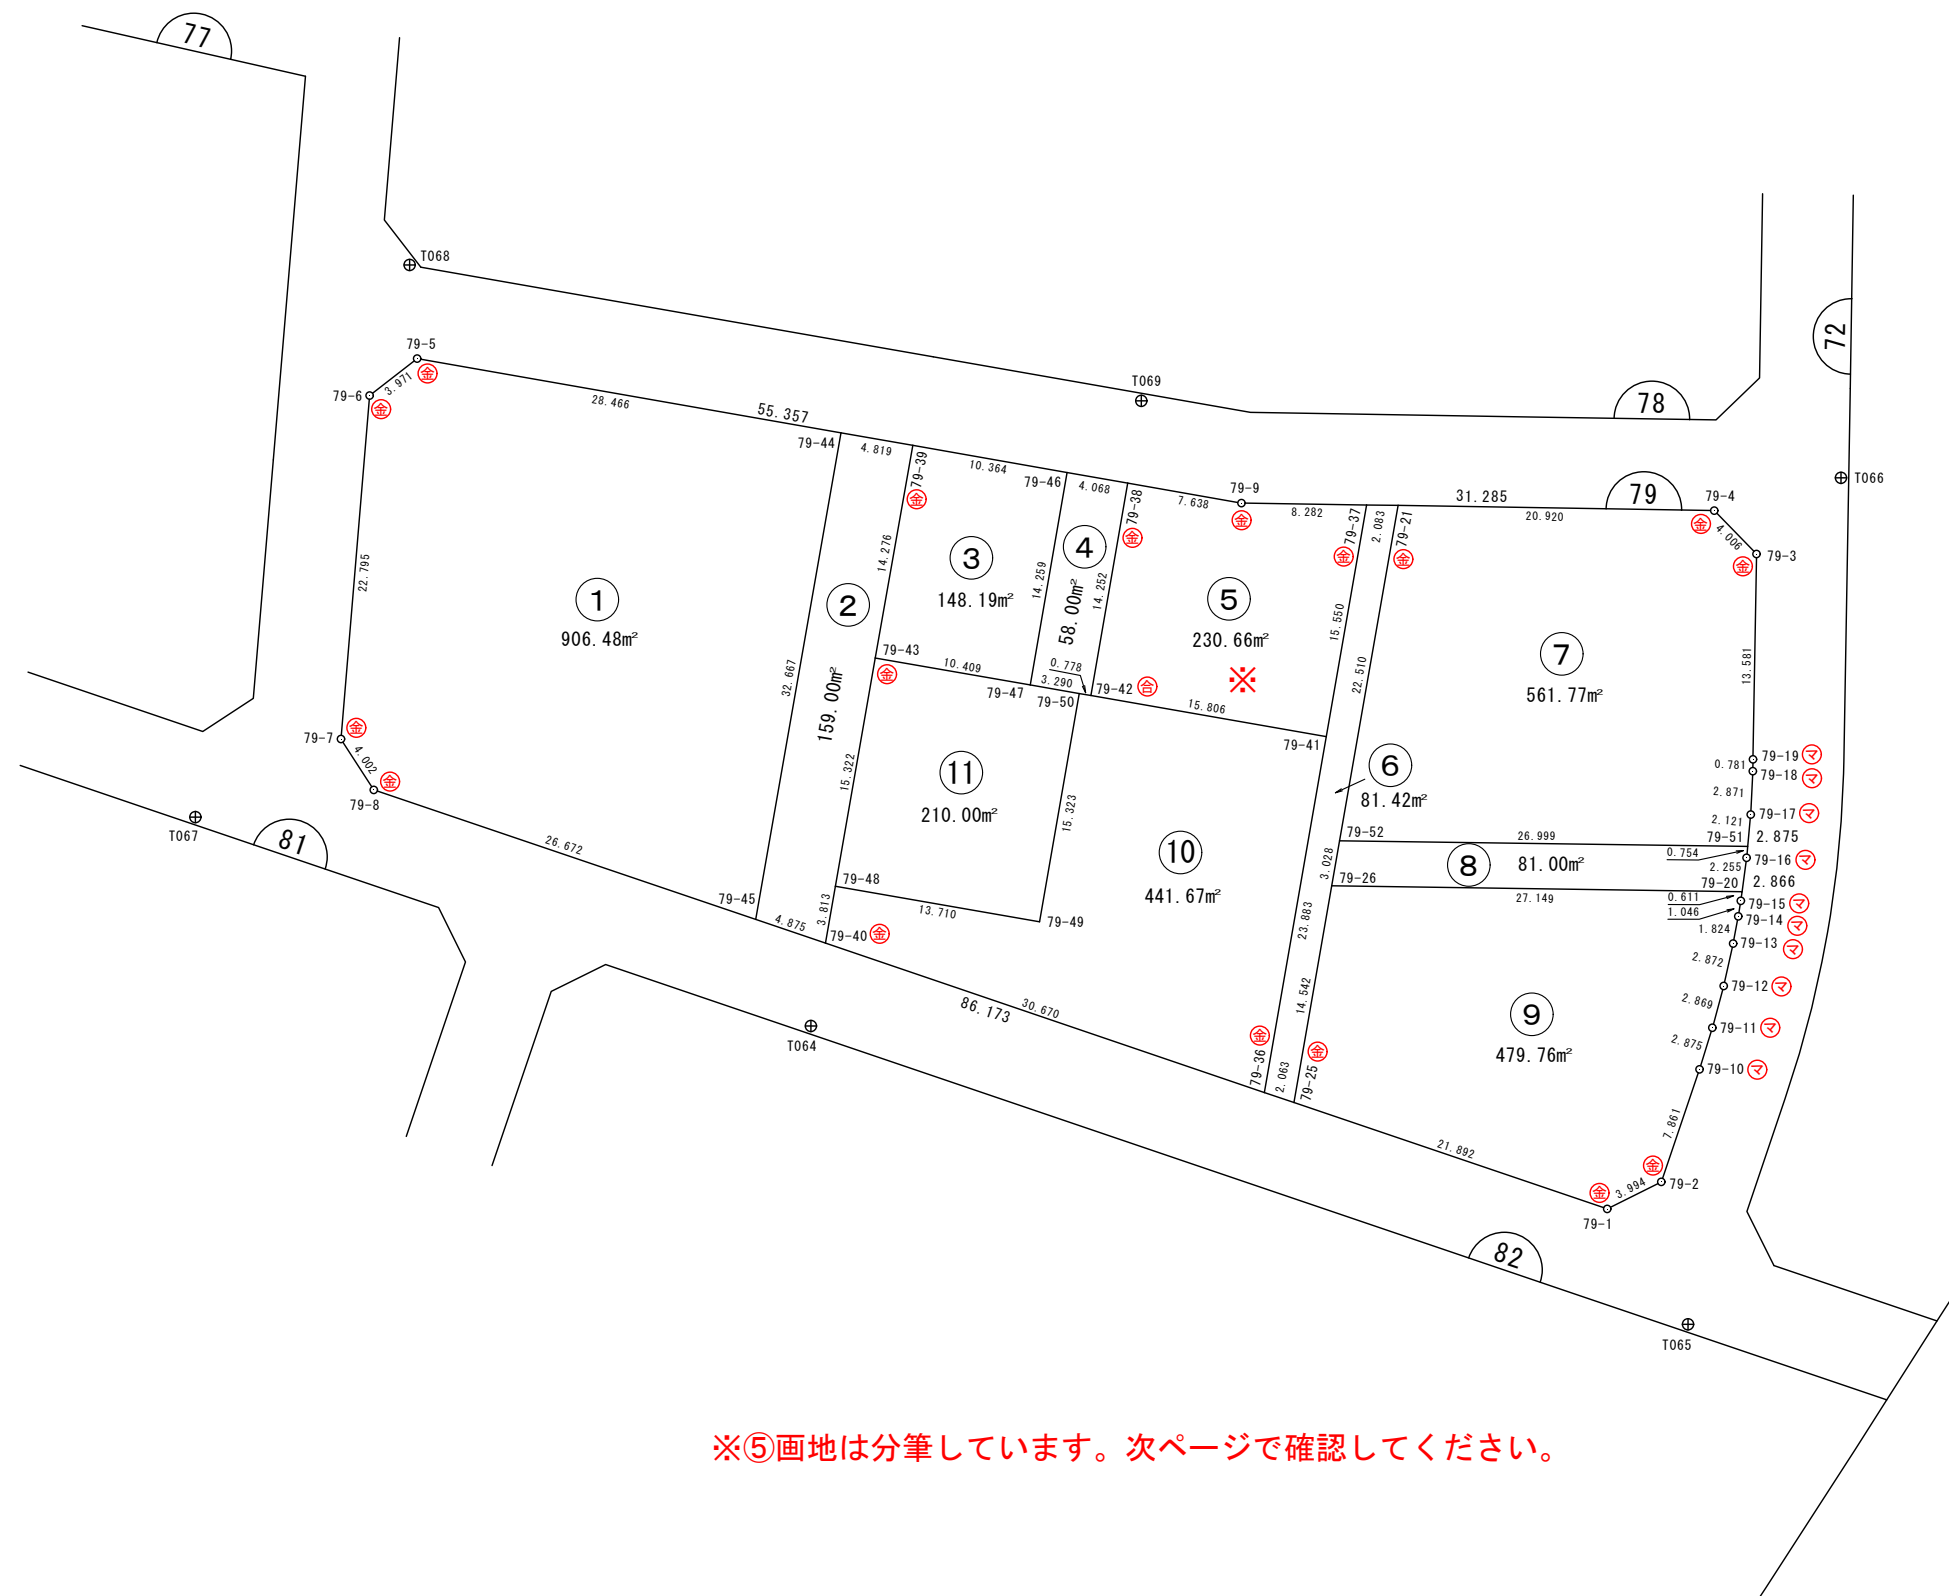

※⑤画地は分筆しています。次ページで確認してください。

凡 例	
事 項	記 号
金属プレート	Ⓜ
コンクリート杭	Ⓜ
金属 鋸	Ⓜ
合成樹脂杭	Ⓜ
マーキング	Ⓜ

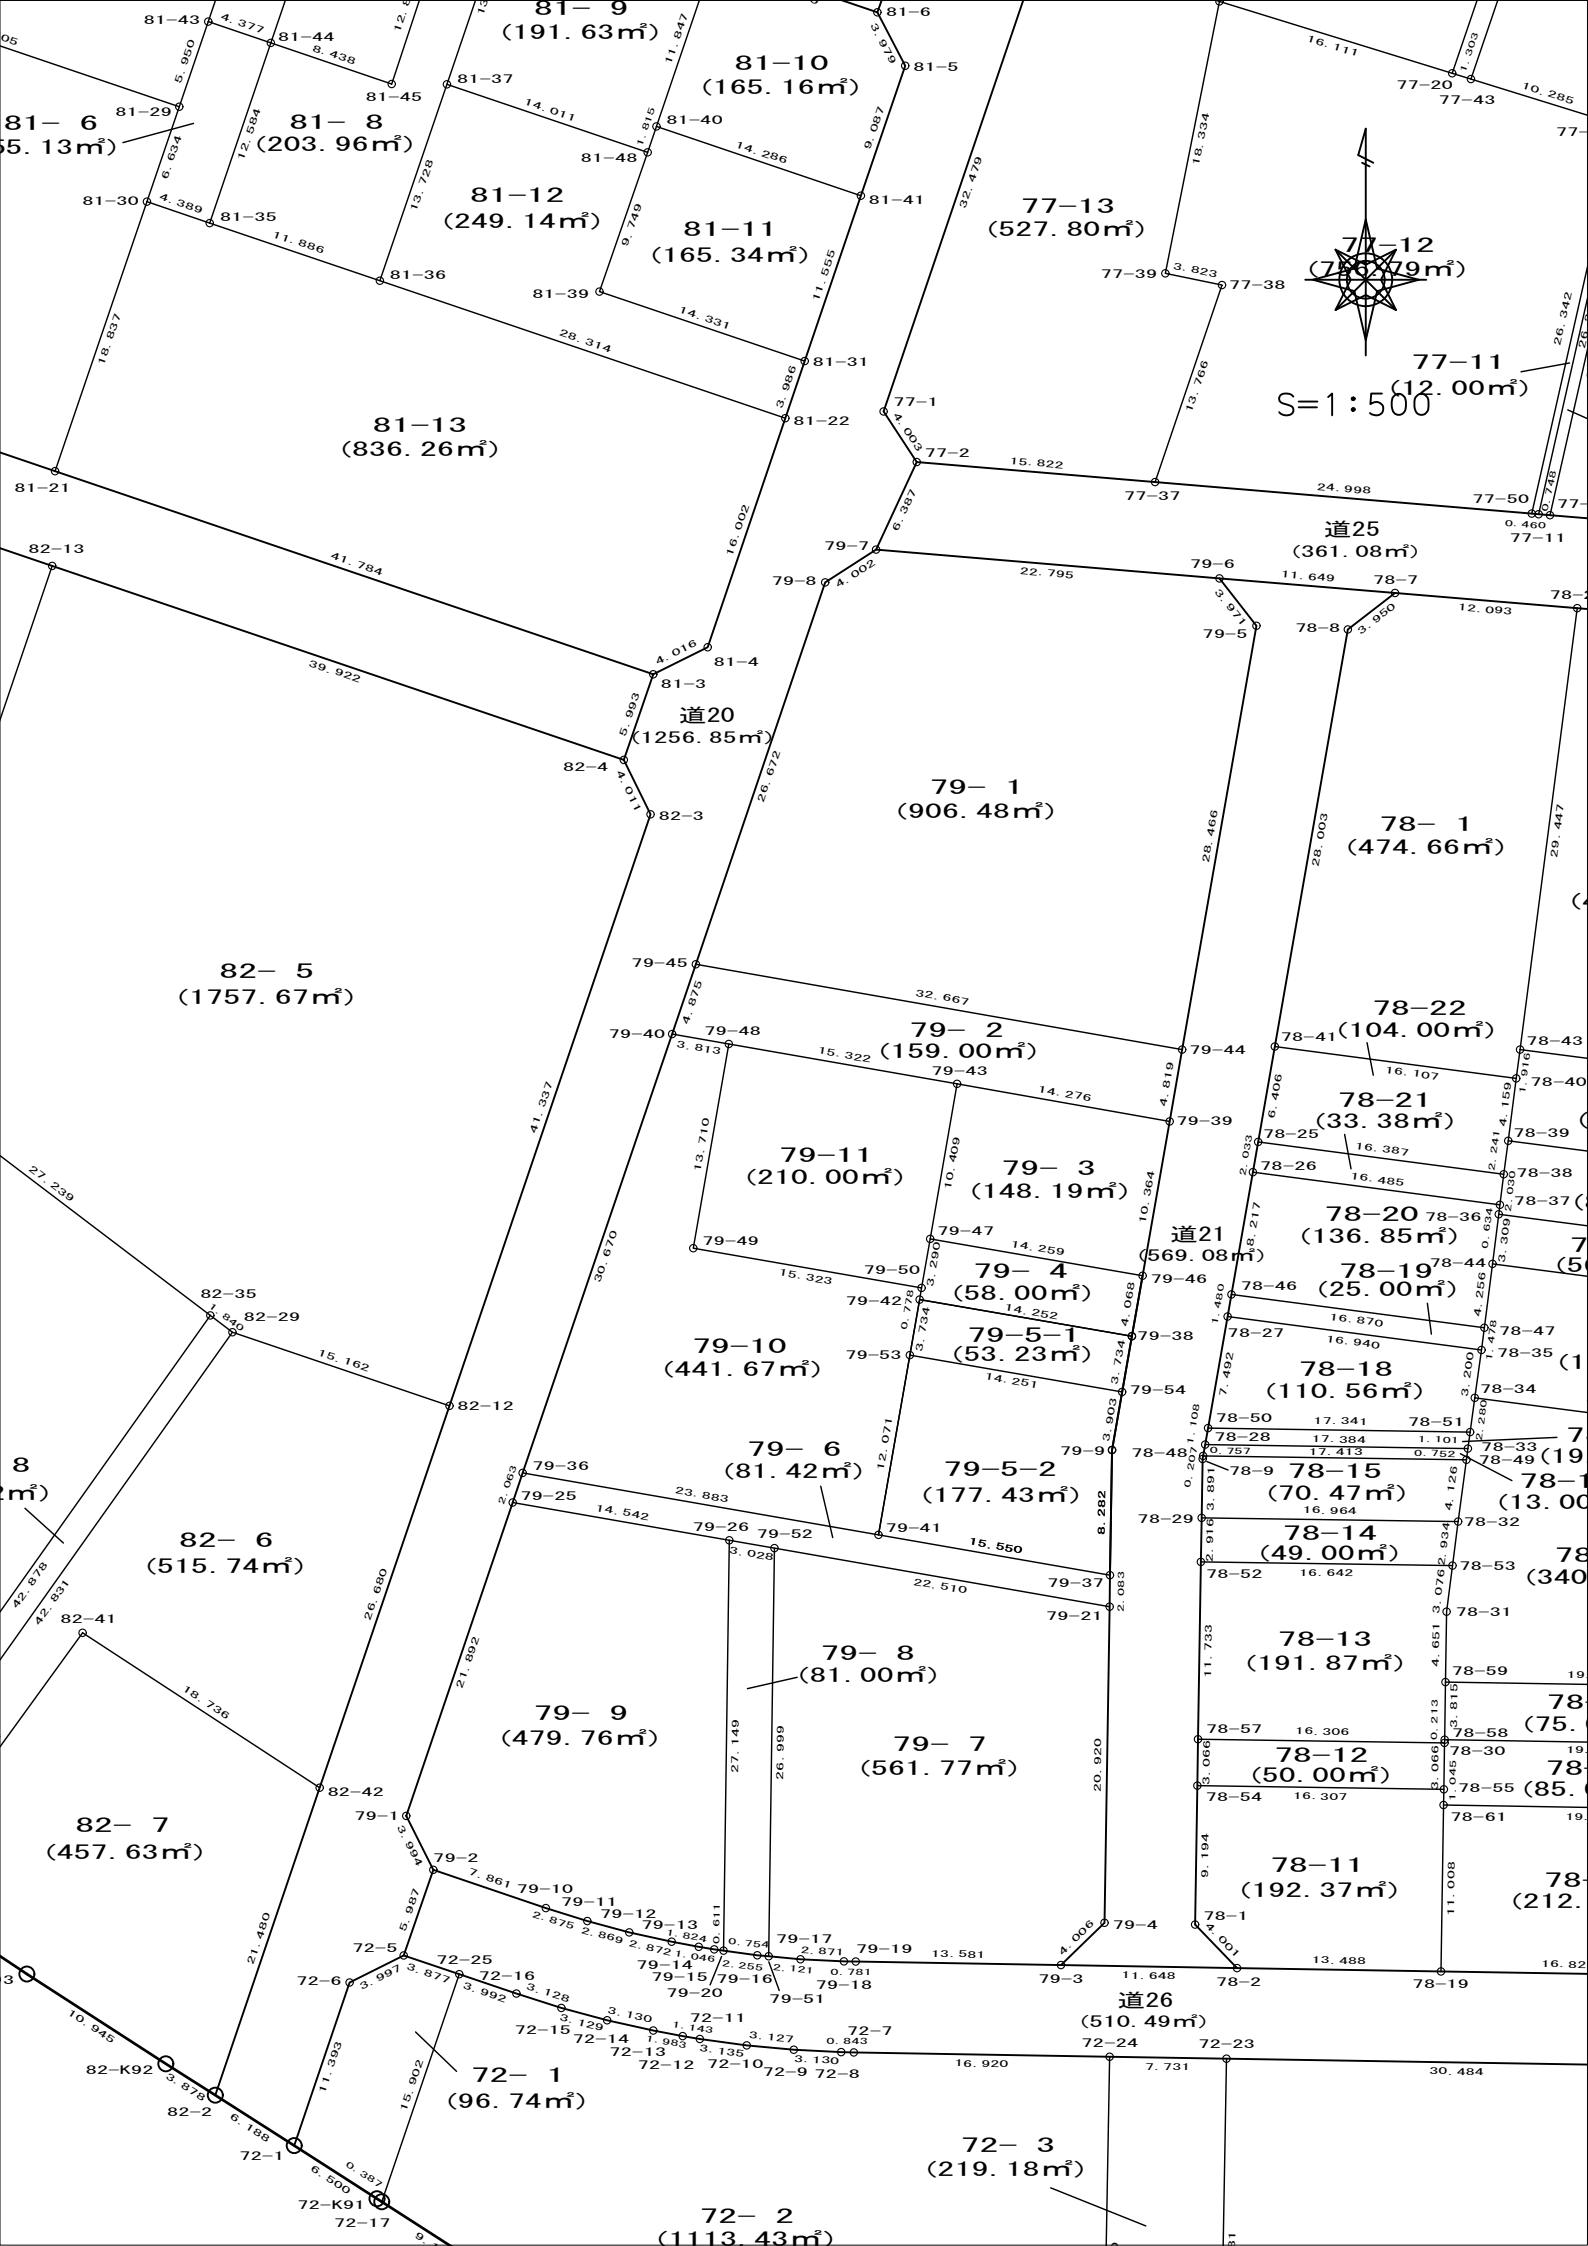

画地面積(座標法)計算簿

画地番号：79- 1

点名	Xn	Yn	距離	方向角	X _{n+1} -X _{n-1}	Y _{n+1} -Y _{n-1}	X _n *(Y _{n+1} -Y _{n-1})	Y _n *(X _{n+1} -X _{n-1})
79-7	47428.599	-71015.711	4.002	237° 08' 09"	-0.269	-26.078	-1236843.004722	19103.226259
79-8	47426.427	-71019.073	26.672	198° 43' 42"	-27.432	-11.926	-565607.568402	1948195.210536
79-45	47401.167	-71027.637	32.667	99° 57' 09"	-30.906	23.612	1119236.355204	2195180.149122
79-44	47395.521	-70995.461	28.466	9° 55' 26"	22.395	37.082	1757520.709722	-1589943.349095
79-5	47423.562	-70990.555	3.971	322° 05' 50"	31.175	2.466	116946.503892	-2213130.552125
79-6	47426.696	-70992.995	22.795	274° 47' 19"	5.037	-25.156	-1193065.964576	-357591.715815
							倍面積	-1812.968882
							面積	906.4844410
							地積	906.48

画地面積(座標法)計算簿

画地番号：79- 2

点名	Xn	Yn	距離	方向角	X _{n+1} -X _{n-1}	Y _{n+1} -Y _{n-1}	X _n *(Y _{n+1} -Y _{n-1})	Y _n *(X _{n+1} -X _{n-1})
79-45	47401.167	-71027.637	4.875	198° 43' 29"	1.029	-33.741	-1599362.775747	-73087.438473
79-40	47396.550	-71029.202	3.813	99° 55' 18"	-5.274	2.191	103845.841050	374608.011348
79-48	47395.893	-71025.446	15.322	99° 55' 02"	-3.296	18.850	893412.583050	234099.870016
79-43	47393.254	-71010.352	14.276	100° 00' 14"	-5.119	29.153	1381655.533862	363501.991888
79-39	47390.774	-70996.293	4.819	9° 56' 28"	2.267	14.891	705696.015634	-160948.596231
79-44	47395.521	-70995.461	32.667	279° 57' 09"	10.393	-31.344	-1485565.210224	-737855.826173
							倍面積	-318.012375
							面積	159.0061875
							地積	159.00

画地面積(座標法)計算簿

画地番号：79- 3

点名	Xn	Yn	距離	方向角	X _{n+1} -X _{n-1}	Y _{n+1} -Y _{n-1}	X _n *(Y _{n+1} -Y _{n-1})	Y _n *(X _{n+1} -X _{n-1})
79-39	47390.774	-70996.293	14.276	280° 00' 14"	12.688	-12.266	-581295.233884	-900800.965584
79-43	47393.254	-71010.352	10.409	189° 52' 07"	-7.775	-15.843	-750851.323122	552105.486800
79-47	47382.999	-71012.136	14.259	99° 49' 28"	-12.688	12.266	581199.865734	901001.981568
79-46	47380.566	-70998.086	10.364	9° 57' 44"	7.775	15.843	750650.307138	-552010.118650
倍面積								-296.384134
面積								148.1920670
地積								148.19

画地面積(座標法)計算簿

画地番号：79- 4

点名	Xn	Yn	距離	方向角	X _{n+1} -X _{n-1}	Y _{n+1} -Y _{n-1}	X _n *(Y _{n+1} -Y _{n-1})	Y _n *(X _{n+1} -X _{n-1})
79-38	47376.559	-70998.790	4.068	9° 57' 53"	1.576	14.748	698709.492132	-111894.093040
79-46	47380.566	-70998.086	14.259	279° 49' 28"	6.440	-13.346	-632341.033836	-457227.673840
79-47	47382.999	-71012.136	3.290	189° 52' 08"	-0.809	-14.614	-692455.147386	57448.818024
79-50	47379.757	-71012.700	0.778	189° 54' 36"	-4.009	-0.698	-33071.070386	284689.914300
79-42	47378.990	-71012.834	14.252	99° 49' 14"	-3.198	13.910	659041.750900	227099.043132
							倍面積	-116.008576
							面積	58.0042880
							地積	58.00

画地面積(座標法)計算簿

画地番号：79-5-1

点名	Xn	Yn	距離	方向角	X _{n+1} -X _{n-1}	Y _{n+1} -Y _{n-1}	X _n *(Y _{n+1} -Y _{n-1})	Y _n *(X _{n+1} -X _{n-1})
79-42	47378.990	-71012.834	3.734	189° 54' 50"	-1.248	-14.687	-695855.226130	88624.016832
79-53	47375.311	-71013.477	14.251	99° 49' 16"	-6.110	13.400	634829.167400	433892.344470
79-54	47372.880	-70999.434	3.734	9° 55' 44"	1.248	14.687	695765.488560	-88607.293632
79-38	47376.559	-70998.790	14.252	279° 49' 14"	6.110	-13.400	-634845.890600	-433802.606900
倍面積								-106.460770
面積								53.2303850
地積								53.23

画地面積(座標法)計算簿

画地番号：79-5-2

点名	Xn	Yn	距離	方向角	X _{n+1} -X _{n-1}	Y _{n+1} -Y _{n-1}	X _n *(Y _{n+1} -Y _{n-1})	Y _n *(X _{n+1} -X _{n-1})
79-53	47375.311	-71013.477	12.071	189° 55' 02"	-9.460	-16.122	-763784.763942	671787.492420
79-41	47363.420	-71015.556	15.550	99° 52' 18"	-14.557	13.241	627139.044220	1033773.448692
79-37	47360.754	-71000.236	8.282	0° 53' 33"	5.615	15.449	731676.288546	-398666.325140
79-9	47369.035	-71000.107	3.903	9° 55' 41"	12.126	0.802	37989.966070	-860947.297482
79-54	47372.880	-70999.434	14.251	279° 49' 16"	6.276	-13.370	-633375.405600	-445592.447784
							倍面積	-354.870706
							面積	177.4353530
							地積	177.43

画地面積(座標法)計算簿

画地番号：79- 6

点名	Xn	Yn	距離	方向角	X _{n+1} -X _{n-1}	Y _{n+1} -Y _{n-1}	X _n *(Y _{n+1} -Y _{n-1})	Y _n *(X _{n+1} -X _{n-1})
79-37	47360.754	-71000.236	15.550	279° 52' 18"	4.749	-15.294	-724335.371676	-337180.120764
79-41	47363.420	-71015.556	23.883	279° 52' 29"	6.762	-38.850	-1840068.867000	-480207.189672
79-36	47367.516	-71039.086	2.063	198° 40' 51"	2.141	-24.191	-1145867.579556	-152094.683126
79-25	47365.561	-71039.747	14.542	99° 53' 56"	-4.455	13.665	647250.391065	316482.072885
79-26	47363.061	-71025.421	3.028	99° 54' 26"	-3.021	17.309	819807.222849	214567.796841
79-52	47362.540	-71022.438	22.510	99° 53' 48"	-4.390	25.159	1191594.143860	311788.502820
79-21	47358.671	-71000.262	2.083	0° 42' 54"	-1.786	22.202	1051457.213542	126806.467932
							倍面積	-162.846916
							面積	81.4234580
							地積	81.42

画地面積(座標法)計算簿

画地番号：79- 7

点名	Xn	Yn	距離	方向角	X _{n+1} -X _{n-1}	Y _{n+1} -Y _{n-1}	X _n *(Y _{n+1} -Y _{n-1})	Y _n *(X _{n+1} -X _{n-1})
79-21	47358.671	-71000.262	22.510	279° 53' 48"	24.787	-21.833	-1033981.863943	-1759883.494194
79-52	47362.540	-71022.438	26.999	180° 48' 15"	-23.128	-22.555	-1068262.089700	1642606.946064
79-51	47335.543	-71022.817	2.121	95° 18' 07"	-27.193	1.733	82032.496019	1931323.462681
79-17	47335.347	-71020.705	2.871	92° 48' 52"	-0.337	4.980	235730.028060	23933.977585
79-18	47335.206	-71017.837	0.781	90° 48' 25"	-0.152	3.649	172726.166694	10794.711224
79-19	47335.195	-71017.056	13.581	90° 59' 29"	-0.246	14.360	679733.400200	17470.195776
79-3	47334.960	-71003.477	4.006	45° 47' 56"	2.558	16.451	778707.426960	-181626.894166
79-4	47337.753	-71000.605	20.920	0° 56' 22"	23.711	3.215	152190.875895	-1683495.345155
							倍面積	-1123.559815
							面積	561.7799075
							地積	561.77

画地面積(座標法)計算簿

画地番号：79- 8

点名	Xn	Yn	距離	方向角	X _{n+1} -X _{n-1}	Y _{n+1} -Y _{n-1}	X _n *(Y _{n+1} -Y _{n-1})	Y _n *(X _{n+1} -X _{n-1})
79-26	47363.061	-71025.421	27.149	180° 48' 22"	-26.626	-3.365	-159376.700265	1891122.859546
79-20	47335.914	-71025.803	2.255	97° 41' 43"	-27.449	1.853	87713.448642	1949587.266547
79-16	47335.612	-71023.568	0.754	95° 14' 58"	-0.371	2.986	141344.137432	26349.743728
79-51	47335.543	-71022.817	26.999	0° 48' 15"	26.928	1.130	53489.163590	-1912502.416176
79-52	47362.540	-71022.438	3.028	279° 54' 26"	27.518	-2.604	-123332.054160	-1954395.448884
							倍面積	-162.004761
							面積	81.0023805
							地積	81.00

画地面積(座標法)計算簿

画地番号：79- 9

点名	Xn	Yn	距離	方向角	X _{n+1} -X _{n-1}	Y _{n+1} -Y _{n-1}	X _n *(Y _{n+1} -Y _{n-1})	Y _n *(X _{n+1} -X _{n-1})
79-25	47365.561	-71039.747	21.892	198° 45' 10"	-18.230	-21.364	-1011917.845204	1295054.587810
79-1	47344.831	-71046.785	3.994	153° 25' 20"	-24.302	-5.251	-248607.707581	1726578.969070
79-2	47341.259	-71044.998	7.861	108° 45' 03"	-6.099	9.231	437007.161829	433303.442802
79-10	47338.732	-71037.554	2.875	107° 18' 02"	-3.382	10.189	482334.340348	240249.007628
79-11	47337.877	-71034.809	2.869	105° 09' 00"	-1.605	5.515	261068.391655	114010.868445
79-12	47337.127	-71032.039	2.872	102° 30' 26"	-1.372	5.574	263857.145898	97455.957508
79-13	47336.505	-71029.235	1.824	100° 32' 47"	-0.956	4.598	217653.249990	67903.948660
79-14	47336.171	-71027.441	1.046	99° 37' 27"	-0.509	2.826	133772.019246	36152.967469
79-15	47335.996	-71026.409	0.611	97° 42' 22"	-0.257	1.638	77536.361448	18253.787113
79-20	47335.914	-71025.803	27.149	0° 48' 22"	27.065	0.988	46767.883032	-1922313.358195
79-26	47363.061	-71025.421	14.542	279° 53' 56"	29.647	-13.944	-660430.522584	-2105690.656387
							倍面積	-959.521923
							面積	479.7609615
							地積	479.76

画地面積(座標法)計算簿

画地番号：79-10

点名	X _n	Y _n	距離	方向角	X _{n+1} -X _{n-1}	Y _{n+1} -Y _{n-1}	X _n *(Y _{n+1} -Y _{n-1})	Y _n *(X _{n+1} -X _{n-1})
79-36	47367.516	-71039.086	23.883	99° 52' 29"	-33.130	13.646	646377.123336	2353524.919180
79-41	47363.420	-71015.556	12.071	9° 55' 02"	7.795	25.609	1212929.822780	-553566.259020
79-53	47375.311	-71013.477	3.734	9° 54' 50"	15.570	2.722	128955.596542	-1105679.836890
79-42	47378.990	-71012.834	0.778	9° 54' 36"	4.446	0.777	36813.475230	-315723.059964
79-50	47379.757	-71012.700	15.323	279° 52' 32"	3.395	-14.962	-708895.924234	-241088.116500
79-49	47382.385	-71027.796	13.710	9° 52' 09"	16.136	-12.746	-603935.879210	-1146104.516256
79-48	47395.893	-71025.446	3.813	279° 55' 18"	14.165	-1.406	-66638.625558	-1006075.442590
79-40	47396.550	-71029.202	30.670	198° 48' 00"	-28.377	-13.640	-646488.942000	2015595.665154
							倍面積	-883.353114
							面積	441.6765570
							地積	441.67

画地面積(座標法)計算簿

画地番号：79-11

点名	Xn	Yn	距離	方向角	X _{n+1} -X _{n-1}	Y _{n+1} -Y _{n-1}	X _n *(Y _{n+1} -Y _{n-1})	Y _n *(X _{n+1} -X _{n-1})
79-47	47382.999	-71012.136	10.409	9° 52' 07"	13.497	2.348	111255.281652	-958450.799592
79-43	47393.254	-71010.352	15.322	279° 55' 02"	12.894	-13.310	-630804.210740	-915607.478688
79-48	47395.893	-71025.446	13.710	189° 52' 09"	-10.869	-17.444	-826773.957492	771975.572574
79-49	47382.385	-71027.796	15.323	99° 52' 32"	-16.136	12.746	603935.879210	1146104.516256
79-50	47379.757	-71012.700	3.290	9° 52' 08"	0.614	15.660	741966.994620	-43601.797800
							倍面積	-420.012750
							面積	210.0063750
							地積	210.00

画地面積(座標法)計算簿

画地番号：80- 1

点名	Xn	Yn	距離	方向角	X _{n+1} -X _{n-1}	Y _{n+1} -Y _{n-1}	X _n *(Y _{n+1} -Y _{n-1})	Y _n *(X _{n+1} -X _{n-1})
80-8	47542.332	-71098.994	23.902	198° 44' 50"	-24.373	-11.297	-537085.724604	1732895.780762
80-21	47519.698	-71106.676	14.591	108° 47' 38"	-27.335	6.132	291390.788136	1943700.988460
80-43	47514.997	-71092.862	3.879	108° 47' 40"	-5.951	17.487	830894.752539	423073.621762
80-22	47513.747	-71089.189	0.287	108° 41' 14"	-1.342	3.945	187441.731915	95401.691638
80-42	47513.655	-71088.917	0.654	108° 47' 41"	-0.303	0.892	42382.180260	21539.941851
80-23	47513.444	-71088.297	0.704	108° 47' 42"	-0.438	1.287	61149.802428	31136.674086
80-24	47513.217	-71087.630	2.310	18° 51' 59"	1.959	1.414	67183.688838	-139260.667170
80-25	47515.403	-71086.883	24.402	18° 47' 58"	25.287	8.611	409155.135233	-1797574.010421
80-20	47538.504	-71079.019	17.281	288° 47' 33"	28.668	-8.496	-403887.129984	-2037693.316692
80-7	47544.071	-71095.379	4.011	244° 18' 36"	3.828	-19.975	-949692.818225	-272153.110812
倍面積								-1067.593464
面積								533.7967320
地積								533.79