



# 81街区 画地出来形確認図 (4980.66m<sup>2</sup>)

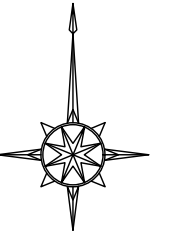


S=1:500

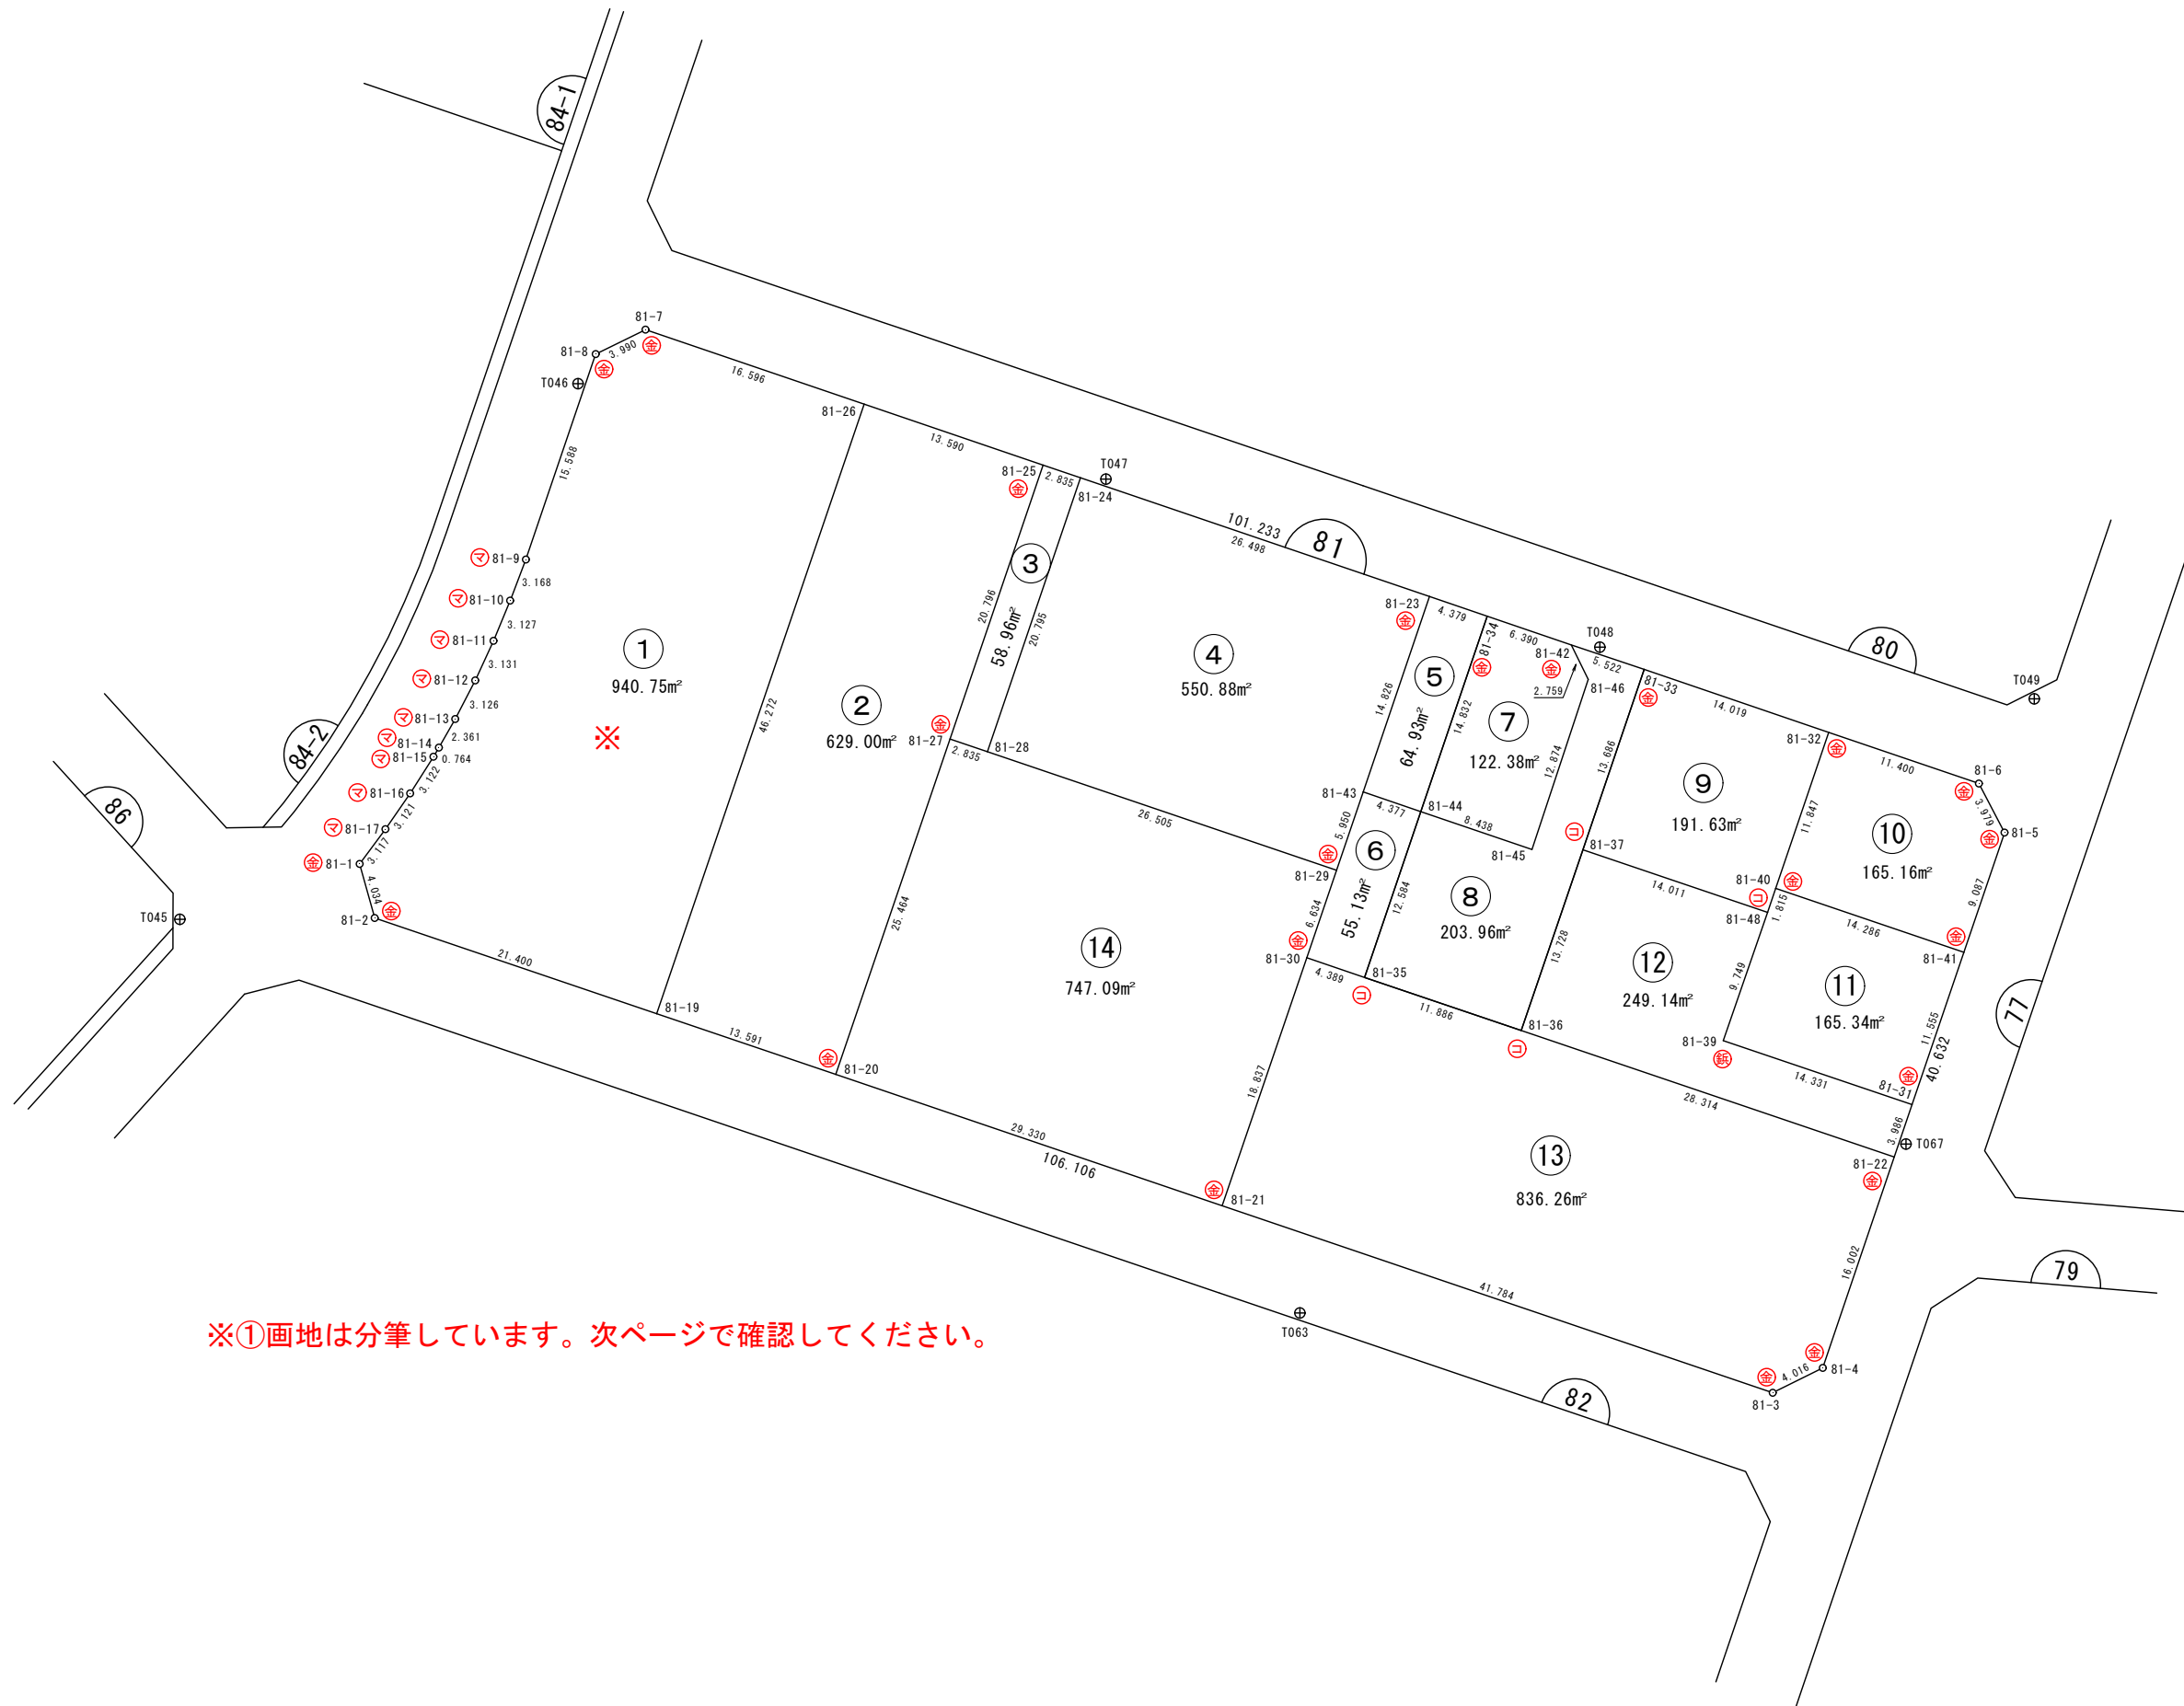

※①画地は分筆しています。次ページで確認してください。

凡 例	
事 項	記 号
金属プレート	Ⓜ
コンクリート杭	Ⓜ
金属釘	Ⓜ
合成樹脂杭	Ⓜ
マーキング	Ⓜ

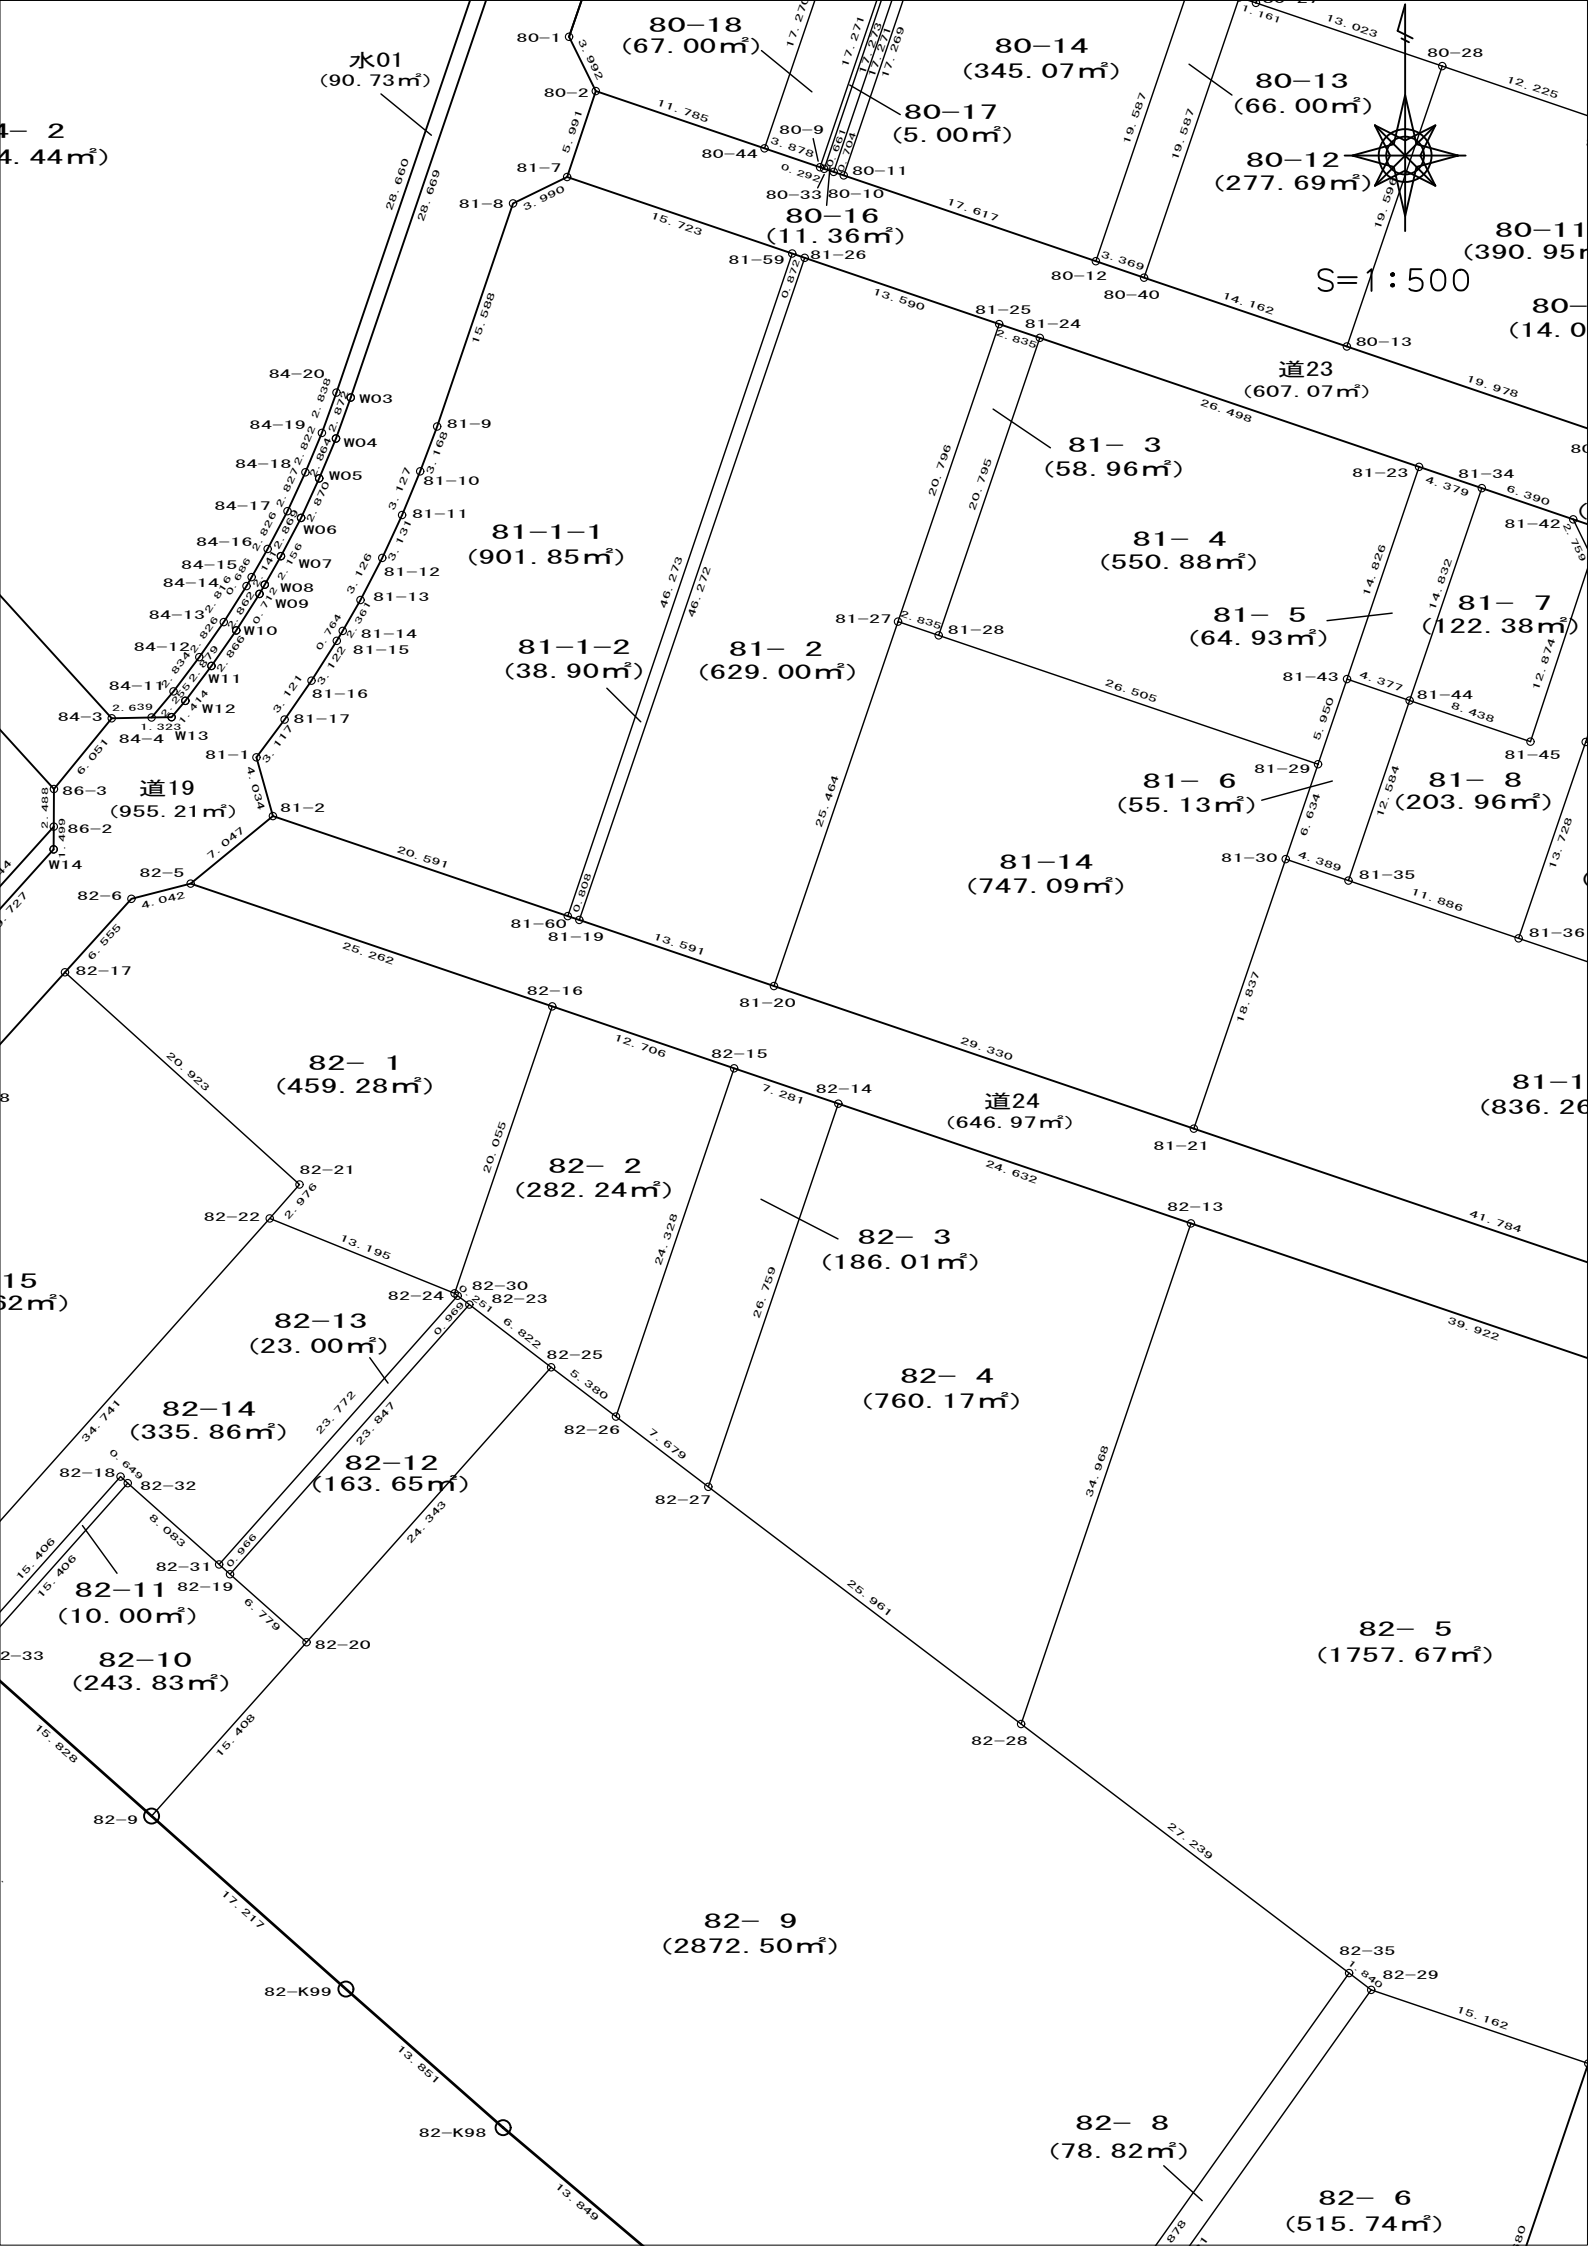

## 画地面積(座標法)計算簿

画地番号 : 81- 1-1

点名	Xn	Yn	距離	方向角	X <sub>n+1</sub> -X <sub>n-1</sub>	Y <sub>n+1</sub> -Y <sub>n-1</sub>	X <sub>n</sub> *(Y <sub>n+1</sub> -Y <sub>n-1</sub> )	Y <sub>n</sub> *(X <sub>n+1</sub> -X <sub>n-1</sub> )
81-2	47454.476	-71130.925	20.591	108° 44' 41"	-10.502	20.588	976992.751888	747016.974350
81-60	47447.859	-71111.426	46.273	18° 42' 48"	37.210	34.345	1629596.717355	-2646056.161460
81-59	47491.686	-71096.580	15.723	288° 48' 38"	48.897	-0.038	-1804.684068	-3476409.472260
81-7	47496.756	-71111.464	3.990	243° 53' 27"	3.314	-18.467	-877122.593052	-235663.391696
81-8	47495.000	-71115.047	15.588	198° 46' 15"	-16.515	-8.599	-408409.505000	1174465.001205
81-9	47480.241	-71120.063	3.168	200° 50' 15"	-17.720	-6.143	-291671.120463	1260247.516360
81-10	47477.280	-71121.190	3.127	202° 28' 54"	-5.851	-2.323	-110289.721440	416130.082690
81-11	47474.390	-71122.386	3.131	204° 49' 48"	-5.732	-2.511	-119208.193290	407673.516552
81-12	47471.548	-71123.701	3.126	207° 21' 36"	-5.619	-2.752	-130641.700096	399644.075919
81-13	47468.771	-71125.138	2.361	209° 48' 40"	-4.826	-2.611	-123940.961081	343249.915988
81-14	47466.722	-71126.312	0.764	210° 41' 37"	-2.706	-1.564	-74237.953208	192467.800272
81-15	47466.065	-71126.702	3.122	212° 29' 02"	-3.291	-2.067	-98112.356355	234077.976282
81-16	47463.431	-71128.379	3.121	214° 37' 36"	-5.203	-3.451	-163796.300381	370080.955937
81-17	47460.862	-71130.153	3.117	216° 39' 11"	-5.070	-3.635	-172520.233370	360629.875710
81-1	47458.361	-71132.014	4.034	164° 20' 29"	-6.386	-0.772	-36637.854692	454249.041404
							倍面積	-1803.707253
							面積	901.8536265
							地積	901.85

## 画地面積(座標法)計算簿

画地番号：81- 1-2

点名	Xn	Yn	距離	方向角	X <sub>n+1</sub> -X <sub>n-1</sub>	Y <sub>n+1</sub> -Y <sub>n-1</sub>	X <sub>n</sub> *(Y <sub>n+1</sub> -Y <sub>n-1</sub> )	Y <sub>n</sub> *(X <sub>n+1</sub> -X <sub>n-1</sub> )
81-60	47447.859	-71111.426	0.808	108° 44' 55"	-44.087	-14.080	-668065.854720	3135089.438062
81-19	47447.599	-71110.660	46.272	18° 47' 31"	43.546	15.672	743598.771528	-3096584.800360
81-26	47491.405	-71095.754	0.872	288° 47' 17"	44.087	14.080	668678.982400	-3134398.506598
81-59	47491.686	-71096.580	46.273	198° 42' 48"	-43.546	-15.672	-744289.702992	3095971.672680
							倍面積	-77.803784
							面積	38.9018920
							地積	38.90

## 画地面積(座標法)計算簿

画地番号：81- 2

点名	Xn	Yn	距離	方向角	X <sub>n+1</sub> -X <sub>n-1</sub>	Y <sub>n+1</sub> -Y <sub>n-1</sub>	X <sub>n</sub> *(Y <sub>n+1</sub> -Y <sub>n-1</sub> )	Y <sub>n</sub> *(X <sub>n+1</sub> -X <sub>n-1</sub> )
81-27	47467.335	-71089.579	20.796	18° 46' 04"	43.795	14.902	707358.226170	-3113368.112305
81-25	47487.026	-71082.888	13.590	288° 47' 46"	24.070	-6.175	-293232.385550	-1710965.114160
81-26	47491.405	-71095.754	46.272	198° 47' 31"	-39.427	-27.772	-1318931.299660	2803092.292958
81-19	47447.599	-71110.660	13.591	108° 44' 49"	-48.174	-2.036	-96603.311564	3425684.934840
81-20	47443.231	-71097.790	25.464	18° 48' 41"	19.736	21.081	1000150.752711	-1403185.983440
							倍面積	-1258.017893
							面積	629.0089465
							地積	629.00

## 画地面積(座標法)計算簿

画地番号：81- 3

点名	Xn	Yn	距離	方向角	X <sub>n+1</sub> -X <sub>n-1</sub>	Y <sub>n+1</sub> -Y <sub>n-1</sub>	X <sub>n</sub> *(Y <sub>n+1</sub> -Y <sub>n-1</sub> )	Y <sub>n</sub> *(X <sub>n+1</sub> -X <sub>n-1</sub> )
81-25	47487.026	-71082.888	20.796	198° 46' 04"	-18.778	-9.375	-445190.868750	1334794.470864
81-27	47467.335	-71089.579	2.835	108° 45' 39"	-20.603	-4.006	-190154.144010	1464658.596137
81-28	47466.423	-71086.894	20.795	18° 45' 58"	18.778	9.375	444997.715625	-1334869.695532
81-24	47486.113	-71080.204	2.835	288° 47' 11"	20.603	4.006	190229.368678	-1464465.443012
<b>倍面積</b>								-117.928457
<b>面積</b>								58.9642285
<b>地積</b>								58.96

## 画地面積(座標法)計算簿

画地番号：81- 4

点名	Xn	Yn	距離	方向角	X <sub>n+1</sub> -X <sub>n-1</sub>	Y <sub>n+1</sub> -Y <sub>n-1</sub>	X <sub>n</sub> *(Y <sub>n+1</sub> -Y <sub>n-1</sub> )	Y <sub>n</sub> *(X <sub>n+1</sub> -X <sub>n-1</sub> )
81-24	47486.113	-71080.204	20.795	198° 45' 58"	-11.153	-31.776	-1508918.726688	792757.515212
81-28	47466.423	-71086.894	26.505	108° 45' 18"	-28.212	18.408	873761.914584	2005503.453528
81-29	47457.901	-71061.796	5.950	18° 45' 06"	-2.887	27.011	1281885.363911	205155.405052
81-43	47463.536	-71059.883	14.826	18° 44' 48"	19.675	6.678	316961.493408	-1398103.198025
81-23	47477.576	-71055.118	26.498	288° 47' 38"	22.577	-20.321	-964791.821896	-1604211.399086
							倍面積	-1101.776681
							面積	550.8883405
							地積	550.88

## 画地面積(座標法)計算簿

画地番号：81- 5

点名	Xn	Yn	距離	方向角	X <sub>n+1</sub> -X <sub>n-1</sub>	Y <sub>n+1</sub> -Y <sub>n-1</sub>	X <sub>n</sub> *(Y <sub>n+1</sub> -Y <sub>n-1</sub> )	Y <sub>n</sub> *(X <sub>n+1</sub> -X <sub>n-1</sub> )
81-23	47477.576	-71055.118	14.826	198° 44' 48"	-12.630	-8.911	-423072.679736	897426.140340
81-43	47463.536	-71059.883	4.377	108° 51' 26"	-15.455	-0.622	-29522.319392	1098230.491765
81-44	47462.121	-71055.740	14.832	18° 45' 05"	12.630	8.911	422934.960231	-897433.996200
81-34	47476.166	-71050.972	4.379	288° 46' 57"	15.455	0.622	29530.175252	-1098092.772260
<b>倍面積</b>								-129.863645
<b>面積</b>								64.9318225
<b>地積</b>								64.93



## 画地面積(座標法)計算簿

画地番号：81- 6

点名	Xn	Yn	距離	方向角	X <sub>n+1</sub> -X <sub>n-1</sub>	Y <sub>n+1</sub> -Y <sub>n-1</sub>	X <sub>n</sub> *(Y <sub>n+1</sub> -Y <sub>n-1</sub> )	Y <sub>n</sub> *(X <sub>n+1</sub> -X <sub>n-1</sub> )
81-30	47451.623	-71063.940	4.389	108° 50' 52"	-7.696	2.010	95377.762230	546908.082240
81-35	47450.205	-71059.786	12.584	18° 45' 16"	10.498	8.200	389091.681000	-745985.633428
81-44	47462.121	-71055.740	4.377	288° 51' 26"	13.331	-0.097	-4603.825737	-947244.069940
81-43	47463.536	-71059.883	5.950	198° 45' 06"	-4.220	-6.056	-287439.174016	299872.706260
81-29	47457.901	-71061.796	6.634	198° 51' 20"	-11.913	-4.057	-192536.704357	846559.175748
							倍面積	-110.260880
							面積	55.1304400
							地積	55.13

## 画地面積(座標法)計算簿

画地番号：81- 7

点名	Xn	Yn	距離	方向角	X <sub>n+1</sub> -X <sub>n-1</sub>	Y <sub>n+1</sub> -Y <sub>n-1</sub>	X <sub>n</sub> *(Y <sub>n+1</sub> -Y <sub>n-1</sub> )	Y <sub>n</sub> *(X <sub>n+1</sub> -X <sub>n-1</sub> )
81-34	47476.166	-71050.972	14.832	198° 45' 05"	-11.982	-10.816	-513502.211456	851332.746504
81-44	47462.121	-71055.740	8.438	108° 48' 38"	-16.766	3.220	152828.029620	1191320.536840
81-45	47459.400	-71047.752	12.874	18° 17' 34"	9.503	12.029	570889.122600	-675166.787256
81-46	47471.624	-71043.711	2.759	333° 55' 37"	14.703	2.828	134249.752672	-1044555.682833
81-42	47474.103	-71044.924	6.390	288° 50' 05"	4.542	-7.261	-344709.461883	-322686.044808
							倍面積	-244.768447
							面積	122.3842235
							地積	122.38

## 画地面積(座標法)計算簿

画地番号：81- 8

点名	Xn	Yn	距離	方向角	X <sub>n+1</sub> -X <sub>n-1</sub>	Y <sub>n+1</sub> -Y <sub>n-1</sub>	X <sub>n</sub> *(Y <sub>n+1</sub> -Y <sub>n-1</sub> )	Y <sub>n</sub> *(X <sub>n+1</sub> -X <sub>n-1</sub> )
81-35	47450.205	-71059.786	11.886	108° 44' 07"	-15.734	7.211	342163.428255	1118054.672924
81-36	47446.387	-71048.529	13.728	18° 51' 41"	9.173	15.695	744671.043965	-651728.156517
81-37	47459.378	-71044.091	13.686	18° 45' 10"	25.951	8.838	419445.982764	-1843665.205541
81-33	47472.338	-71039.691	5.522	288° 38' 18"	14.725	-0.833	-39544.457554	-1046059.449975
81-42	47474.103	-71044.924	2.759	153° 55' 37"	-0.714	-4.020	-190845.894060	50726.075736
81-46	47471.624	-71043.711	12.874	198° 17' 34"	-14.703	-2.828	-134249.752672	1044555.682833
81-45	47459.400	-71047.752	8.438	288° 48' 38"	-9.503	-12.029	-570889.122600	675166.787256
81-44	47462.121	-71055.740	12.584	198° 45' 16"	-9.195	-12.034	-571159.164114	653357.529300
							倍面積	-407.936016
							面積	203.9680080
							地積	203.96

## 画地面積(座標法)計算簿

画地番号：81- 9

点名	Xn	Yn	距離	方向角	X <sub>n+1</sub> -X <sub>n-1</sub>	Y <sub>n+1</sub> -Y <sub>n-1</sub>	X <sub>n</sub> *(Y <sub>n+1</sub> -Y <sub>n-1</sub> )	Y <sub>n</sub> *(X <sub>n+1</sub> -X <sub>n-1</sub> )
81-33	47472.338	-71039.691	13.686	198° 45' 10"	-8.436	-17.670	-838836.212460	599290.833276
81-37	47459.378	-71044.091	14.011	108° 43' 43"	-17.459	8.870	420964.682860	1240358.784769
81-48	47454.879	-71030.821	1.815	18° 38' 05"	-2.779	13.850	657250.074150	197394.651559
81-40	47456.599	-71030.241	11.847	18° 48' 35"	12.935	4.400	208809.035600	-918776.167335
81-32	47467.814	-71026.421	14.019	288° 49' 31"	15.739	-9.450	-448570.842300	-1117884.840119
							倍面積	-383.262150
							面積	191.6310750
							地積	191.63

## 画地面積(座標法)計算簿

画地番号：81-10

点名	Xn	Yn	距離	方向角	X <sub>n+1</sub> -X <sub>n-1</sub>	Y <sub>n+1</sub> -Y <sub>n-1</sub>	X <sub>n</sub> *(Y <sub>n+1</sub> -Y <sub>n-1</sub> )	Y <sub>n</sub> *(X <sub>n+1</sub> -X <sub>n-1</sub> )
81-32	47467.814	-71026.421	11.847	198° 48' 35"	-7.541	-14.612	-693599.698168	535610.240761
81-40	47456.599	-71030.241	14.286	108° 44' 26"	-15.805	9.709	460756.119691	1122632.959005
81-41	47452.009	-71016.712	9.087	18° 46' 33"	4.014	16.454	780775.356086	-285061.081968
81-5	47460.613	-71013.787	3.979	332° 25' 26"	12.131	1.083	51399.843879	-861468.250097
81-6	47464.140	-71015.629	11.400	288° 48' 02"	7.201	-12.634	-599661.944760	-511383.544429
							倍面積	-330.323272
							面積	165.1616360
							地積	165.16

## 画地面積(座標法)計算簿

画地番号：81-11

点名	Xn	Yn	距離	方向角	X <sub>n+1</sub> -X <sub>n-1</sub>	Y <sub>n+1</sub> -Y <sub>n-1</sub>	X <sub>n</sub> *(Y <sub>n+1</sub> -Y <sub>n-1</sub> )	Y <sub>n</sub> *(X <sub>n+1</sub> -X <sub>n-1</sub> )
81-41	47452.009	-71016.712	14.286	288° 44' 26"	15.530	-9.809	-465456.756281	-1102889.537360
81-40	47456.599	-71030.241	1.815	198° 38' 05"	2.870	-14.109	-669565.155291	-203856.791670
81-48	47454.879	-71030.821	9.749	199° 04' 27"	-10.934	-3.766	-178715.074314	776650.996814
81-39	47445.665	-71034.007	14.331	108° 42' 15"	-13.810	10.389	492913.013685	980979.636670
81-31	47441.069	-71020.432	11.555	18° 46' 48"	6.344	17.295	820493.288355	-450553.620608
							倍面積	-330.683846
							面積	165.3419230
							地積	165.34

## 画地面積(座標法)計算簿

画地番号：81-12

点名	Xn	Yn	距離	方向角	X <sub>n+1</sub> -X <sub>n-1</sub>	Y <sub>n+1</sub> -Y <sub>n-1</sub>	X <sub>n</sub> *(Y <sub>n+1</sub> -Y <sub>n-1</sub> )	Y <sub>n</sub> *(X <sub>n+1</sub> -X <sub>n-1</sub> )
81-31	47441.069	-71020.432	14.331	288° 42' 15"	8.371	-12.293	-583193.061217	-594512.036272
81-39	47445.665	-71034.007	9.749	19° 04' 27"	13.810	-10.389	-492913.013685	-980979.636670
81-48	47454.879	-71030.821	14.011	288° 43' 43"	13.713	-10.084	-478534.999836	-974045.648373
81-37	47459.378	-71044.091	13.728	198° 51' 41"	-8.492	-17.708	-840410.665624	603306.420772
81-36	47446.387	-71048.529	28.314	108° 43' 55"	-22.084	22.377	1061707.801899	1569035.714436
81-22	47437.294	-71021.714	3.986	18° 45' 27"	-5.318	28.097	1332845.649518	377693.475052
							倍面積	-498.288945
							面積	249.1444725
							地積	249.14

## 画地面積(座標法)計算簿

画地番号：81-13

点名	X <sub>n</sub>	Y <sub>n</sub>	距離	方向角	X <sub>n+1</sub> -X <sub>n-1</sub>	Y <sub>n+1</sub> -Y <sub>n-1</sub>	X <sub>n</sub> *(Y <sub>n+1</sub> -Y <sub>n-1</sub> )	Y <sub>n</sub> *(X <sub>n+1</sub> -X <sub>n-1</sub> )
81-22	47437.294	-71021.714	28.314	288° 43' 55"	24.248	-21.676	-1028250.784744	-1722134.521072
81-36	47446.387	-71048.529	11.886	288° 44' 07"	12.911	-38.072	-1806378.845864	-917307.557919
81-35	47450.205	-71059.786	4.389	288° 50' 52"	5.236	-15.411	-731255.109255	-372069.039496
81-30	47451.623	-71063.940	18.837	198° 49' 35"	-16.412	-10.233	-485572.458159	1166301.383280
81-21	47433.793	-71070.019	41.784	108° 45' 19"	-31.265	33.487	1588415.426191	2222004.144035
81-3	47420.358	-71030.453	4.016	63° 40' 39"	-11.654	43.166	2046947.173428	827788.899262
81-4	47422.139	-71026.853	16.002	18° 43' 54"	16.936	8.739	414422.072721	-1202910.782408
							倍面積	-1672.525682
							面積	836.2628410
							地積	836.26



## 画地面積(座標法)計算簿

画地番号：81-14

点名	Xn	Yn	距離	方向角	X <sub>n+1</sub> -X <sub>n-1</sub>	Y <sub>n+1</sub> -Y <sub>n-1</sub>	X <sub>n</sub> *(Y <sub>n+1</sub> -Y <sub>n-1</sub> )	Y <sub>n</sub> *(X <sub>n+1</sub> -X <sub>n-1</sub> )
81-21	47433.793	-71070.019	18.837	18° 49' 35"	8.392	33.850	1605633.893050	-596419.599448
81-30	47451.623	-71063.940	6.634	18° 51' 20"	24.108	8.223	390194.695929	-1713209.465520
81-29	47457.901	-71061.796	26.505	288° 45' 18"	14.800	-22.954	-1089348.659554	-1051714.580800
81-28	47466.423	-71086.894	2.835	288° 45' 39"	9.434	-27.783	-1318759.630209	-670633.757996
81-27	47467.335	-71089.579	25.464	198° 48' 41"	-23.192	-10.896	-517204.082160	1648709.516168
81-20	47443.231	-71097.790	29.330	108° 46' 13"	-33.542	19.560	927989.598360	2384762.072180
							倍面積	-1494.184584
							面積	747.0922920
							地積	747.09