



85街区 画地出来形確認図 (2259.05m²)

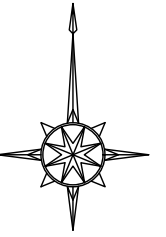

S=1:500

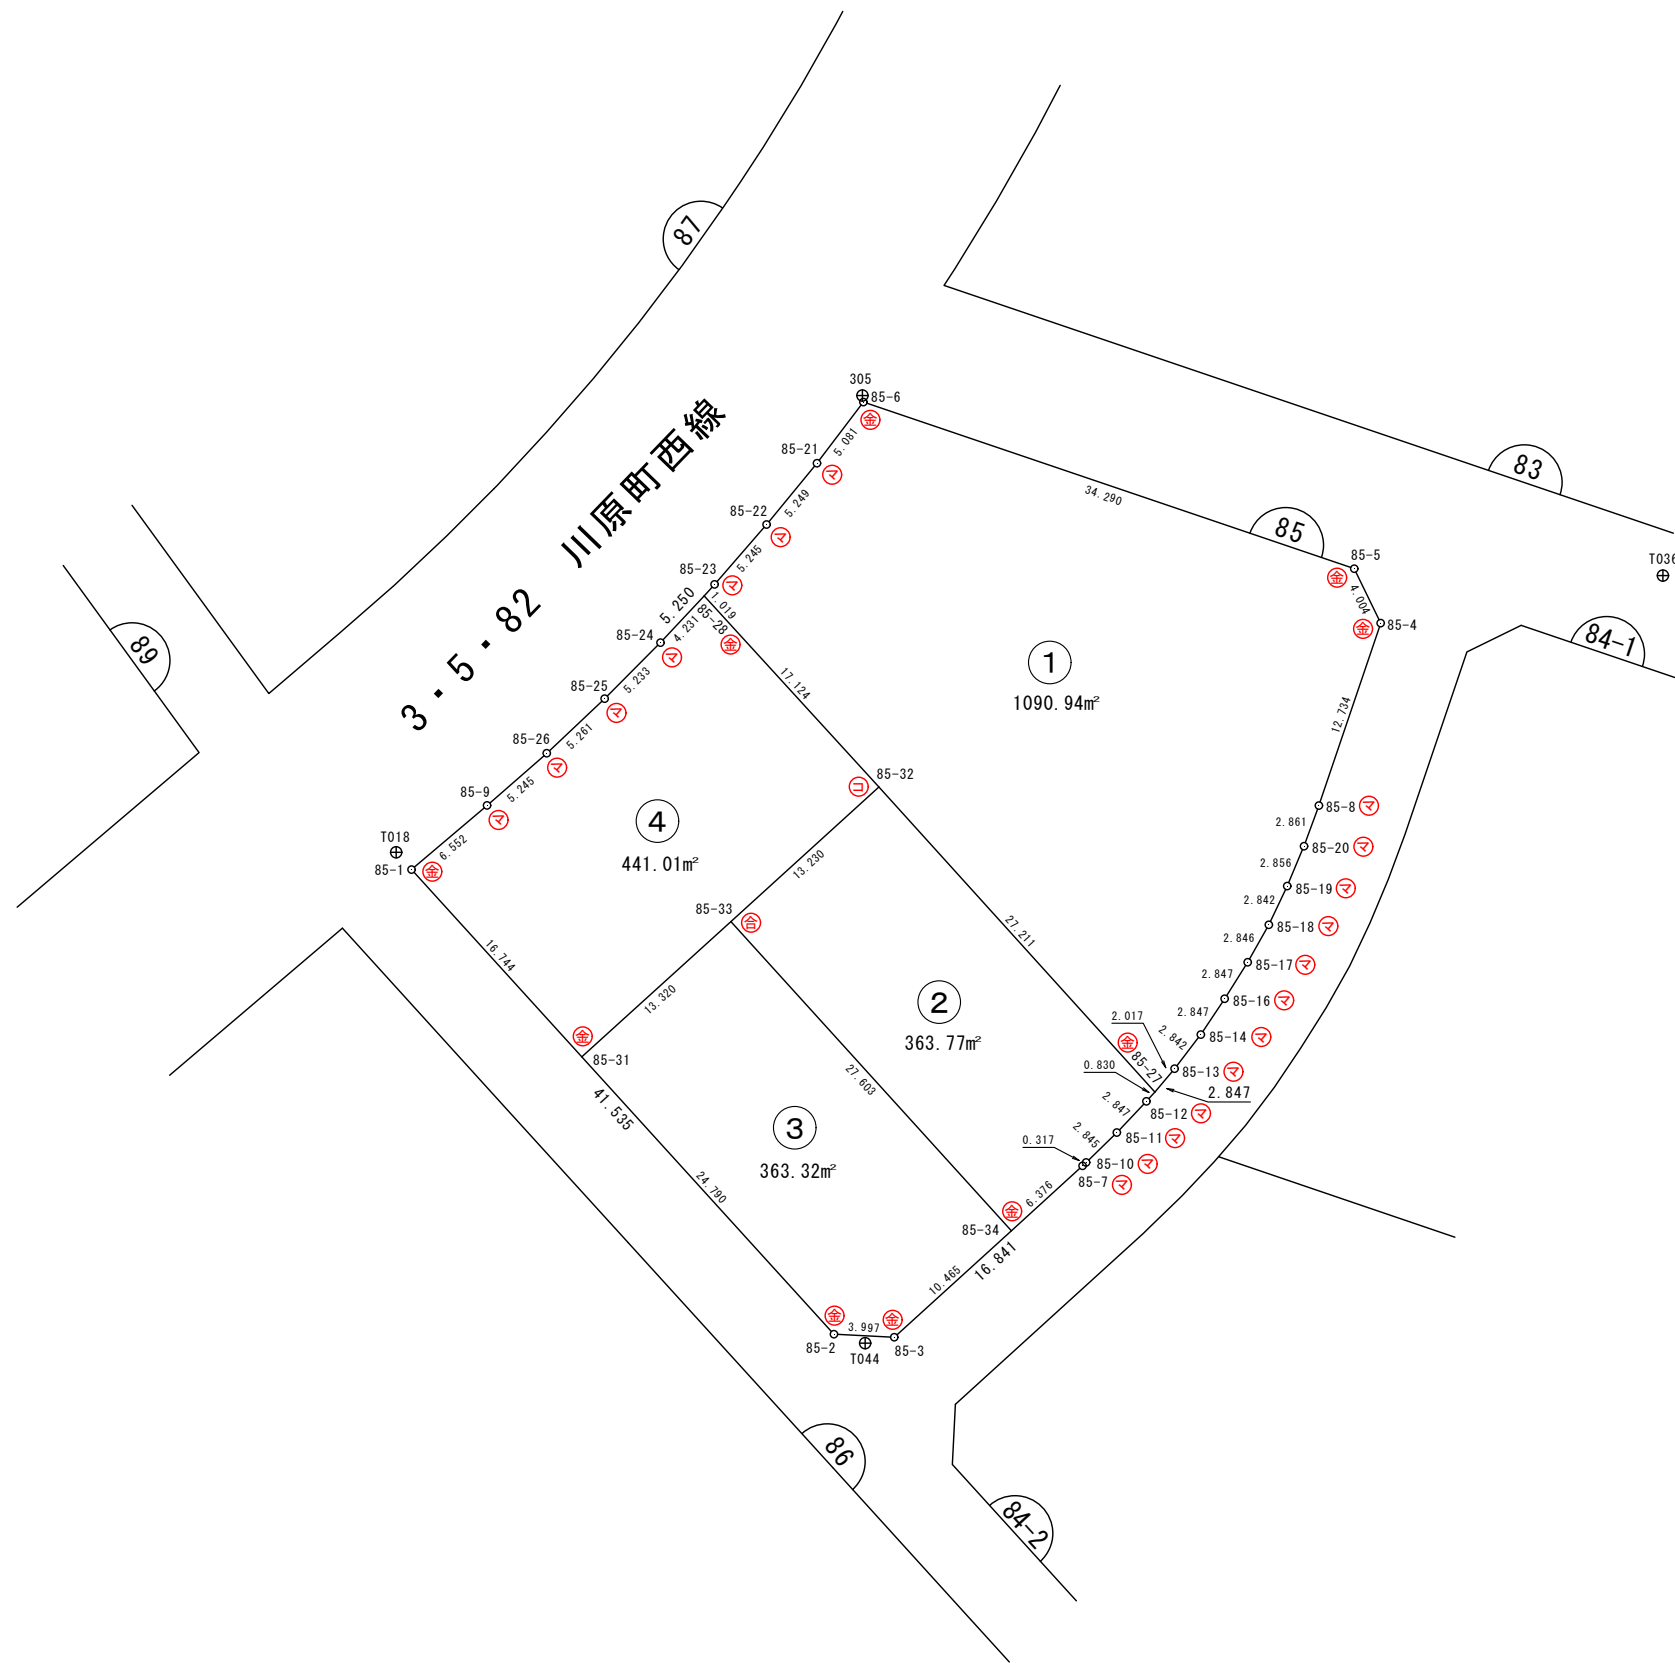

凡 例	
事 項	記 号
金属プレート	Ⓜ
コンクリート杭	Ⓜ
金属板	Ⓜ
合成樹脂杭	Ⓜ
マーキング	Ⓜ

画地面積(座標法)計算簿

画地番号：85- 1

点名	Xn	Yn	距離	方向角	X _{n+1} -X _{n-1}	Y _{n+1} -Y _{n-1}	X _n *(Y _{n+1} -Y _{n-1})	Y _n *(X _{n+1} -X _{n-1})
85-6	47575.422	-71187.663	5.081	217° 12' 37"	6.973	-35.545	-1691068.374990	-496391.574099
85-21	47571.375	-71190.736	5.249	219° 22' 20"	-8.105	-6.403	-304599.514125	577000.915280
85-22	47567.317	-71194.066	5.245	221° 00' 40"	-8.016	-6.772	-322125.870724	570691.633056
85-23	47563.359	-71197.508	1.019	222° 17' 47"	-4.712	-4.128	-196341.545952	335482.657696
85-28	47562.605	-71198.194	17.124	137° 33' 13"	-13.390	10.871	517053.078955	953343.817660
85-32	47549.969	-71186.637	27.211	137° 50' 41"	-32.809	29.820	1417940.075580	2335562.373333
85-27	47529.796	-71168.374	2.017	40° 09' 17"	-18.631	19.564	929872.928944	1325937.975994
85-13	47531.338	-71167.073	2.842	37° 26' 18"	3.799	3.029	143972.422802	-270363.710327
85-14	47533.595	-71165.345	2.847	33° 49' 06"	4.623	3.313	157478.800235	-328997.389935
85-16	47535.961	-71163.760	2.847	32° 08' 38"	4.777	3.100	147361.479100	-339949.281520
85-17	47538.372	-71162.245	2.846	29° 26' 16"	4.890	2.914	138526.816008	-347983.378050
85-18	47540.851	-71160.846	2.842	25° 26' 18"	5.046	2.620	124557.029620	-359077.628916
85-19	47543.418	-71159.625	2.856	22° 46' 38"	5.201	2.327	110633.533686	-370101.209625
85-20	47546.052	-71158.519	2.861	20° 11' 43"	5.320	2.094	99561.432888	-378563.321080
85-8	47548.738	-71157.531	12.734	18° 43' 26"	14.747	5.076	241357.394088	-1049360.109657
85-4	47560.799	-71153.443	4.004	334° 07' 11"	15.664	2.340	111292.269660	-1114547.531152
85-5	47564.402	-71155.191	34.290	288° 44' 44"	14.623	-34.220	-1627653.836440	-1040502.357993
							倍面積	-2181.880665
							面積	1090.9403325
							地積	1090.94

画地面積(座標法)計算簿

画地番号：85- 2

点名	Xn	Yn	距離	方向角	X _{n+1} -X _{n-1}	Y _{n+1} -Y _{n-1}	X _n *(Y _{n+1} -Y _{n-1})	Y _n *(X _{n+1} -X _{n-1})
85-27	47529.796	-71168.374	27.211	317° 50' 41"	20.786	-17.703	-841419.978588	-1479305.821964
85-32	47549.969	-71186.637	13.230	227° 42' 07"	11.269	-28.049	-1333729.080481	-802202.212353
85-33	47541.065	-71196.423	27.603	137° 47' 18"	-29.349	8.760	416459.729400	2089543.818627
85-34	47520.620	-71177.877	6.376	47° 39' 24"	-16.150	23.259	1105282.100580	1149522.713550
85-7	47524.915	-71173.164	0.317	47° 25' 23"	4.510	4.947	235105.754505	-320990.969640
85-10	47525.130	-71172.930	2.845	45° 44' 25"	2.201	2.272	107977.095360	-156651.618930
85-11	47527.116	-71170.892	2.847	43° 26' 56"	4.053	3.996	189918.355536	-288455.625276
85-12	47529.183	-71168.934	0.830	42° 24' 47"	2.680	2.518	119678.482794	-190732.743120
							倍面積	-727.540894
							面積	363.7704470
							地積	363.77

画地面積(座標法)計算簿

画地番号：85- 3

点名	Xn	Yn	距離	方向角	X _{n+1} -X _{n-1}	Y _{n+1} -Y _{n-1}	X _n *(Y _{n+1} -Y _{n-1})	Y _n *(X _{n+1} -X _{n-1})
85-34	47520.620	-71177.877	27.603	317° 47' 18"	27.490	-10.807	-513555.340340	-1956679.838730
85-33	47541.065	-71196.423	13.320	227° 47' 35"	11.496	-28.413	-1350784.279845	-818474.078808
85-31	47532.116	-71206.290	24.790	137° 42' 26"	-27.287	6.815	323931.370540	1943006.035230
85-2	47513.778	-71189.608	3.997	92° 54' 40"	-18.541	20.674	982299.846372	1319926.521928
85-3	47513.575	-71185.616	10.465	47° 41' 16"	6.842	11.731	557381.748325	-487051.984672
							倍面積	-726.654948
							面積	363.3274740
							地積	363.32

画地面積(座標法)計算簿

画地番号：85- 4

点名	Xn	Yn	距離	方向角	X _{n+1} -X _{n-1}	Y _{n+1} -Y _{n-1}	X _n *(Y _{n+1} -Y _{n-1})	Y _n *(X _{n+1} -X _{n-1})
85-28	47562.605	-71198.194	4.231	223° 06' 49"	9.547	-14.449	-687232.079645	-679729.158118
85-24	47559.516	-71201.086	5.233	224° 49' 19"	-6.801	-6.581	-312989.174796	484238.585886
85-25	47555.804	-71204.775	5.261	226° 40' 44"	-7.322	-7.517	-357476.978668	521361.362550
85-26	47552.194	-71208.603	5.245	228° 50' 56"	-7.062	-7.778	-369860.964932	502875.154386
85-9	47548.742	-71212.553	6.552	229° 44' 07"	-7.687	-8.950	-425561.240900	547410.894911
85-1	47544.507	-71217.553	16.744	137° 43' 49"	-16.626	6.263	297771.247341	1184063.036178
85-31	47532.116	-71206.290	13.320	47° 47' 35"	-3.442	21.130	1004353.611080	245092.050180
85-33	47541.065	-71196.423	13.230	47° 42' 07"	17.853	19.653	934324.550445	-1271069.739819
85-32	47549.969	-71186.637	17.124	317° 33' 13"	21.540	-1.771	-84210.995099	-1533360.160980
							倍面積	-882.025174
							面積	441.0125870
							地積	441.01