



87街区 画地出来形確認図 (4259.53m²)

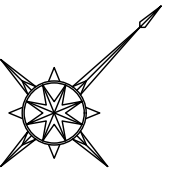

S=1:500

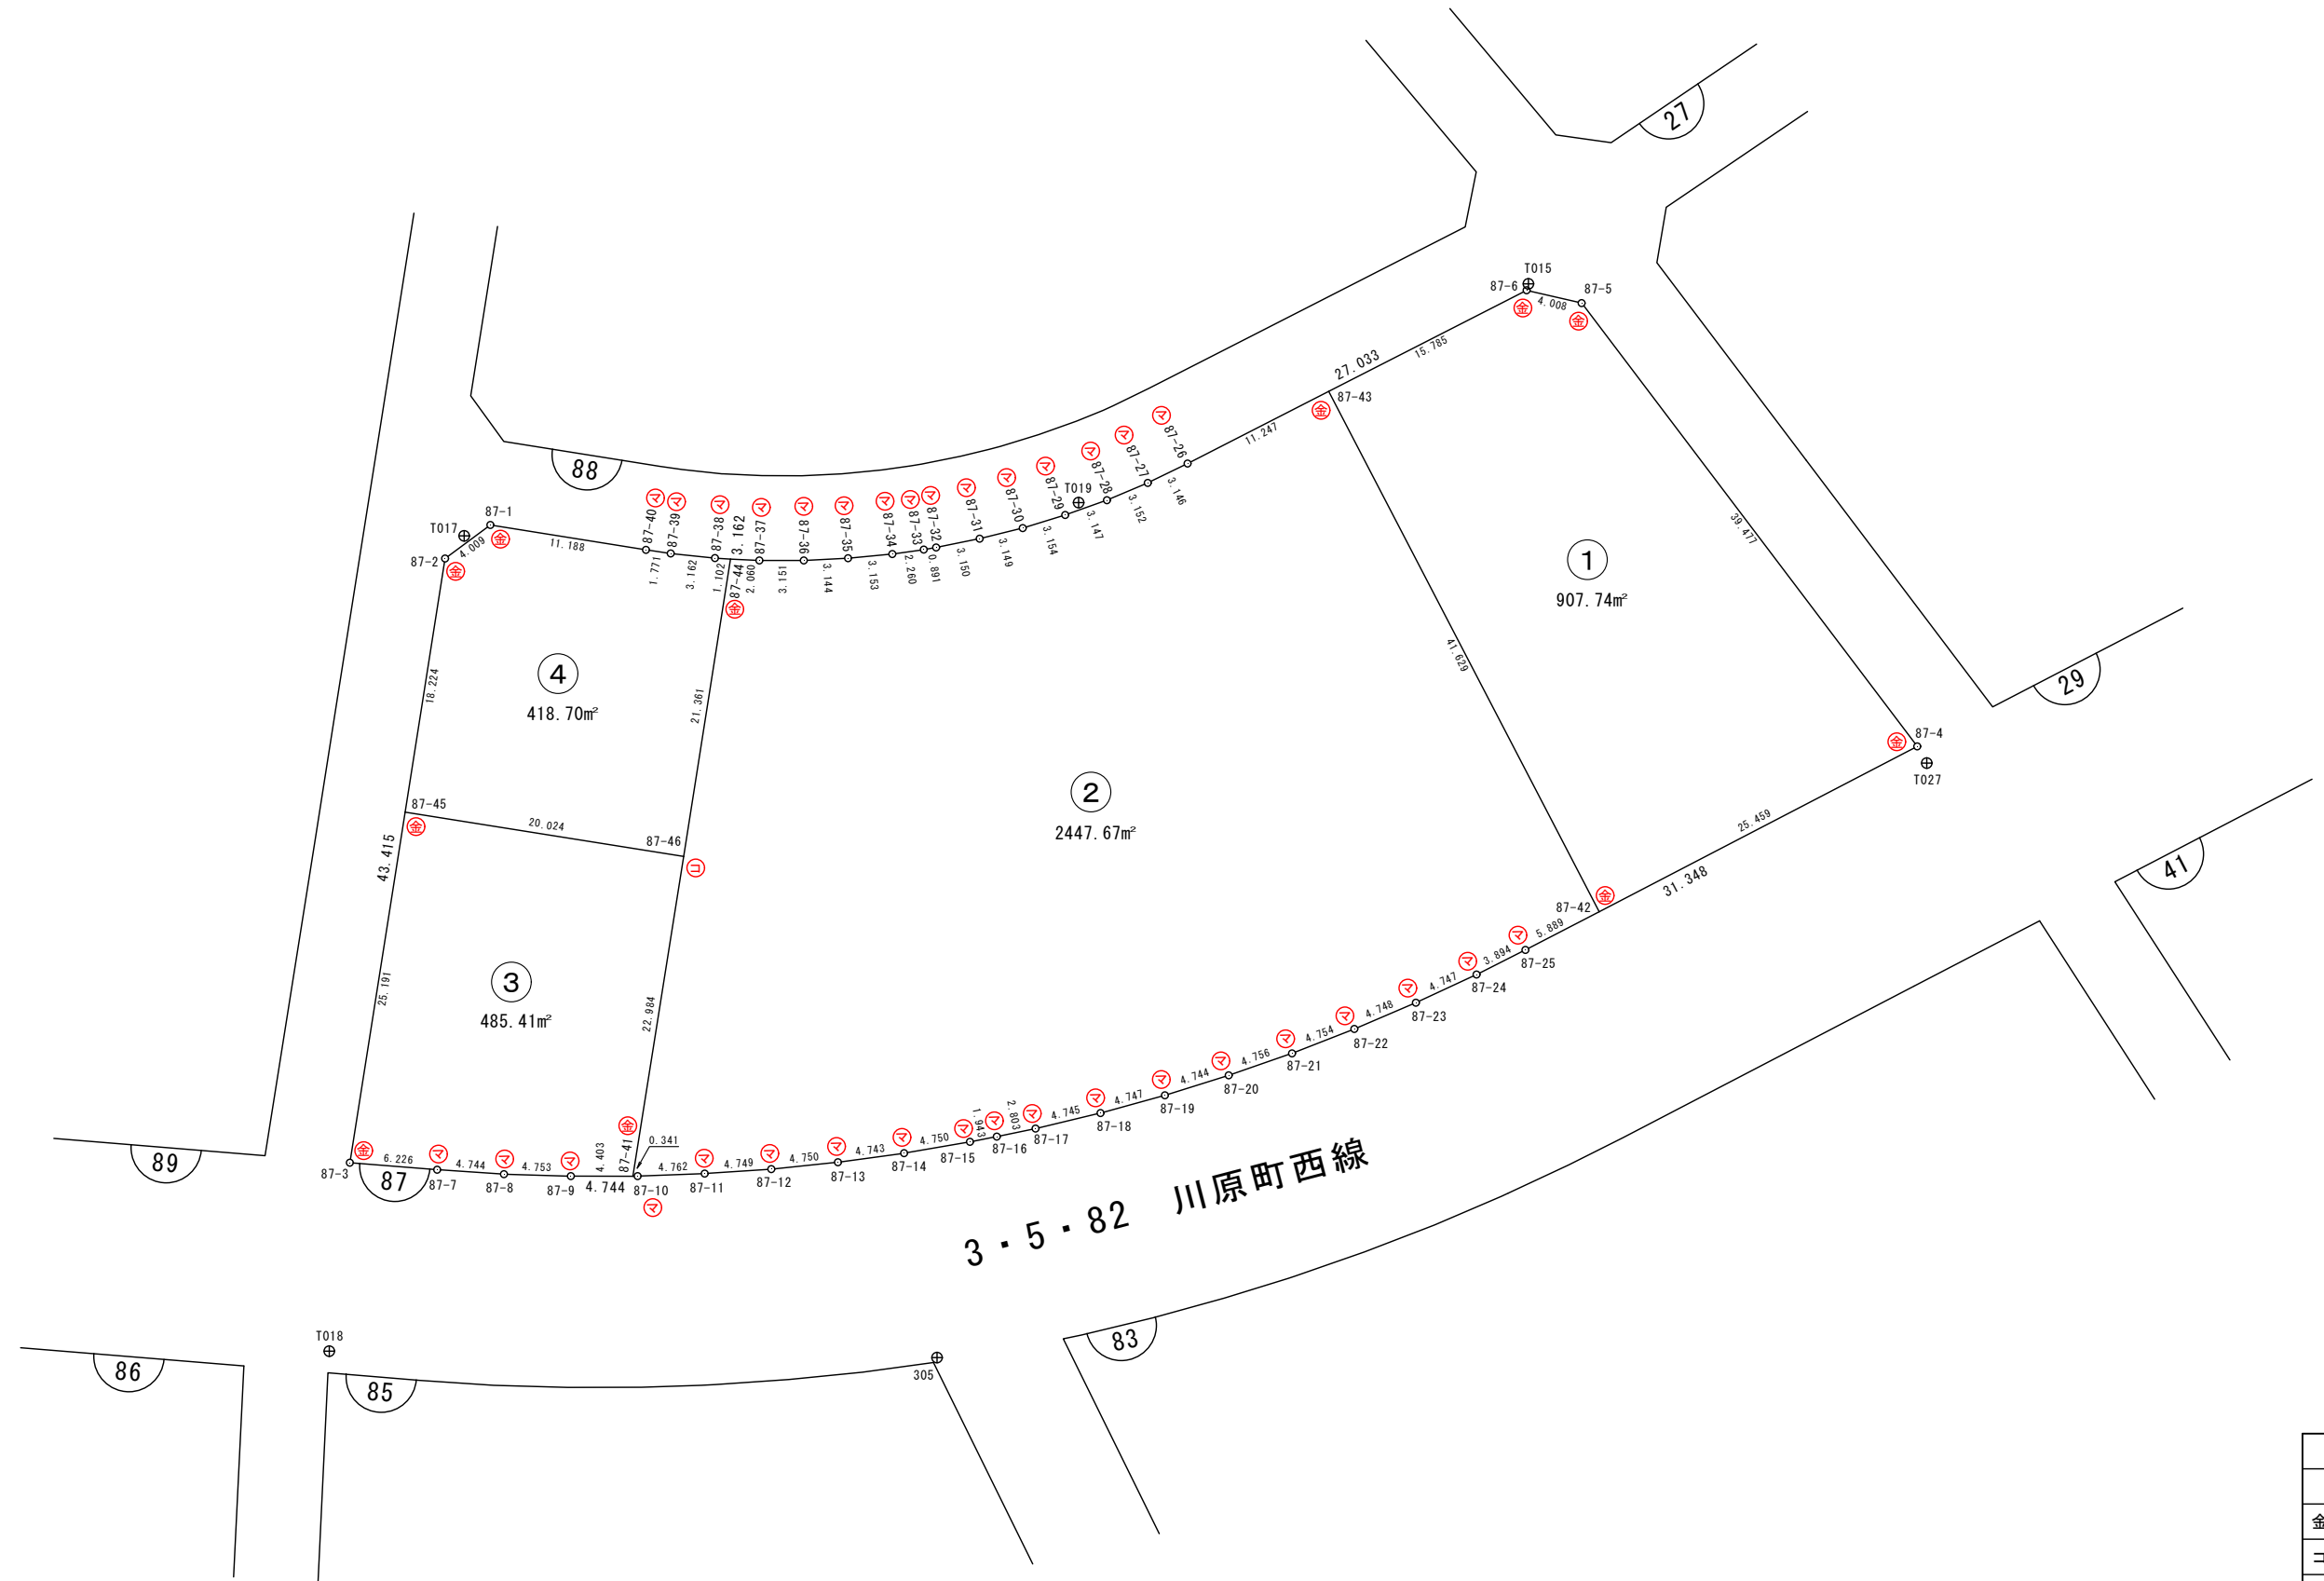

凡 例	
事 項	記 号
金属プレート	Ⓜ
コンクリート杭	Ⓜ
金属板	Ⓜ
合成樹脂杭	Ⓜ
マーキング	Ⓜ

画地面積(座標法)計算簿

画地番号：87- 1

点名	Xn	Yn	距離	方向角	X _{n+1} -X _{n-1}	Y _{n+1} -Y _{n-1}	X _n *(Y _{n+1} -Y _{n-1})	Y _n *(X _{n+1} -X _{n-1})
87-4	47655.751	-71169.179	39.477	277° 51' 49"	29.676	-31.431	-1497867.909681	-2112016.556004
87-5	47661.152	-71208.285	4.008	237° 59' 57"	3.277	-42.505	-2025837.265760	-233349.549945
87-6	47659.028	-71211.684	15.785	197° 57' 31"	-17.140	-8.266	-393949.525448	1220568.263760
87-43	47644.012	-71216.551	41.629	107° 31' 33"	-27.552	34.830	1659440.937960	1962158.413152
87-42	47631.476	-71176.854	25.459	17° 32' 43"	11.739	47.372	2256398.281072	-835545.089106
							倍面積	-1815.481857
							面積	907.7409285
							地積	907.74

画地面積(座標法)計算簿

画地番号：87- 2

点名	Xn	Yn	距離	方向角	X _{n+1} -X _{n-1}	Y _{n+1} -Y _{n-1}	X _n *(Y _{n+1} -Y _{n-1})	Y _n *(X _{n+1} -X _{n-1})
87-42	47631.476	-71176.854	41.629	287° 31' 33"	18.148	-37.911	-1805756.886636	-1291717.546392
87-43	47644.012	-71216.551	11.247	197° 57' 29"	1.836	-43.165	-2056553.777980	-130753.587636
87-26	47633.312	-71220.019	3.146	199° 02' 02"	-13.674	-4.494	-214064.104128	973862.539806
87-27	47630.338	-71221.045	3.152	202° 07' 19"	-5.894	-2.213	-105405.937994	419776.839230
87-28	47627.418	-71222.232	3.147	205° 27' 28"	-5.762	-2.540	-120973.641720	410382.500784
87-29	47624.576	-71223.585	3.154	207° 55' 19"	-5.629	-2.830	-134777.550080	400917.559965
87-30	47621.789	-71225.062	3.149	211° 10' 00"	-5.482	-3.107	-147960.898423	390455.789884
87-31	47619.094	-71226.692	3.150	213° 30' 12"	-5.322	-3.369	-160428.727686	379068.454824
87-32	47616.467	-71228.431	0.891	215° 13' 26"	-3.355	-2.253	-107279.900151	238971.386005
87-33	47615.739	-71228.945	2.260	217° 01' 01"	-2.533	-1.875	-89279.510625	180422.917685
87-34	47613.934	-71230.306	3.153	219° 32' 42"	-4.237	-3.369	-160411.343646	301802.806522
87-35	47611.502	-71232.314	3.144	222° 11' 25"	-4.762	-4.120	-196159.388240	339208.279268
87-36	47609.172	-71234.426	3.151	225° 02' 19"	-4.557	-4.342	-206719.024824	324615.279282
87-37	47606.945	-71236.656	2.060	227° 29' 53"	-3.619	-3.749	-178478.436805	257805.458064
87-44	47605.553	-71238.175	21.361	143° 57' 01"	-18.663	11.052	526136.571756	1329518.060025
87-46	47588.282	-71225.604	22.984	144° 02' 10"	-35.874	26.069	1240578.923458	2555147.317896
87-41	47569.679	-71212.106	0.341	43° 13' 16"	-18.354	13.732	653226.832028	1307026.993524
87-10	47569.928	-71211.872	4.762	42° 52' 21"	3.739	3.474	165257.929872	-266261.189408
87-11	47573.418	-71208.632	4.749	41° 11' 34"	7.064	6.368	302947.525824	-503017.776448
87-12	47576.992	-71205.504	4.750	39° 05' 15"	7.261	6.123	291313.922016	-517023.164544
87-13	47580.679	-71202.509	4.743	37° 14' 48"	7.463	5.866	279108.263014	-531384.324667
87-14	47584.455	-71199.638	4.750	35° 12' 45"	7.657	5.610	266948.792550	-545175.628166
87-15	47588.336	-71196.899	1.943	33° 54' 10"	5.494	3.823	181930.208528	-391155.763106
87-16	47589.949	-71195.815	2.803	33° 17' 56"	3.956	2.623	124828.436227	-281650.644140
87-17	47592.292	-71194.276	4.745	31° 32' 59"	6.387	4.022	191416.198424	-454717.840812
87-18	47596.336	-71191.793	4.747	29° 37' 36"	8.171	4.830	229890.302880	-581708.140603
87-19	47600.463	-71189.446	4.744	27° 36' 46"	8.331	4.546	216391.704798	-593079.274626
87-20	47604.667	-71187.247	4.756	25° 51' 14"	8.484	4.273	203414.742091	-603952.603548
87-21	47608.947	-71185.173	4.754	23° 41' 49"	8.634	3.985	189721.653795	-614612.783682
87-22	47613.301	-71183.262	4.748	21° 53' 12"	8.760	3.681	175264.560981	-623565.375120
87-23	47617.707	-71181.492	4.747	20° 06' 25"	8.864	3.402	161995.439214	-630952.745088
87-24	47622.165	-71179.860	3.894	18° 15' 13"	8.157	2.852	135818.414580	-580614.118020
87-25	47625.864	-71178.640	5.889	17° 39' 13"	9.311	3.006	143163.347184	-662744.317040
							倍面積	-4895.359718
							面積	2447.6798590
							地積	2447.67

画地面積(座標法)計算簿

画地番号：87- 3

点名	X _n	Y _n	距離	方向角	X _{n+1} -X _{n-1}	Y _{n+1} -Y _{n-1}	X _n *(Y _{n+1} -Y _{n-1})	Y _n *(X _{n+1} -X _{n-1})
87-41	47569.679	-71212.106	22.984	324° 02' 10"	21.714	-10.382	-493868.407378	-1546299.669684
87-46	47588.282	-71225.604	20.024	234° 01' 06"	6.838	-29.702	-1413467.151964	-487040.680152
87-45	47576.517	-71241.808	25.191	143° 58' 20"	-32.138	-1.387	-65988.629079	2289569.225504
87-3	47556.144	-71226.991	6.226	49° 31' 14"	-16.331	19.553	929865.283632	1163207.990021
87-7	47560.186	-71222.255	4.744	48° 51' 14"	7.164	8.309	395177.585474	-510236.234820
87-8	47563.308	-71218.682	4.753	46° 42' 17"	6.382	7.033	334512.745164	-454517.628524
87-9	47566.568	-71215.222	4.403	45° 02' 46"	6.371	6.576	312797.751168	-453712.179362
							倍面積	-970.822983
							面積	485.4114915
							地積	485.41

画地面積(座標法)計算簿

画地番号：87- 4

点名	Xn	Yn	距離	方向角	X _{n+1} -X _{n-1}	Y _{n+1} -Y _{n-1}	X _n *(Y _{n+1} -Y _{n-1})	Y _n *(X _{n+1} -X _{n-1})
87-46	47588.282	-71225.604	21.361	323° 57' 01"	29.036	3.633	172888.228506	-2068106.637744
87-44	47605.553	-71238.175	1.102	228° 51' 47"	16.546	-13.401	-637962.015753	-1178706.843550
87-38	47604.828	-71239.005	3.162	230° 55' 48"	-2.718	-3.285	-156381.859980	193627.615590
87-39	47602.835	-71241.460	1.771	233° 24' 07"	-3.049	-3.877	-184556.191295	217215.211540
87-40	47601.779	-71242.882	11.188	234° 04' 21"	-7.621	-10.482	-498961.847478	542942.003722
87-1	47595.214	-71251.942	4.009	188° 31' 13"	-10.530	-9.654	-459484.195956	750282.949260
87-2	47591.249	-71252.536	18.224	143° 56' 15"	-18.697	10.134	482289.717366	1332208.665592
87-45	47576.517	-71241.808	20.024	54° 01' 06"	-2.967	26.932	1281330.755844	211374.444336
							倍面積	-837.408746
							面積	418.7043730
							地積	418.70