



9 街区 画地出来形確認図 (3144.47m²)

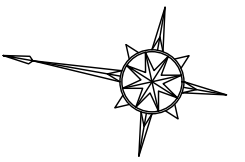

S=1:500

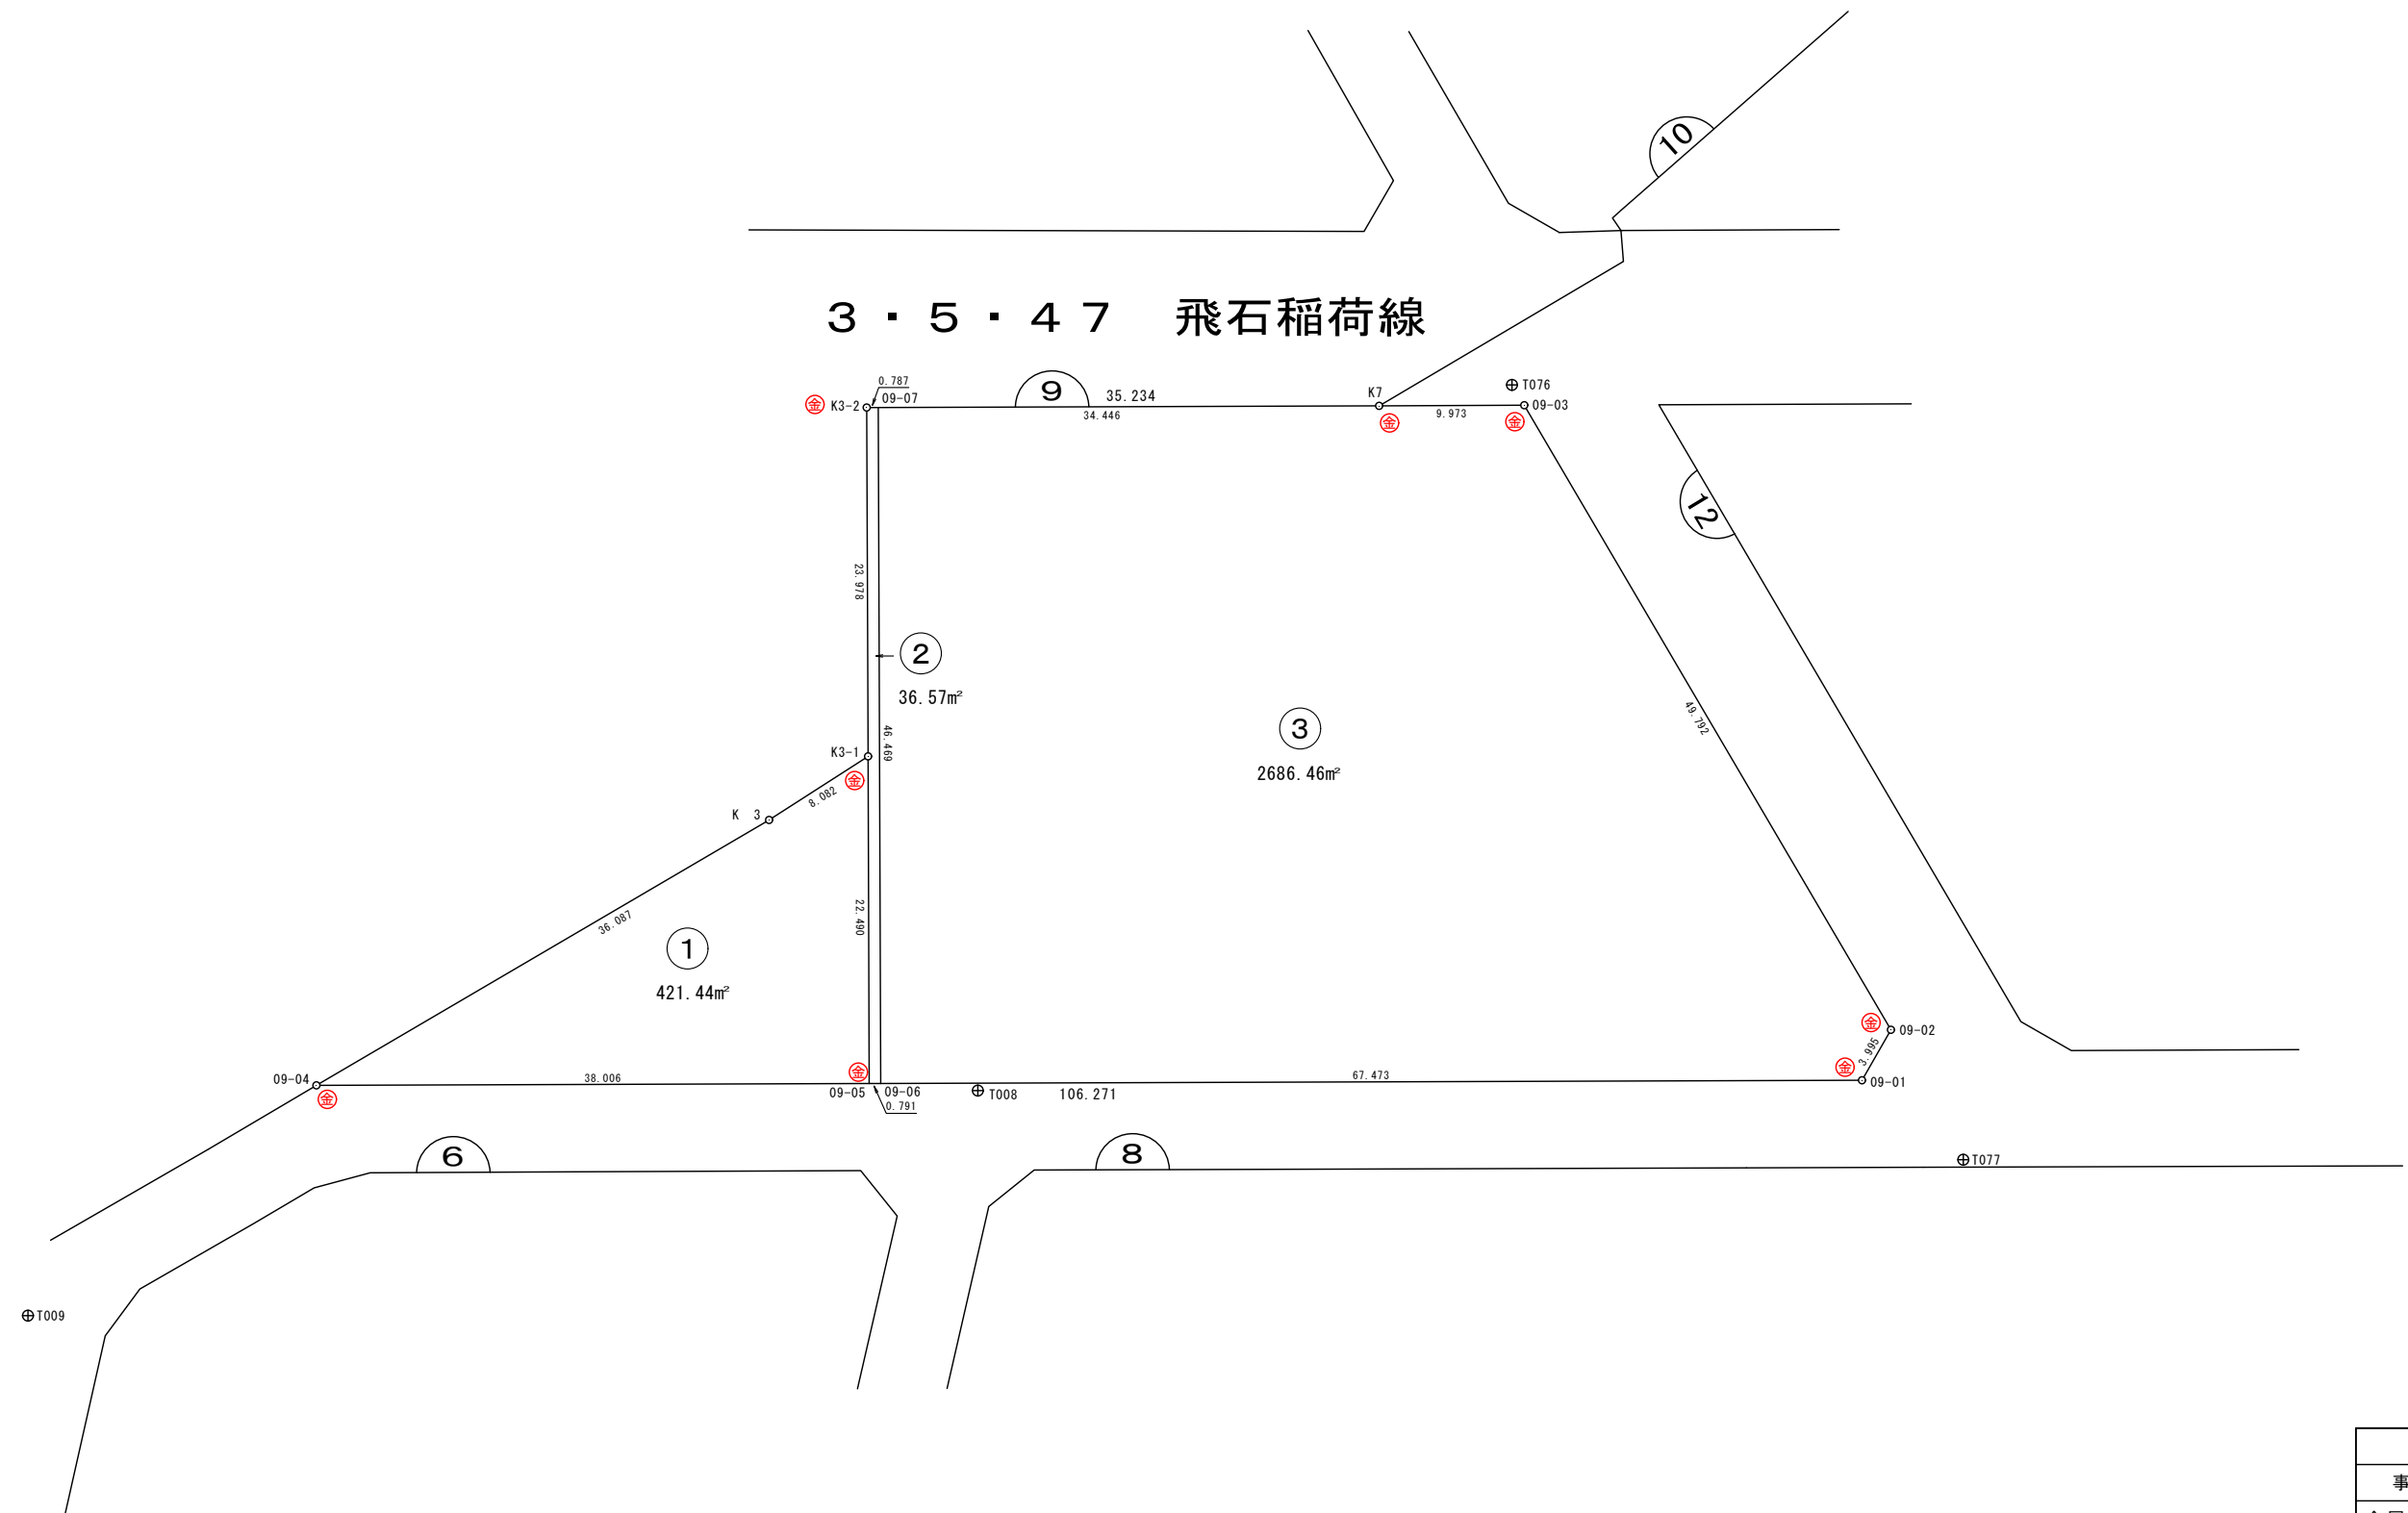

凡 例	
事 項	記 号
金属プレート	⊕
コンクリート杭	⊖
金属錐	⊙
合成樹脂杭	⊕
マーキング	⊗

画地面積(座標法)計算簿

画地番号：09-01

点名	Xn	Yn	距離	方向角	X _{n+1} -X _{n-1}	Y _{n+1} -Y _{n-1}	X _n *(Y _{n+1} -Y _{n-1})	Y _n *(X _{n+1} -X _{n-1})
K3-1	48222.944	-71053.431	22.490	259° 48' 35"	-9.917	-16.652	-803008.463488	704636.875227
09-05	48218.965	-71075.567	38.006	349° 48' 07"	33.427	-28.865	-1391840.424725	-2375842.978109
09-04	48256.371	-71082.296	36.087	139° 37' 01"	9.917	16.652	803565.089892	-704923.129432
K3#K	48228.882	-71058.915	8.082	137° 16' 34"	-33.427	28.865	1392126.678930	2375286.351705
							倍面積	842.880609
							面積	421.4403045
							地積	421.44

画地面積(座標法)計算簿

画地番号：09-02

点名	Xn	Yn	距離	方向角	X _{n+1} -X _{n-1}	Y _{n+1} -Y _{n-1}	X _n *(Y _{n+1} -Y _{n-1})	Y _n *(X _{n+1} -X _{n-1})
09-06	48218.186	-71075.427	46.469	79° 47' 33"	7.456	45.874	2211961.064564	-529938.383712
09-07	48226.421	-71029.693	0.787	349° 49' 55"	9.010	45.595	2198883.665495	-639977.533930
K3-2	48227.196	-71029.832	23.978	259° 47' 10"	-3.477	-23.738	-1144817.178648	246970.725864
K3-1	48222.944	-71053.431	22.490	259° 48' 35"	-8.231	-45.735	-2205476.343840	584840.790561
09-05	48218.965	-71075.567	0.791	169° 48' 42"	-4.758	-21.996	-1060624.354140	338177.547786
							倍面積	-73.146569
							面積	36.5732845
							地積	36.57

画地面積(座標法)計算簿

画地番号：09-03

点名	Xn	Yn	距離	方向角	X _{n+1} -X _{n-1}	Y _{n+1} -Y _{n-1}	X _n *(Y _{n+1} -Y _{n-1})	Y _n *(X _{n+1} -X _{n-1})
09-07	48226.421	-71029.693	46.469	259° 47' 33"	25.668	-51.831	-2499623.626851	-1823190.159924
09-06	48218.186	-71075.427	67.473	169° 48' 45"	-74.645	-33.800	-1629774.686800	5305425.248415
09-01	48151.776	-71063.493	3.995	109° 51' 16"	-67.767	15.692	755597.668992	4815759.730131
09-02	48150.419	-71059.735	49.792	49° 34' 51"	30.927	41.666	2006235.358054	-2197664.424345
09-03	48182.703	-71021.827	9.973	349° 46' 59"	42.099	36.139	1741274.703717	-2989947.894873
K7	48192.518	-71023.596	34.446	349° 48' 18"	43.718	-7.866	-379082.346588	-3105009.569928
							倍面積	-5372.929476
							面積	2686.4647380
							地積	2686.46