



平成13年度 川原第三土地区画整理事業

基準点配置図

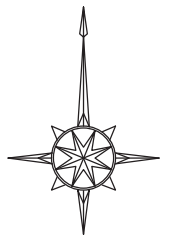

S=1:2000

世界測地系

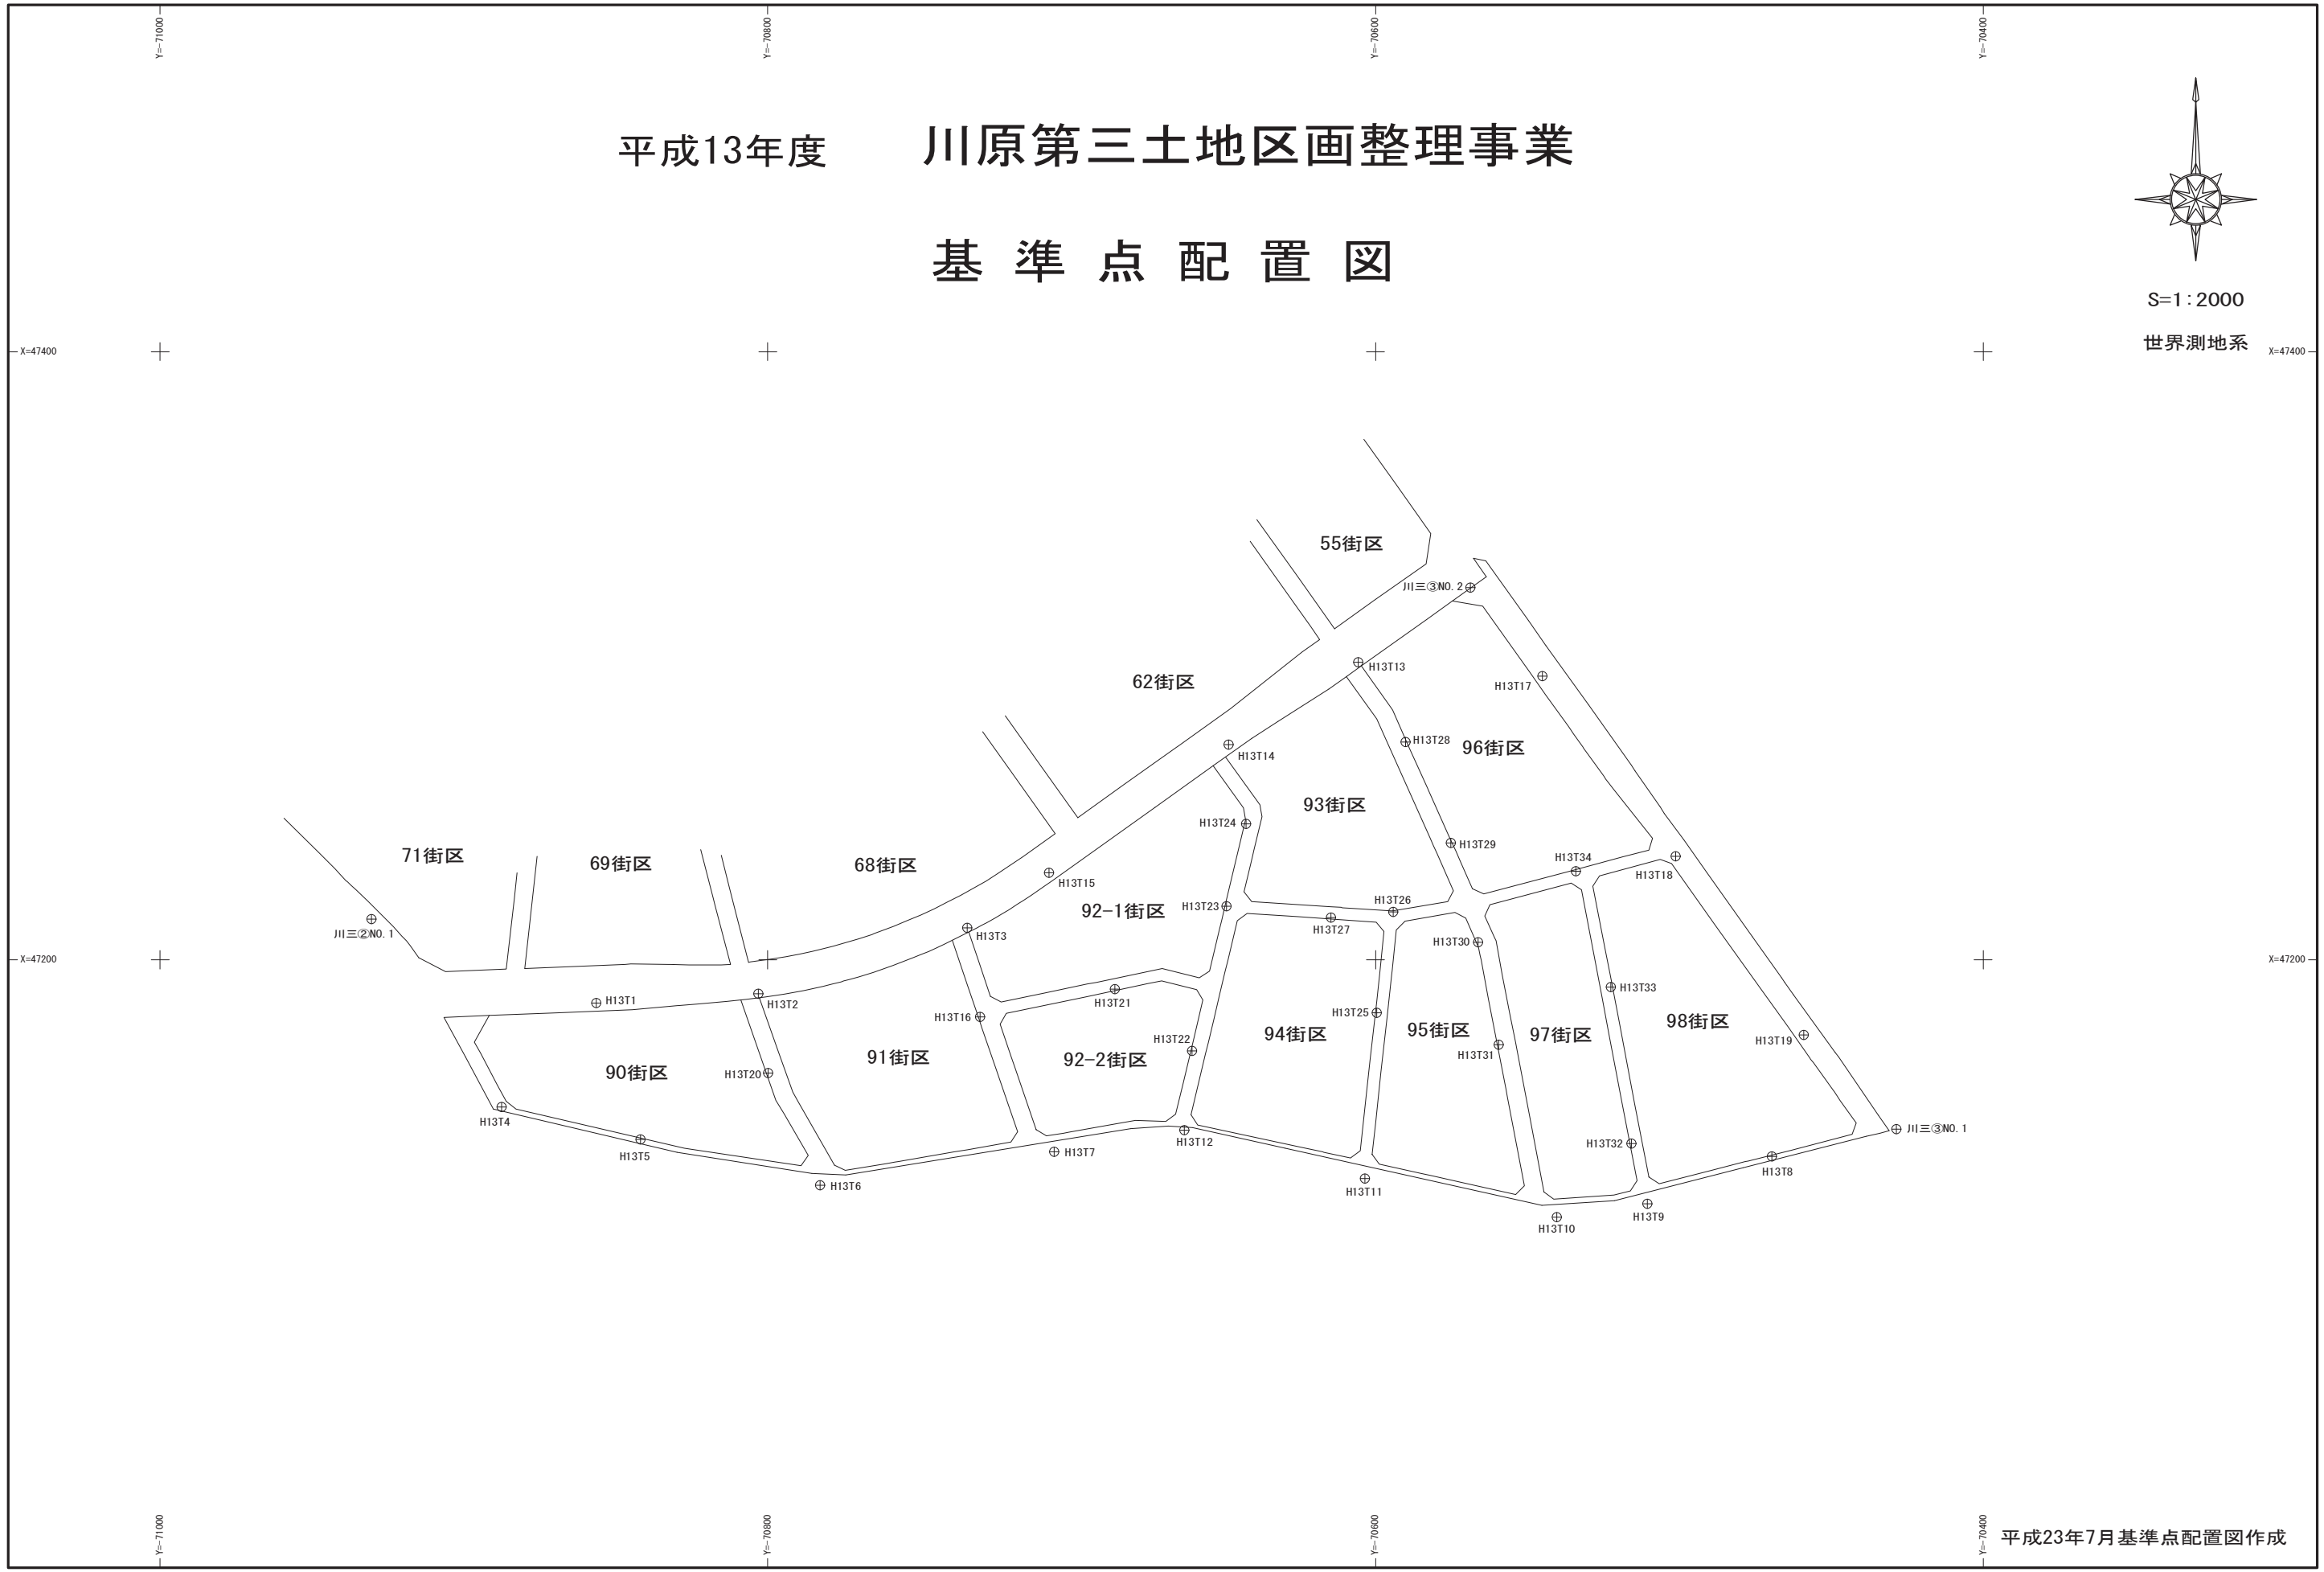

測点リスト

地区名：平成13年度川原第三土地区画整理事業

測点	X m	Y m	測点	X m	Y m
川三②NO.1	47213.311	-70930.512	H13T25	47182.505	-70599.607
川三③NO.1	47144.322	-70428.500	H13T26	47215.673	-70594.130
川三③NO.2	47322.394	-70568.814	H13T27	47213.847	-70614.632
H13T1	47185.808	-70856.449	H13T28	47271.577	-70590.165
H13T2	47188.818	-70803.195	H13T29	47238.355	-70575.252
H13T3	47210.489	-70734.376	H13T30	47205.785	-70566.210
H13T4	47151.496	-70887.610	H13T31	47172.117	-70559.531
H13T5	47140.956	-70841.852	H13T32	47139.461	-70515.719
H13T6	47125.778	-70782.748	H13T33	47190.950	-70522.530
H13T7	47136.829	-70705.797	H13T34	47229.158	-70534.103
H13T8	47135.345	-70469.561	H19K70	47189.631	-70911.631
H13T9	47119.695	-70510.548	H19K71	47198.135	-70916.960
H13T10	47115.262	-70540.289			
H13T11	47128.034	-70603.465			
H13T12	47143.925	-70662.934			
H13T13	47297.813	-70605.659			
H13T14	47270.760	-70648.337			
H13T15	47228.541	-70707.534			
H13T16	47181.157	-70730.199			
H13T17	47293.246	-70544.987			
H13T18	47233.954	-70501.139			
H13T19	47175.292	-70459.018			
H13T20	47162.645	-70799.876			
H13T21	47190.254	-70685.844			
H13T22	47170.036	-70660.344			
H13T23	47217.610	-70649.015			
H13T24	47244.723	-70642.528			