



109街区 画地出来形確認図 (4548.82m²)

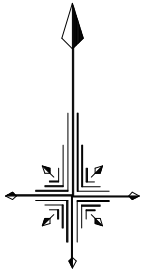

S=1/500

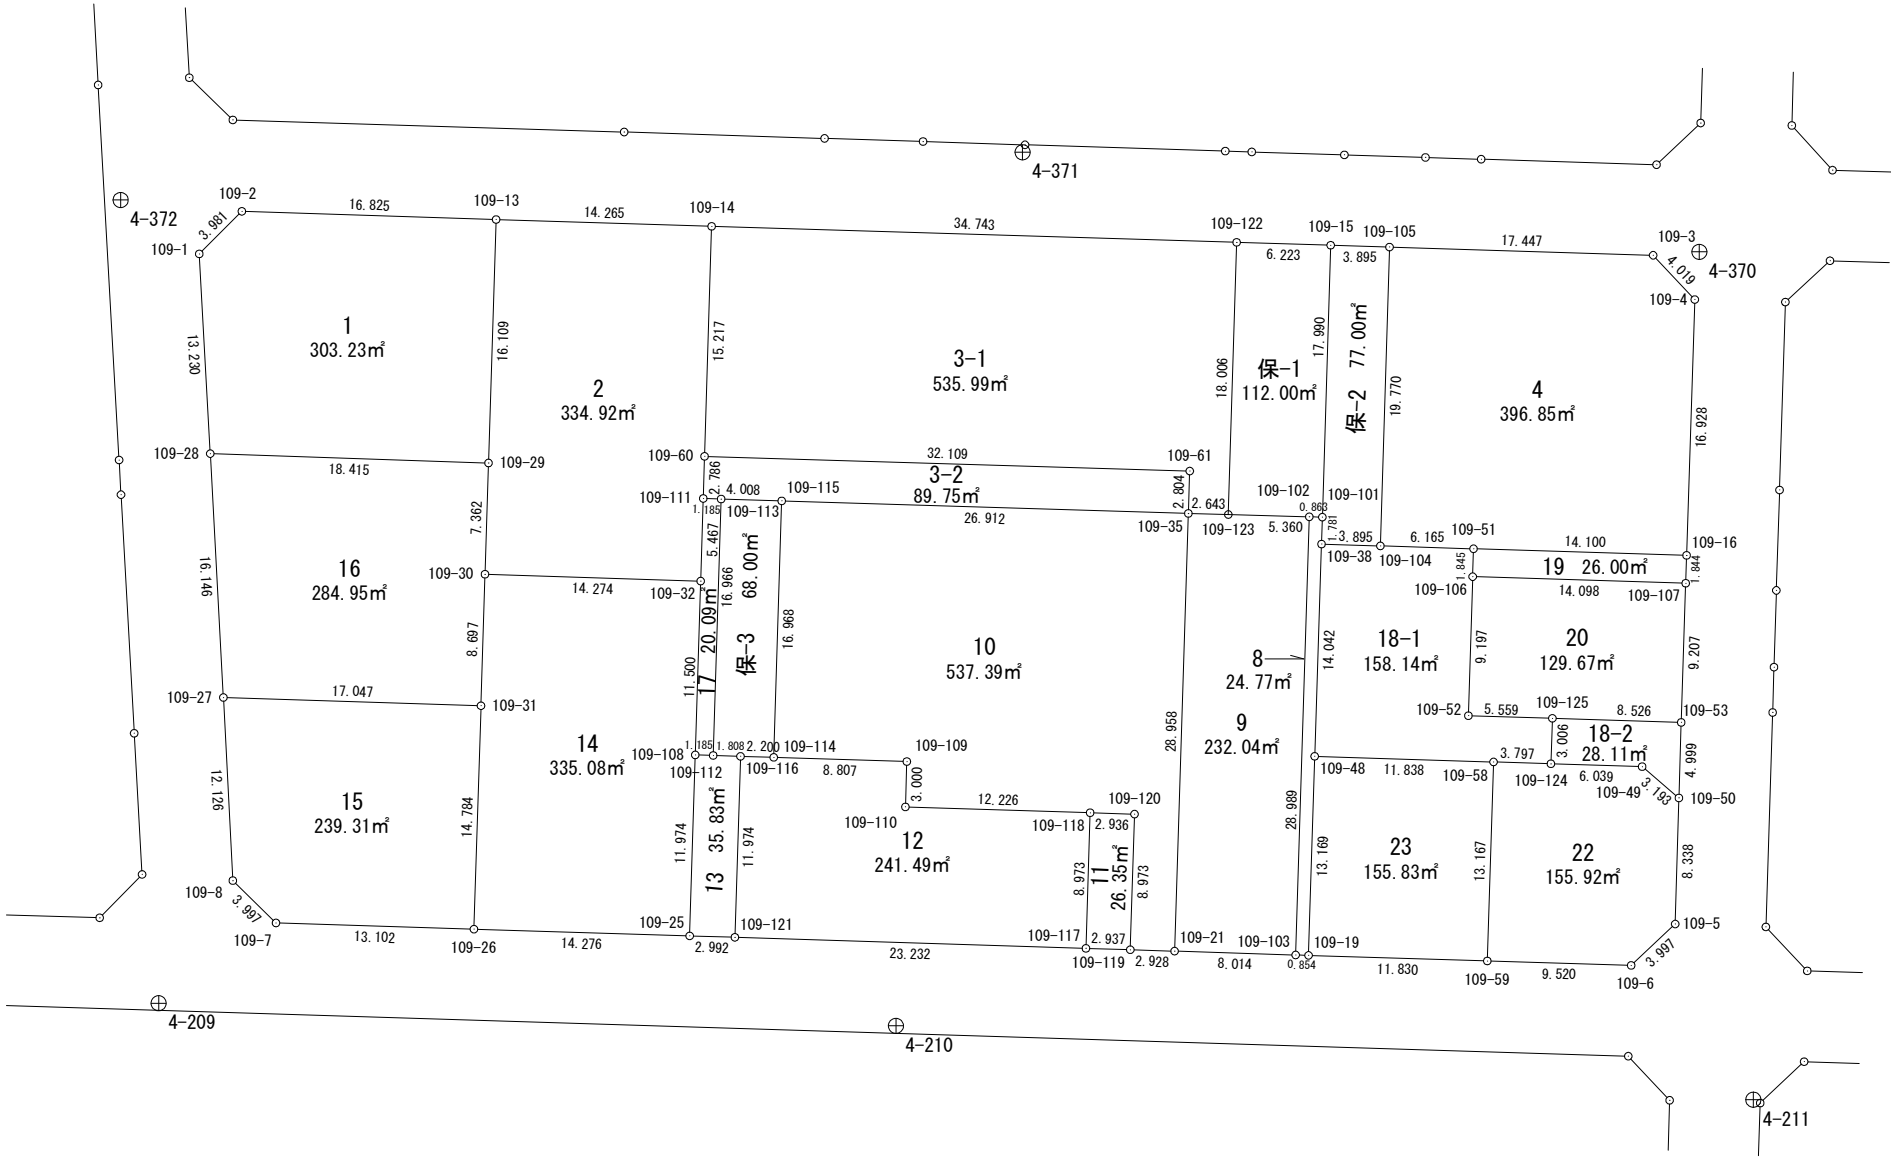


面積計算書（座標法）

世界測地系（測地成果2011）

所 在	地 番	公簿地目	現況地目	地 積	所 有 者
前橋市六供町四丁目	109-10			537.39 m ²	

点 名	X 座標	Y 座標	辺 長	方 向 角	測 角	DX	倍 積 (Y×DX)
109-114	41269.953	-67751.251	8.807	91-48-08	90-01-21	-17.237	1167828.313487
109-109	41269.676	-67742.448	3.000	181-47-43	269-59-35	-3.276	221924.259648
109-110	41266.677	-67742.542	12.226	91-48-00	90-00-17	-3.383	229173.019586
109-118	41266.293	-67730.322	2.936	91-47-43	179-59-43	-0.476	32239.633272
109-120	41266.201	-67727.387	8.973	181-46-31	269-58-48	-9.061	613677.853607
109-119	41257.232	-67727.665	2.928	91-48-01	90-01-30	-9.061	613680.372565
109-21	41257.140	-67724.738	28.958	1-48-24	90-00-23	28.852	-1953994.140776
109-35	41286.084	-67723.825	26.912	271-45-55	89-57-31	29.773	-2016341.441725
109-115	41286.913	-67750.724	16.968	181-46-47	90-00-52	-16.131	1092886.928844
						倍面積	1074.798508
						面 積	537.3992540

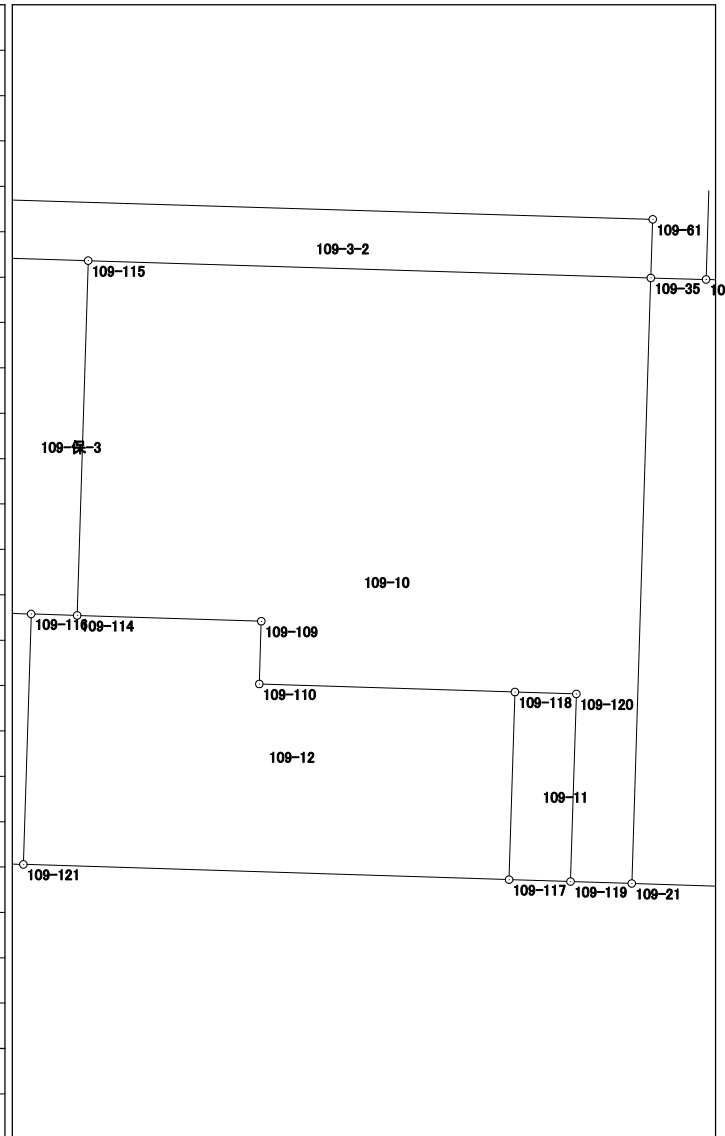


面積計算書 (座標法)

世界測地系 (測地成果2011)

所 在	地 番	公簿地目	現況地目	地 積	所 有 者
前橋市六供町四丁目	109-11			26.35 m ²	

点 名	X 座 標	Y 座 標	辺 長	方 向 角	測 角	DX	倍 積 (Y×DX)
109-117	41257.324	-67730.601	2.937	91-47-41	90-00-47	-9.061	613706.975661
109-119	41257.232	-67727.665	8.973	1-46-31	89-58-50	8.877	-601218.482205
109-120	41266.201	-67727.387	2.936	271-47-43	90-01-12	9.061	-613677.853607
109-118	41266.293	-67730.322	8.973	181-46-54	89-59-11	-8.877	601242.068394

倍面積	52.708243
面 積	26.3541215

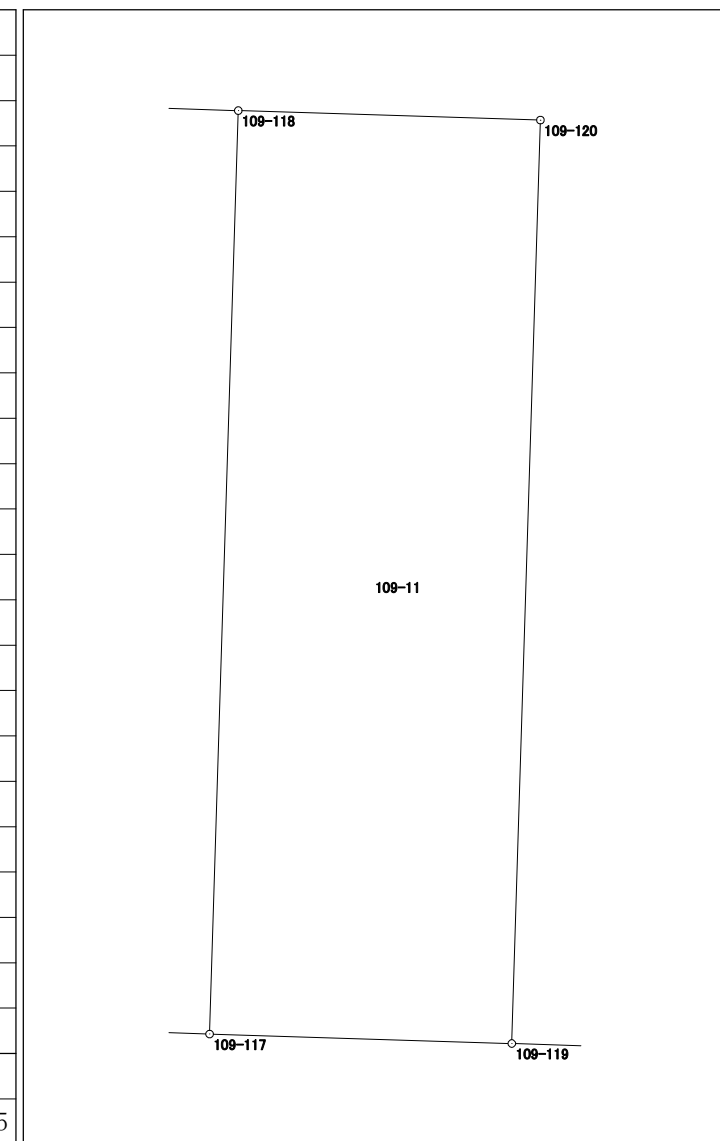


面積計算書（座標法）

世界測地系（測地成果2011）

所在	地番	公簿地目	現況地目	地積	所有者
前橋市六供町四丁目	109-12			241.49 m ²	

点名	X 座標	Y 座標	辺長	方向角	測角	DX	倍積 (Y×DX)
109-116	41270.022	-67753.450	11.974	181-46-49	89-58-59	-11.899	806198.301550
109-121	41258.054	-67753.822	23.232	91-48-02	90-01-13	-12.698	860338.031756
109-117	41257.324	-67730.601	8.973	1-46-54	89-58-52	8.239	-558032.421639
109-118	41266.293	-67730.322	12.226	271-48-00	90-01-06	9.353	-633481.701666
109-110	41266.677	-67742.542	3.000	1-47-43	269-59-43	3.383	-229173.019586
109-109	41269.676	-67742.448	8.807	271-48-08	90-00-25	3.276	-221924.259648
109-114	41269.953	-67751.251	2.200	271-47-50	179-59-42	0.346	-23441.932846

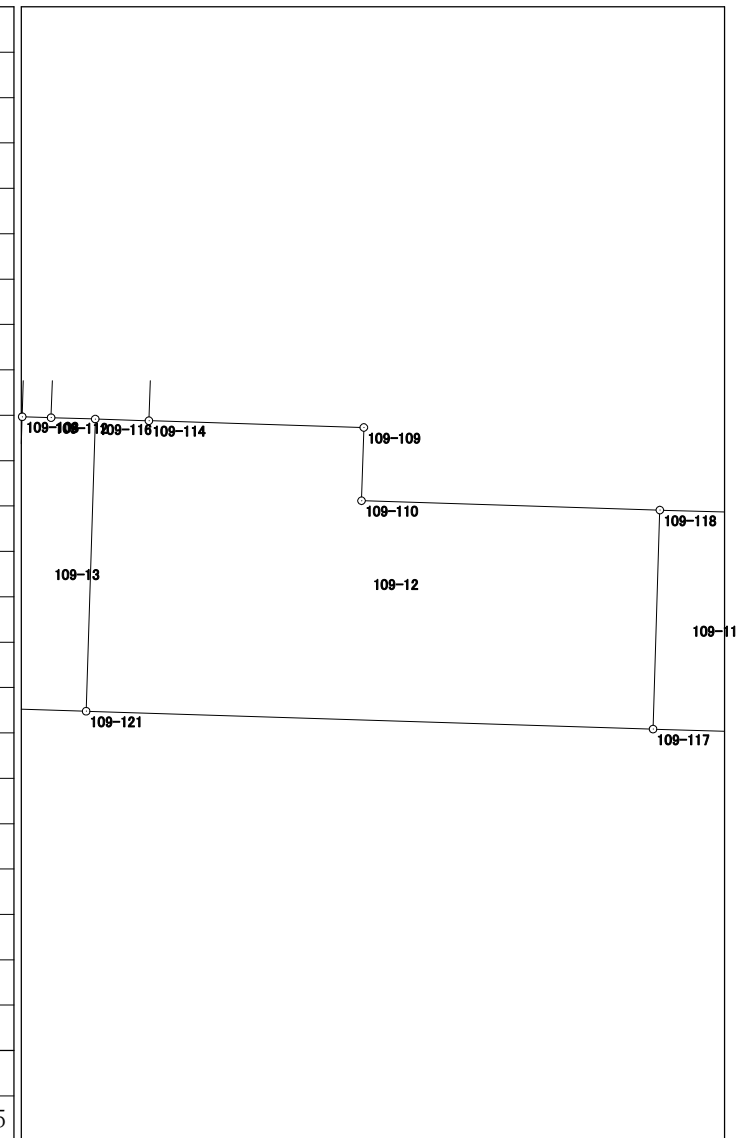


面積計算書 (座標法)

世界測地系 (測地成果2011)

所在	地番	公簿地目	現況地目	地積	所有者
前橋市六供町四丁目	109-13			35.83 m ²	

点名	X座標	Y座標	辺長	方向角	測角	DX	倍積 (Y×DX)
109-108	41270.116	-67756.441	11.974	181-46-49	89-59-25	-11.931	808402.097571
109-25	41258.148	-67756.813	2.992	91-48-00	90-01-11	-12.062	817282.678406
109-121	41258.054	-67753.822	11.974	1-46-49	89-58-49	11.874	-804508.882428
109-116	41270.022	-67753.450	1.808	271-48-24	90-01-35	12.025	-814735.236250
109-112	41270.079	-67755.257	1.185	271-47-24	179-59-00	0.094	-6368.994158
						倍面積	71.663141
						面積	35.8315705

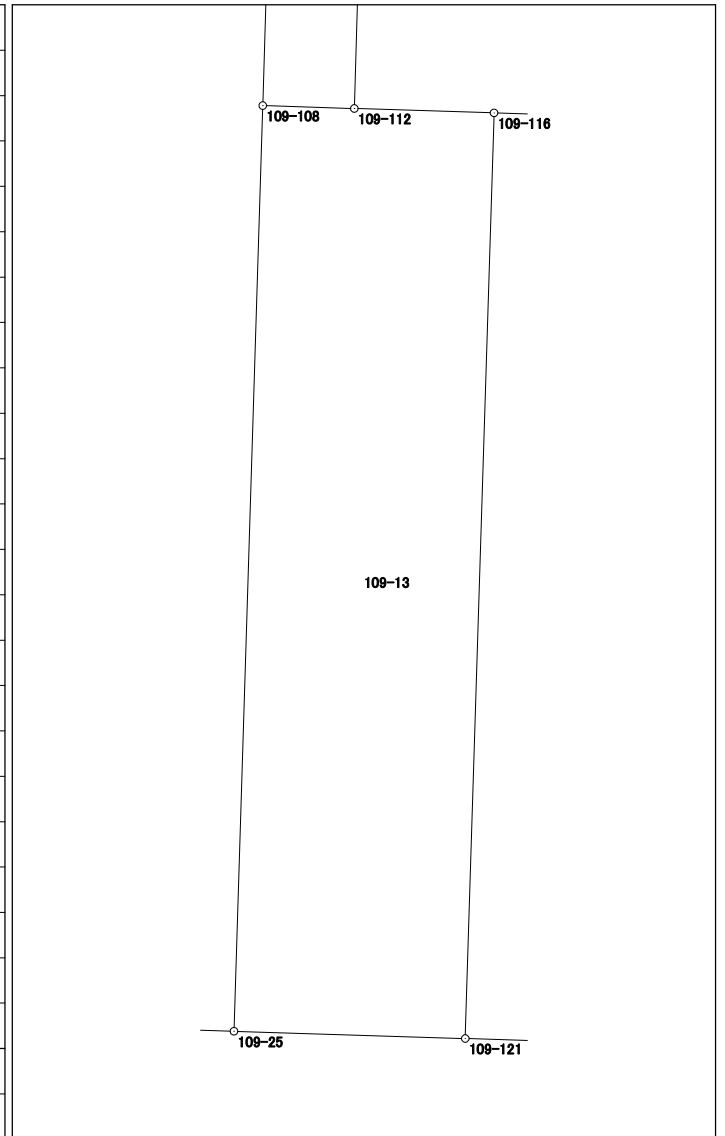


面積計算書 (座標法)

世界測地系 (測地成果2011)

所在	地番	公簿地目	現況地目	地積	所有者
前橋市六供町四丁目	109-14			335.08 m ²	

点名	X座標	Y座標	辺長	方向角	測角	DX	倍積 (Y×DX)
109-30	41282.062	-67770.351	8.697	181-45-10	89-56-17	-8.241	558495.462591
109-31	41273.369	-67770.617	14.784	181-48-09	180-02-59	-23.470	1590576.380990
109-26	41258.592	-67771.082	14.276	91-46-56	89-58-47	-15.221	1031543.639122
109-25	41258.148	-67756.813	11.974	1-46-49	89-59-53	11.524	-780829.513012
109-108	41270.116	-67756.441	11.500	1-46-44	179-59-55	23.462	-1589701.618742
109-32	41281.610	-67756.084	14.274	271-48-53	90-02-09	11.946	-809414.179464

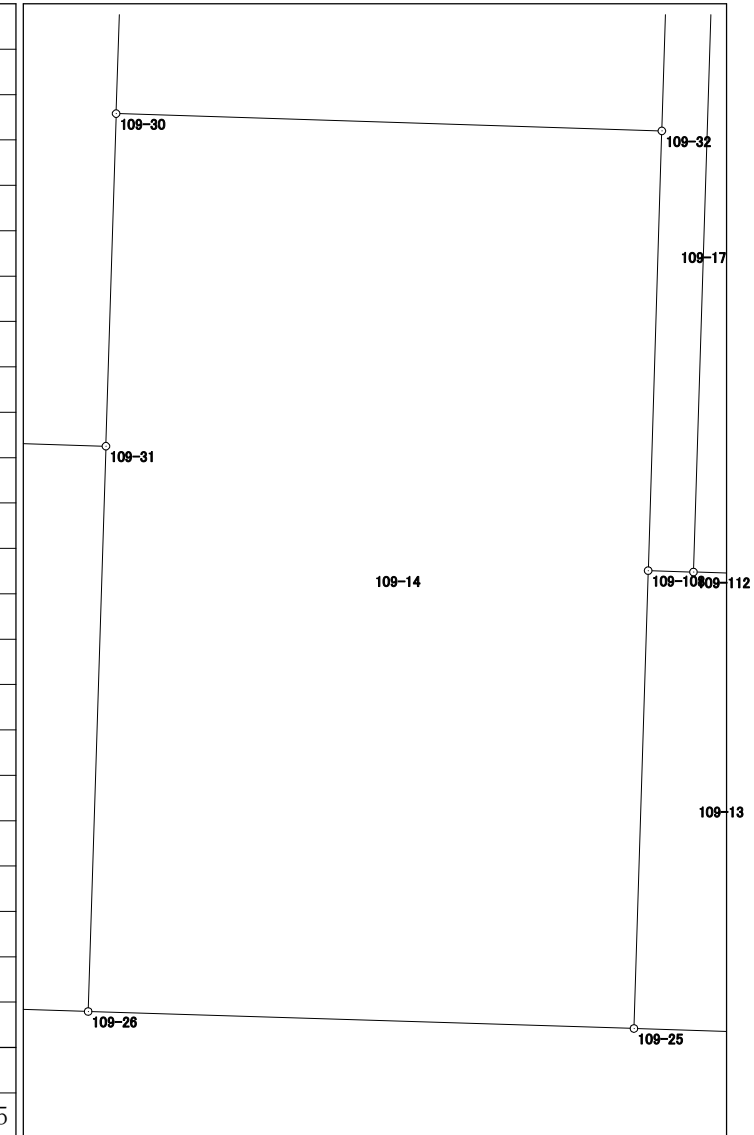


倍面積	670.171485
面積	335.0857425

面積計算書 (座標法)

世界測地系 (測地成果2011)

所在	地番	公簿地目	現況地目	地積	所有者
前橋市六供町四丁目	109-16			284.95 m ²	

点名	X座標	Y座標	辺長	方向角	測角	DX	倍積 (Y×DX)
109-28	41290.037	-67788.525	16.146	176-54-41	84-59-29	-15.506	1051128.868650
109-27	41273.914	-67787.655	17.047	91-49-56	94-55-15	-16.668	1129884.633540
109-31	41273.369	-67770.617	8.697	1-45-10	89-55-14	8.148	-552194.987316
109-30	41282.062	-67770.351	7.362	1-47-53	180-02-43	16.051	-1087781.903901
109-29	41289.420	-67770.120	18.415	271-55-12	90-07-19	7.975	-540466.707000
						倍面積	569.903973
						面積	284.9519865

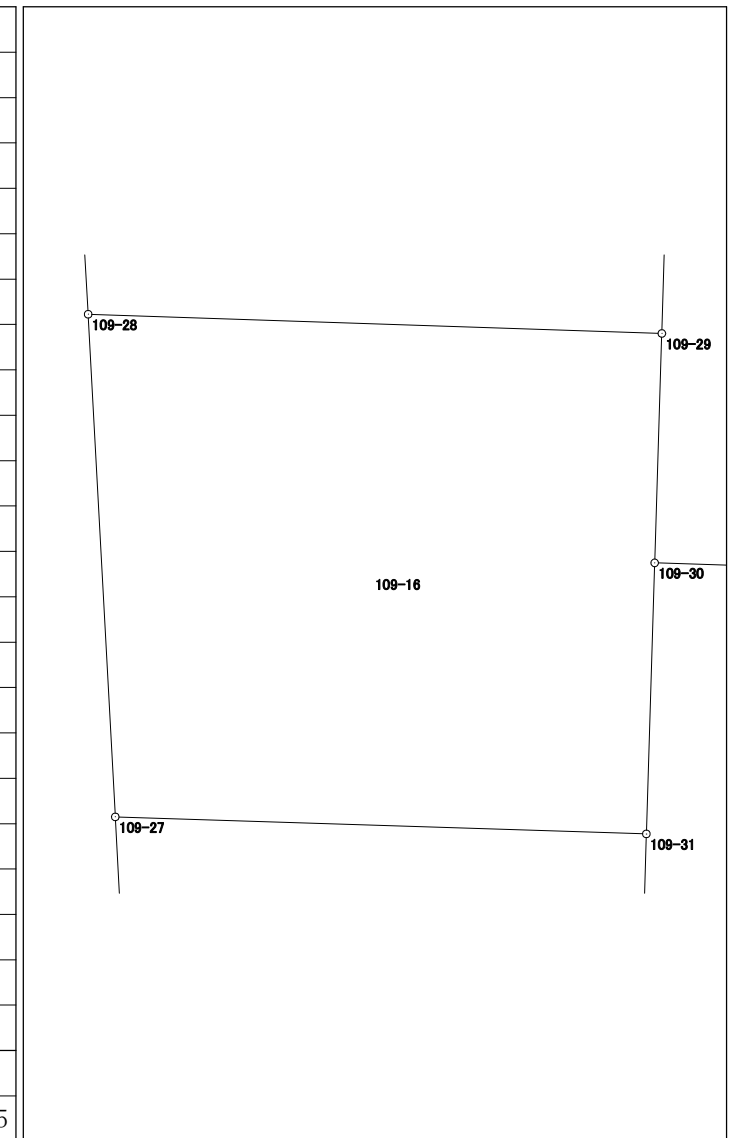

面積計算書 (座標法)

世界測地系 (測地成果2011)

所在	地番	公簿地目	現況地目	地積	所有者
前橋市六供町四丁目	109-17			20.09 m ²	

点名	X座標	Y座標	辺長	方向角	測角	DX	倍積 (Y×DX)
109-32	41281.610	-67756.084	11.500	181-46-44	179-59-49	-16.958	1149007.672472
109-108	41270.116	-67756.441	1.185	91-47-24	90-00-40	-11.531	781299.521171
109-112	41270.079	-67755.257	16.966	1-46-48	89-59-24	16.921	-1146486.703697
109-113	41287.037	-67754.730	1.185	271-47-24	90-00-36	16.995	-1151491.636350
109-111	41287.074	-67755.914	5.467	181-46-55	89-59-31	-5.427	367711.345278
						倍面積	40.198874
						面積	20.0994370

