



# 111-2街区 画地出来形確認図 (2420.10m<sup>2</sup>)

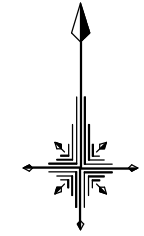

S=1/500

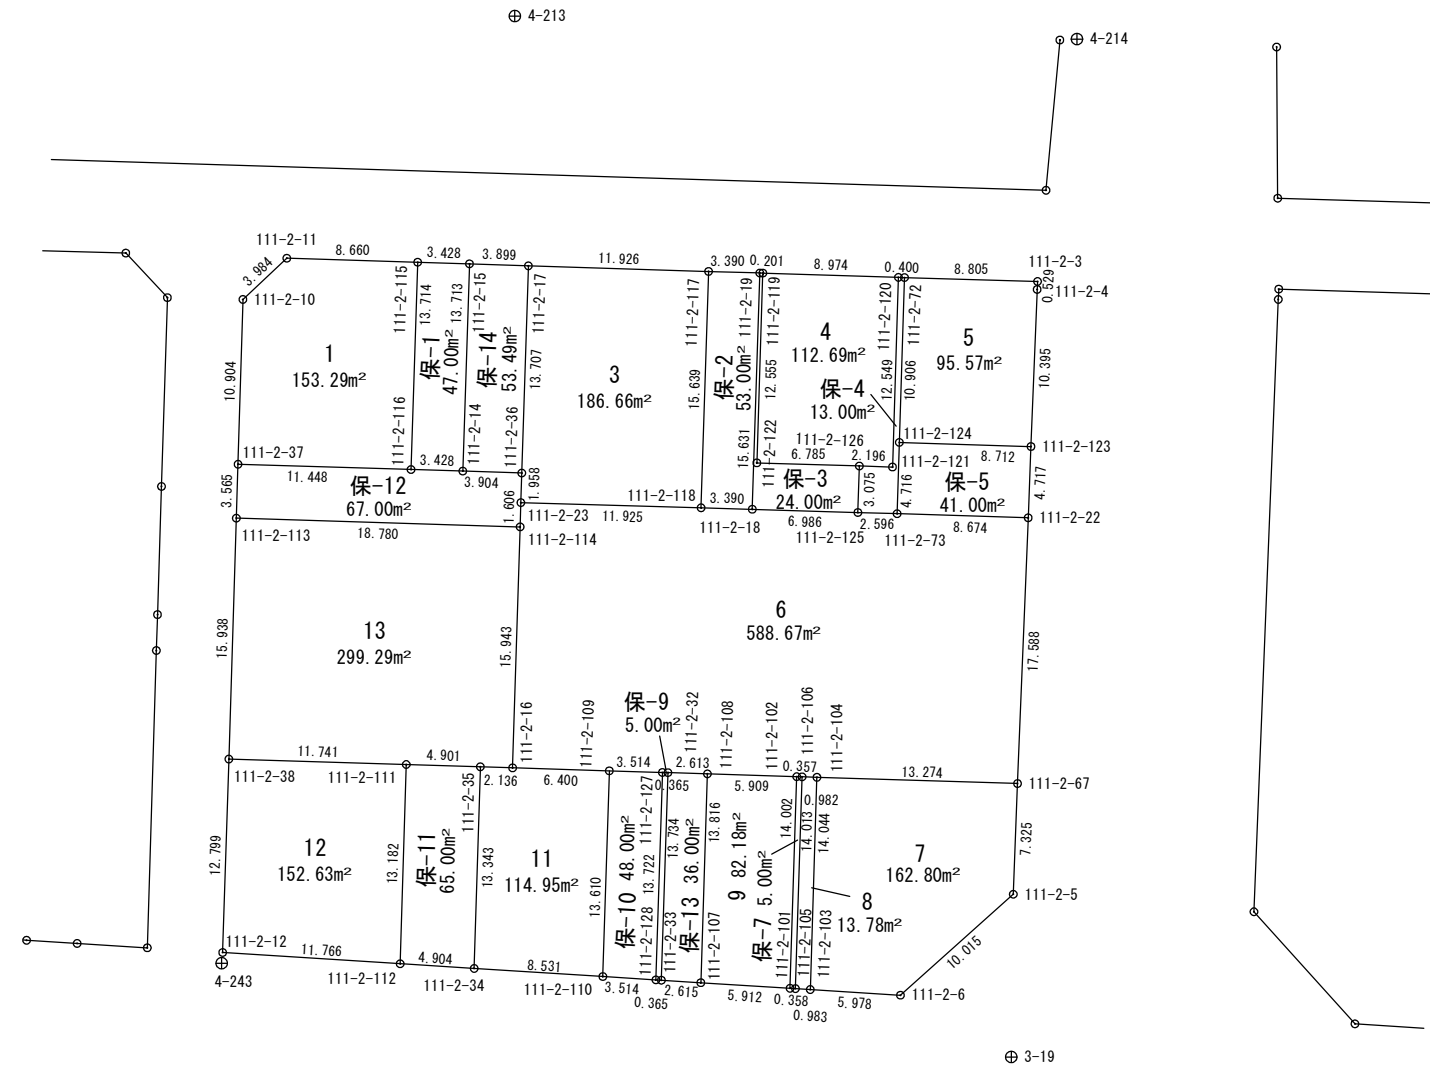

3. 3. 10江田天川大島線

















































