



115街区 画地出来形確認図 (2378.99m²)

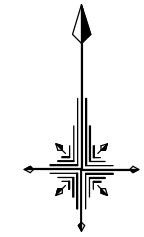

S=1/500

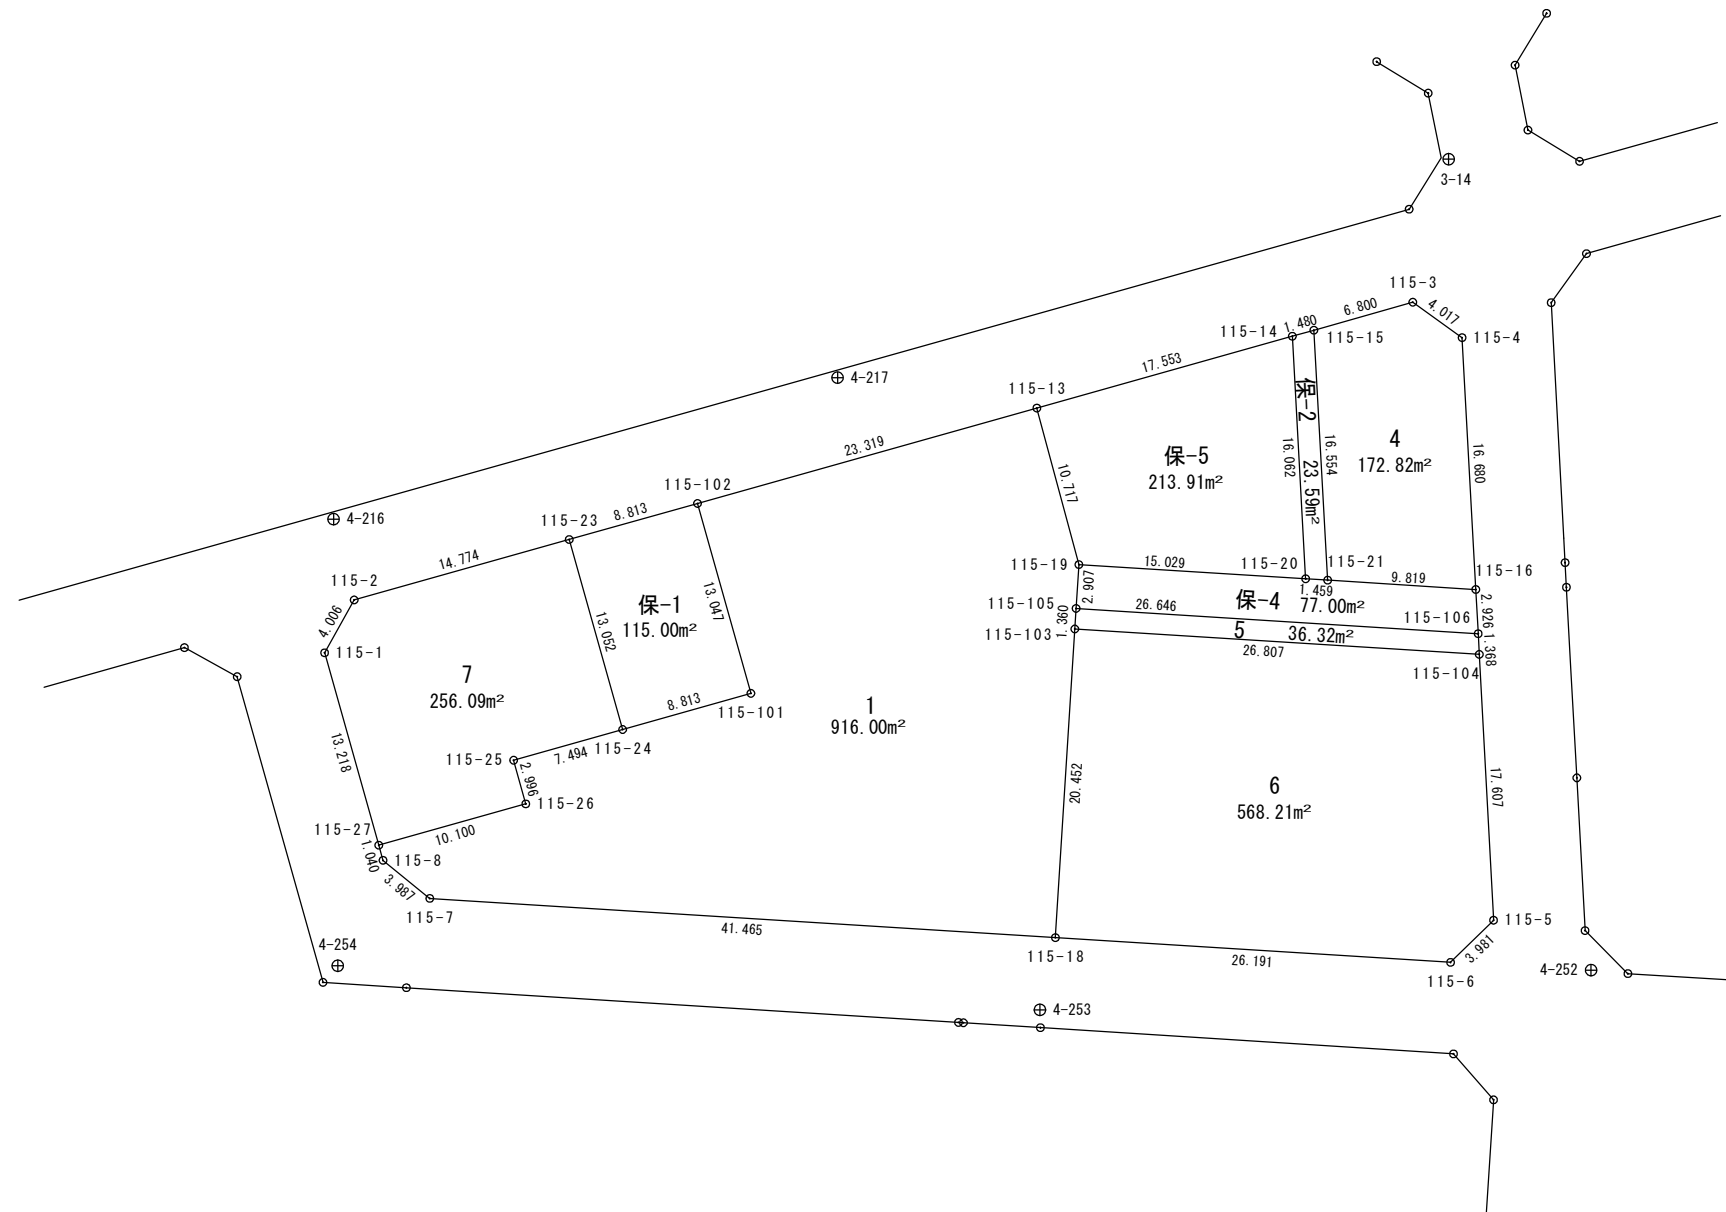


面積計算書（座標法）

世界測地系（測地成果2011）

所 在	地 番	公簿地目	現況地目	地 積	所 有 者
前橋市六供町四丁目	115-6			568.21 m ²	

点 名	X 座標	Y 座標	辺 長	方 向 角	測 角	DX	倍 積 (Y×DX)
115-104	41233.801	-67402.328	26.807	273-35-28	96-39-52	19.261	-1298236.239608
115-103	41235.480	-67429.082	20.452	183-36-08	90-00-40	-18.733	1263148.993106
115-18	41215.068	-67430.367	26.191	93-34-52	89-58-44	-22.048	1486704.731616
115-6	41213.432	-67404.227	3.981	45-34-12	131-59-20	1.151	-77582.265277
115-5	41216.219	-67401.384	17.607	356-55-36	131-21-24	20.369	-1372898.790696
						倍面積	1136.429141
						面 積	568.2145705

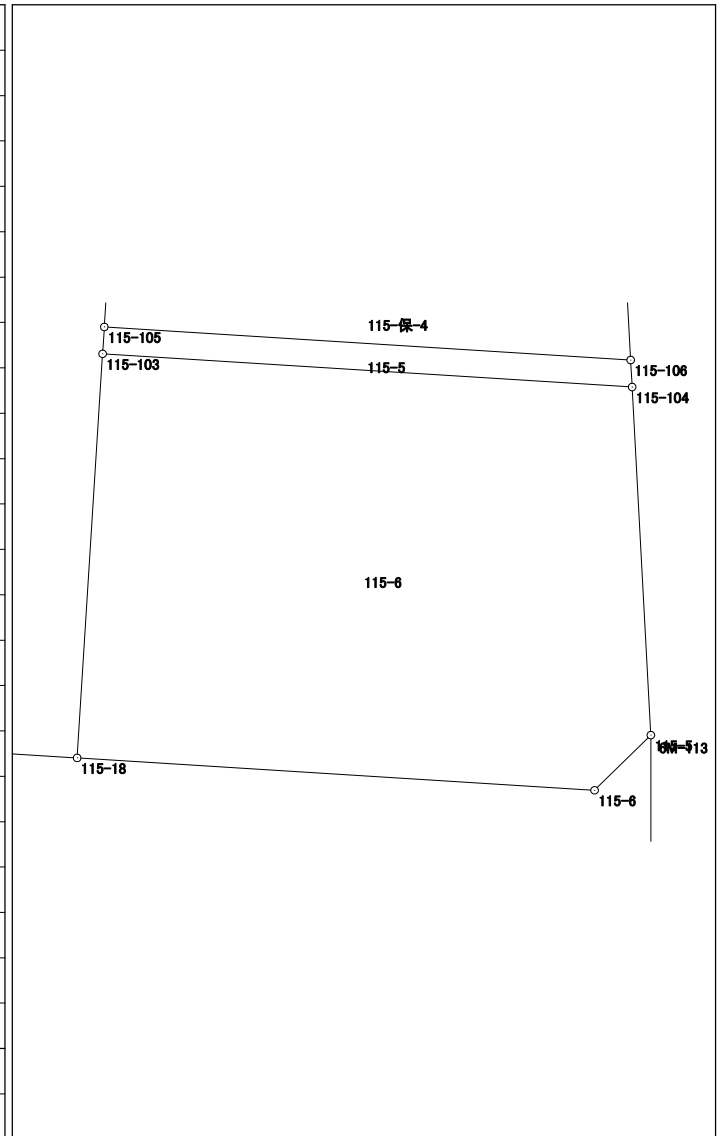

面積計算書（座標法）

世界測地系（測地成果2011）

所 在	地 番	公簿地目	現況地目	地 積	所 有 者
前橋市六供町四丁目	115-保-1			115.00 m ²	

点 名	X 座標	Y 座標	辺 長	方 向 角	測 角	DX	倍 積 (Y×DX)	
115-101	41231.221	-67450.509	13.047	344-17-02	90-01-07	14.949	-1008317.659041	
115-102	41243.780	-67454.043	8.813	254-17-54	90-00-52	10.174	-686277.433482	
115-23	41241.395	-67462.527	13.052	164-17-08	89-59-14	-14.949	1008497.316123	
115-24	41228.831	-67458.992	8.813	74-15-55	89-58-47	-10.174	686327.784608	
							倍面積	230.008208
							面 積	115.0041040

面積計算書 (座標法)

世界測地系 (測地成果2011)

所在	地番	公簿地目	現況地目	地積	所有者
前橋市六供町四丁目	115-保-4			77.00 m ²	

点名	X座標	Y座標	辺長	方向角	測角	DX	倍積 (Y×DX)
115-105	41236.837	-67428.996	26.646	93-35-36	90-00-13	-4.571	308217.940716
115-106	41235.167	-67402.402	2.926	356-56-38	83-21-02	1.252	-84387.807304
115-16	41238.089	-67402.558	9.819	273-36-30	96-39-52	3.540	-238605.055320
115-21	41238.707	-67412.358	1.459	273-39-17	180-02-47	0.711	-47930.186538
115-20	41238.800	-67413.814	15.029	273-34-42	179-55-25	1.031	-69503.642234
115-19	41239.738	-67428.814	2.907	183-35-23	90-00-41	-1.963	132362.761882




倍面積	154.011202
面積	77.0056010

面積計算書（座標法）

世界測地系（測地成果2011）

所 在	地 番	公簿地目	現況地目	地 積	所 有 者
前橋市六供町四丁目	115-保-5			213.91 m ²	

点 名	X 座標	Y 座標	辺 長	方 向 角	測 角	DX	倍 積 (Y×DX)
115-13	41250.088	-67431.593	10.717	164-58-14	90-40-16	-15.100	1018217.054300
115-19	41239.738	-67428.814	15.029	93-34-42	108-36-28	-11.288	761136.452432
115-20	41238.800	-67413.814	16.062	356-51-21	83-16-39	15.100	-1017948.591400
115-14	41254.838	-67414.695	17.553	254-17-58	77-26-37	11.288	-760977.077160

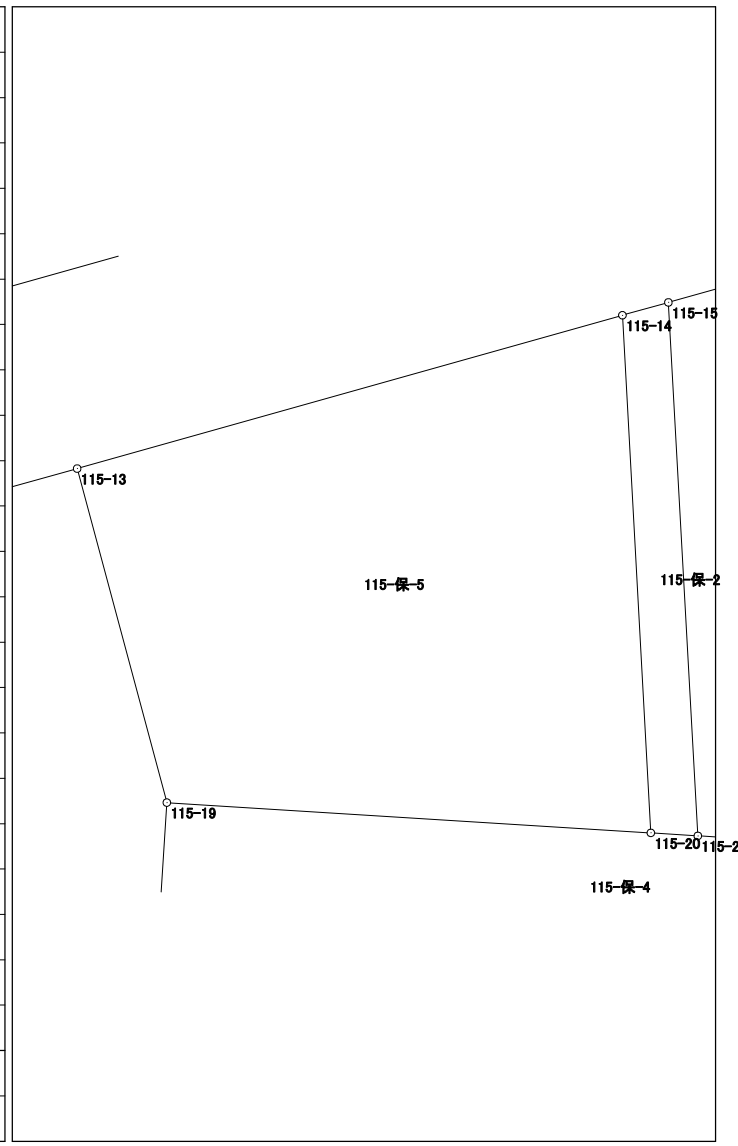

倍面積	427.838172
面 積	213.9190860