


1 1 - 1 街区  
1 1 - 2 街区

# 画地出来形確認図

(1610.04 m<sup>2</sup>)  
(2027.87 m<sup>2</sup>)

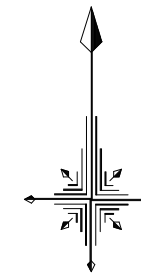

S=1/500




# 面積計算書（座標法）

世界測地系（測地成果2011）

所在	地番	公簿地目	現況地目	地積	所有者
前橋市六供町一丁目	11-1-1			178.47 m <sup>2</sup>	

点名	X座標	Y座標	辺長	方向角	測角	DX	倍積 (Y×DX)
11-1-101	41750.250	-68356.174	13.531	348-13-51	90-01-17	16.003	-1093903.852522
11-1-58	41763.497	-68358.934	10.646	258-12-20	89-58-29	11.071	-756801.758314
11-1-2	41761.321	-68369.355	4.007	213-22-22	135-10-02	-5.522	377535.578310
11-1-1	41757.975	-68371.559	10.706	168-14-23	134-52-01	-13.827	945373.546293
11-1-102	41747.494	-68369.377	13.488	78-12-34	89-58-11	-7.725	528153.437325
						倍面積	356.951092
						面積	178.475460

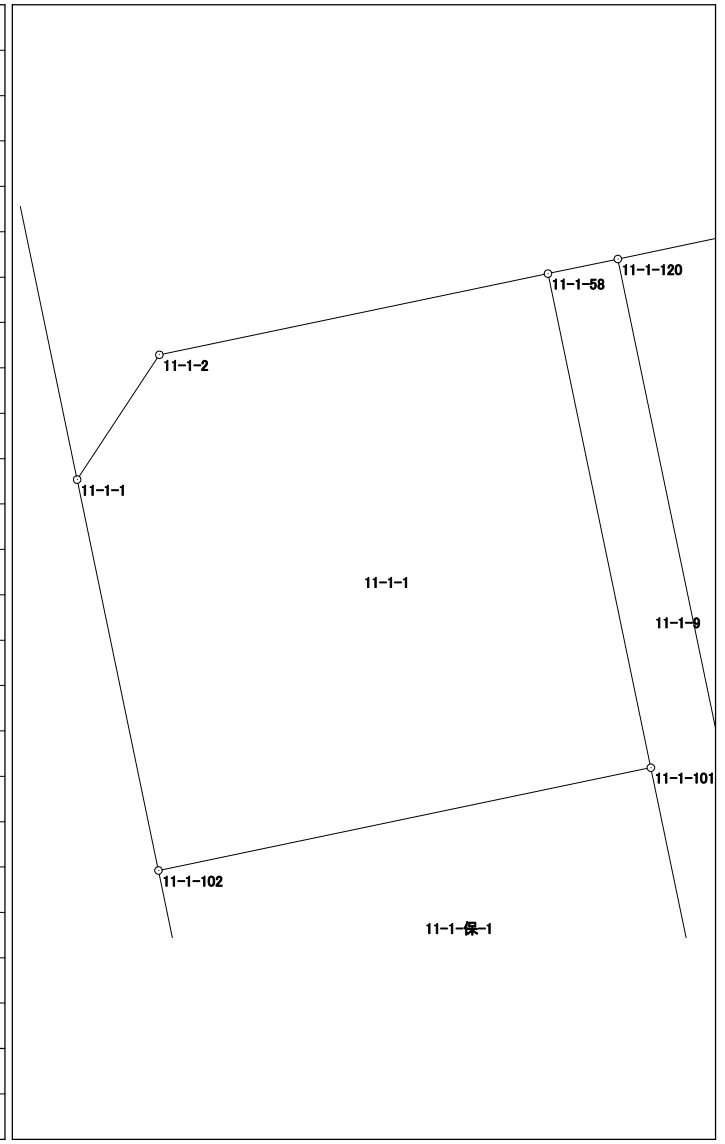






# 面積計算書 (座標法)

世界測地系 (測地成果2011)

所在	地番	公簿地目	現況地目	地積	所有者
前橋市六供町一丁目	11-1-4			202.67 m <sup>2</sup>	

点名	X座標	Y座標	辺長	方向角	測角	DX	倍積 (Y×DX)
11-1-111	41750.201	-68329.890	1.801	78-10-43	89-58-57	-18.183	1242442.389870
11-1-110	41750.570	-68328.127	9.010	78-11-51	180-01-08	2.212	-151141.816924
11-1-26	41752.413	-68319.307	16.824	348-12-43	90-00-52	18.312	-1251063.149784
11-1-17	41768.882	-68322.744	2.998	303-16-55	135-04-12	18.114	-1237598.184816
11-1-16	41770.527	-68325.250	8.700	258-14-03	134-57-08	-0.129	8813.957250
11-1-112	41768.753	-68333.767	18.953	168-11-46	89-57-43	-20.326	1388952.148042

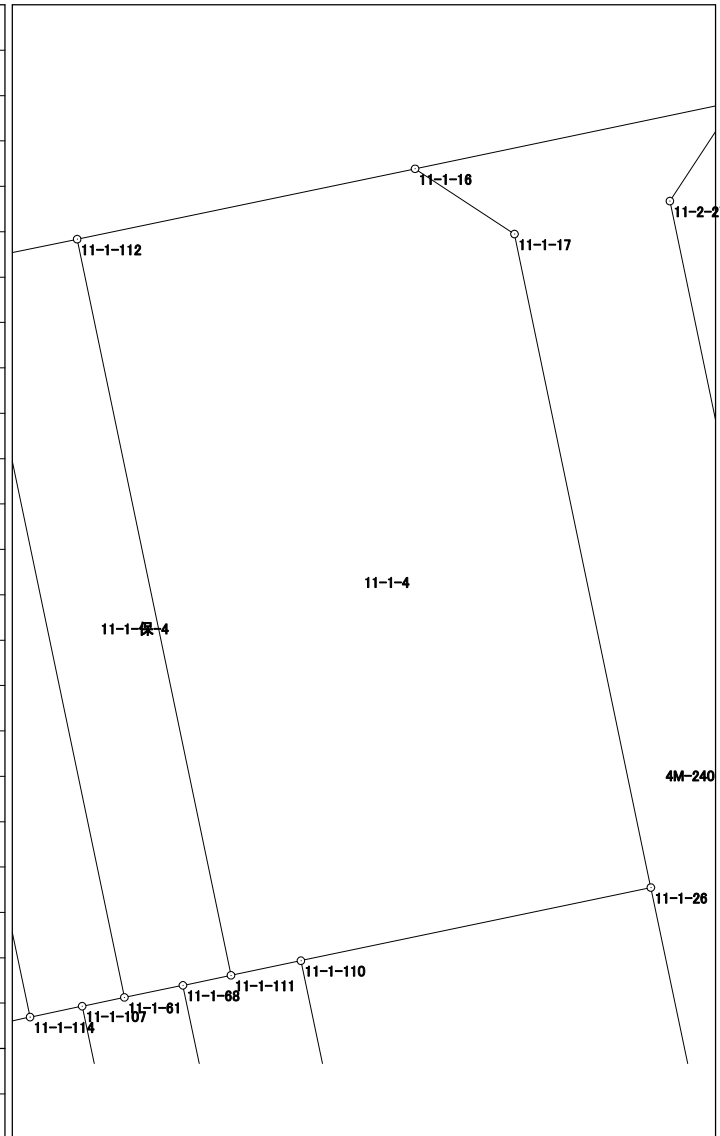

倍面積	405.343638
面積	202.6718190




# 面積計算書（座標法）

世界測地系（測地成果2011）

所 在	地 番	公簿地目	現況地目	地 積	所 有 者
前橋市六供町一丁目	11-1-6			136.60 m <sup>2</sup>	

点 名	X 座標	Y 座標	辺 長	方 向 角	測 角	DX	倍 積 (Y×DX)
11-1-107	41749.423	-68333.641	1.341	258-12-45	90-01-04	12.936	-883963.979976
11-1-114	41749.149	-68334.954	8.785	258-13-01	180-00-16	-2.068	141316.684872
11-1-66	41747.355	-68343.554	13.485	168-11-24	89-58-23	-14.994	1024743.248676
11-1-65	41734.155	-68340.794	10.125	78-16-22	90-04-58	-11.142	761453.126748
11-1-108	41736.213	-68330.880	13.495	348-11-41	89-55-19	15.268	-1043275.875840
						倍面積	273.204480
						面 積	136.6022400

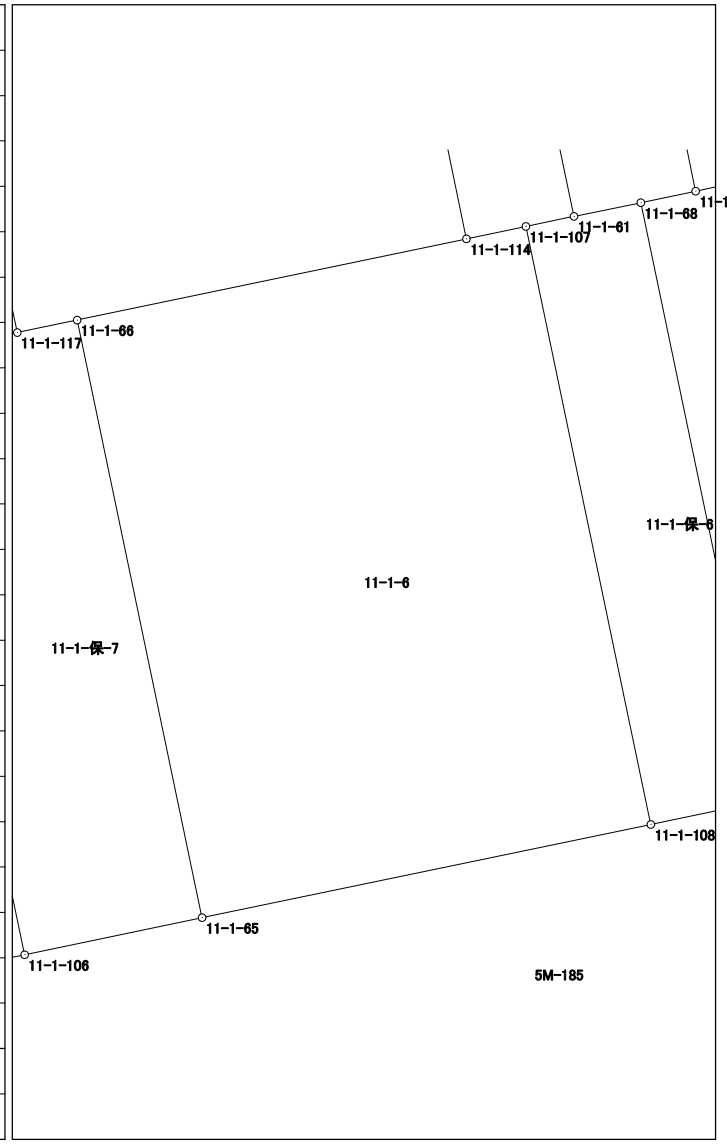








# 面積計算書 (座標法)

世界測地系 (測地成果2011)

所在	地番	公簿地目	現況地目	地積	所有者
前橋市六供町一丁目	11-1-9			36.30 m <sup>2</sup>	

点名	X座標	Y座標	辺長	方向角	測角	DX	倍積 (Y×DX)
11-1-101	41750.250	-68356.174	5.410	168-13-29	179-59-38	-18.543	1267528.534482
11-1-57	41744.954	-68355.070	1.916	78-13-37	90-00-08	-4.905	335281.618350
11-1-119	41745.345	-68353.194	18.942	348-13-47	90-00-10	18.935	-1294267.728390
11-1-120	41763.889	-68357.058	1.917	258-11-51	89-58-04	18.152	-1240817.316816
11-1-58	41763.497	-68358.934	13.531	168-13-51	90-02-00	-13.639	932347.500826
						倍面積	72.608452
						面積	36.3042260

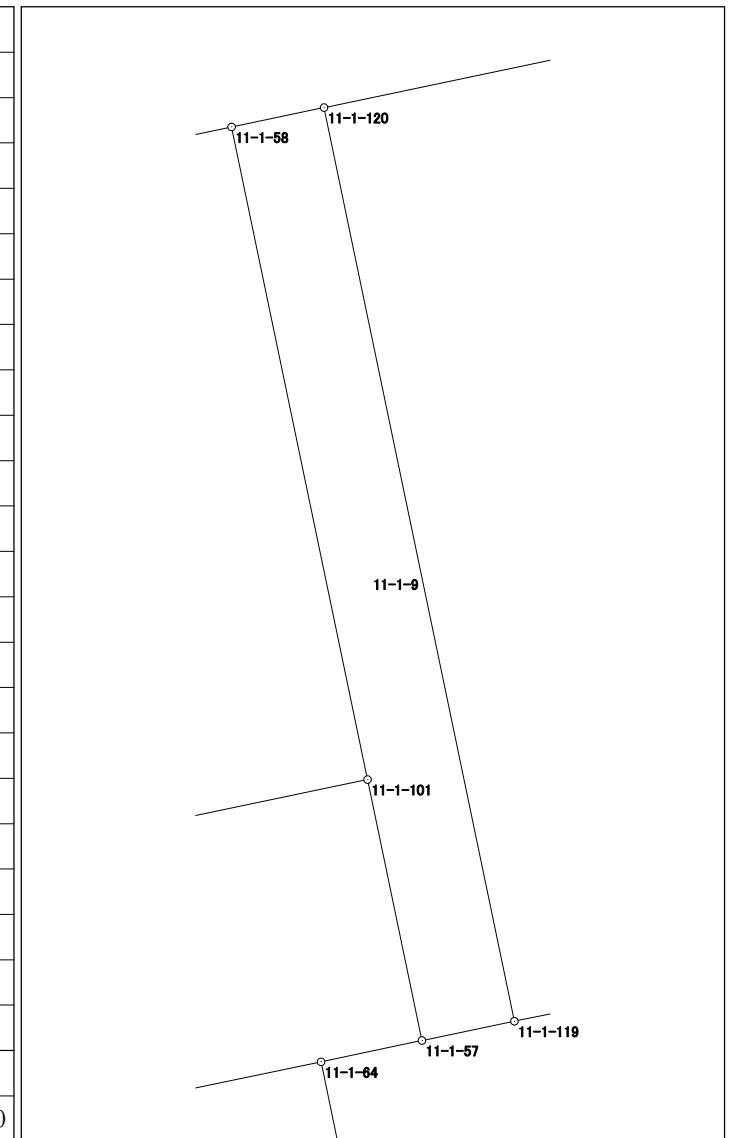




# 面積計算書（座標法）

世界測地系（測地成果2011）

所 在	地 番	公簿地目	現況地目	地 積	所 有 者
前橋市六供町一丁目	11-1-保-2			42.00 m <sup>2</sup>	

点 名	X 座標	Y 座標	辺 長	方 向 角	測 角	DX	倍 積 (Y×DX)
11-1-116	41765.173	-68350.911	18.944	168-13-41	90-00-51	-18.999	1298598.958089
11-1-115	41746.627	-68347.046	2.217	78-14-02	90-00-21	-18.094	1236671.450324
11-1-117	41747.079	-68344.876	18.945	348-13-54	89-59-52	18.999	-1298484.299124
11-1-118	41765.626	-68348.740	2.218	258-12-50	89-58-56	18.094	-1236702.101560
						倍面積	84.007729
						面 積	42.0038645

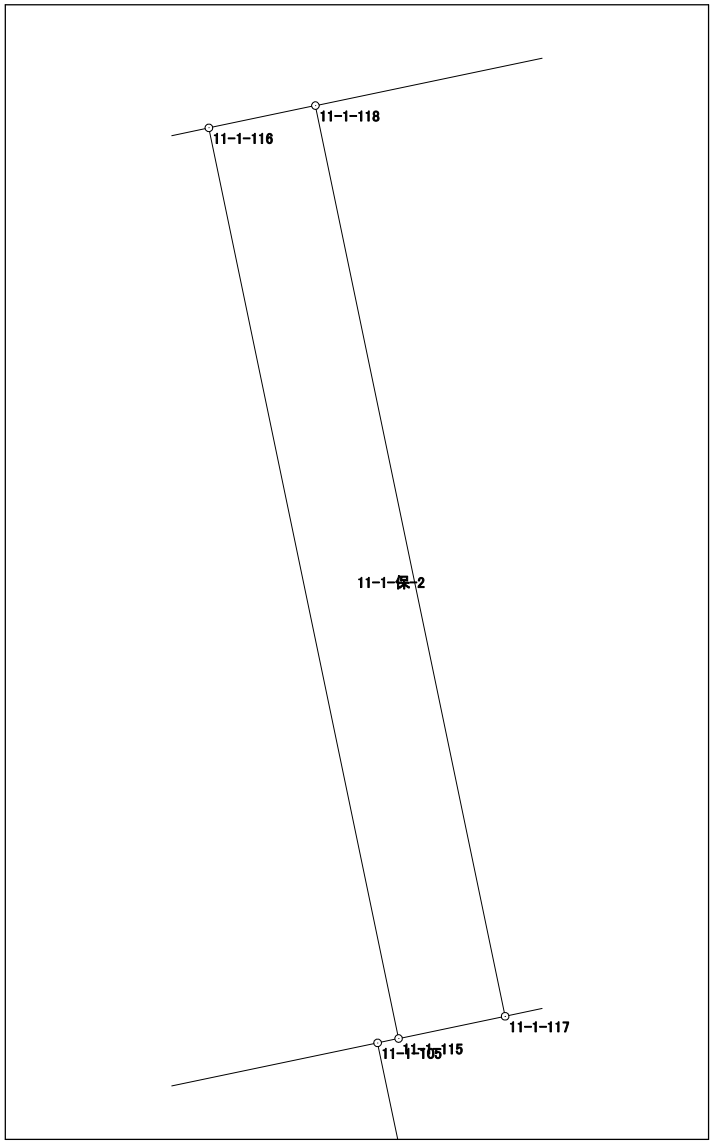




# 面積計算書 (座標法)

世界測地系 (測地成果2011)

所 在	地 番	公簿地目	現況地目	地 積	所 有 者
前橋市六供町一丁目	11-1-保-4			52.00 m <sup>2</sup>	

点 名	X 座標	Y 座標	辺 長	方 向 角	測 角	DX	倍 積 (Y×DX)
11-1-61	41749.645	-68332.577	1.507	78-23-57	90-12-07	-18.246	1246796.199942
11-1-68	41749.948	-68331.101	1.237	78-11-59	179-48-02	0.556	-37992.092156
11-1-111	41750.201	-68329.890	18.953	348-11-46	89-59-47	18.805	-1284943.581450
11-1-112	41768.753	-68333.767	2.744	258-14-37	90-02-51	17.993	-1229529.469631
11-1-62	41768.194	-68336.453	18.950	168-11-50	89-57-13	-19.108	1305772.943924
倍面積						104.000629	
面 積						52.0003145	

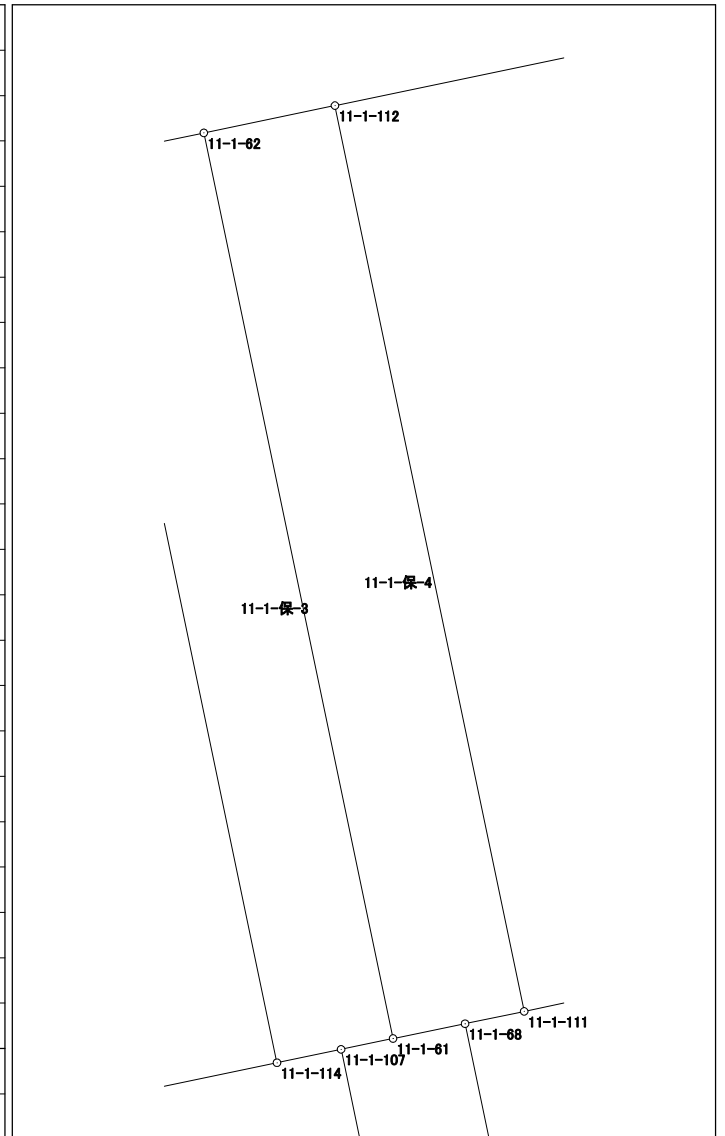


# 面積計算書 (座標法)

世界測地系 (測地成果2011)

所在	地番	公簿地目	現況地目	地積	所有者
前橋市六供町一丁目	11-1-保-5			41.00 m <sup>2</sup>	

点名	X座標	Y座標	辺長	方向角	測角	DX	倍積 (Y×DX)
11-1-67	41736.740	-68328.340	3.039	78-13-40	90-02-06	-12.588	860117.143920
11-1-109	41737.360	-68325.365	13.496	348-11-26	89-57-46	13.830	-944939.797950
11-1-110	41750.570	-68328.127	1.801	258-10-43	89-59-17	12.841	-877401.478807
11-1-111	41750.201	-68329.890	1.237	258-11-59	180-01-16	-0.622	42501.191580
11-1-68	41749.948	-68331.101	13.493	168-11-34	89-59-35	-13.461	919804.950561
						倍面積	82.009304
						面積	41.0046520

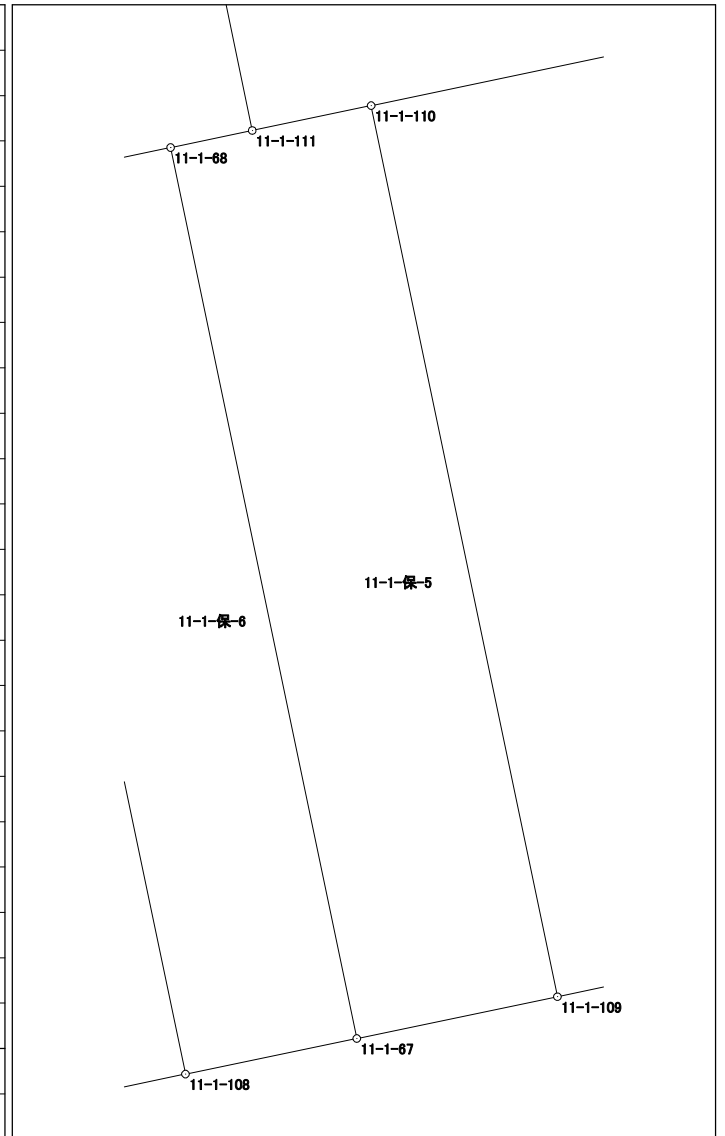





# 面積計算書（座標法）

世界測地系（測地成果2011）

所 在	地 番	公簿地目	現況地目	地 積	所 有 者
前橋市六供町一丁目	11-1-保-7			54.00 m <sup>2</sup>	

点 名	X 座標	Y 座標	辺 長	方 向 角	測 角	DX	倍 積 (Y×DX)
11-1-66	41747.355	-68343.554	1.351	258-12-27	90-01-03	12.924	-883272.091896
11-1-117	41747.079	-68344.876	2.217	258-14-02	180-01-35	-0.728	49755.069728
11-1-115	41746.627	-68347.046	0.437	258-15-11	180-01-09	-0.541	36975.751886
11-1-105	41746.538	-68347.474	13.487	168-11-31	89-56-20	-13.291	908406.276934
11-1-106	41733.336	-68344.714	4.005	78-11-57	90-00-26	-12.383	846312.593462
11-1-65	41734.155	-68340.794	13.485	348-11-24	89-59-27	14.019	-958069.591086
						倍面積	108.009028
						面 積	54.0045140

