

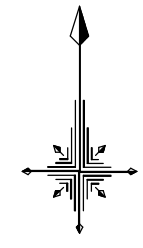


122街区 画地出来形確認図 (1900.57m²)

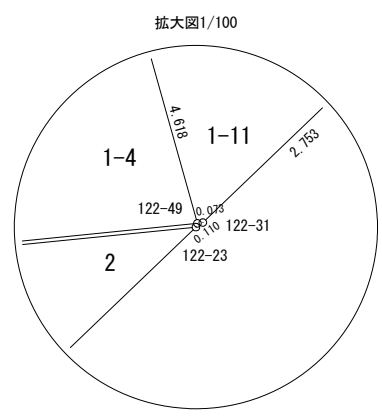

S=1/500

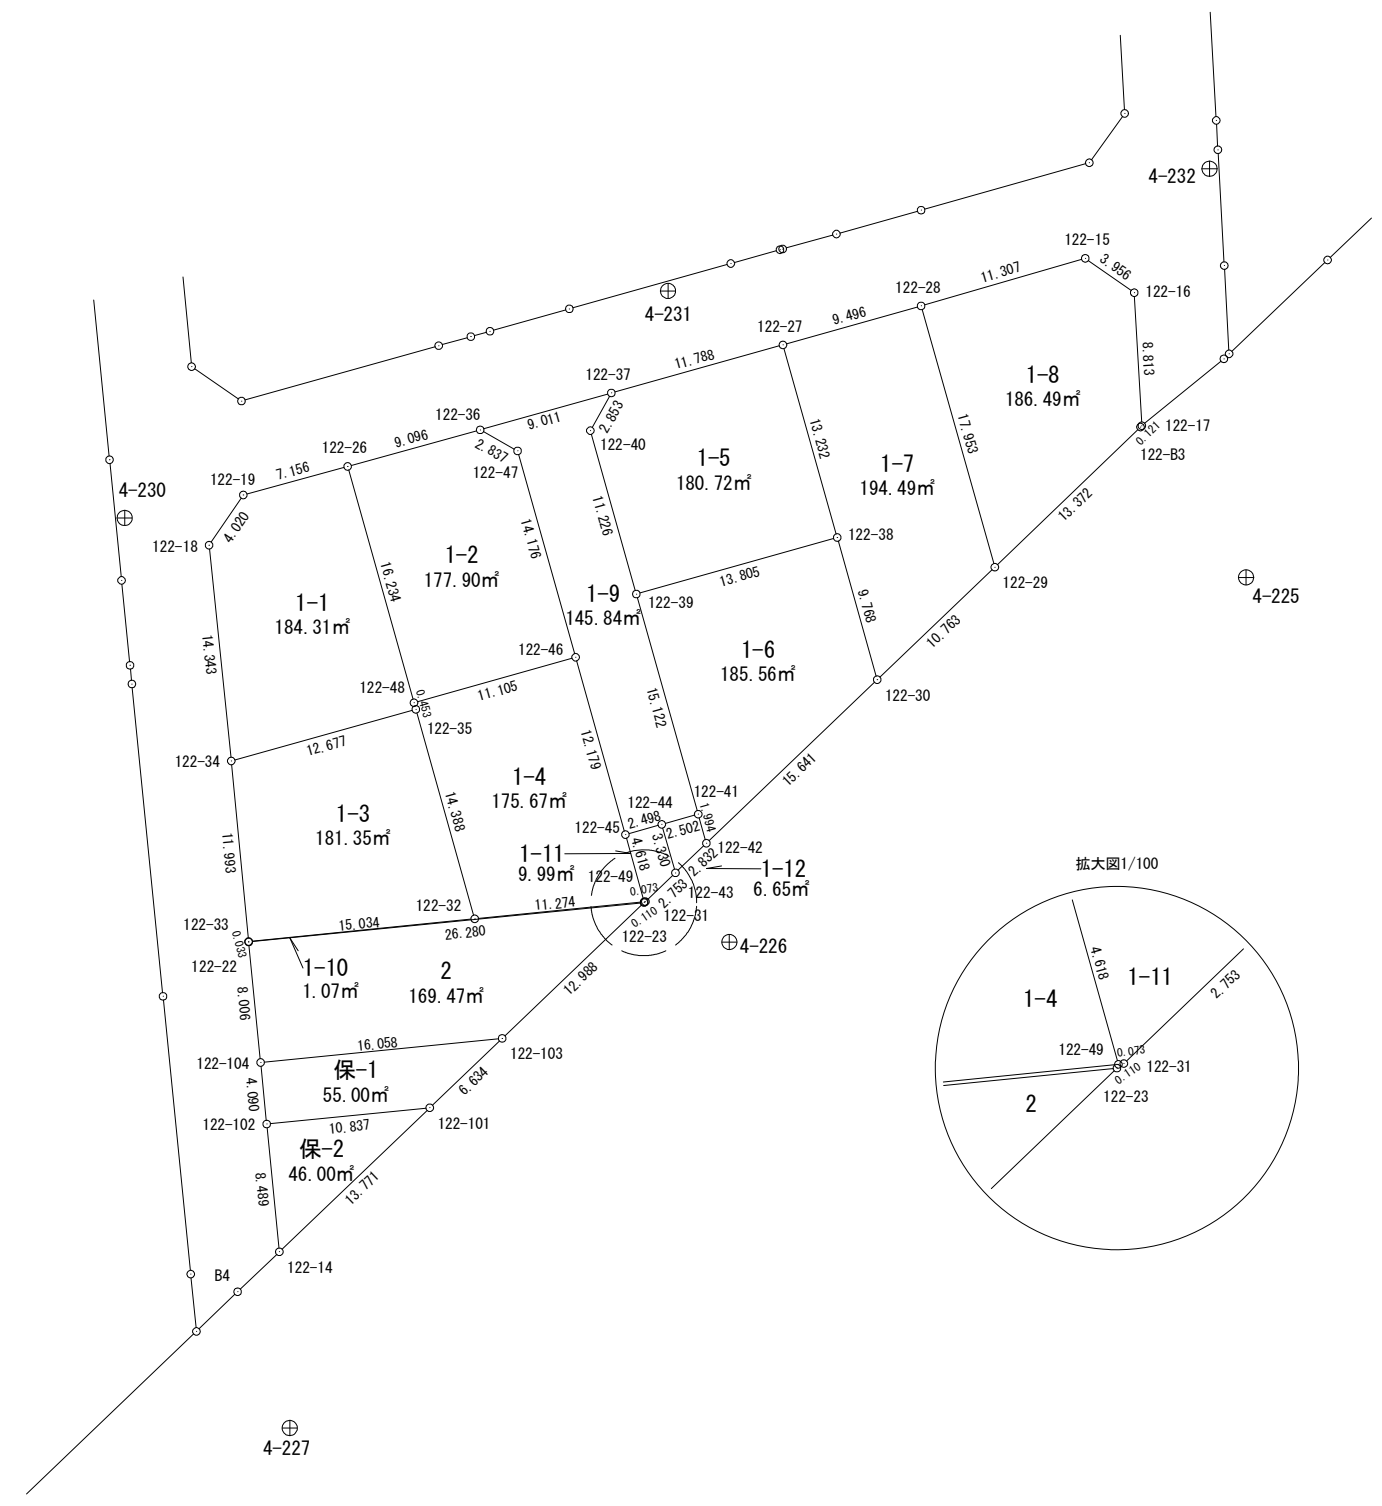

面積計算書（座標法）

世界測地系（測地成果2011）

所 在	地 番	公簿地目	現況地目	地 積	所 有 者
前橋市天川原町二丁目	122-1-8			186.49 m ²	

点 名	X 座標	Y 座標	辺 長	方 向 角	測 角	DX	倍 積 (Y×DX)
122-28	41289.531	-67154.260	17.953	164-14-26	90-24-04	-20.425	1371625.760500
122-29	41272.253	-67149.384	13.372	46-06-43	61-52-17	-8.008	537732.267072
122-B3	41281.523	-67139.747	0.121	46-00-18	179-53-35	9.354	-628025.193438
122-17	41281.607	-67139.660	8.813	356-44-28	130-44-10	8.883	-596401.599780
122-16	41290.406	-67140.161	3.956	305-02-52	128-18-24	11.071	-743308.722431
122-15	41292.678	-67143.400	11.307	253-50-22	128-47-30	-0.875	58750.475000
倍面積							372.986923
面 積							186.4934615

