



130街区 画地出来形確認図(1809.55m²)

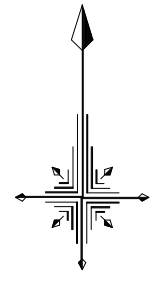

S=1/500

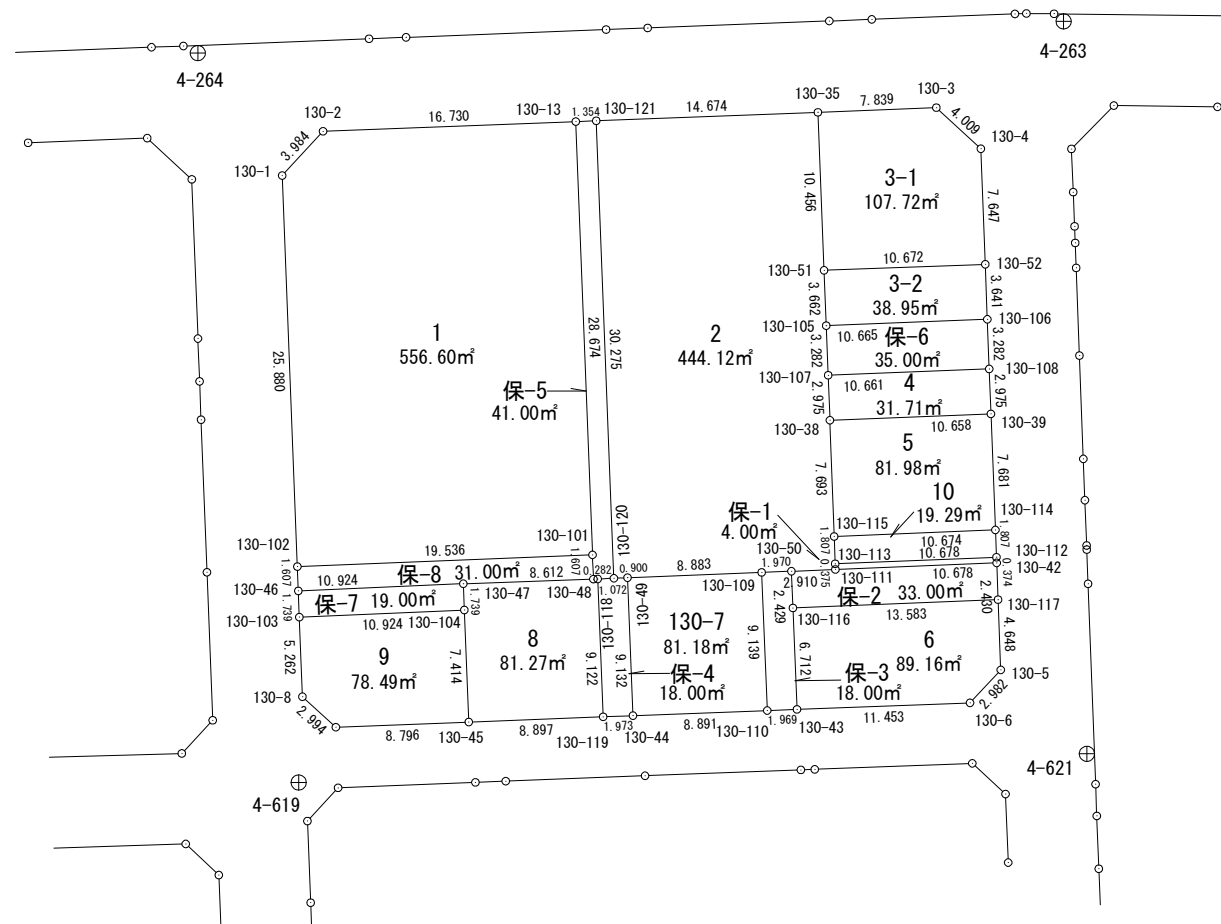

面積計算書 (座標法)

世界測地系 (測地成果2011)

所 在	地 番	公簿地目	現況地目	地 積	所 有 者
前橋市六供町五丁目	130-保-3			18.00 m ²	

点 名	X 座標	Y 座標	辺 長	方 向 角	測 角	DX	倍 積 (Y×DX)
130-43	41068.961	-67467.511	6.712	357-41-10	89-52-07	6.782	-457564.659602
130-116	41075.668	-67467.782	2.429	357-41-16	180-00-06	9.134	-616250.720788
130-50	41078.095	-67467.880	1.970	267-45-34	90-04-18	2.350	-158549.518000
130-109	41078.018	-67469.848	9.139	177-41-10	89-55-36	-9.209	621329.830232
130-110	41068.886	-67469.479	1.969	87-49-03	90-07-53	-9.057	611071.071303
						倍面積	36.003145
						面 積	18.0015725

