



# 139街区 画地出来形確認図 (8631.96m<sup>2</sup>)

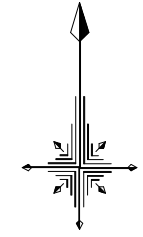

1/500

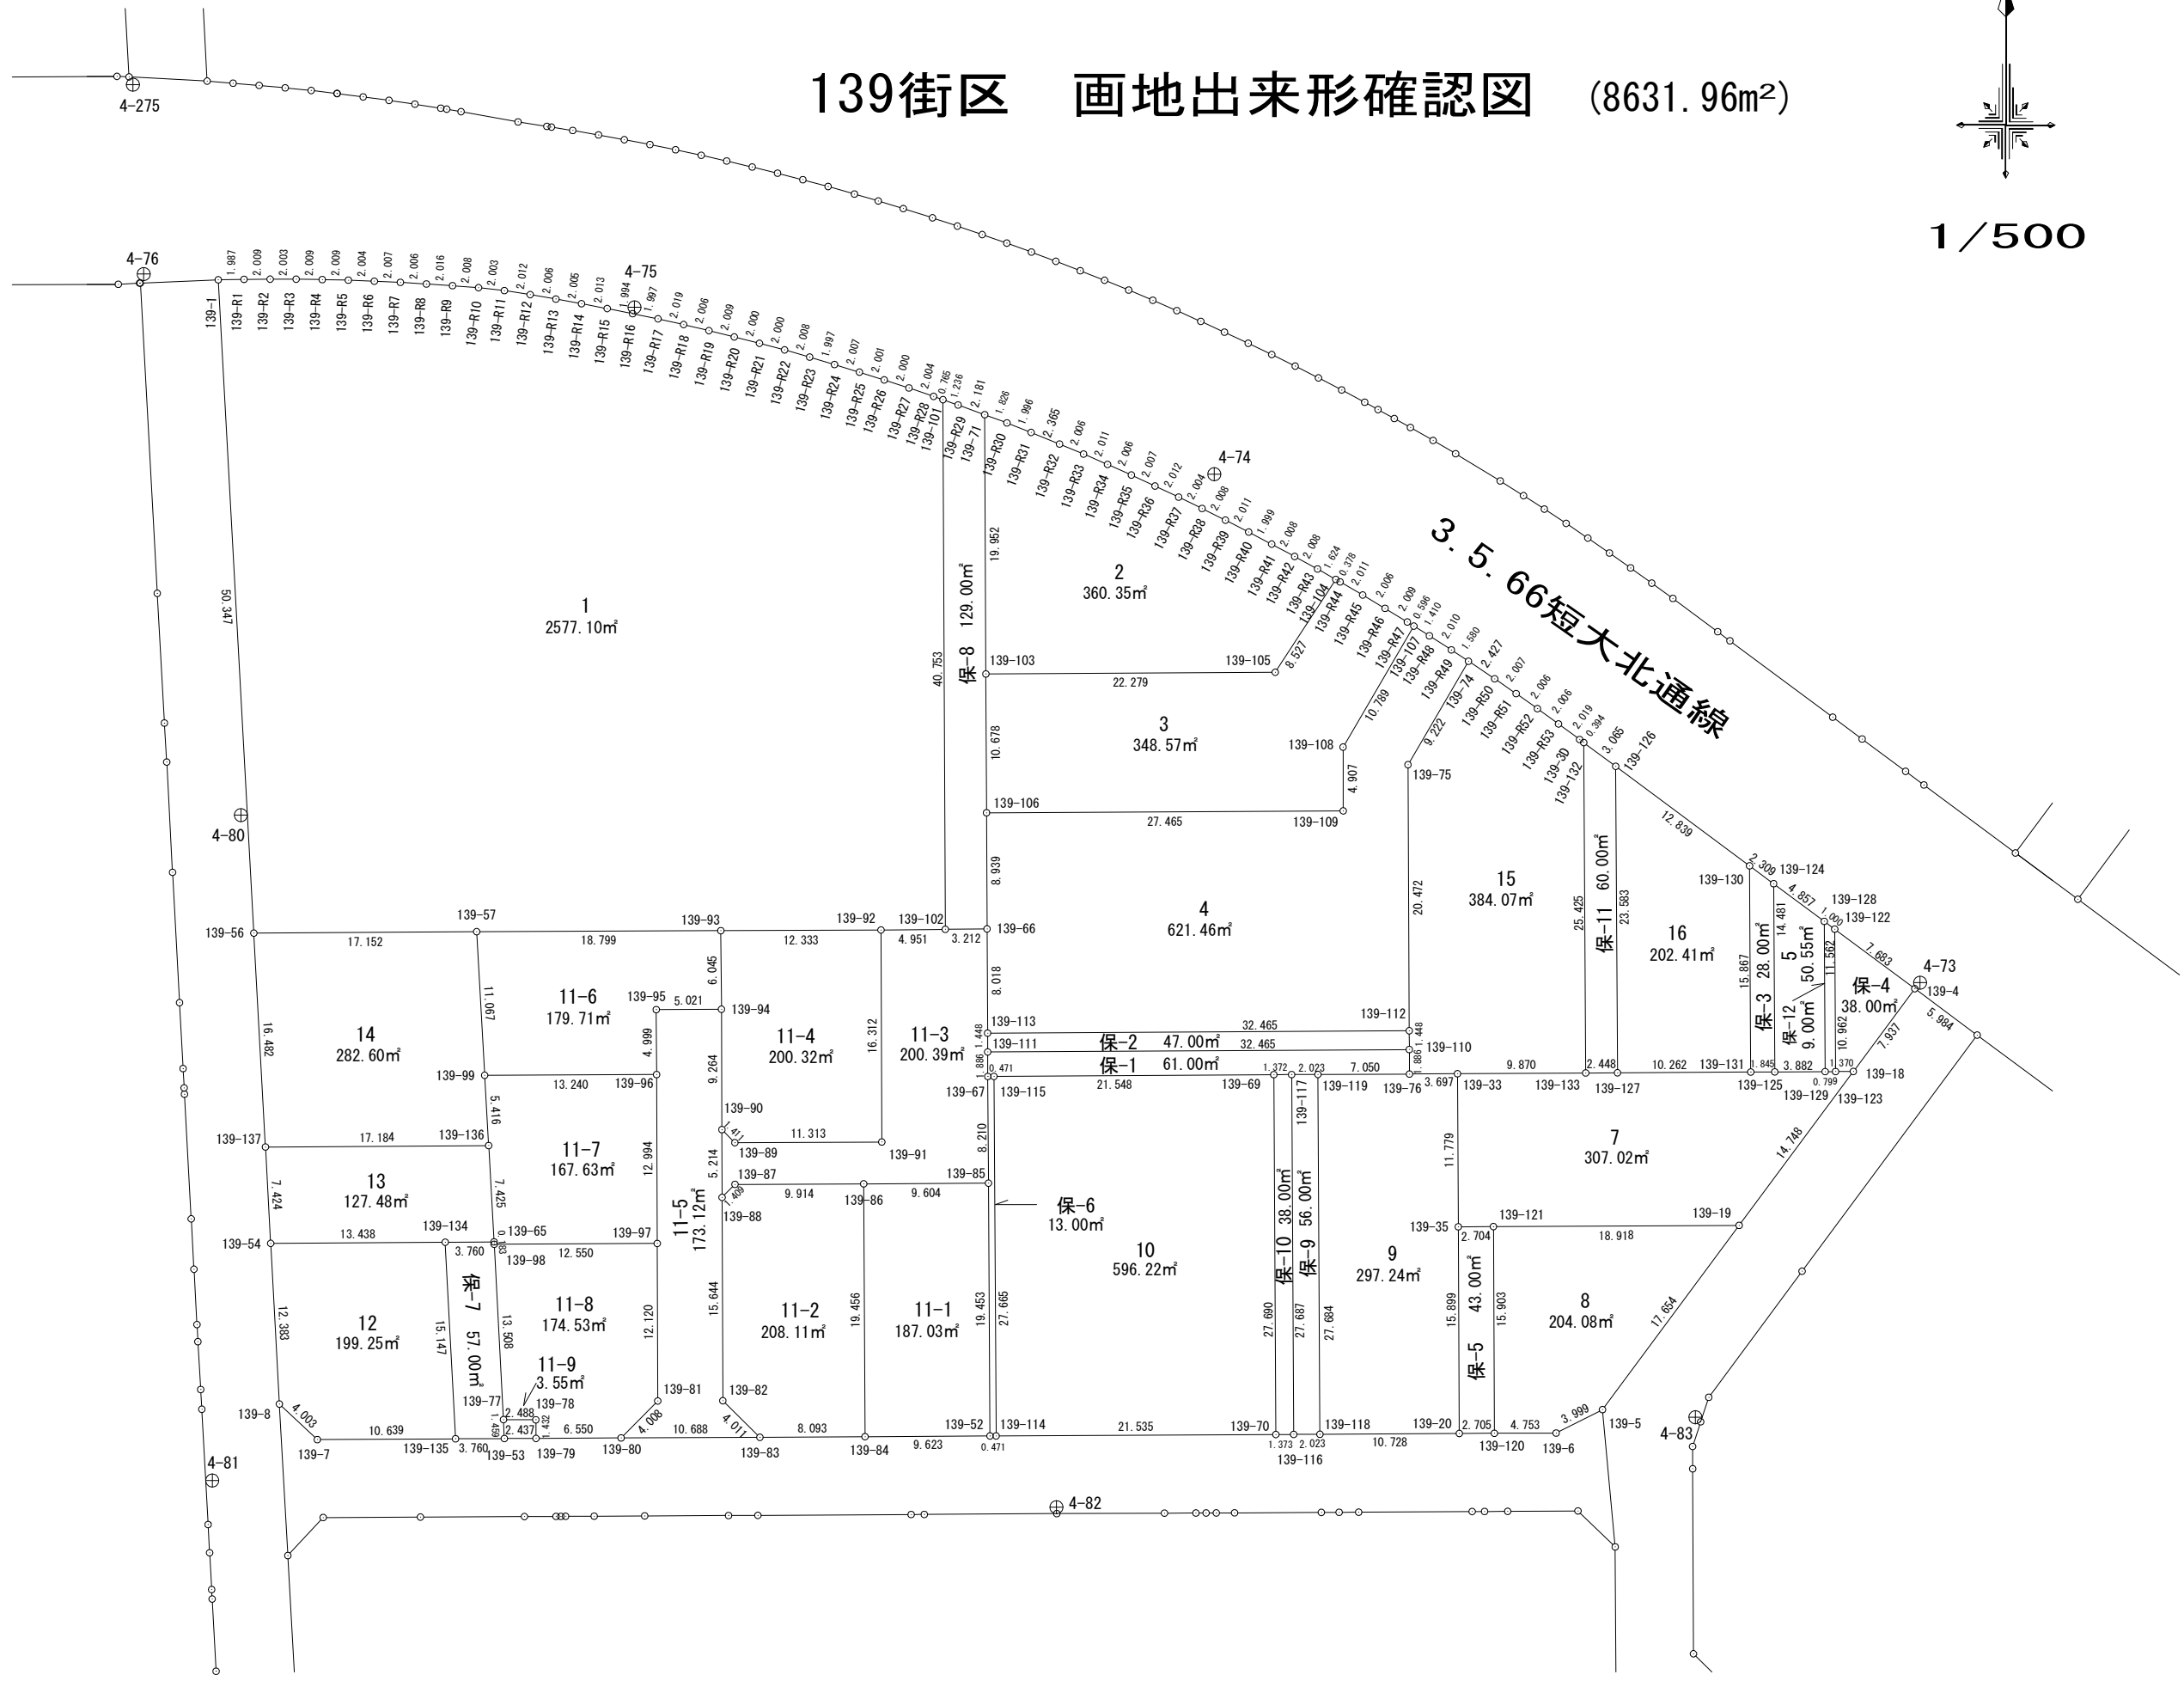


# 面積計算書 (座標法)

世界測地系 (測地成果2011)

所在	地番	公簿地目	現況地目	地積	所有者
前橋市六供町五丁目	139-1			2577.10 m <sup>2</sup>	

点名	X座標	Y座標	辺長	方向角	測角	DX	倍積 (Y×DX)
139-102	40924.447	-67718.257	40.753	359-44-39	90-20-04	40.804	-2763175.758628
139-101	40965.200	-67718.439	0.765	289-32-53	109-48-14	41.009	-2777065.464951
139-R28	40965.456	-67719.160	2.004	288-52-08	179-19-15	0.904	-61218.120640
139-R27	40966.104	-67721.056	2.000	288-00-00	179-07-52	1.266	-85734.856896
139-R26	40966.722	-67722.958	2.001	287-23-05	179-23-05	1.216	-82351.116928
139-R25	40967.320	-67724.868	2.007	286-58-21	179-35-16	1.184	-80186.243712
139-R24	40967.906	-67726.788	1.997	286-42-07	179-43-46	1.160	-78563.074080
139-R23	40968.480	-67728.701	2.008	285-59-19	179-17-12	1.127	-76330.246027
139-R22	40969.033	-67730.631	2.000	284-40-56	178-41-37	1.060	-71794.468860
139-R21	40969.540	-67732.566	2.000	284-10-56	179-30-00	0.997	-67529.368302
139-R20	40970.030	-67734.505	2.009	283-58-02	179-47-06	0.975	-66041.142375
139-R19	40970.515	-67736.455	2.006	283-31-25	179-33-23	0.954	-64620.578070
139-R18	40970.984	-67738.405	2.019	282-33-23	179-01-58	0.908	-61506.471740
139-R17	40971.423	-67740.376	1.997	281-29-44	178-56-21	0.837	-56698.694712
139-R16	40971.821	-67742.333	1.994	281-21-59	179-52-15	0.791	-53584.185403
139-R15	40972.214	-67744.288	2.013	280-40-45	179-18-46	0.766	-51892.124608
139-R14	40972.587	-67746.266	2.005	280-15-23	179-34-38	0.730	-49454.774180
139-R13	40972.944	-67748.239	2.006	279-48-52	179-33-29	0.699	-47356.019061
139-R12	40973.286	-67750.216	2.012	278-46-43	178-57-51	0.649	-43969.890184
139-R11	40973.593	-67752.204	2.003	276-28-45	177-42-02	0.533	-36111.924732
139-R10	40973.819	-67754.194	2.008	274-23-55	177-55-10	0.380	-25746.593720
139-R9	40973.973	-67756.196	2.016	273-41-49	179-17-54	0.284	-19242.759664

倍面積	
面積	

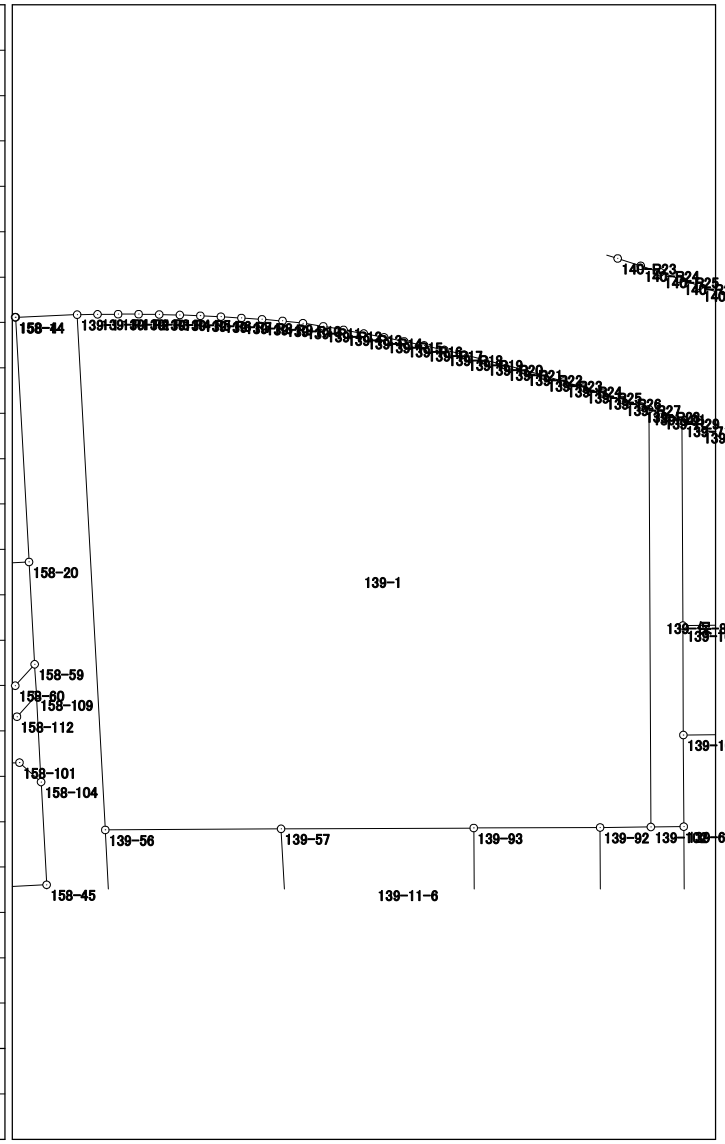




# 面積計算書 (座標法)

世界測地系 (測地成果2011)

所在	地番	公簿地目	現況地目	地積	所有者
前橋市六供町五丁目	139-2			360.35 m <sup>2</sup>	

点名	X座標	Y座標	辺長	方向角	測角	DX	倍積 (Y×DX)
139-71	40964.047	-67715.222	19.952	179-44-40	69-25-25	-19.318	1308122.658596
139-103	40944.095	-67715.133	22.279	89-39-19	89-54-39	-19.818	1341978.505794
139-105	40944.229	-67692.854	8.527	33-09-05	123-29-46	7.273	-492330.127142
139-104	40951.368	-67688.191	1.624	299-48-06	86-39-01	7.946	-537850.365686
139-R43	40952.175	-67689.600	2.008	298-41-49	178-53-43	1.771	-119878.281600
139-R42	40953.139	-67691.361	2.008	298-15-44	179-33-55	1.915	-129628.956315
139-R41	40954.090	-67693.130	1.999	297-39-16	179-23-32	1.879	-127195.391270
139-R40	40955.018	-67694.901	2.011	297-06-01	179-26-45	1.844	-124829.397444
139-R39	40955.934	-67696.691	2.008	296-28-33	179-22-32	1.811	-122598.707401
139-R38	40956.829	-67698.488	2.004	295-53-15	179-24-42	1.770	-119826.323760
139-R37	40957.704	-67700.291	2.012	295-09-04	179-15-49	1.730	-117121.503430
139-R36	40958.559	-67702.112	2.007	294-52-01	179-42-57	1.699	-115025.888288
139-R35	40959.403	-67703.933	2.006	293-59-50	179-07-49	1.660	-112388.528780
139-R34	40960.219	-67705.766	2.011	293-21-07	179-21-17	1.613	-109209.400558
139-R33	40961.016	-67707.612	2.006	292-39-58	179-18-51	1.570	-106300.950840
139-R32	40961.789	-67709.463	2.365	292-12-55	179-32-57	1.667	-112871.674821
139-R31	40962.683	-67711.652	1.996	291-26-59	179-14-04	1.624	-109963.722848
139-R30	40963.413	-67713.510	1.826	290-19-15	178-52-16	1.364	-92361.227640

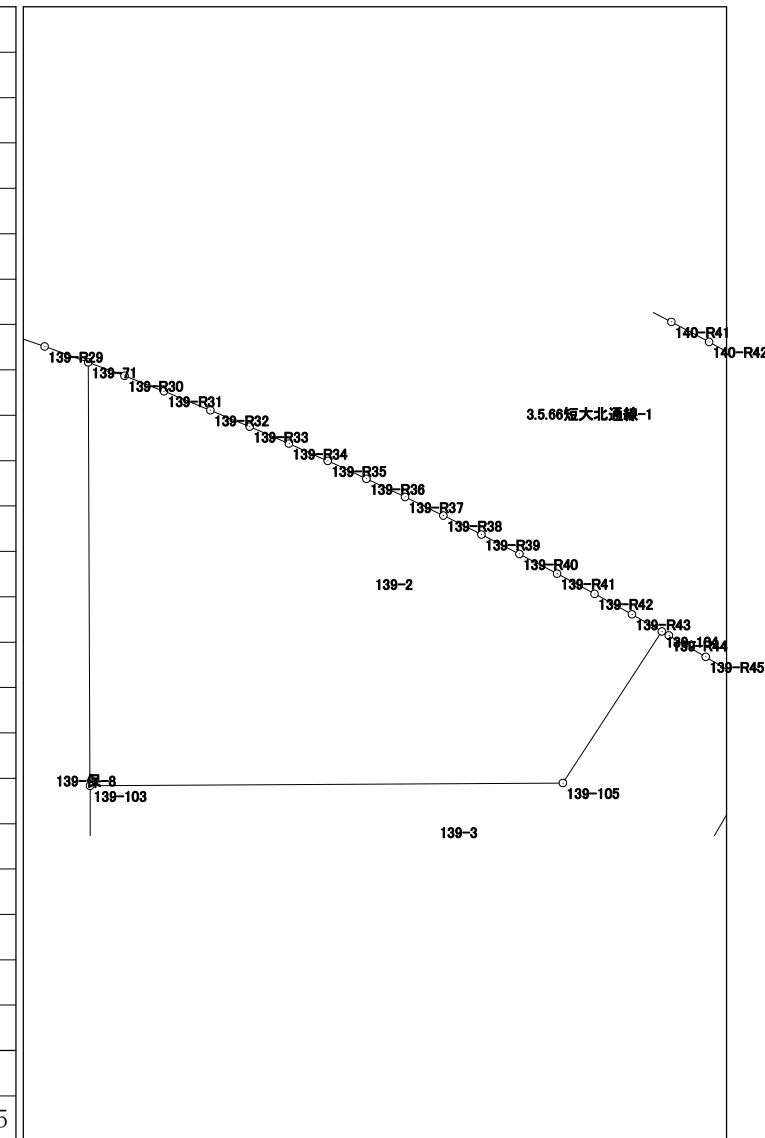

倍面積	720.716567
面積	360.3582835









































































