


13街区 画地出来形確認図 (1400.62m²)

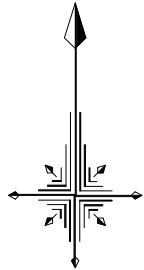

S=1/500




面積計算書 (座標法)

世界測地系 (測地成果2011)

所在	地番	公簿地目	現況地目	地積	所有者
前橋市六供町一丁目	13-1			96.86 m ²	

点名	X座標	Y座標	辺長	方向角	測角	DX	倍積 (Y×DX)
13-201	41695.373	-68399.639	10.546	348-17-10	89-57-01	12.192	-833928.398688
13-28	41705.699	-68401.780	9.150	258-16-17	89-59-07	8.466	-579089.469480
13-51	41703.839	-68410.739	10.536	168-43-08	90-26-51	-12.192	834063.729888
13-202	41693.507	-68408.678	9.230	78-20-09	89-37-01	-8.466	579147.867948
						倍面積	193.729668
						面積	96.8648340

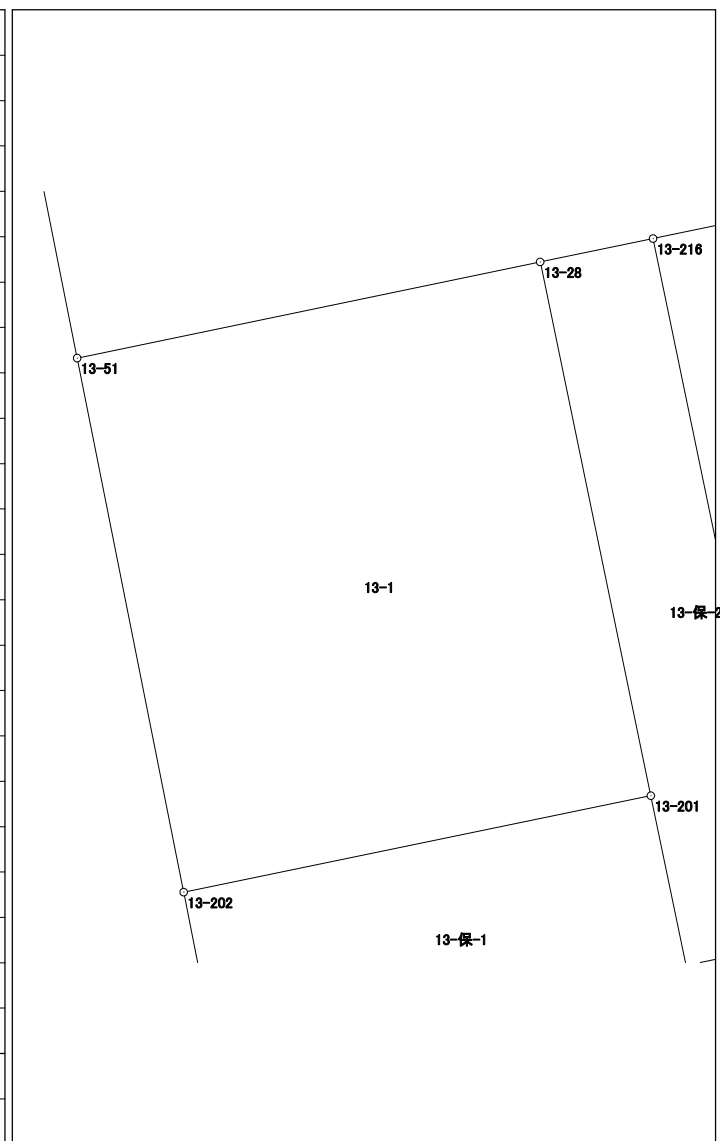


面積計算書 (座標法)

世界測地系 (測地成果2011)

所在	地番	公簿地目	現況地目	地積	所有者
前橋市六供町一丁目	13-2			197.32 m ²	

点名	X座標	Y座標	辺長	方向角	測角	DX	倍積 (Y×DX)
13-215	41692.544	-68396.774	5.239	78-11-33	89-54-30	-12.536	857421.958864
13-36	41693.616	-68391.646	1.519	78-17-52	180-06-19	1.380	-94380.471480
13-208	41693.924	-68390.159	7.448	78-16-20	179-58-28	1.822	-124606.869698
13-40	41695.438	-68382.866	13.891	348-15-58	89-59-38	15.115	-1033607.019590
13-30	41709.039	-68385.691	11.563	258-16-27	90-00-29	11.251	-769407.409441
13-217	41706.689	-68397.013	2.638	258-15-20	179-58-53	-2.887	197462.176531
13-216	41706.152	-68399.596	13.898	168-17-03	90-01-43	-14.145	967512.285420
						倍面積	394.650606
						面積	197.3253030

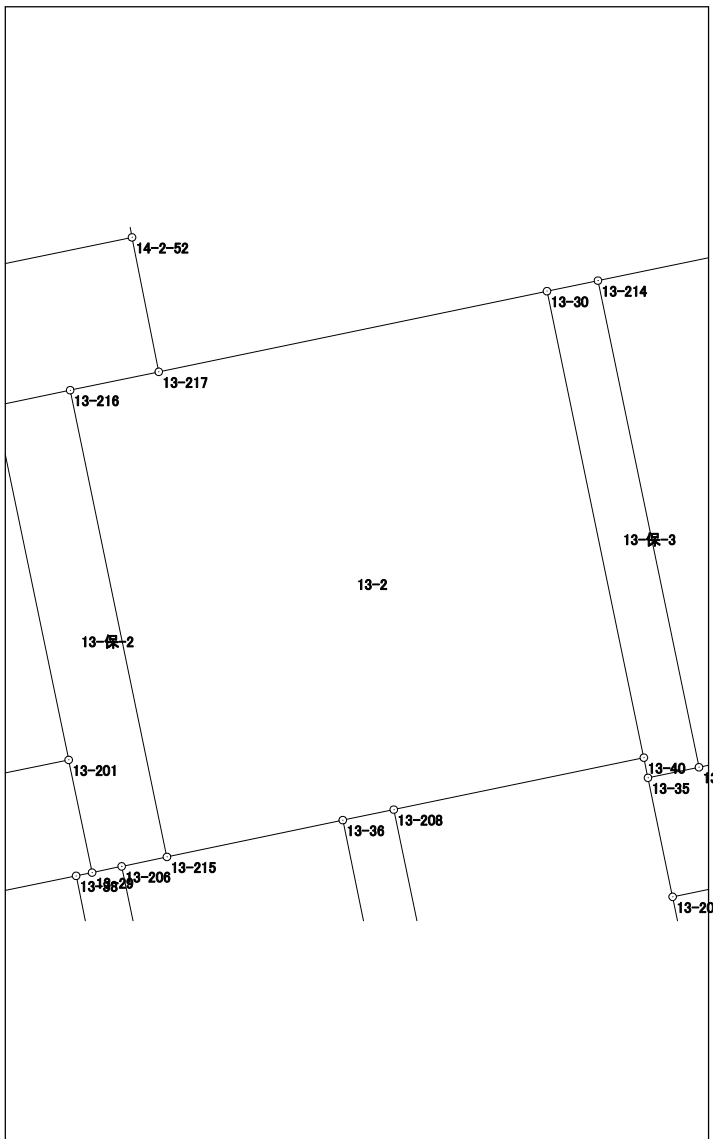


面積計算書 (座標法)

世界測地系 (測地成果2011)

所在	地番	公簿地目	現況地目	地積	所有者
前橋市六供町一丁目	13-3			114.70 m ²	

点名	X座標	Y座標	辺長	方向角	測角	DX	倍積 (Y×DX)
13-213	41695.158	-68381.258	7.915	78-19-21	90-03-04	-12.588	860783.275704
13-33	41696.760	-68373.507	3.231	348-14-54	89-55-33	4.765	-325799.760855
13-212	41699.923	-68374.165	11.270	348-15-19	180-00-25	14.197	-970708.020505
13-32	41710.957	-68376.459	7.910	258-15-50	90-00-31	9.425	-644448.126075
13-214	41709.348	-68384.204	14.493	168-16-17	90-00-27	-15.799	1080402.038996
						倍面積	229.407265
						面積	114.7036325

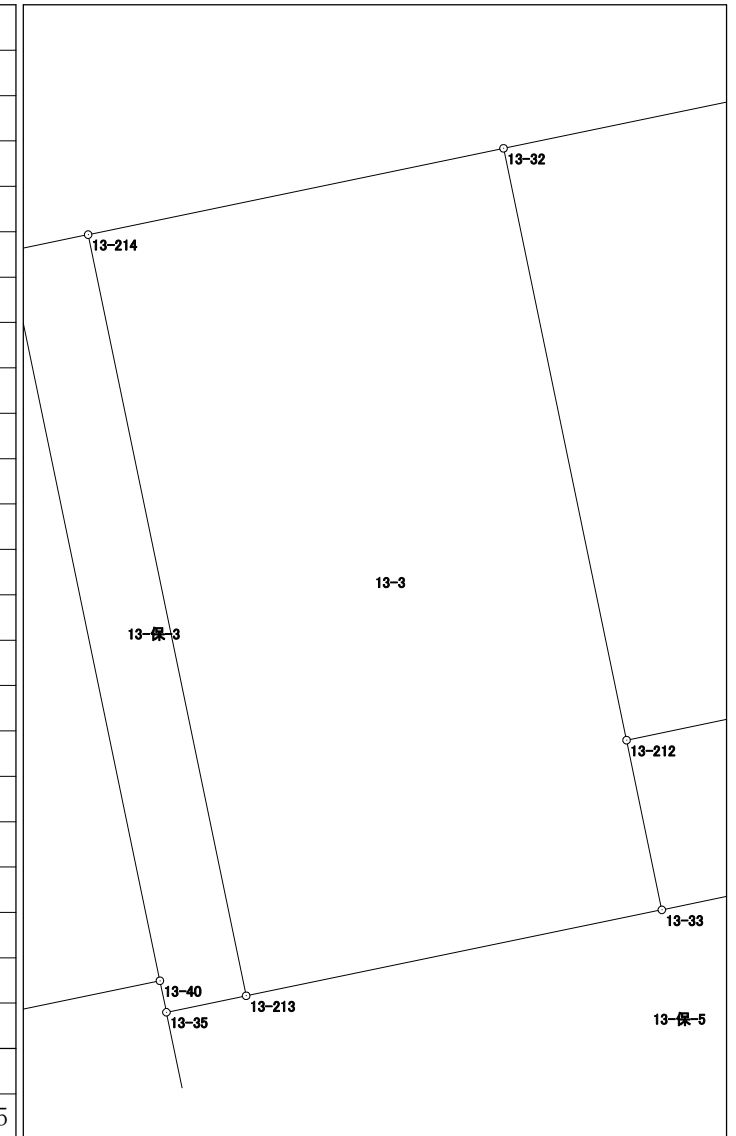


面積計算書 (座標法)

世界測地系 (測地成果2011)

所在	地番	公簿地目	現況地目	地積	所有者
前橋市六供町一丁目	13-4			91.95 m ²	

点名	X座標	Y座標	辺長	方向角	測角	DX	倍積 (Y×DX)
13-211	41701.625	-68365.982	9.150	348-15-33	90-00-31	10.661	-728849.734102
13-22	41710.584	-68367.844	2.984	303-26-04	135-10-31	10.603	-724904.249932
13-21	41712.228	-68370.334	6.255	258-16-37	134-50-33	0.373	-25502.134582
13-32	41710.957	-68376.459	11.270	168-15-19	89-58-42	-12.305	841372.327995
13-212	41699.923	-68374.165	8.358	78-15-02	89-59-43	-9.332	638067.707780
						倍面積	183.917159
						面積	91.9585795

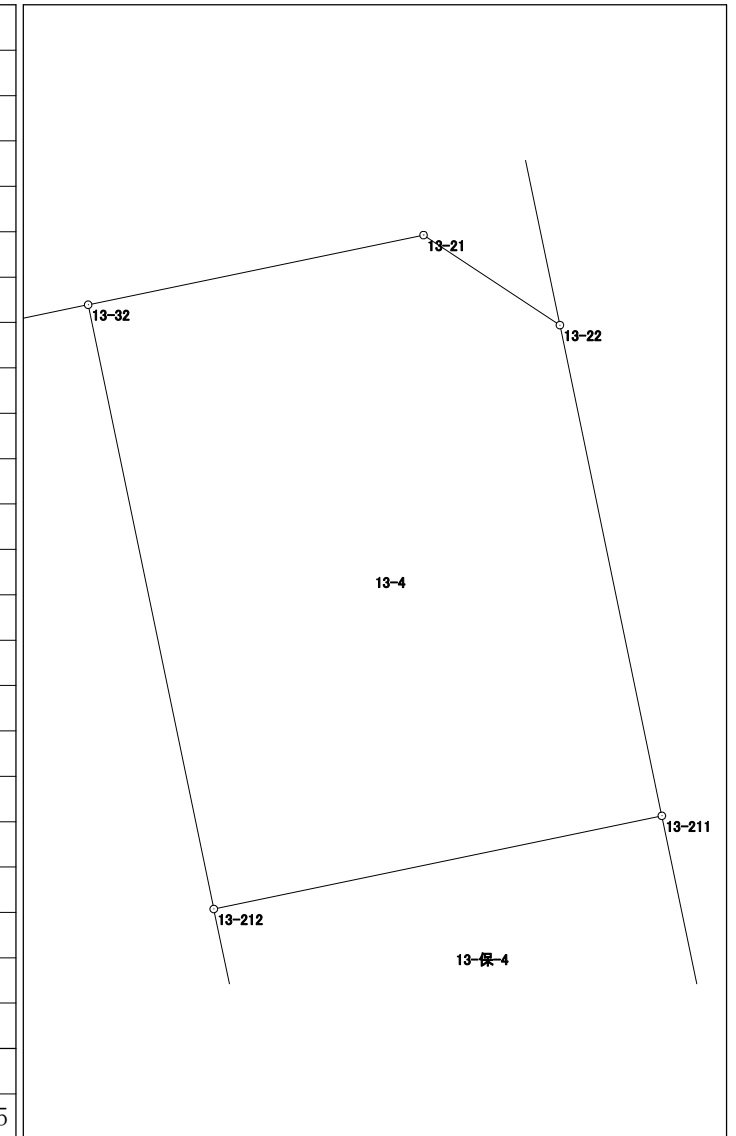


面積計算書 (座標法)

世界測地系 (測地成果2011)

所在	地番	公簿地目	現況地目	地積	所有者
前橋市六供町一丁目	13-6			137.40 m ²	

点名	X座標	Y座標	辺長	方向角	測角	DX	倍積 (Y×DX)
13-207	41675.860	-68386.419	7.449	78-15-53	89-57-43	-16.549	1131726.848031
13-31	41677.375	-68379.126	14.303	348-18-07	90-02-14	15.521	-1061312.414646
13-209	41691.381	-68382.026	3.544	348-17-37	179-59-30	17.476	-1195044.286376
13-35	41694.851	-68382.745	0.599	348-21-09	180-03-32	4.057	-277428.796465
13-40	41695.438	-68382.866	7.448	258-16-20	89-55-11	-0.927	63390.916782
13-208	41693.924	-68390.159	18.447	168-18-10	90-01-50	-19.578	1338942.532902
						倍面積	274.800228
						面積	137.4001140

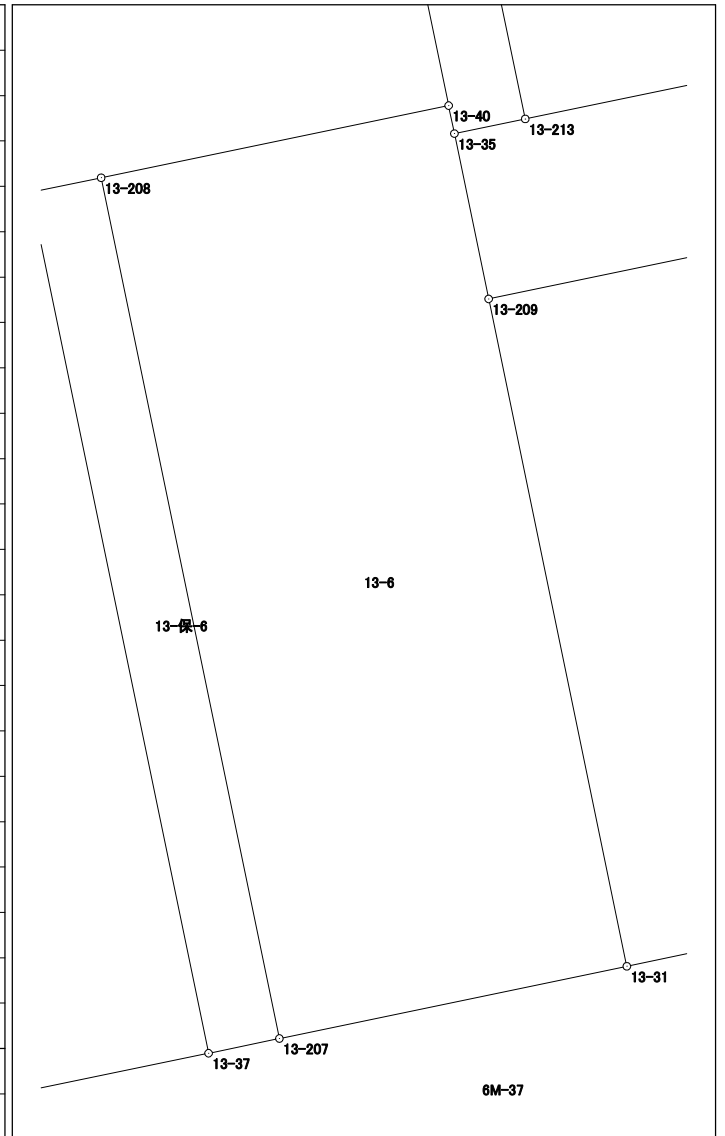


面積計算書 (座標法)

世界測地系 (測地成果2011)

所在	地番	公簿地目	現況地目	地積	所有者
前橋市六供町一丁目	13-7			121.37 m ²	

点名	X座標	Y座標	辺長	方向角	測角	DX	倍積 (Y×DX)
13-205	41674.217	-68394.344	6.576	78-17-43	90-01-52	-16.717	1143348.248648
13-37	41675.551	-68387.905	18.448	348-18-01	90-00-18	19.399	-1326656.969095
13-36	41693.616	-68391.646	5.239	258-11-33	89-53-32	16.993	-1162179.240478
13-215	41692.544	-68396.774	1.349	258-11-24	179-59-51	-1.348	92198.851352
13-206	41692.268	-68398.094	18.436	168-15-51	90-04-27	-18.327	1253531.868738
						倍面積	242.759165
						面積	121.3795825

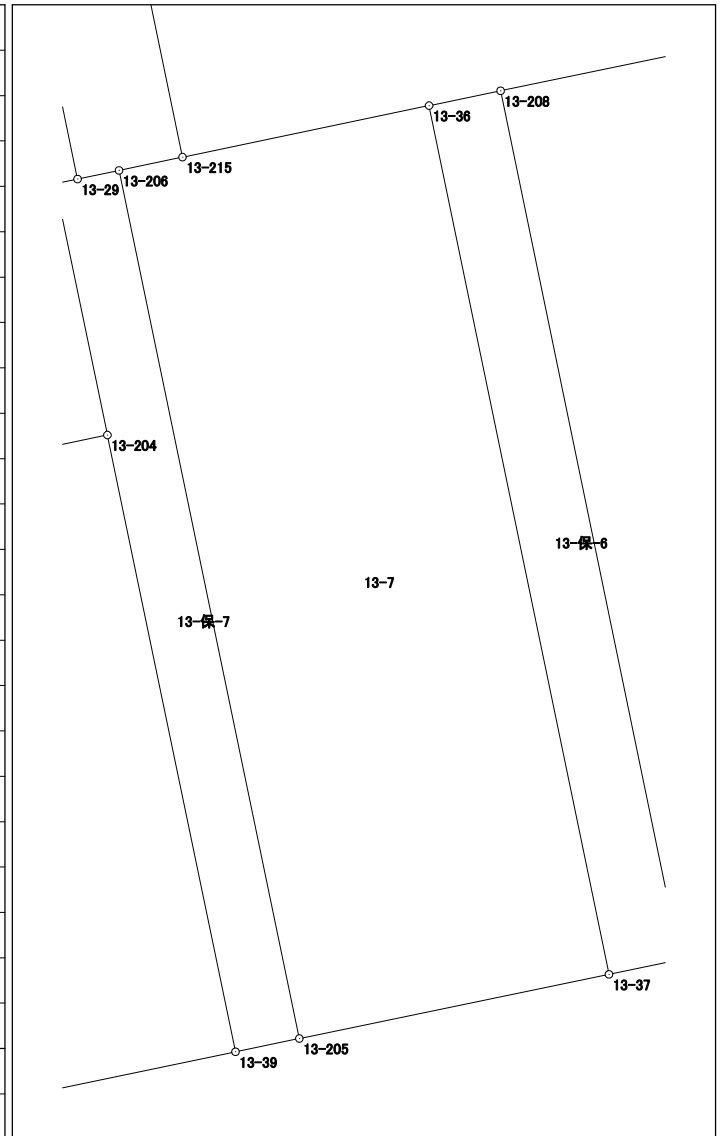


面積計算書（座標法）

世界測地系（測地成果2011）

所在	地番	公簿地目	現況地目	地積	所有者
前橋市六供町一丁目	13-保-8			47.00 m ²	

点名	X座標	Y座標	辺長	方向角	測角	DX	倍積 (Y×DX)
13-38	41691.993	-68399.422	8.781	258-19-54	90-04-08	3.451	-236046.405322
13-41	41690.217	-68408.022	5.338	168-46-35	90-26-41	-7.012	479677.050264
13-203	41684.981	-68406.983	8.829	78-20-11	89-33-36	-3.451	236072.498333
13-204	41686.766	-68398.336	5.339	348-15-46	89-55-35	7.012	-479609.132032

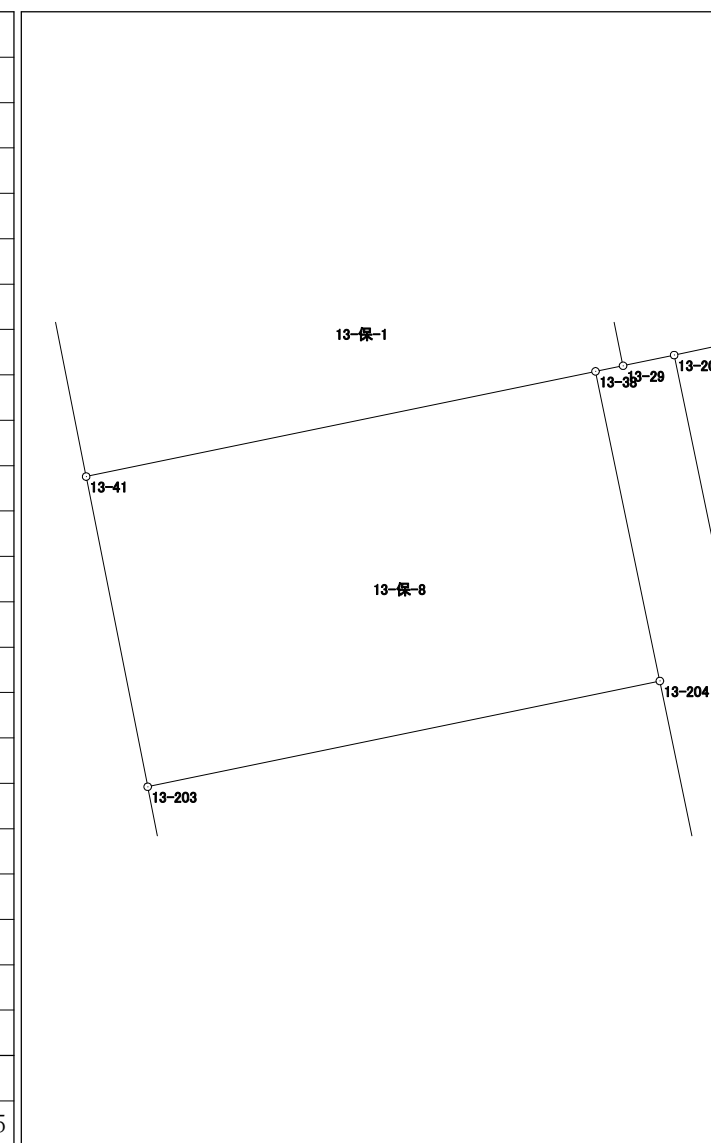

倍面積	94.011243
面積	47.0056215