



152街区 画地出来形確認図 (7836.20m²)

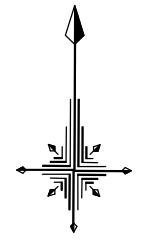

S=1/500

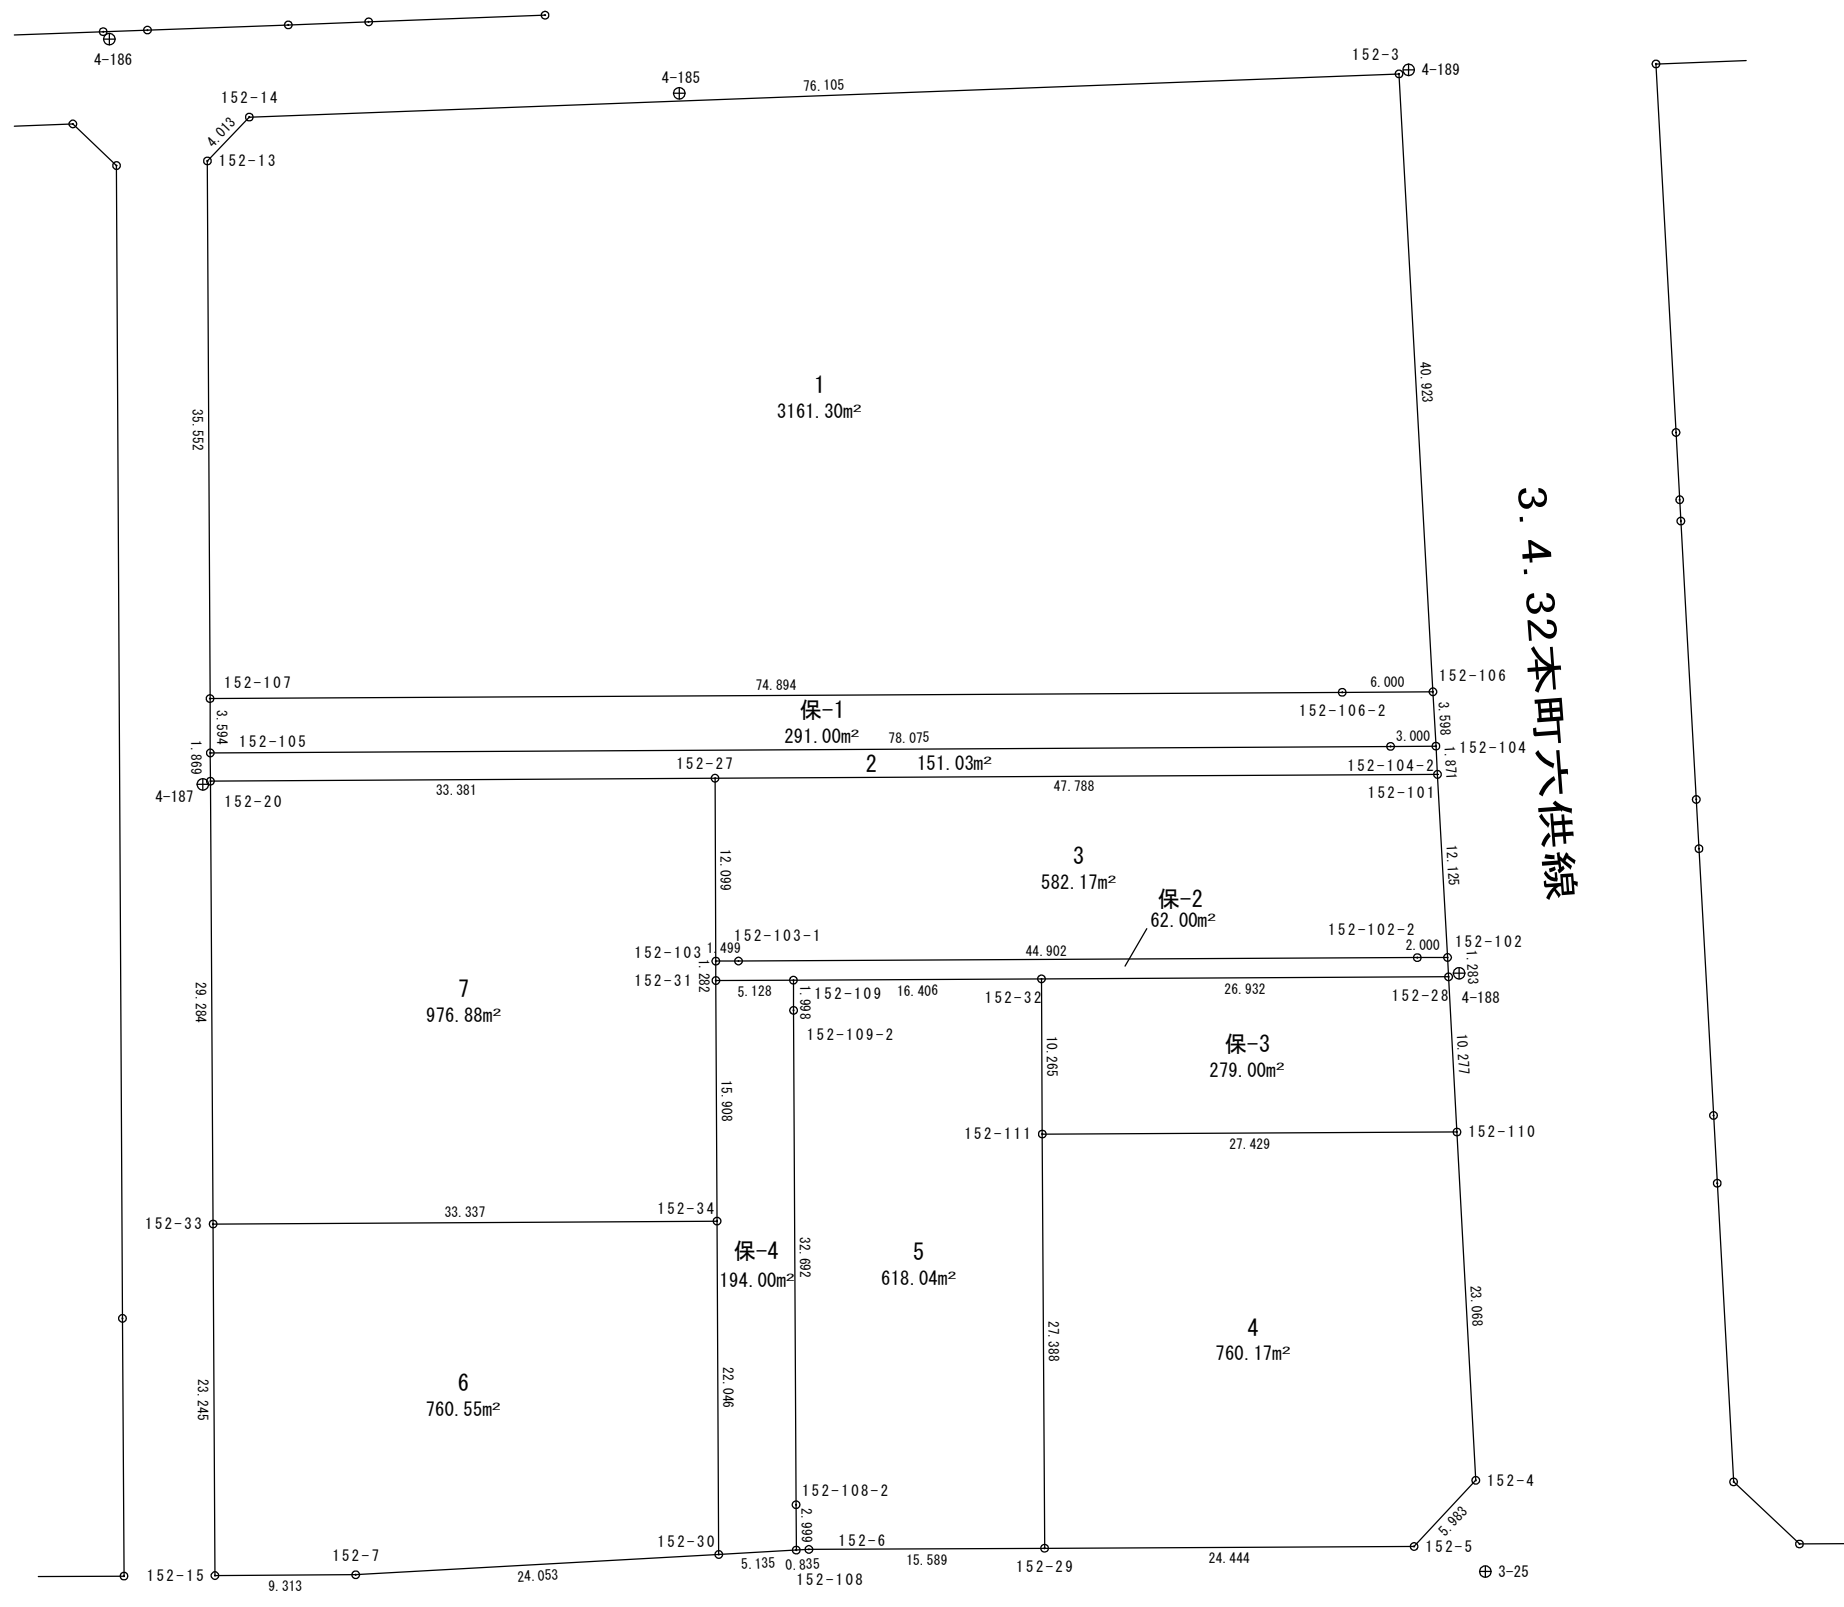

3. 5. 66短大北通線

