



# 154街区 画地出来形確認図 (5034.00m<sup>2</sup>)

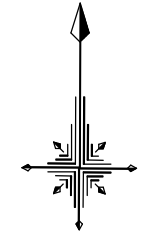

S=1/500

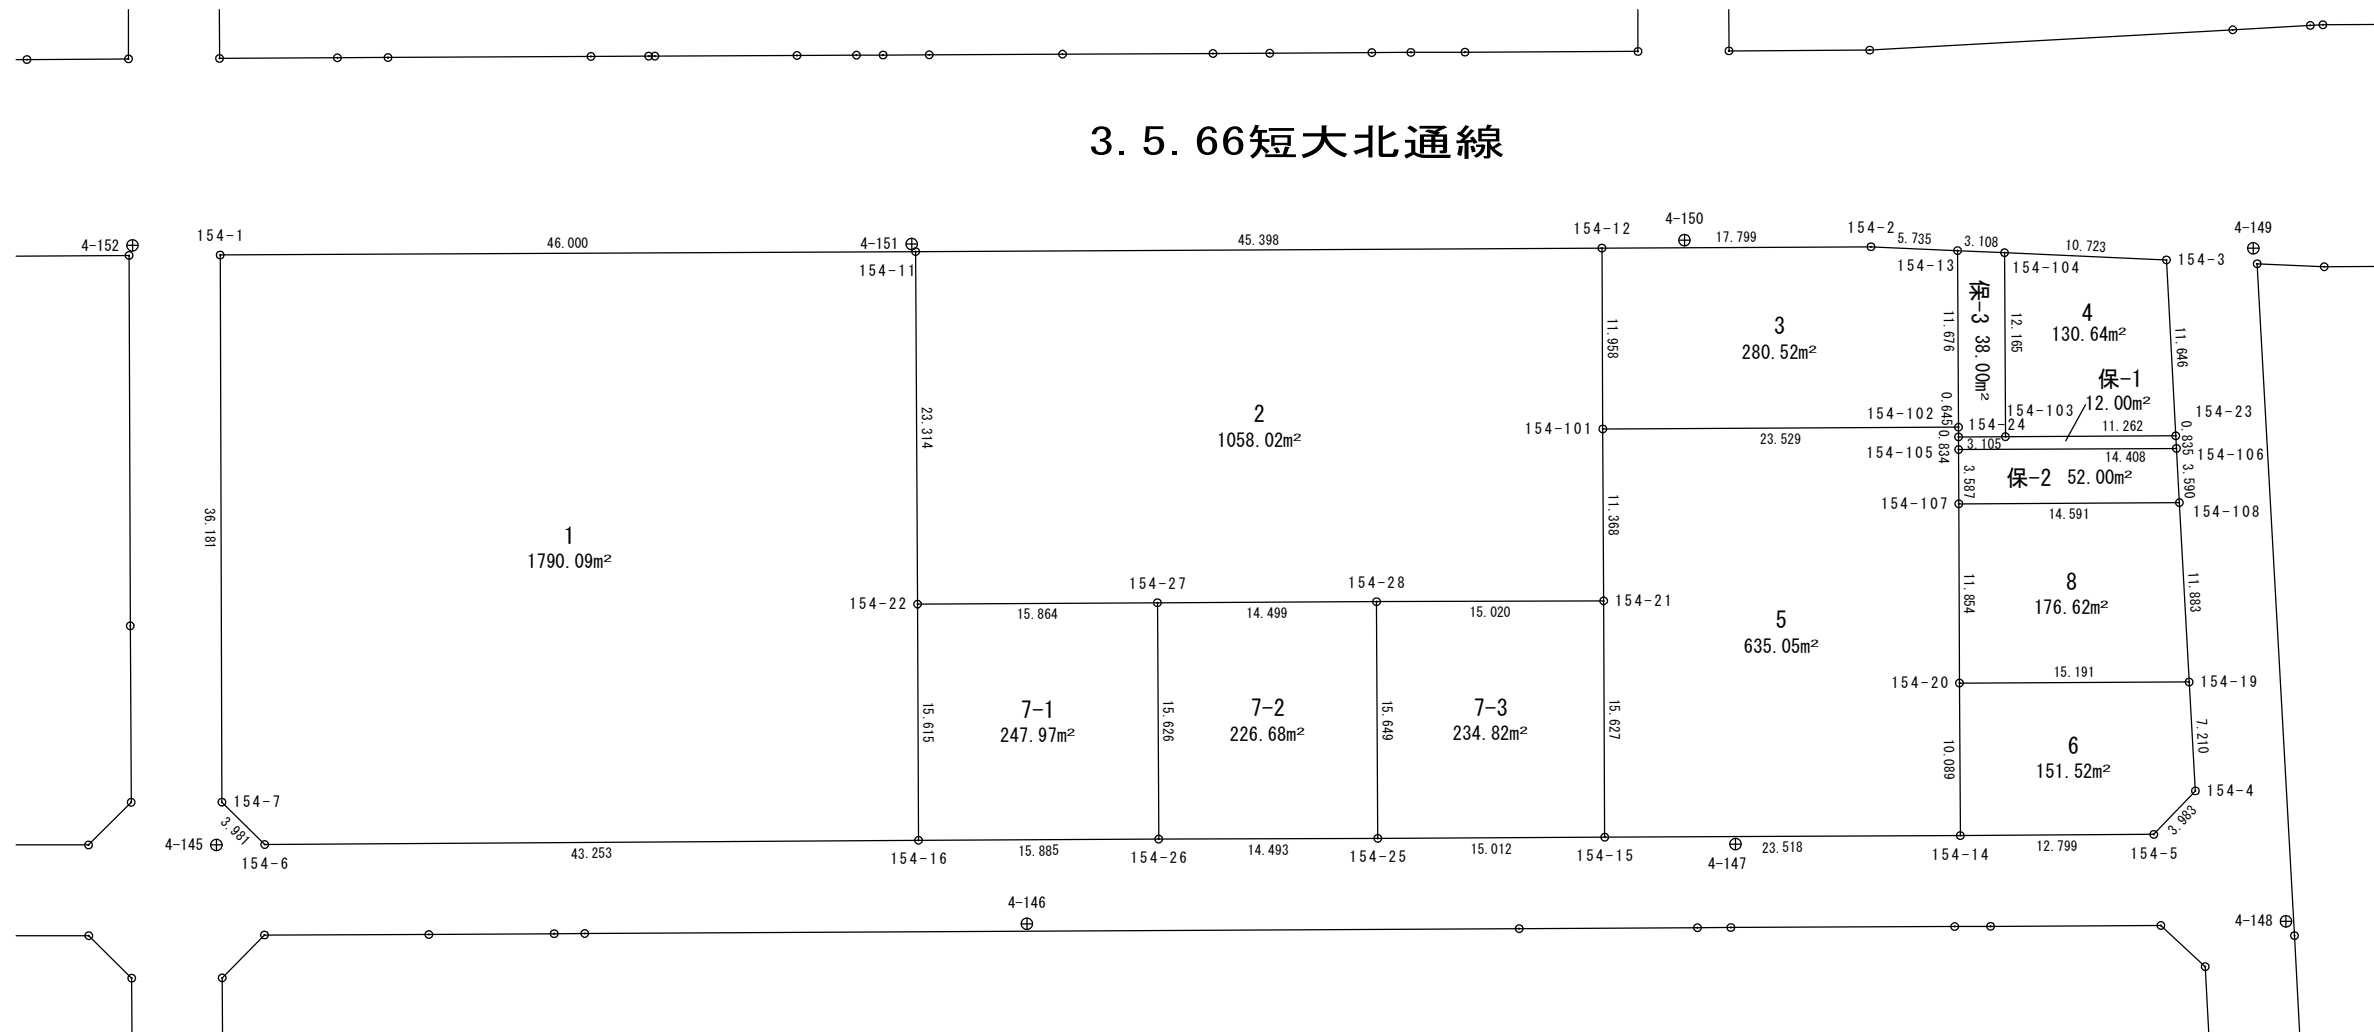



# 面積計算書（座標法）

世界測地系（測地成果2011）

所在	地番	公簿地目	現況地目	地積	所有者
前橋市六供町三丁目	154-2			1058.02 m <sup>2</sup>	

点名	X座標	Y座標	辺長	方向角	測角	DX	倍積 (Y×DX)	
154-22	40951.194	-67981.515	15.864	89-40-04	89-59-23	-23.222	1578666.741330	
154-27	40951.286	-67965.651	14.499	89-43-24	180-03-20	0.162	-11010.435462	
154-28	40951.356	-67951.152	15.020	89-47-25	180-04-01	0.125	-8493.894000	
154-21	40951.411	-67936.132	11.368	359-42-46	89-55-21	11.423	-776034.435836	
154-101	40962.779	-67936.189	11.958	359-42-45	179-59-59	23.326	-1584679.544614	
154-12	40974.737	-67936.249	45.398	269-42-40	89-59-55	11.729	-796824.264521	
154-11	40974.508	-67981.646	23.314	179-40-41	89-58-01	-23.543	1600491.891778	
						倍面積	2116.058675	
						面積	1058.0293375	

# 面積計算書（座標法）

世界測地系（測地成果2011）


所 在	地 番	公簿地目	現況地目	地 積	所 有 者
前橋市六供町三丁目	154-3			280.52 m <sup>2</sup>	

点 名	X 座標	Y 座標	辺 長	方 向 角	測 角	DX	倍 積 (Y×DX)	
154-101	40962.779	-67936.189	23.529	89-42-46	90-00-01	-11.840	804364.477760	
154-102	40962.897	-67912.660	11.676	359-42-02	89-59-16	11.794	-800961.912040	
154-13	40974.573	-67912.721	5.735	272-31-07	92-49-05	11.928	-810062.936088	
154-2	40974.825	-67918.450	17.799	269-43-00	177-11-53	0.164	-11138.625800	
154-12	40974.737	-67936.249	11.958	179-42-45	89-59-45	-12.046	818360.055454	
							倍面積	
							面 積	280.5296430

# 面積計算書 (座標法)

所在	地番	公簿地目	現況地目	地積	所有者
前橋市六供町三丁目	154-4			130.64 m <sup>2</sup>	

点名	X座標	Y座標	辺長	方向角	測角	DX	倍積 (Y×DX)
154-104	40974.434	-67909.616	12.165	179-41-55	87-08-56	-11.688	793727.591808
154-103	40962.269	-67909.552	11.262	89-42-18	90-00-23	-12.107	822180.946064
154-23	40962.327	-67898.290	11.646	356-58-40	87-16-22	11.688	-793595.213520
154-3	40973.957	-67898.904	10.723	272-32-59	95-34-19	12.107	-822052.030728

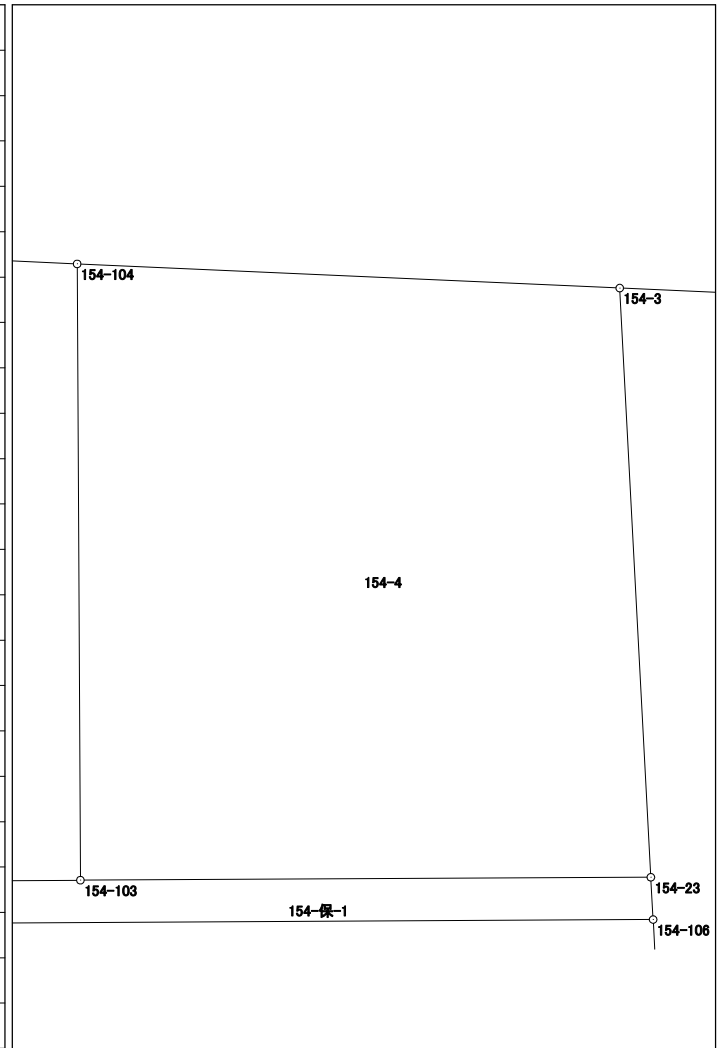

倍面積	261.293624
面積	130.6468120

# 面積計算書 (座標法)

世界測地系 (測地成果2011)

所在	地番	公簿地目	現況地目	地積	所有者
前橋市六供町三丁目	154-5			635.05 m <sup>2</sup>	


点名	X座標	Y座標	辺長	方向角	測角	DX	倍積 (Y×DX)
154-21	40951.411	-67936.132	15.627	179-44-10	180-01-24	-26.995	1833935.883340
154-15	40935.784	-67936.060	23.518	89-44-48	90-00-38	-15.523	1054571.459380
154-14	40935.888	-67912.542	10.089	359-42-17	89-57-29	10.193	-692232.540606
154-20	40945.977	-67912.594	11.854	359-46-40	180-04-23	21.943	-1490206.050142
154-107	40957.831	-67912.640	3.587	359-47-32	180-00-52	15.441	-1048639.074240
154-105	40961.418	-67912.653	0.834	359-43-31	179-55-59	4.421	-300241.838913
154-24	40962.252	-67912.657	0.645	359-44-01	180-00-30	1.479	-100442.819703
154-102	40962.897	-67912.660	23.529	269-42-46	89-58-45	0.527	-35789.971820
154-101	40962.779	-67936.189	11.368	179-42-46	90-00-00	-11.486	780315.066854
						倍面積	1270.114150
						面積	635.0570750

# 面積計算書 (座標法)

世界測地系 (測地成果2011)

所在	地番	公簿地目	現況地目	地積	所有者
前橋市六供町三丁目	154-6			151.52 m <sup>2</sup>	

点名	X座標	Y座標	辺長	方向角	測角	DX	倍積 (Y×DX)
154-20	40945.977	-67912.594	10.089	179-42-17	89-57-13	-10.155	689652.392070
154-14	40935.888	-67912.542	12.799	89-38-31	89-56-14	-10.009	679736.632878
154-5	40935.968	-67899.743	3.983	43-44-55	134-06-24	2.957	-200779.540051
154-4	40938.845	-67896.989	7.210	356-42-30	132-57-35	10.075	-684062.164175
154-19	40946.043	-67897.403	15.191	269-45-04	93-02-34	7.132	-484244.278196
						倍面積	303.042526
						面積	151.5212630

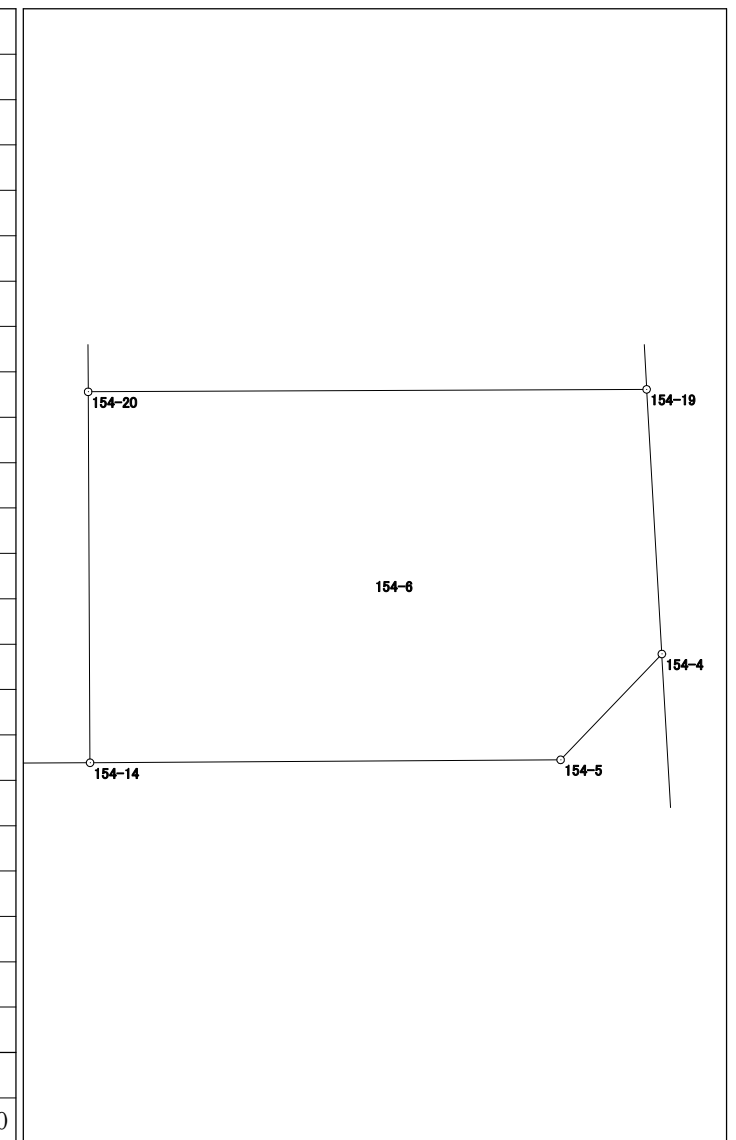







# 面積計算書 (座標法)

世界測地系 (測地成果2011)

所在	地番	公簿地目	現況地目	地積	所有者
前橋市六供町三丁目	154-7-3			234.82 m <sup>2</sup>	


点名	X座標	Y座標	辺長	方向角	測角	DX	倍積 (Y×DX)		
154-28	40951.356	-67951.152	15.649	179-42-26	89-55-01	-15.704	1067104.891008		
154-25	40935.707	-67951.072	15.012	89-42-22	89-59-56	-15.572	1058134.093184		
154-15	40935.784	-67936.060	15.627	359-44-10	90-01-48	15.704	-1066867.886240		
154-21	40951.411	-67936.132	15.020	269-47-25	90-03-15	15.572	-1057901.447504		
							倍面積		469.650448
							面積		234.8252240

# 面積計算書 (座標法)

世界測地系 (測地成果2011)

所 在	地 番	公簿地目	現況地目	地 積	所 有 者
前橋市六供町三丁目	154-8			176.62 m <sup>2</sup>	

点 名	X 座標	Y 座標	辺 長	方 向 角	測 角	DX	倍 積 (Y×DX)
154-108	40957.908	-67898.049	14.591	269-41-52	92-48-51	11.788	-800382.201612
154-107	40957.831	-67912.640	11.854	179-46-40	90-04-48	-11.931	810265.707840
154-20	40945.977	-67912.594	15.191	89-45-04	89-58-24	-11.788	800553.658072
154-19	40946.043	-67897.403	11.883	356-53-01	87-07-57	11.931	-810083.915193

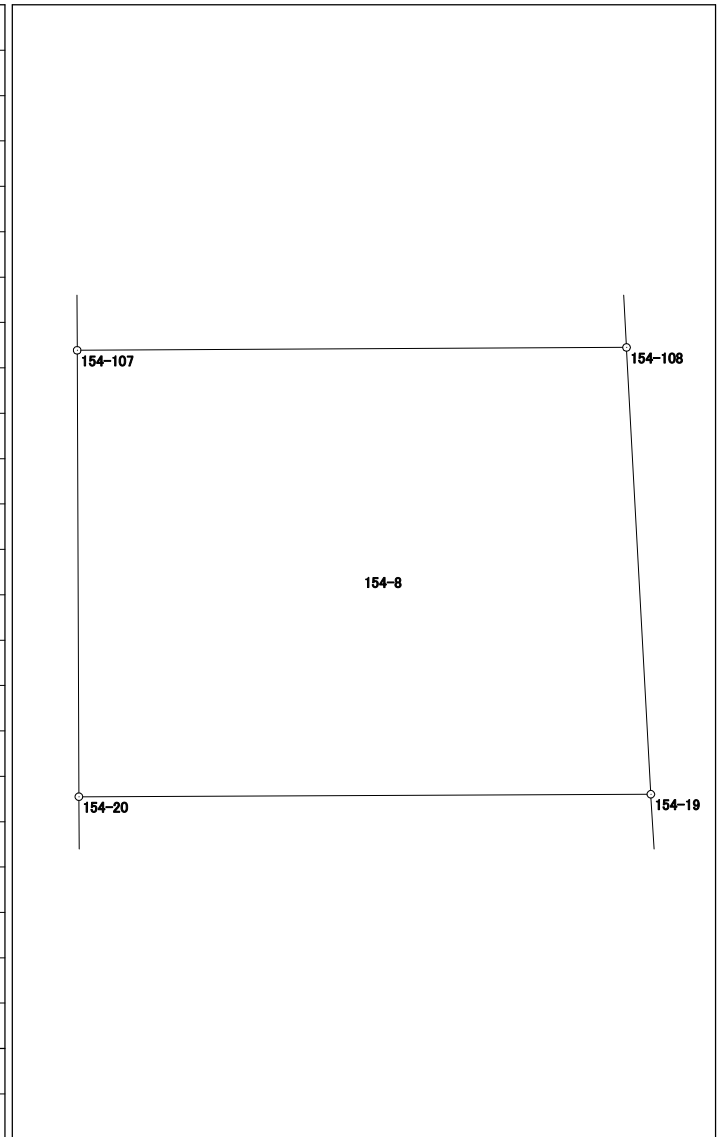


# 面積計算書 (座標法)

世界測地系 (測地成果2011)

所 在	地 番	公簿地目	現況地目	地 積	所 有 者
前橋市六供町三丁目	154-保-1			12.00 m <sup>2</sup>	

点 名	X 座標	Y 座標	辺 長	方 向 角	測 角	DX	倍 積 (Y×DX)
154-105	40961.418	-67912.653	14.408	89-42-06	89-58-35	-0.759	51545.703627
154-106	40961.493	-67898.245	0.835	356-54-41	87-12-35	0.909	-61719.504705
154-23	40962.327	-67898.290	11.262	269-42-18	92-47-37	0.776	-52689.073040
154-103	40962.269	-67909.552	3.105	269-41-11	179-58-53	-0.075	5093.216400
154-24	40962.252	-67912.657	0.834	179-43-31	90-02-20	-0.851	57793.671107
						倍面積	24.013389
						面 積	12.0066945

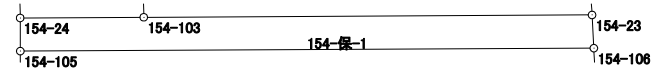


# 面積計算書 (座標法)

世界測地系 (測地成果2011)

所在	地番	公簿地目	現況地目	地積	所有者
前橋市六供町三丁目	154-保-2			52.00 m <sup>2</sup>	

点名	X座標	Y座標	辺長	方向角	測角	DX	倍積 (Y×DX)
154-107	40957.831	-67912.640	14.591	89-41-52	89-54-20	-3.510	238373.366400
154-108	40957.908	-67898.049	3.590	356-52-14	87-10-22	3.662	-248642.655438
154-106	40961.493	-67898.245	14.408	269-42-06	92-49-52	3.510	-238322.839950
154-105	40961.418	-67912.653	3.587	179-47-32	90-05-26	-3.662	248696.135286
						倍面積	104.006298
						面積	52.0031490

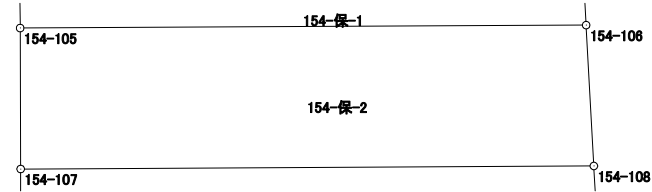

# 面積計算書 (座標法)

世界測地系 (測地成果2011)

所在	地番	公簿地目	現況地目	地積	所有者
前橋市六供町三丁目	154-保-3			38.00 m <sup>2</sup>	

点名	X座標	Y座標	辺長	方向角	測角	DX	倍積 (Y×DX)
154-103	40962.269	-67909.552	12.165	359-41-55	90-00-44	12.182	-827274.162464
154-104	40974.434	-67909.616	3.108	272-33-48	92-51-53	12.304	-835559.915264
154-13	40974.573	-67912.721	11.676	179-42-02	87-08-14	-11.537	783509.062177
154-102	40962.897	-67912.660	0.645	179-44-01	180-01-59	-12.321	836751.883860
154-24	40962.252	-67912.657	3.105	89-41-11	89-57-10	-0.628	42649.148596
						倍面積	76.016905
						面積	38.0084525

