



158街区 画地出来形確認図 (5809.27m²)

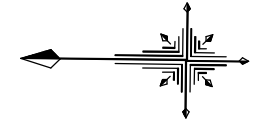

1/500

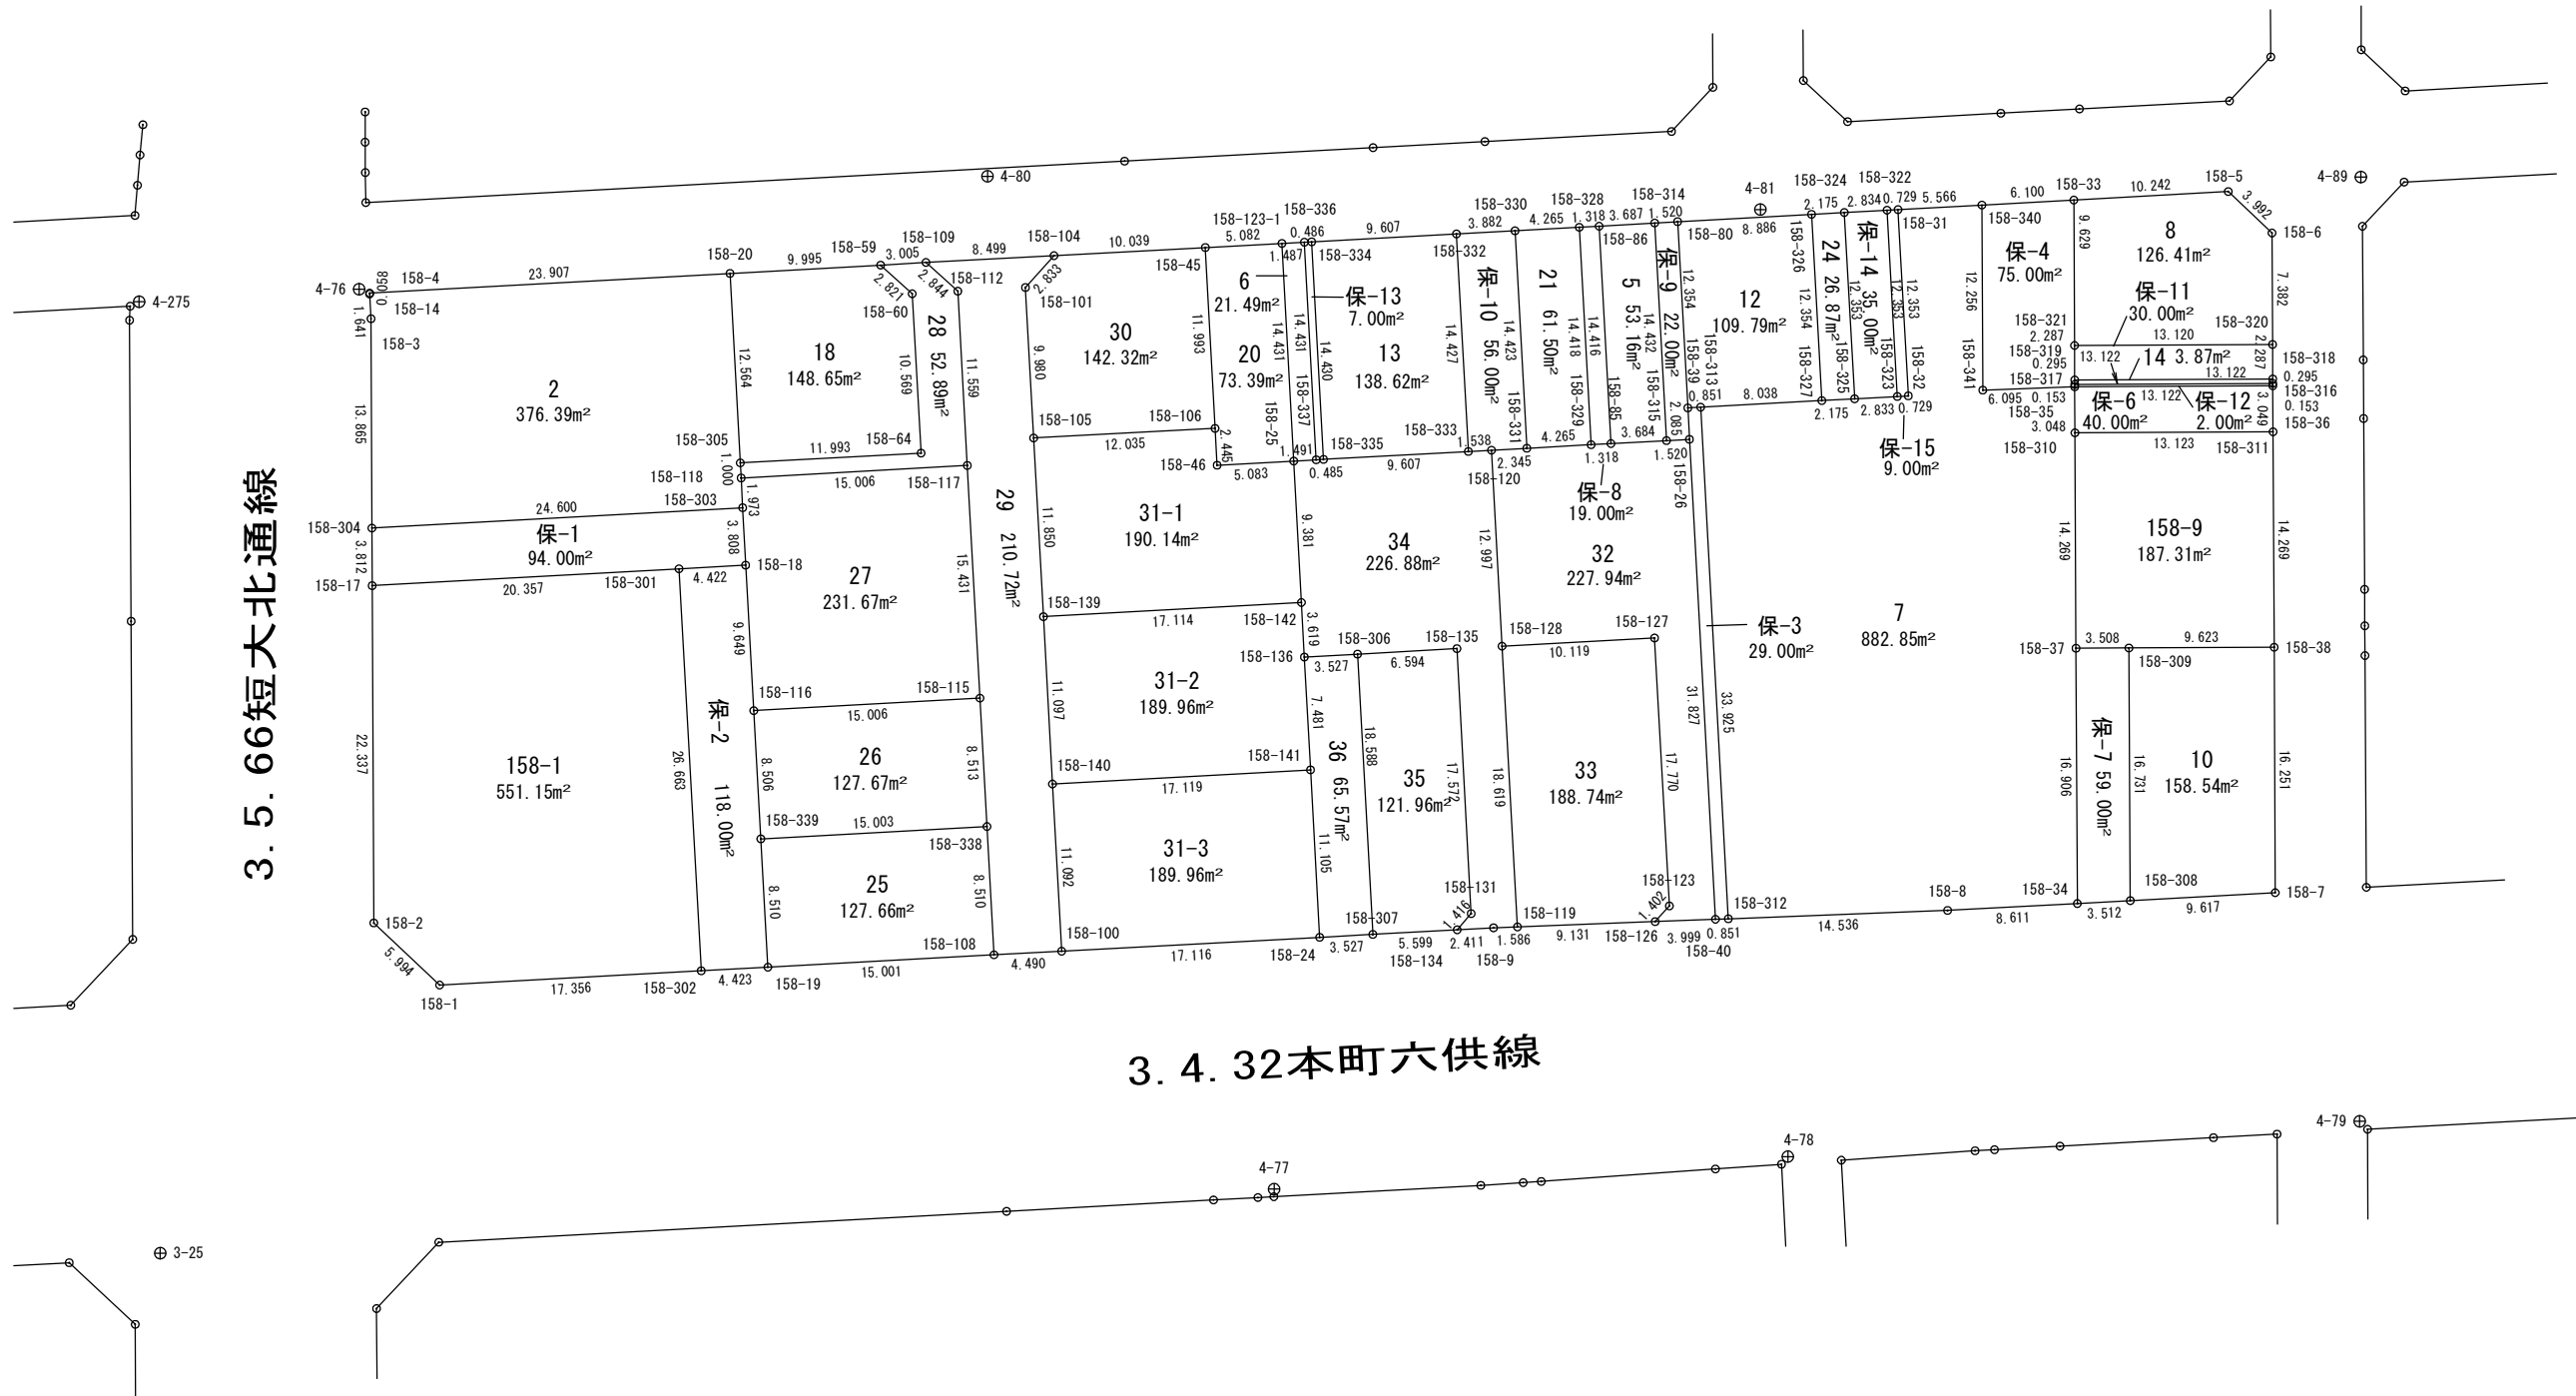


面積計算書 (座標法)

世界測地系 (測地成果2011)

| | | | | | |
|-----------|-------|------|------|-----------------------|-------|
| 所 在 | 地 番 | 公簿地目 | 現況地目 | 地 積 | 所 有 者 |
| 前橋市六供町五丁目 | 158-1 | | | 551.15 m ² | |

| 点 名 | X 座標 | Y 座標 | 辺 長 | 方 向 角 | 測 角 | DX | 倍 積 (Y×DX) |
|---------|-----------|------------|--------|-----------|-----------|---------|-----------------|
| 158-302 | 40952.205 | -67825.111 | 26.663 | 86-49-44 | 89-56-25 | -15.855 | 1075367.134905 |
| 158-301 | 40953.680 | -67798.489 | 20.357 | 356-51-26 | 90-01-42 | 21.801 | -1478074.858689 |
| 158-17 | 40974.006 | -67799.605 | 22.337 | 269-43-13 | 92-51-47 | 20.217 | -1370704.614285 |
| 158-2 | 40973.897 | -67821.942 | 5.994 | 223-18-11 | 133-34-58 | -4.471 | 303231.902682 |
| 158-1 | 40969.535 | -67826.053 | 17.356 | 176-53-19 | 133-35-08 | -21.692 | 1471282.741676 |
| | | | | | | | |
| | | | | | | | |
| | | | | | | 倍面積 | 1102.306289 |
| | | | | | | 面 積 | 551.1531445 |

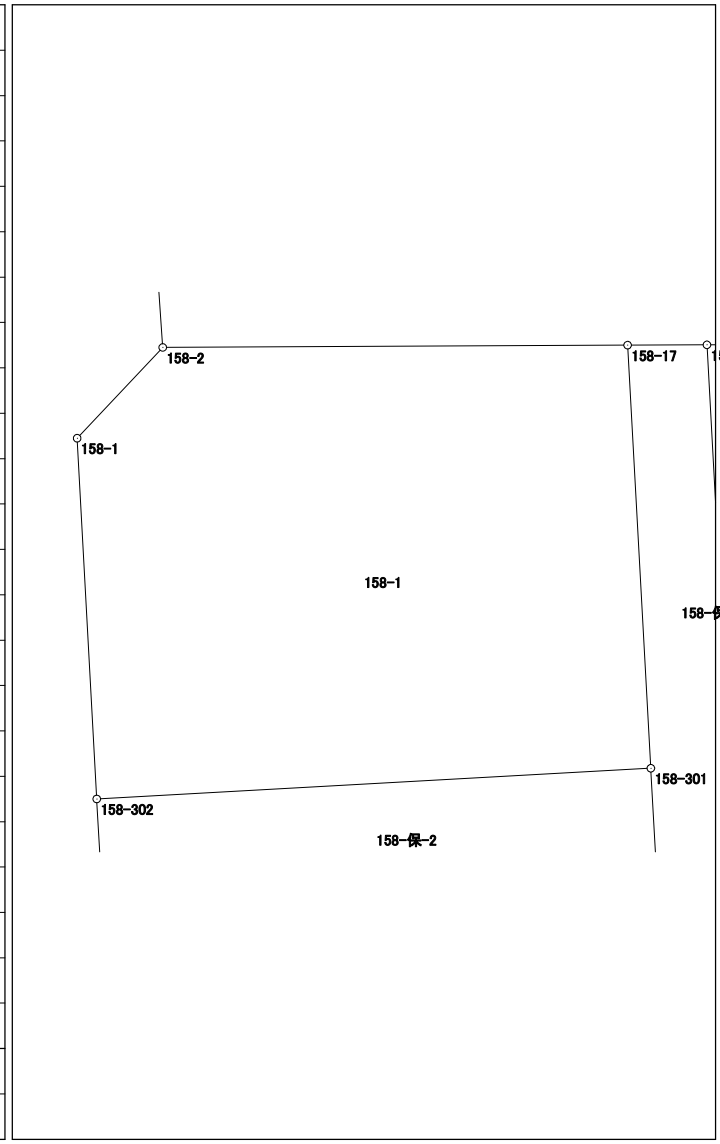

面積計算書（座標法）

世界測地系（測地成果2011）

| | | | | | |
|-----------|-------|------|------|----------------------|-------|
| 所 在 | 地 番 | 公簿地目 | 現況地目 | 地 積 | 所 有 者 |
| 前橋市六供町五丁目 | 158-5 | | | 53.16 m ² | |


| 点 名 | X 座標 | Y 座標 | 辺 長 | 方 向 角 | 測 角 | DX | 倍 積 (Y×DX) | |
|---------|-----------|------------|--------|-----------|----------|--------|----------------|--|
| 158-315 | 40888.255 | -67789.998 | 14.432 | 86-53-38 | 89-59-24 | -2.897 | 196387.624206 | |
| 158-314 | 40889.037 | -67775.587 | 3.687 | 356-39-26 | 89-45-48 | 4.463 | -302482.444781 | |
| 158-86 | 40892.718 | -67775.802 | 14.416 | 266-52-57 | 90-13-31 | 2.897 | -196346.498394 | |
| 158-85 | 40891.934 | -67790.197 | 3.684 | 176-54-14 | 90-01-17 | -4.463 | 302547.649211 | |
| | | | | | | | | |
| | | | | | | | | |
| | | | | | | 倍面積 | 106.330242 | |
| | | | | | | 面 積 | 53.1651210 | |

面積計算書（座標法）

世界測地系（測地成果2011）

| | | | | | |
|-----------|-------|------|------|----------------------|-------|
| 所 在 | 地 番 | 公簿地目 | 現況地目 | 地 積 | 所 有 者 |
| 前橋市六供町五丁目 | 158-6 | | | 21.49 m ² | |

| 点 名 | X 座標 | Y 座標 | 辺 長 | 方 向 角 | 測 角 | DX | 倍 積 (Y×DX) |
|-----------|-----------|------------|--------|-----------|----------|--------|----------------|
| 158-337 | 40911.462 | -67791.272 | 14.431 | 86-52-55 | 89-59-45 | -0.704 | 47725.055488 |
| 158-336 | 40912.247 | -67776.862 | 1.487 | 356-52-40 | 89-59-45 | 2.270 | -153853.476740 |
| 158-123-1 | 40913.732 | -67776.943 | 14.431 | 266-53-52 | 90-01-12 | 0.704 | -47714.967872 |
| 158-25 | 40912.951 | -67791.353 | 1.491 | 176-53-10 | 89-59-18 | -2.270 | 153886.371310 |
| | | | | | | | |
| | | | | | | | |
| | | | | | | 倍面積 | 42.982186 |
| | | | | | | 面積 | 21.4910930 |

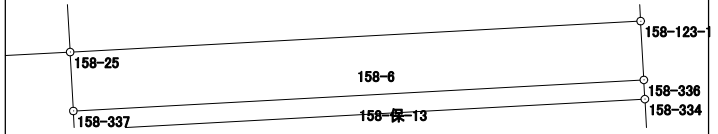


面積計算書（座標法）

世界測地系（測地成果2011）

| | | | | | |
|-----------|-------|------|------|-----------------------|-------|
| 所 在 | 地 番 | 公簿地目 | 現況地目 | 地 積 | 所 有 者 |
| 前橋市六供町五丁目 | 158-7 | | | 882.85 m ² | |

| 点 名 | X 座標 | Y 座標 | 辺 長 | 方 向 角 | 測 角 | DX | 倍 積 (Y×DX) |
|---------|-----------|------------|--------|-----------|-----------|---------|----------------|
| 158-341 | 40867.301 | -67786.657 | 12.256 | 89-43-44 | 271-49-32 | 6.149 | -416820.153893 |
| 158-340 | 40867.359 | -67774.401 | 5.566 | 356-53-23 | 87-09-39 | 5.616 | -380621.036016 |
| 158-31 | 40872.917 | -67774.703 | 12.353 | 266-50-23 | 89-57-00 | 4.877 | -330537.226531 |
| 158-32 | 40872.236 | -67787.037 | 0.729 | 356-51-18 | 270-00-55 | 0.047 | -3185.990739 |
| 158-323 | 40872.964 | -67787.077 | 2.833 | 356-53-03 | 180-01-45 | 3.557 | -241118.632889 |
| 158-325 | 40875.793 | -67787.231 | 2.175 | 356-51-50 | 179-58-47 | 5.001 | -339003.942231 |
| 158-327 | 40877.965 | -67787.350 | 8.038 | 356-52-35 | 180-00-45 | 10.198 | -691295.395300 |
| 158-313 | 40885.991 | -67787.788 | 33.925 | 266-54-22 | 90-01-47 | 6.195 | -419945.346660 |
| 158-312 | 40884.160 | -67821.664 | 14.536 | 177-49-40 | 90-55-18 | -16.357 | 1109358.958048 |
| 158-8 | 40869.634 | -67821.113 | 8.611 | 176-57-52 | 179-08-12 | -23.125 | 1568363.238125 |
| 158-34 | 40861.035 | -67820.657 | 16.906 | 89-41-18 | 92-43-26 | -8.507 | 576950.329099 |
| 158-37 | 40861.127 | -67803.751 | 14.269 | 89-43-37 | 180-02-19 | 0.160 | -10848.600160 |
| 158-310 | 40861.195 | -67789.482 | 3.048 | 89-43-05 | 179-59-28 | 0.083 | -5626.527006 |
| 158-35 | 40861.210 | -67786.434 | 6.095 | 357-54-12 | 88-11-07 | 6.106 | -413903.966004 |
| | | | | | | | |
| | | | | | | | |
| | | | | | | 倍面積 | 1765.707843 |
| | | | | | | 面 積 | 882.8539215 |

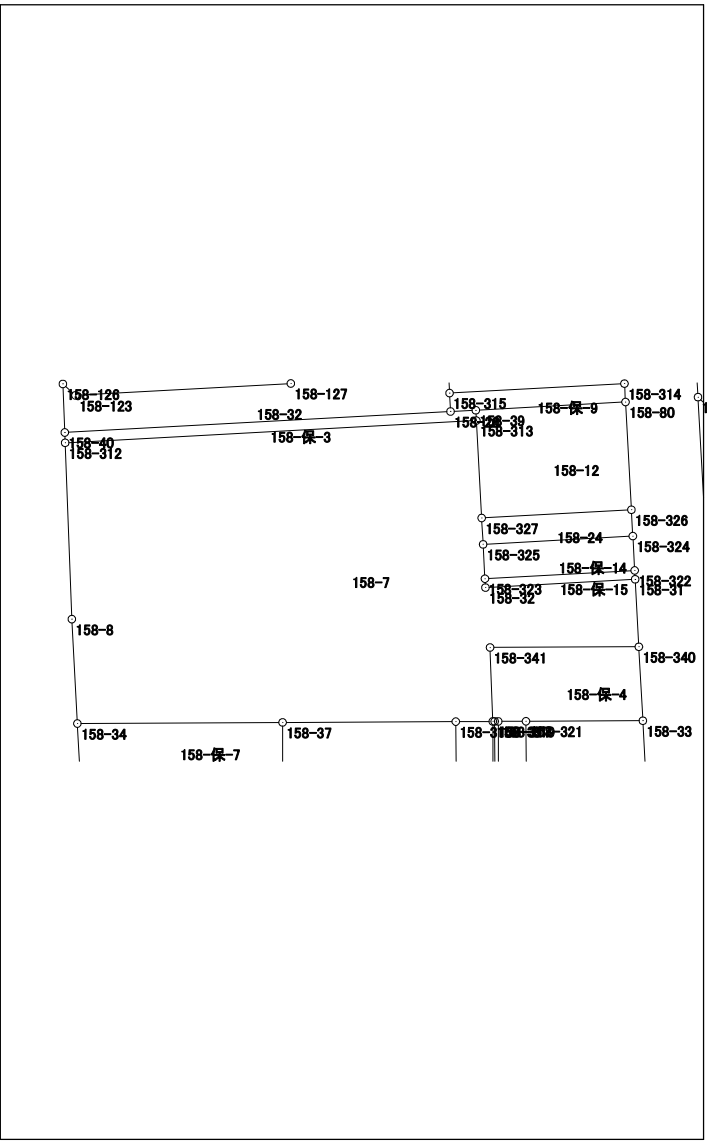


面積計算書 (座標法)

世界測地系 (測地成果2011)

| | | | | | |
|-----------|-------|------|------|-----------------------|-----|
| 所在 | 地番 | 公簿地目 | 現況地目 | 地積 | 所有者 |
| 前橋市六供町五丁目 | 158-8 | | | 126.41 m ² | |

| 点名 | X座標 | Y座標 | 辺長 | 方向角 | 測角 | DX | 倍積 (Y×DX) |
|---------|-----------|------------|--------|-----------|-----------|---------|----------------|
| 158-321 | 40861.222 | -67783.699 | 13.120 | 179-42-27 | 89-58-52 | -13.166 | 892440.181034 |
| 158-320 | 40848.102 | -67783.632 | 7.382 | 89-41-50 | 89-59-23 | -13.081 | 886677.690192 |
| 158-6 | 40848.141 | -67776.250 | 3.992 | 43-24-23 | 133-42-33 | 2.939 | -199194.398750 |
| 158-5 | 40851.041 | -67773.507 | 10.242 | 356-50-56 | 133-26-33 | 13.127 | -889662.826389 |
| 158-33 | 40861.268 | -67774.070 | 9.629 | 269-43-35 | 92-52-39 | 10.181 | -690007.806670 |
| | | | | | | | |
| | | | | | | | |
| | | | | | | 倍面積 | 252.839417 |
| | | | | | | 面積 | 126.4197085 |

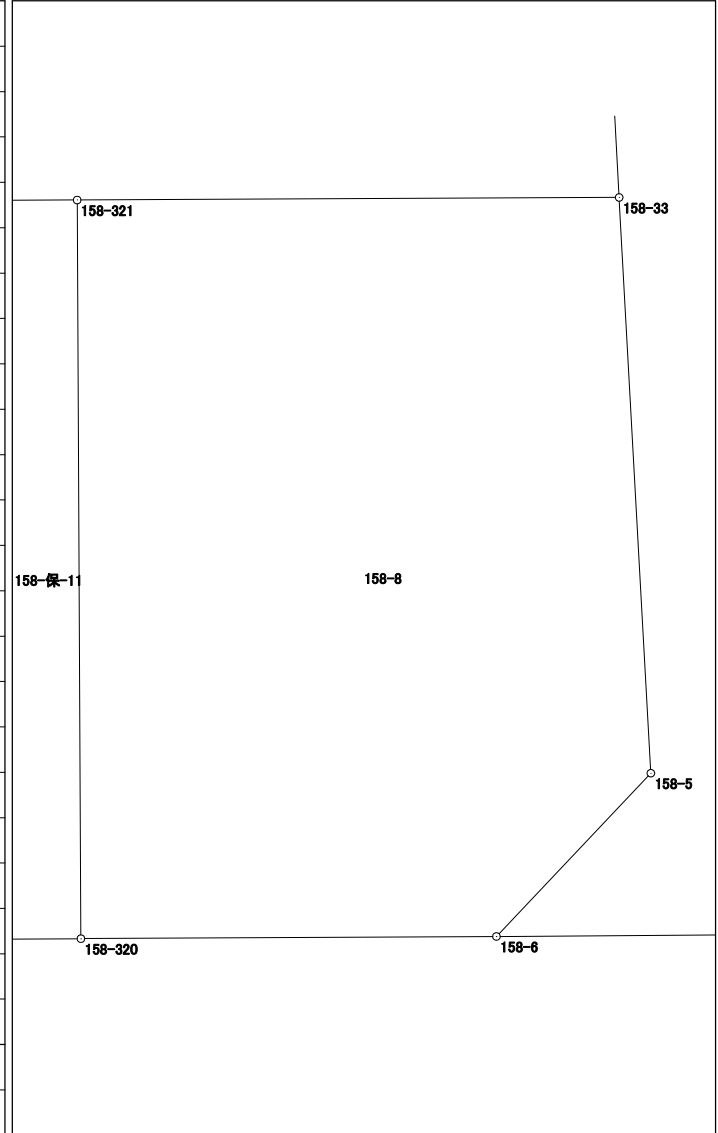

面積計算書（座標法）

世界測地系（測地成果2011）

| | | | | | |
|-----------|-------|------|------|-----------------------|-------|
| 所 在 | 地 番 | 公簿地目 | 現況地目 | 地 積 | 所 有 者 |
| 前橋市六供町五丁目 | 158-9 | | | 187.31 m ² | |


| 点 名 | X 座標 | Y 座標 | 辺 長 | 方 向 角 | 測 角 | DX | 倍 積 (Y×DX) | |
|---------|-----------|------------|--------|-----------|-----------|---------|----------------|-------------|
| 158-310 | 40861.195 | -67789.482 | 14.269 | 269-43-37 | 90-00-54 | 13.055 | -884991.687510 | |
| 158-37 | 40861.127 | -67803.751 | 3.508 | 179-42-22 | 89-58-45 | -3.576 | 242466.213576 | |
| 158-309 | 40857.619 | -67803.733 | 9.623 | 179-42-51 | 180-00-29 | -13.131 | 890330.818023 | |
| 158-38 | 40847.996 | -67803.685 | 14.269 | 89-41-41 | 89-58-50 | -9.547 | 647321.780695 | |
| 158-311 | 40848.072 | -67789.416 | 13.123 | 359-42-43 | 90-01-02 | 13.199 | -894752.501784 | |
| | | | | | | | | |
| | | | | | | | | |
| | | | | | | | 倍面積 | 374.623000 |
| | | | | | | | 面 積 | 187.3115000 |

面積計算書（座標法）

世界測地系（測地成果2011）

| 所在 | 地番 | 公簿地目 | 現況地目 | 地積 | 所有者 |
|-----------|--------|------|------|-----------------------|-----|
| 前橋市六供町五丁目 | 158-10 | | | 158.54 m ² | |

| 点名 | X座標 | Y座標 | 辺長 | 方向角 | 測角 | DX | 倍積 (Y×DX) |
|---------|-----------|------------|--------|-----------|----------|--------|----------------|
| 158-309 | 40857.619 | -67803.733 | 16.731 | 269-41-18 | 89-58-27 | 9.532 | -646305.182956 |
| 158-308 | 40857.528 | -67820.464 | 9.617 | 176-51-09 | 87-09-51 | -9.693 | 657383.757552 |
| 158-7 | 40847.926 | -67819.936 | 16.251 | 89-45-12 | 92-54-03 | -9.532 | 646459.629952 |
| 158-38 | 40847.996 | -67803.685 | 9.623 | 359-42-51 | 89-57-39 | 9.693 | -657221.118705 |
| | | | | | | | |
| | | | | | | | |
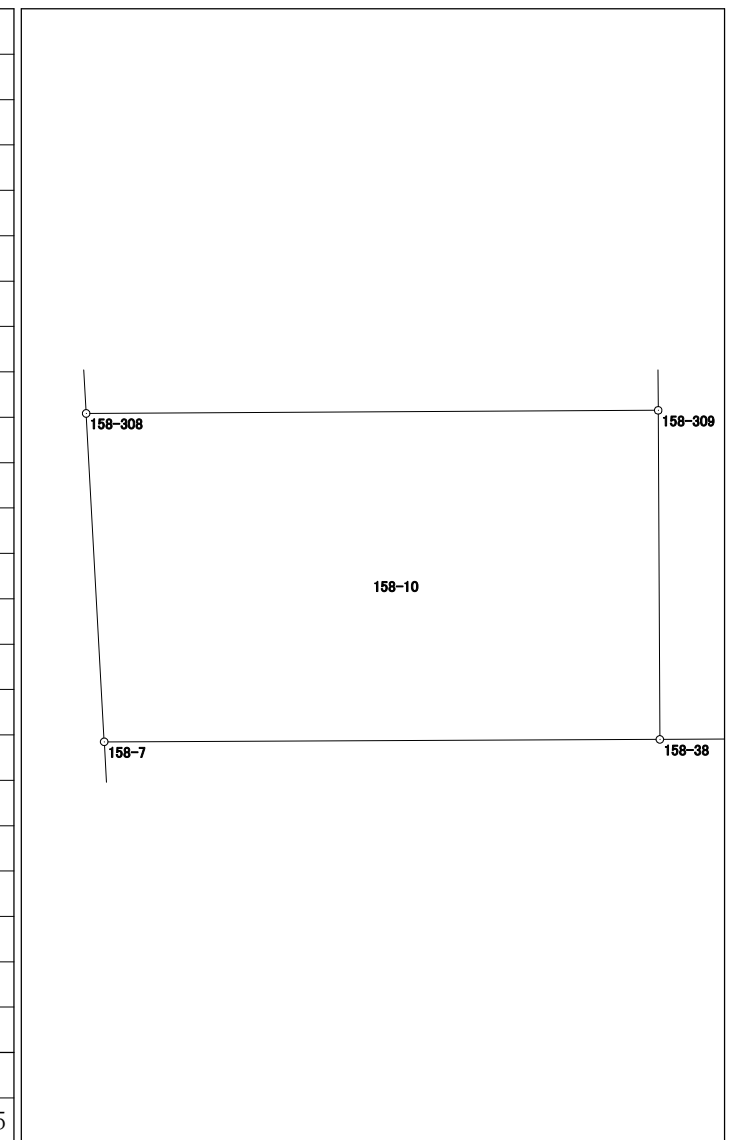


| | |
|-----|-------------|
| 倍面積 | 317.085843 |
| 面積 | 158.5429215 |

面積計算書 (座標法)

世界測地系 (測地成果2011)

| 所在 | 地番 | 公簿地目 | 現況地目 | 地積 | 所有者 |
|-----------|--------|------|------|-----------------------|-----|
| 前橋市六供町五丁目 | 158-12 | | | 109.79 m ² | |

| 点名 | X座標 | Y座標 | 辺長 | 方向角 | 測角 | D _X | 倍積 (Y×D _X) |
|---------|-----------|------------|--------|-----------|-----------|----------------|------------------------|
| 158-327 | 40877.965 | -67787.350 | 12.354 | 86-50-07 | 89-57-32 | -7.344 | 497830.298400 |
| 158-326 | 40878.647 | -67775.015 | 8.886 | 356-52-40 | 90-02-33 | 9.555 | -647590.268325 |
| 158-80 | 40887.520 | -67775.499 | 12.354 | 266-50-57 | 89-58-17 | 8.194 | -555352.438806 |
| 158-39 | 40886.841 | -67787.834 | 0.851 | 176-54-08 | 90-03-11 | -1.529 | 103647.598186 |
| 158-313 | 40885.991 | -67787.788 | 8.038 | 176-52-35 | 179-58-27 | -8.876 | 601684.406288 |
| | | | | | | | |
| | | | | | | | |
| | | | | | | 倍面積 | 219.595743 |
| | | | | | | 面積 | 109.7978715 |

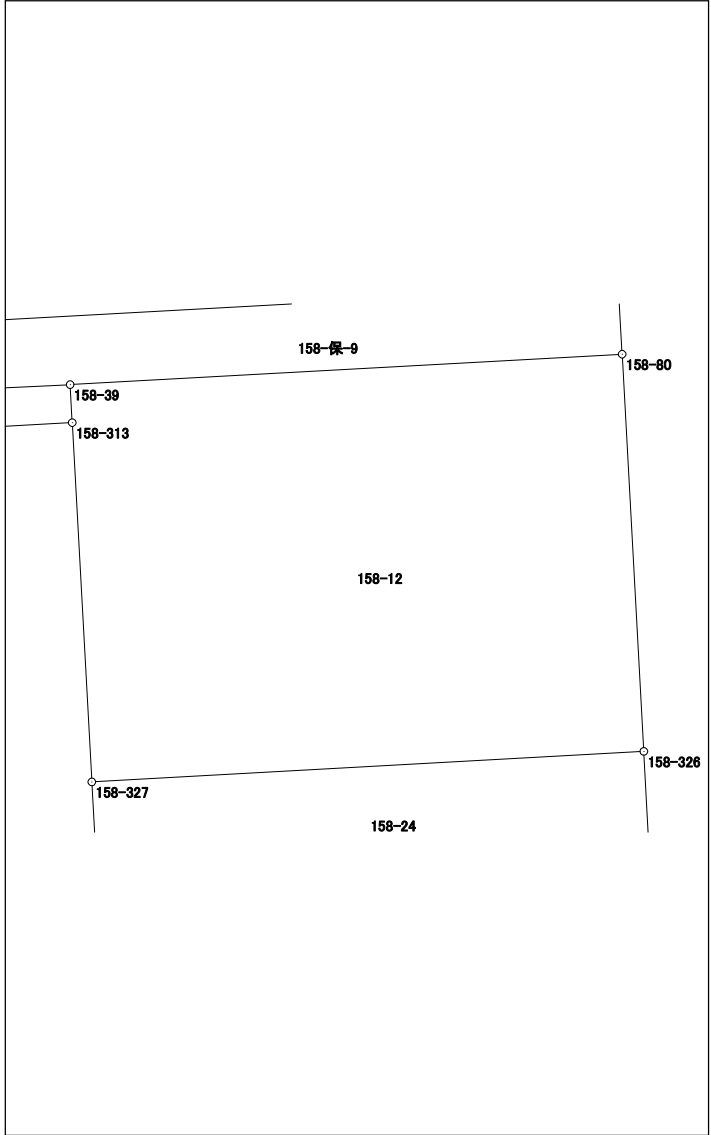

面積計算書 (座標法)

世界測地系 (測地成果2011)

| 所在 | 地番 | 公簿地目 | 現況地目 | 地積 | 所有者 |
|-----------|--------|------|------|-----------------------|-----|
| 前橋市六供町五丁目 | 158-13 | | | 138.62 m ² | |

| 点名 | X座標 | Y座標 | 辺長 | 方向角 | 測角 | DX | 倍積 (Y×DX) | |
|---------|-----------|------------|--------|-----------|----------|---------|----------------|--|
| 158-334 | 40911.762 | -67776.836 | 14.430 | 266-53-08 | 89-59-39 | 8.809 | -597046.148324 | |
| 158-335 | 40910.978 | -67791.245 | 9.607 | 176-52-24 | 89-59-16 | -10.377 | 703469.749365 | |
| 158-333 | 40901.385 | -67790.721 | 14.427 | 86-53-06 | 90-00-42 | -8.809 | 597168.461289 | |
| 158-332 | 40902.169 | -67776.315 | 9.607 | 356-53-29 | 90-00-23 | 10.377 | -703314.820755 | |
| | | | | | | | | |
| | | | | | | | | |
| | |
|-----|-------------|
| 倍面積 | 277.241575 |
| 面積 | 138.6207875 |

面積計算書 (座標法)

世界測地系 (測地成果2011)

| | | | | | |
|-----------|--------|------|------|---------------------|-----|
| 所在 | 地番 | 公簿地目 | 現況地目 | 地積 | 所有者 |
| 前橋市六供町五丁目 | 158-14 | | | 3.87 m ² | |

| 点名 | X座標 | Y座標 | 辺長 | 方向角 | 測角 | DX | 倍積 (Y×DX) |
|---------|-----------|------------|--------|-----------|----------|---------|----------------|
| 158-318 | 40848.090 | -67785.919 | 13.122 | 359-42-27 | 89-54-06 | 13.123 | -889554.615037 |
| 158-319 | 40861.212 | -67785.986 | 0.295 | 269-48-21 | 90-05-54 | 13.121 | -889419.922306 |
| 158-317 | 40861.211 | -67786.281 | 13.122 | 179-42-27 | 89-54-06 | -13.123 | 889559.365563 |
| 158-316 | 40848.089 | -67786.214 | 0.295 | 89-48-21 | 90-05-54 | -13.121 | 889422.913894 |
| | | | | | | | |
| | | | | | | | |
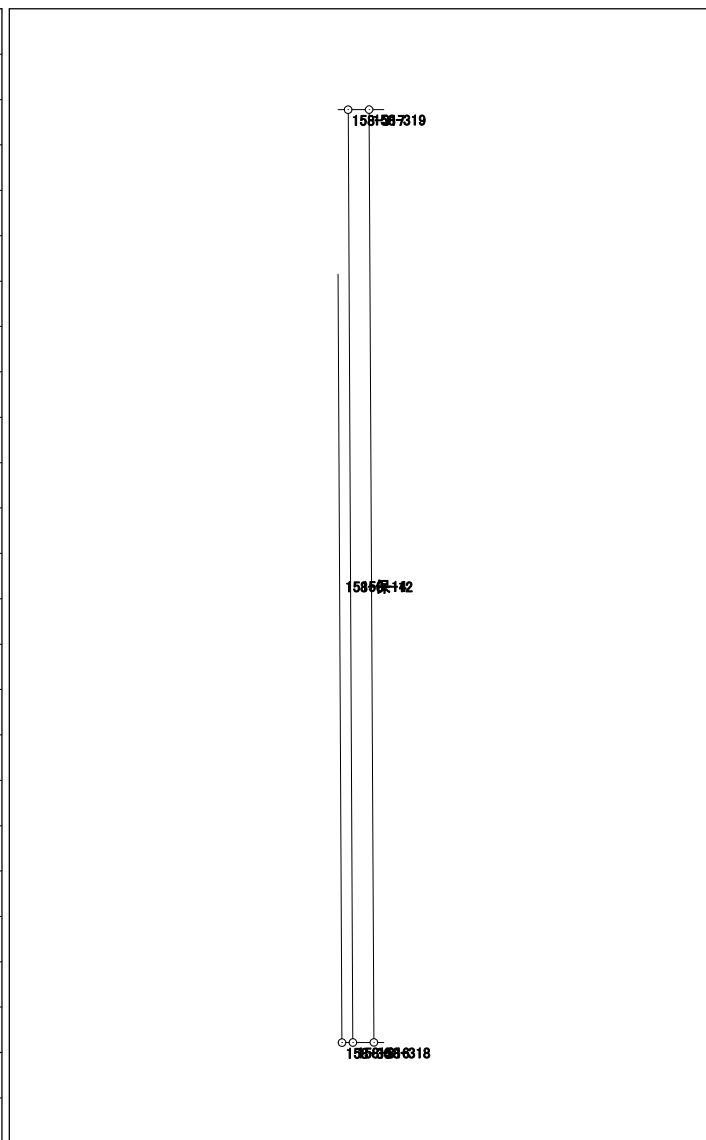


| | |
|-----|-----------|
| 倍面積 | 7.742114 |
| 面積 | 3.8710570 |

面積計算書 (座標法)

世界測地系 (測地成果2011)

| | | | | | |
|-----------|--------|------|------|-----------------------|-----|
| 所在 | 地番 | 公簿地目 | 現況地目 | 地積 | 所有者 |
| 前橋市六供町五丁目 | 158-18 | | | 148.65 m ² | |

| 点名 | X座標 | Y座標 | 辺長 | 方向角 | 測角 | DX | 倍積 (Y×DX) |
|---------|-----------|------------|--------|-----------|-----------|---------|----------------|
| 158-305 | 40949.615 | -67791.475 | 11.993 | 176-54-27 | 90-01-42 | -12.660 | 858240.073500 |
| 158-64 | 40937.639 | -67790.828 | 10.569 | 86-48-00 | 89-53-33 | -11.386 | 771866.367608 |
| 158-60 | 40938.229 | -67780.275 | 2.821 | 42-11-01 | 135-23-01 | 2.680 | -181651.137000 |
| 158-59 | 40940.319 | -67778.381 | 9.995 | 356-51-05 | 134-40-04 | 12.070 | -818085.058670 |
| 158-20 | 40950.299 | -67778.930 | 12.564 | 266-52-45 | 90-01-40 | 9.296 | -630072.933280 |
| | | | | | | | |
| | | | | | | | |
| 倍面積 | | | | | | | 297.312158 |
| 面積 | | | | | | | 148.6560790 |

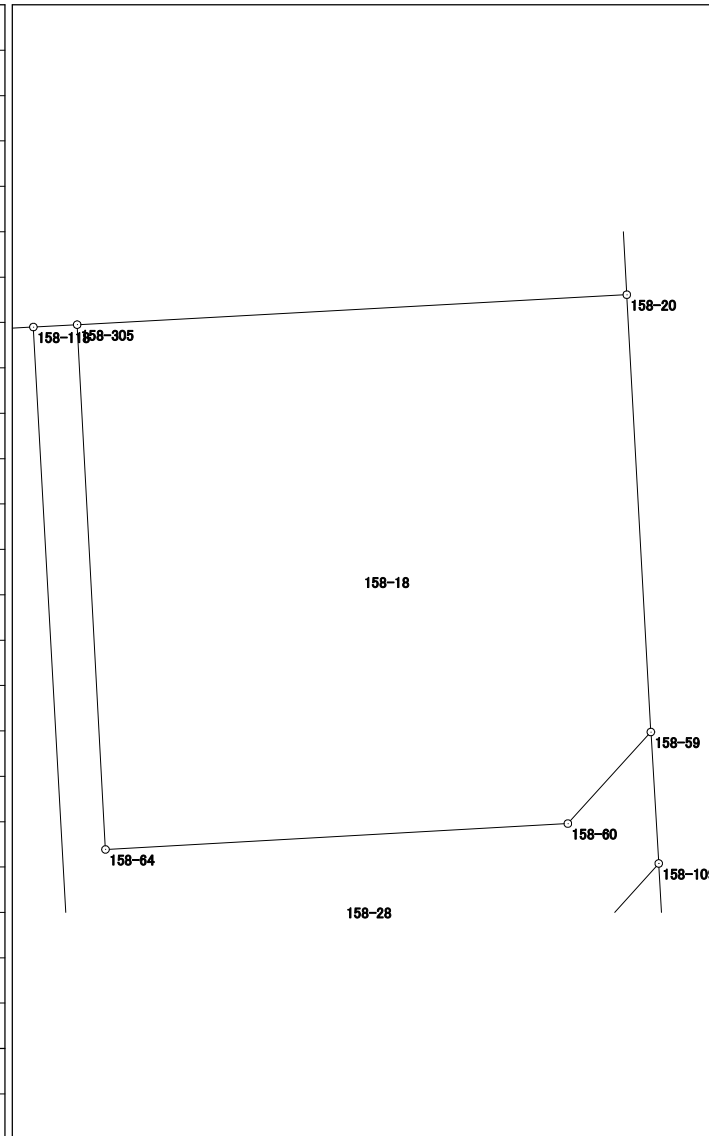


面積計算書 (座標法)

世界測地系 (測地成果2011)

| 所在 | 地番 | 公簿地目 | 現況地目 | 地積 | 所有者 |
|-----------|--------|------|------|----------------------|-----|
| 前橋市六供町五丁目 | 158-20 | | | 73.39 m ² | |

| 点名 | X座標 | Y座標 | 辺長 | 方向角 | 測角 | DX | 倍積(Y×DX) |
|-----------|-----------|------------|--------|-----------|-----------|--------|----------------|
| 158-45 | 40918.807 | -67777.214 | 11.993 | 266-55-19 | 89-58-43 | 4.431 | -300320.835234 |
| 158-106 | 40918.163 | -67789.190 | 2.445 | 266-47-16 | 179-51-57 | -0.781 | 52943.357390 |
| 158-46 | 40918.026 | -67791.631 | 5.083 | 176-51-52 | 90-04-36 | -5.212 | 353329.980772 |
| 158-25 | 40912.951 | -67791.353 | 14.431 | 86-53-52 | 90-02-00 | -4.294 | 291096.069782 |
| 158-123-1 | 40913.732 | -67776.943 | 5.082 | 356-56-36 | 90-02-44 | 5.856 | -396901.778208 |
| | | | | | | | |
| | | | | | | | |
| | |
|-----|------------|
| 倍面積 | 146.794502 |
| 面積 | 73.3972510 |

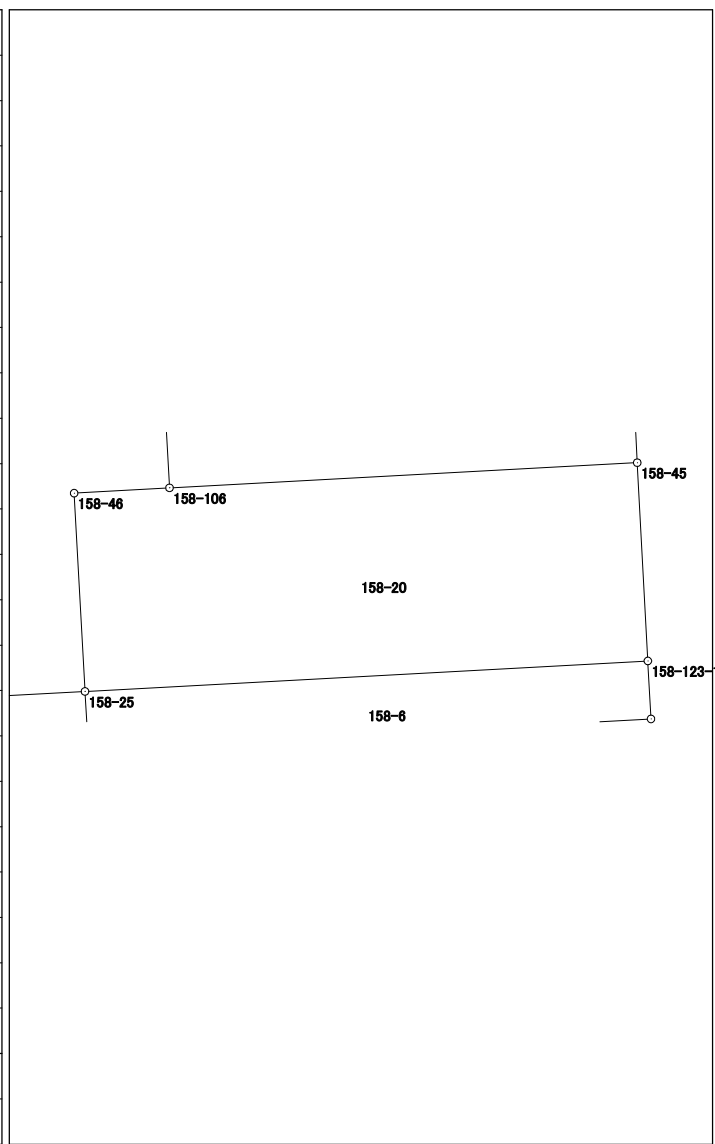


面積計算書 (座標法)

世界測地系 (測地成果2011)

| | | | | | |
|-----------|--------|------|------|----------------------|-------|
| 所 在 | 地 番 | 公簿地目 | 現況地目 | 地 積 | 所 有 者 |
| 前橋市六供町五丁目 | 158-21 | | | 61.50 m ² | |

| 点 名 | X 座標 | Y 座標 | 辺 長 | 方 向 角 | 測 角 | DX | 倍 積 (Y×DX) |
|---------|-----------|------------|--------|-----------|----------|--------|----------------|
| 158-330 | 40898.293 | -67776.105 | 14.423 | 266-52-48 | 89-59-53 | 3.474 | -235454.188770 |
| 158-331 | 40897.508 | -67790.507 | 4.265 | 176-48-51 | 89-56-03 | -5.043 | 341867.526801 |
| 158-329 | 40893.250 | -67790.270 | 14.418 | 86-52-59 | 90-04-08 | -3.474 | 235503.397980 |
| 158-328 | 40894.034 | -67775.873 | 4.265 | 356-52-55 | 89-59-56 | 5.043 | -341793.727539 |
| | | | | | | | |
| | | | | | | | |
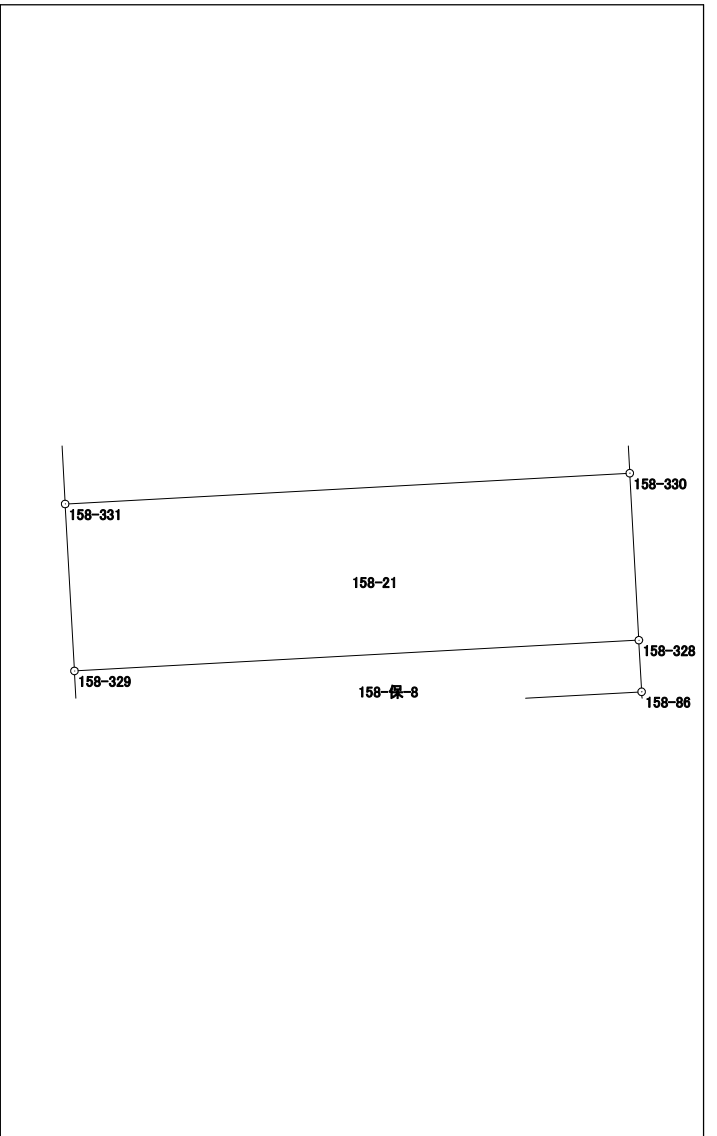


| | |
|-----|------------|
| 倍面積 | 123.008472 |
| 面 積 | 61.5042360 |

面積計算書（座標法）

世界測地系（測地成果2011）

| 所 在 | 地 番 | 公簿地目 | 現況地目 | 地 積 | 所 有 者 |
|-----------|--------|------|------|----------------------|-------|
| 前橋市六供町五丁目 | 158-24 | | | 26.87 m ² | |

| 点 名 | X 座 標 | Y 座 標 | 辺 長 | 方 向 角 | 測 角 | DX | 倍 積 (Y×DX) |
|---------|-----------|------------|--------|-----------|----------|--------|----------------|
| 158-326 | 40878.647 | -67775.015 | 12.354 | 266-50-07 | 89-56-42 | 1.490 | -100984.772350 |
| 158-327 | 40877.965 | -67787.350 | 2.175 | 176-51-50 | 90-01-43 | -2.854 | 193465.096900 |
| 158-325 | 40875.793 | -67787.231 | 12.353 | 86-50-06 | 89-58-16 | -1.490 | 101002.974190 |
| 158-324 | 40876.475 | -67774.897 | 2.175 | 356-53-25 | 90-03-19 | 2.854 | -193429.556038 |
| | | | | | | | |
| | | | | | | | |
| | | | | | | 倍面積 | 53.742702 |
| | | | | | | 面 積 | 26.8713510 |

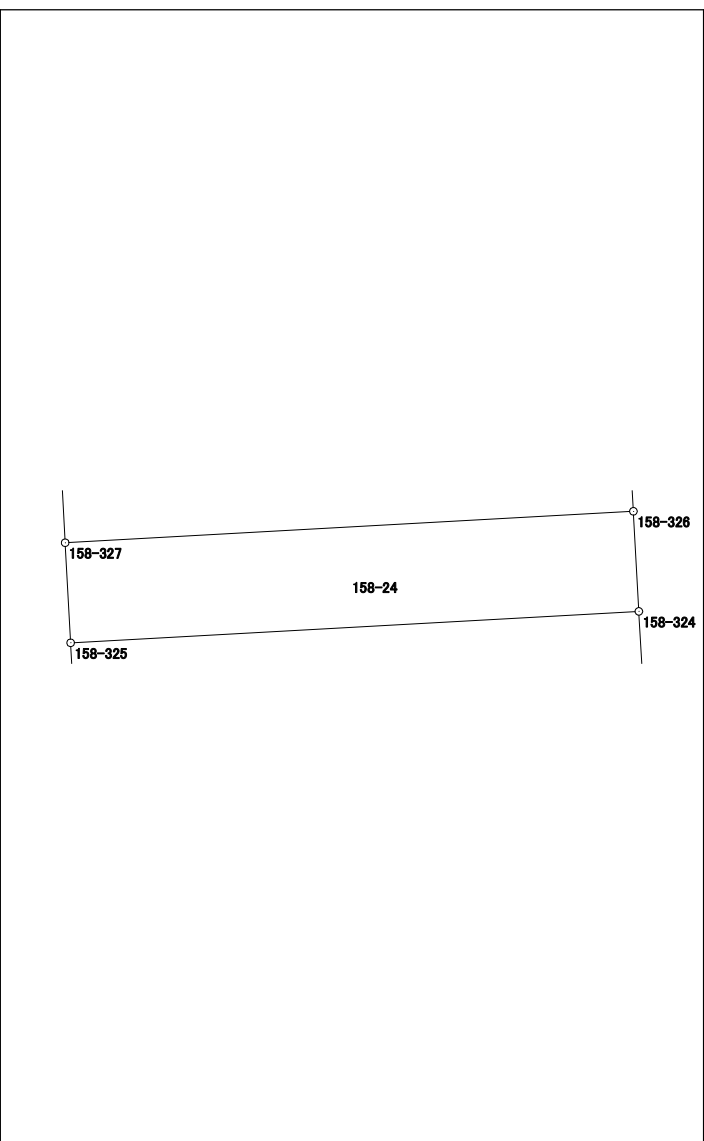

面積計算書 (座標法)

世界測地系 (測地成果2011)

| | | | | | |
|-----------|--------|------|------|----------------------|-----|
| 所在 | 地番 | 公簿地目 | 現況地目 | 地積 | 所有者 |
| 前橋市六供町五丁目 | 158-36 | | | 65.57 m ² | |

| 点名 | X座標 | Y座標 | 辺長 | 方向角 | 測角 | DX | 倍積 (Y×DX) | |
|---------|-----------|------------|--------|-----------|-----------|--------|----------------|--|
| 158-24 | 40911.235 | -67822.892 | 3.527 | 176-52-47 | 90-00-29 | -4.128 | 279972.898176 | |
| 158-307 | 40907.713 | -67822.700 | 18.588 | 86-52-44 | 89-59-57 | -2.510 | 170234.977000 | |
| 158-306 | 40908.725 | -67804.140 | 3.527 | 356-50-50 | 89-58-06 | 4.534 | -307423.970760 | |
| 158-136 | 40912.247 | -67804.334 | 7.481 | 266-53-20 | 90-02-30 | 3.116 | -211278.304744 | |
| 158-141 | 40911.841 | -67811.804 | 11.105 | 266-52-18 | 179-58-58 | -1.012 | 68625.545648 | |
| | | | | | | | | |
| | | | | | | | | |
| | | | | | | 倍面積 | 131.145320 | |
| | | | | | | 面積 | 65.5726600 | |


面積計算書 (座標法)

世界測地系 (測地成果2011)

| 所在 | 地番 | 公簿地目 | 現況地目 | 地積 | 所有者 |
|-----------|---------|------|------|----------------------|-----|
| 前橋市六供町五丁目 | 158-保-1 | | | 94.00 m ² | |

| 点名 | X座標 | Y座標 | 辺長 | 方向角 | 測角 | DX | 倍積 (Y×DX) |
|---------|-----------|------------|--------|-----------|-----------|---------|-----------------|
| 158-304 | 40974.022 | -67795.793 | 3.812 | 269-45-34 | 92-54-11 | 24.547 | -1664183.330771 |
| 158-17 | 40974.006 | -67799.605 | 20.357 | 176-51-26 | 87-05-52 | -20.342 | 1379179.564910 |
| 158-301 | 40953.680 | -67798.489 | 4.422 | 176-51-45 | 180-00-19 | -24.741 | 1677402.416349 |
| 158-18 | 40949.265 | -67798.247 | 3.808 | 87-04-47 | 90-13-02 | -4.221 | 286176.400587 |
| 158-303 | 40949.459 | -67794.444 | 24.600 | 356-51-23 | 89-46-36 | 24.757 | -1678387.050108 |
| | | | | | | | |
| | | | | | | | |
| | |
|-----|------------|
| 倍面積 | 188.000967 |
| 面積 | 94.0004835 |

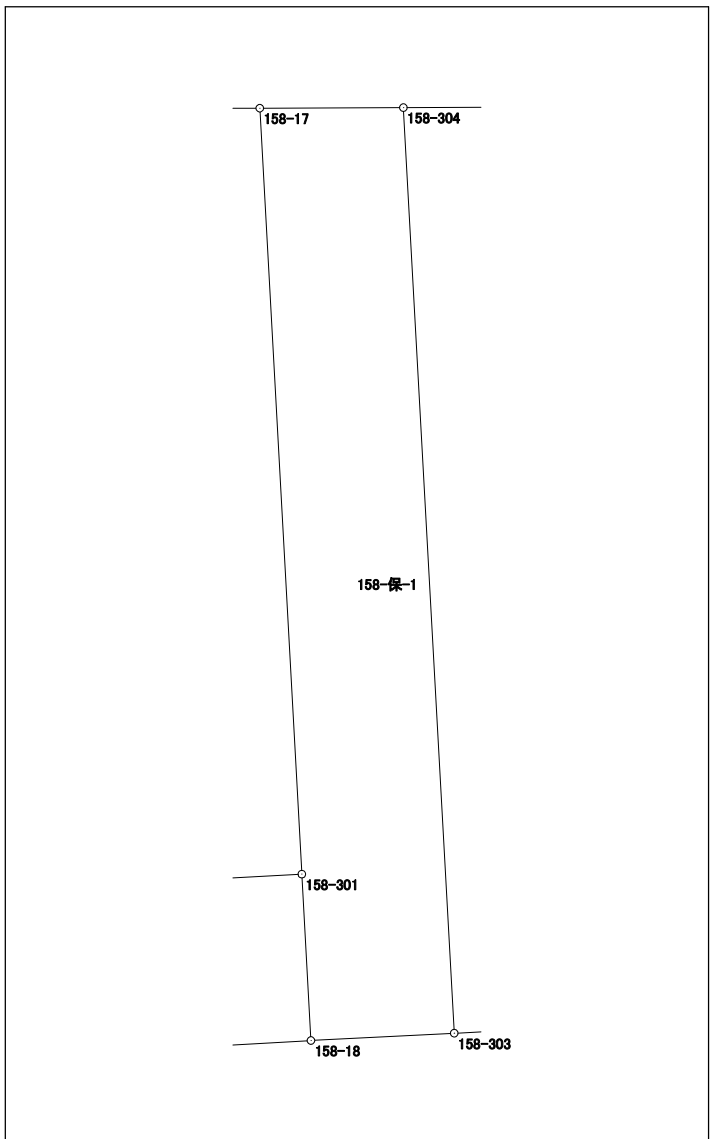


面積計算書（座標法）

世界測地系（測地成果2011）

| | | | | | |
|-----------|---------|------|------|----------------------|-----|
| 所在 | 地番 | 公簿地目 | 現況地目 | 地積 | 所有者 |
| 前橋市六供町五丁目 | 158-保-4 | | | 75.00 m ² | |

| 点名 | X座標 | Y座標 | 辺長 | 方向角 | 測角 | DX | 倍積 (Y×DX) |
|---------|-----------|------------|--------|-----------|-----------|--------|----------------|
| 158-341 | 40867.301 | -67786.657 | 6.095 | 177-54-12 | 88-10-28 | -6.149 | 416820.153893 |
| 158-35 | 40861.210 | -67786.434 | 0.153 | 89-37-32 | 91-43-20 | -6.090 | 412819.383060 |
| 158-317 | 40861.211 | -67786.281 | 0.295 | 89-48-21 | 180-10-49 | 0.002 | -135.572562 |
| 158-319 | 40861.212 | -67785.986 | 2.287 | 89-44-58 | 179-56-37 | 0.011 | -745.645846 |
| 158-321 | 40861.222 | -67783.699 | 9.629 | 89-43-35 | 179-58-37 | 0.056 | -3795.887144 |
| 158-33 | 40861.268 | -67774.070 | 6.100 | 356-53-22 | 87-09-47 | 6.137 | -415929.467590 |
| 158-340 | 40867.359 | -67774.401 | 12.256 | 269-43-44 | 92-50-22 | 6.033 | -408882.961233 |
| | | | | | | | |
| | | | | | | | |
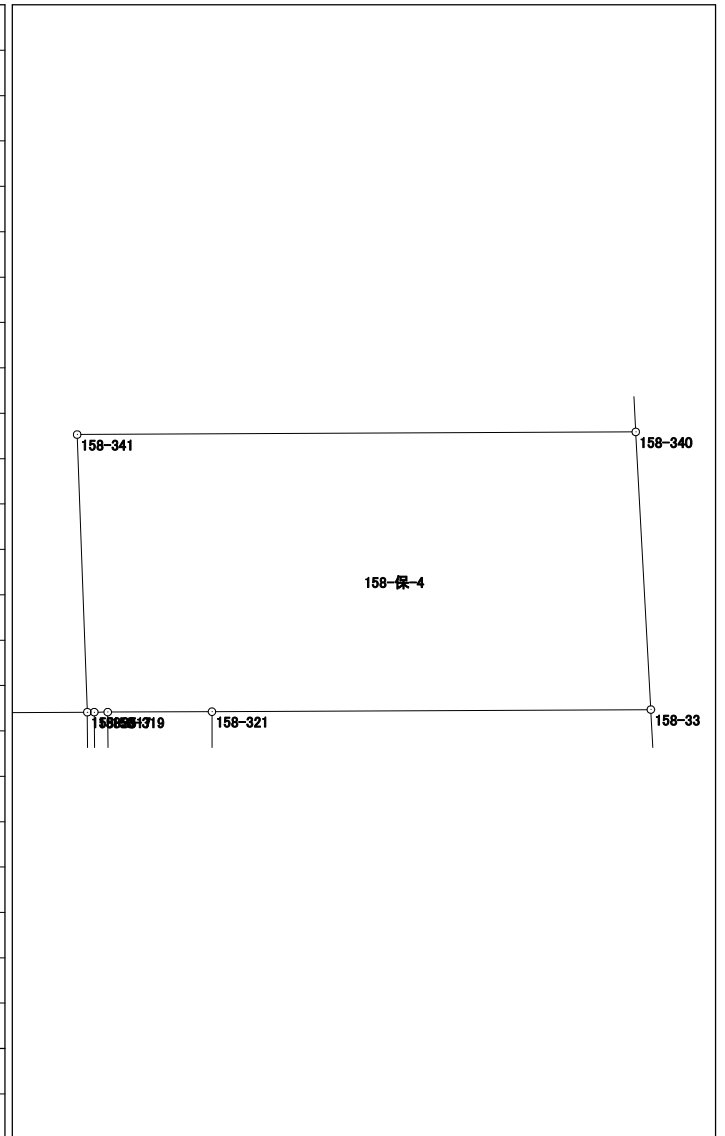


| | |
|-----|------------|
| 倍面積 | 150.002578 |
| 面積 | 75.0012890 |

面積計算書（座標法）

世界測地系（測地成果2011）

| | | | | | |
|-----------|---------|------|------|----------------------|-------|
| 所 在 | 地 番 | 公簿地目 | 現況地目 | 地 積 | 所 有 者 |
| 前橋市六供町五丁目 | 158-保-6 | | | 40.00 m ² | |

| 点 名 | X 座標 | Y 座標 | 辺 長 | 方 向 角 | 測 角 | DX | 倍 積 (Y×DX) |
|---------|-----------|------------|--------|-----------|----------|------------|----------------|
| 158-310 | 40861.195 | -67789.482 | 13.123 | 179-42-43 | 89-59-38 | -13.138 | 890618.214516 |
| 158-311 | 40848.072 | -67789.416 | 3.049 | 89-41-58 | 89-59-15 | -13.107 | 888515.875512 |
| 158-36 | 40848.088 | -67786.367 | 13.122 | 359-42-27 | 90-00-29 | 13.138 | -890577.289646 |
| 158-35 | 40861.210 | -67786.434 | 3.048 | 269-43-05 | 90-00-38 | 13.107 | -888476.790438 |
| | | | | | | | |
| | | | | | | | |
| 倍面積 | | | | | | 80.009944 | |
| 面 積 | | | | | | 40.0049720 | |

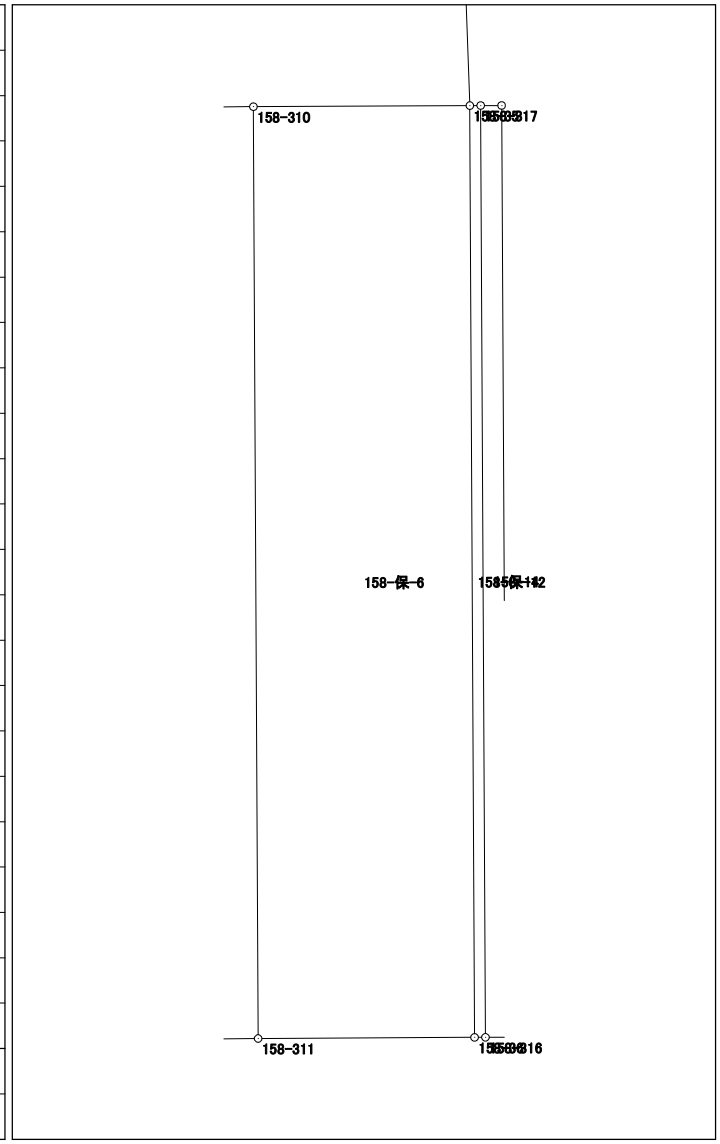


面積計算書 (座標法)

世界測地系 (測地成果2011)

| 所在 | 地番 | 公簿地目 | 現況地目 | 地積 | 所有者 |
|-----------|---------|------|------|----------------------|-----|
| 前橋市六供町五丁目 | 158-保-7 | | | 59.00 m ² | |

| 点名 | X座標 | Y座標 | 辺長 | 方向角 | 測角 | DX | 倍積 (Y×DX) |
|---------|-----------|------------|--------|-----------|----------|--------|----------------|
| 158-308 | 40857.528 | -67820.464 | 16.731 | 89-41-18 | 92-50-18 | -3.416 | 231674.705024 |
| 158-309 | 40857.619 | -67803.733 | 3.508 | 359-42-22 | 90-01-04 | 3.599 | -244025.635067 |
| 158-37 | 40861.127 | -67803.751 | 16.906 | 269-41-18 | 89-58-56 | 3.416 | -231617.613416 |
| 158-34 | 40861.035 | -67820.657 | 3.512 | 176-51-00 | 87-09-42 | -3.599 | 244086.544543 |
| | | | | | | | |
| | | | | | | | |
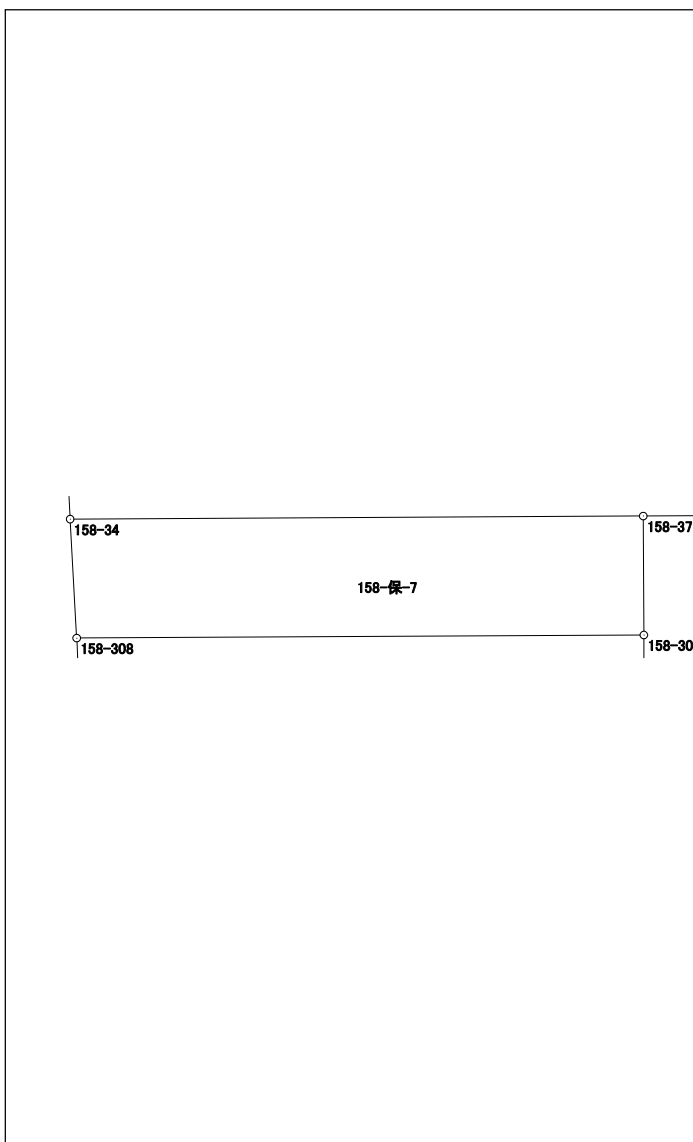


| | |
|-----|------------|
| 倍面積 | 118.001084 |
| 面積 | 59.0005420 |

面積計算書 (座標法)

世界測地系 (測地成果2011)

| 所 在 | 地 番 | 公簿地目 | 現況地目 | 地 積 | 所 有 者 |
|-----------|---------|------|------|----------------------|-------|
| 前橋市六供町五丁目 | 158-保-8 | | | 19.00 m ² | |

| 点 名 | X 座標 | Y 座標 | 辺 長 | 方 向 角 | 測 角 | DX | 倍 積 (Y×DX) |
|---------|-----------|------------|--------|-----------|----------|--------|----------------|
| 158-328 | 40894.034 | -67775.873 | 14.418 | 266-52-59 | 89-58-16 | 0.532 | -36056.764436 |
| 158-329 | 40893.250 | -67790.270 | 1.318 | 176-49-30 | 89-56-31 | -2.100 | 142359.567000 |
| 158-85 | 40891.934 | -67790.197 | 14.416 | 86-52-57 | 90-03-27 | -0.532 | 36064.384804 |
| 158-86 | 40892.718 | -67775.802 | 1.318 | 356-54-43 | 90-01-46 | 2.100 | -142329.184200 |
| | | | | | | | |
| | | | | | | | |
| | | | | | | 倍面積 | 38.003168 |
| | | | | | | 面 積 | 19.0015840 |

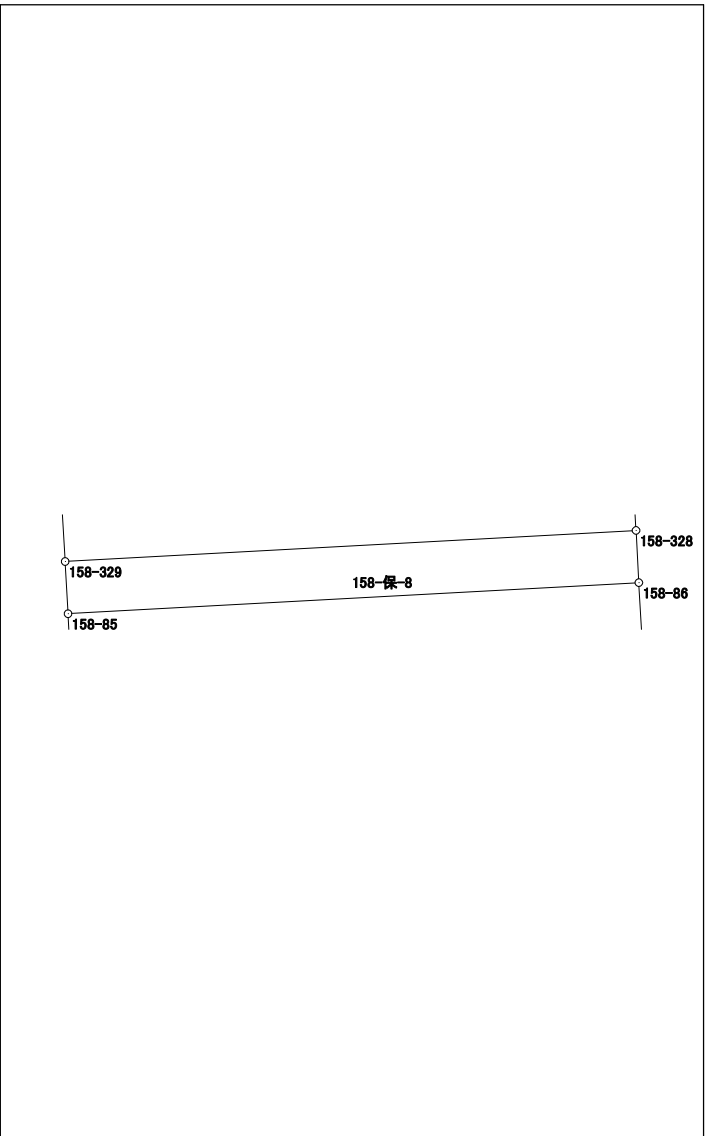


面積計算書（座標法）

世界測地系（測地成果2011）

| | | | | | |
|-----------|---------|------|------|----------------------|-------|
| 所 在 | 地 番 | 公簿地目 | 現況地目 | 地 積 | 所 有 者 |
| 前橋市六供町五丁目 | 158-保-9 | | | 22.00 m ² | |

| 点 名 | X 座標 | Y 座標 | 辺 長 | 方 向 角 | 測 角 | DX | 倍 積 (Y×DX) |
|---------|-----------|------------|--------|-----------|-----------|--------|----------------|
| 158-314 | 40889.037 | -67775.587 | 14.432 | 266-53-38 | 90-12-50 | 0.735 | -49815.056445 |
| 158-315 | 40888.255 | -67789.998 | 1.520 | 176-54-29 | 90-00-51 | -2.300 | 155916.995400 |
| 158-26 | 40886.737 | -67789.916 | 2.085 | 87-08-25 | 90-13-56 | -1.414 | 95854.941224 |
| 158-39 | 40886.841 | -67787.834 | 12.354 | 86-50-57 | 179-42-32 | 0.783 | -53077.874022 |
| 158-80 | 40887.520 | -67775.499 | 1.520 | 356-40-48 | 89-49-51 | 2.196 | -148834.995804 |
| | | | | | | | |
| | | | | | | | |
| | | | | | | 倍面積 | 44.010353 |
| | | | | | | 面 積 | 22.0051765 |

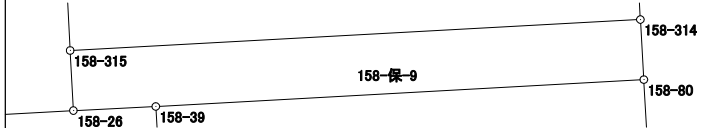

面積計算書（座標法）

世界測地系（測地成果2011）

| | | | | | |
|-----------|----------|------|------|----------------------|-------|
| 所 在 | 地 番 | 公簿地目 | 現況地目 | 地 積 | 所 有 者 |
| 前橋市六供町五丁目 | 158-保-10 | | | 56.00 m ² | |


| 点 名 | X 座標 | Y 座標 | 辺 長 | 方 向 角 | 測 角 | DX | 倍 積 (Y×DX) | |
|---------|-----------|------------|--------|-----------|-----------|--------|----------------|--|
| 158-332 | 40902.169 | -67776.315 | 14.427 | 266-53-06 | 89-59-10 | 3.092 | -209564.365980 | |
| 158-333 | 40901.385 | -67790.721 | 1.538 | 176-52-11 | 89-59-05 | -2.320 | 157274.472720 | |
| 158-120 | 40899.849 | -67790.637 | 2.345 | 176-49-17 | 179-57-06 | -3.877 | 262824.299649 | |
| 158-331 | 40897.508 | -67790.507 | 14.423 | 86-52-48 | 90-03-31 | -1.556 | 105482.028892 | |
| 158-330 | 40898.293 | -67776.105 | 3.882 | 356-53-56 | 90-01-08 | 4.661 | -315904.425405 | |
| | | | | | | | | |
| | | | | | | | | |
| | | | | | | 倍面積 | 112.009876 | |
| | | | | | | 面 積 | 56.0049380 | |

面積計算書 (座標法)

世界測地系 (測地成果2011)

| 所在 | 地番 | 公簿地目 | 現況地目 | 地積 | 所有者 |
|-----------|----------|------|------|----------------------|-----|
| 前橋市六供町五丁目 | 158-保-11 | | | 30.00 m ² | |

| 点名 | X座標 | Y座標 | 辺長 | 方向角 | 測角 | DX | 倍積 (Y×DX) |
|---------|-----------|------------|--------|-----------|----------|---------|----------------|
| 158-320 | 40848.102 | -67783.632 | 13.120 | 359-42-27 | 90-00-29 | 13.132 | -890134.655424 |
| 158-321 | 40861.222 | -67783.699 | 2.287 | 269-44-58 | 90-02-31 | 13.110 | -888644.293890 |
| 158-319 | 40861.212 | -67785.986 | 13.122 | 179-42-27 | 89-57-29 | -13.132 | 890165.568152 |
| 158-318 | 40848.090 | -67785.919 | 2.287 | 89-41-58 | 89-59-31 | -13.110 | 888673.398090 |
| | | | | | | | |
| | | | | | | | |
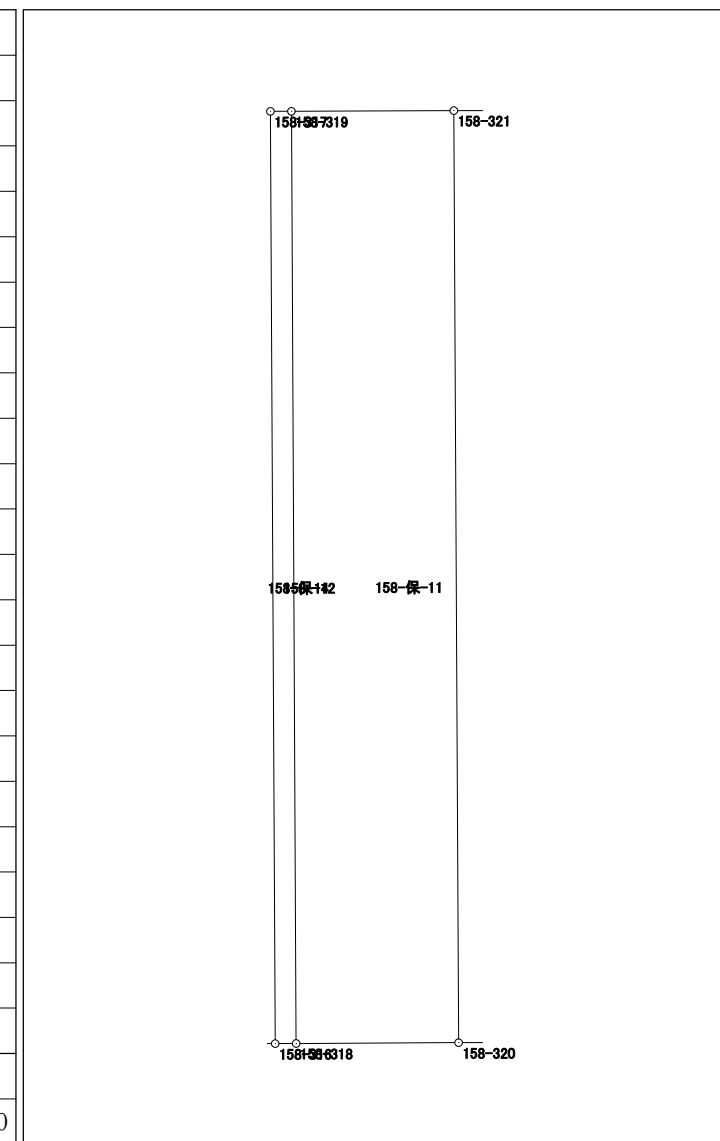

| | |
|-----|------------|
| 倍面積 | 60.016928 |
| 面積 | 30.0084640 |

面積計算書 (座標法)

世界測地系 (測地成果2011)

| | | | | | |
|-----------|----------|------|------|---------------------|-----|
| 所在 | 地番 | 公簿地目 | 現況地目 | 地積 | 所有者 |
| 前橋市六供町五丁目 | 158-保-12 | | | 2.00 m ² | |


| 点名 | X座標 | Y座標 | 辺長 | 方向角 | 測角 | DX | 倍積 (Y×DX) | | |
|---------|-----------|------------|--------|-----------|----------|---------|----------------|--|-----------|
| 158-316 | 40848.089 | -67786.214 | 13.122 | 359-42-27 | 90-04-55 | 13.123 | -889558.486322 | | |
| 158-317 | 40861.211 | -67786.281 | 0.153 | 269-37-32 | 89-55-05 | 13.121 | -889423.793001 | | |
| 158-35 | 40861.210 | -67786.434 | 13.122 | 179-42-27 | 90-04-55 | -13.123 | 889561.373382 | | |
| 158-36 | 40848.088 | -67786.367 | 0.153 | 89-37-32 | 89-55-05 | -13.121 | 889424.921407 | | |
| | | | | | | | | | |
| | | | | | | | | | |
| | | | | | | | 倍面積 | | 4.015466 |
| | | | | | | | 面積 | | 2.0077330 |

面積計算書 (座標法)

世界測地系 (測地成果2011)

| 所 在 | 地 番 | 公簿地目 | 現況地目 | 地 積 | 所 有 者 |
|-----------|----------|------|------|---------------------|-------|
| 前橋市六供町五丁目 | 158-保-13 | | | 7.00 m ² | |

| 点 名 | X 座標 | Y 座標 | 辺 長 | 方 向 角 | 測 角 | DX | 倍 積 (Y×DX) |
|---------|-----------|------------|--------|-----------|----------|--------|---------------|
| 158-336 | 40912.247 | -67776.862 | 14.431 | 266-52-55 | 89-57-02 | -0.300 | 20333.058600 |
| 158-337 | 40911.462 | -67791.272 | 0.485 | 176-48-25 | 89-55-30 | -1.269 | 86027.124168 |
| 158-335 | 40910.978 | -67791.245 | 14.430 | 86-53-08 | 90-04-43 | 0.300 | -20337.373500 |
| 158-334 | 40911.762 | -67776.836 | 0.486 | 356-55-53 | 90-02-45 | 1.269 | -86008.804884 |
| | | | | | | | |
| | | | | | | | |
| | | | | | | 倍面積 | 14.004384 |
| | | | | | | 面 積 | 7.0021920 |

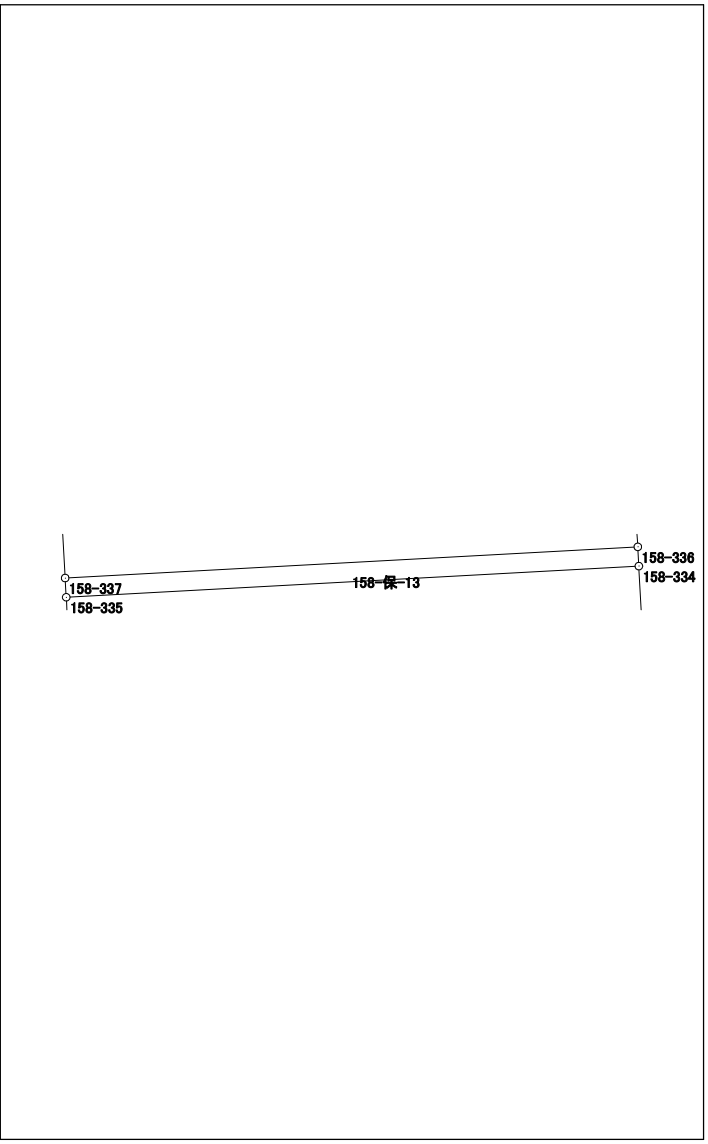


面積計算書（座標法）

世界測地系（測地成果2011）

| | | | | | |
|-----------|----------|------|------|---------------------|-----|
| 所在 | 地番 | 公簿地目 | 現況地目 | 地積 | 所有者 |
| 前橋市六供町五丁目 | 158-保-15 | | | 9.00 m ² | |

| 点名 | X座標 | Y座標 | 辺長 | 方向角 | 測角 | DX | 倍積 (Y×DX) |
|---------|-----------|------------|--------|-----------|----------|--------|---------------|
| 158-322 | 40873.645 | -67774.743 | 12.353 | 266-50-23 | 89-59-05 | 0.047 | -3185.412921 |
| 158-323 | 40872.964 | -67787.077 | 0.729 | 176-51-18 | 90-00-55 | -1.409 | 95511.991493 |
| 158-32 | 40872.236 | -67787.037 | 12.353 | 86-50-23 | 89-59-05 | -0.047 | 3185.990739 |
| 158-31 | 40872.917 | -67774.703 | 0.729 | 356-51-18 | 90-00-55 | 1.409 | -95494.556527 |
| | | | | | | | |
| | | | | | | | |
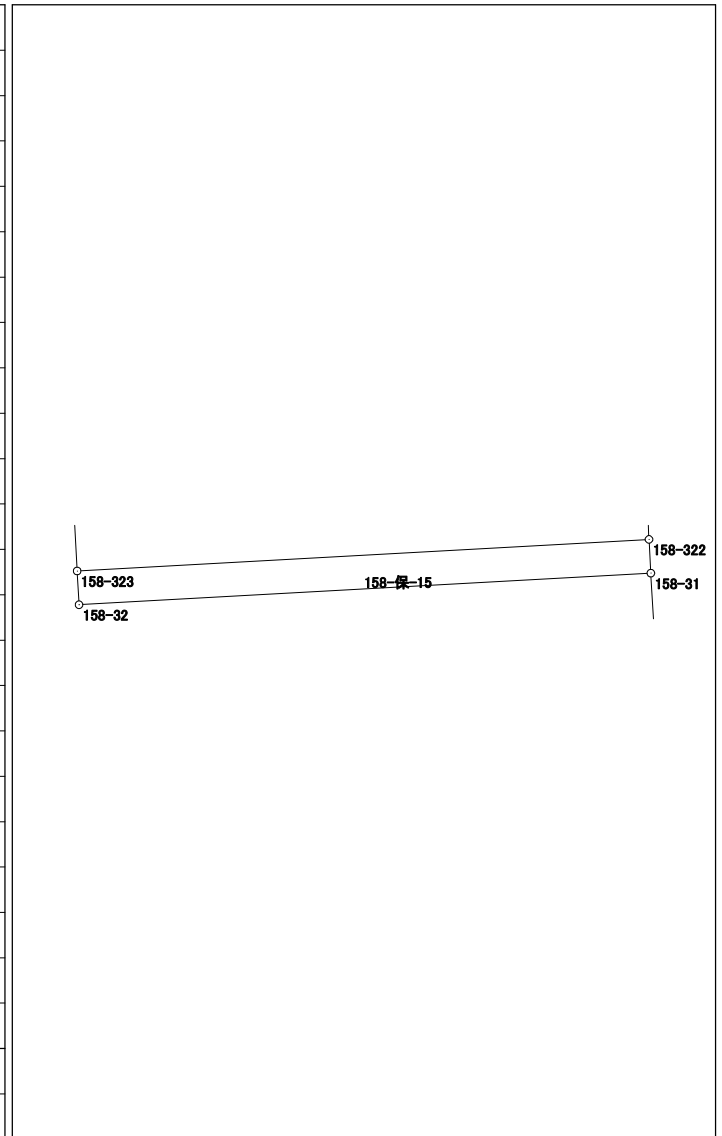

| | |
|-----|-----------|
| 倍面積 | 18.012784 |
| 面積 | 9.0063920 |