



166街区 画地出来形確認図 (6172.00m²)

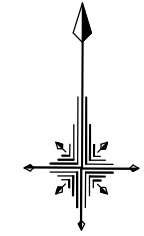

S=1/500

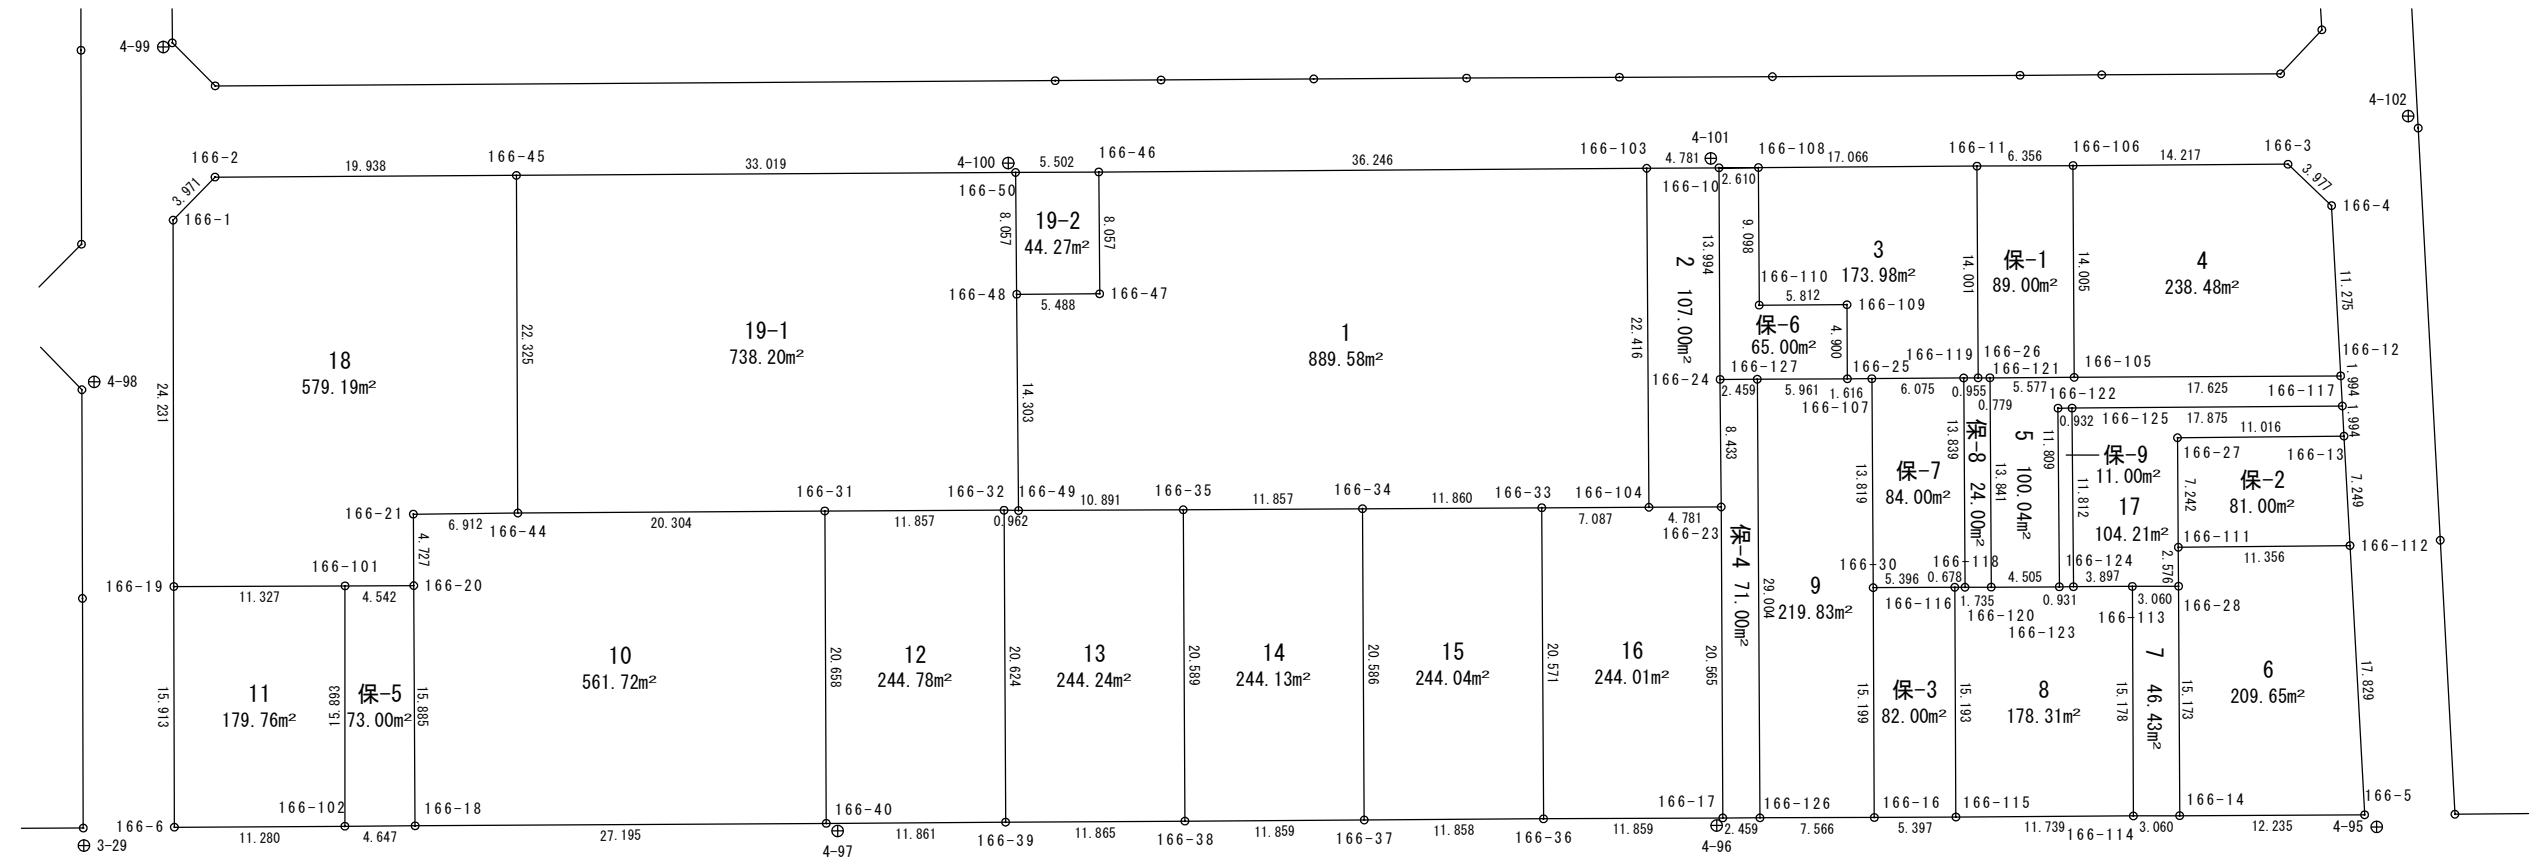

3. 4. 32本町六供線

