



# 169街区 画地出来形確認図 (1870.79m<sup>2</sup>)

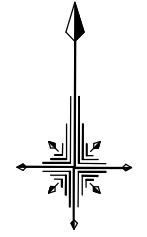

S=1/500

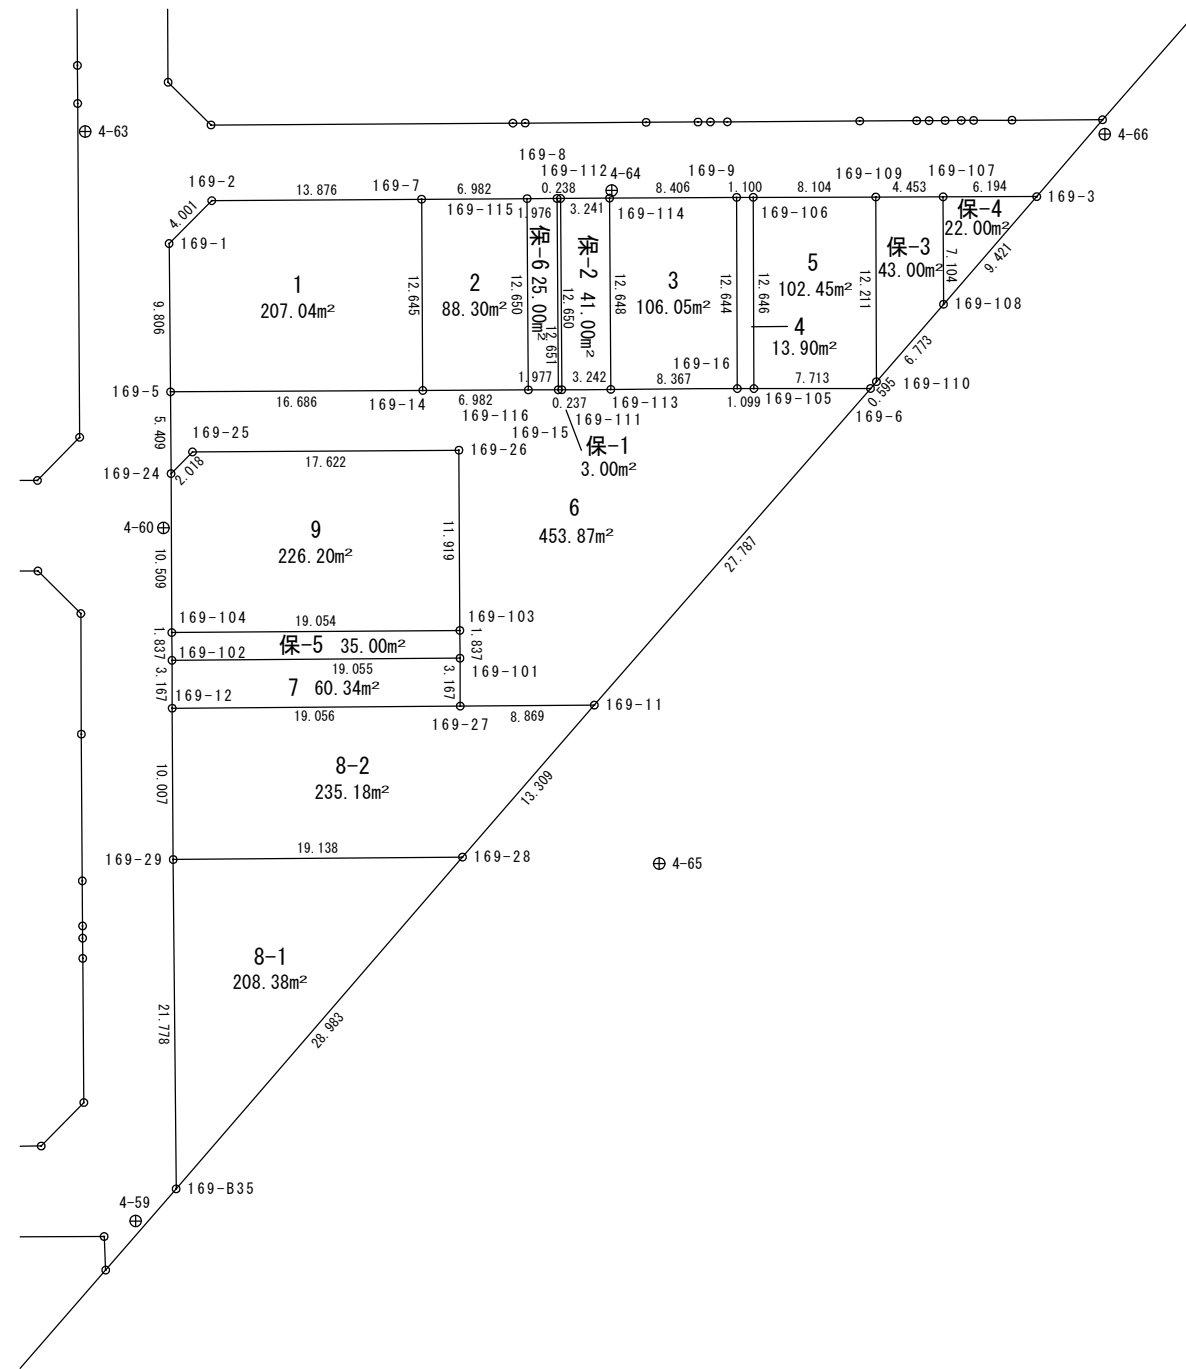


# 面積計算書 (座標法)

世界測地系 (測地成果2011)

所在	地番	公簿地目	現況地目	地積	所有者
前橋市六供町三丁目	169-1			207.04 m <sup>2</sup>	

点名	X座標	Y座標	辺長	方向角	測角	DX	倍積 (Y×DX)
169-2	40612.966	-67917.427	4.001	224-53-55	135-17-42	-2.930	198998.061110
169-1	40610.132	-67920.251	9.806	179-26-42	134-32-47	-12.640	858511.972640
169-5	40600.326	-67920.156	16.686	89-41-15	90-14-33	-9.715	659844.315540
169-14	40600.417	-67903.470	12.645	359-37-59	89-56-44	12.736	-864818.593920
169-7	40613.062	-67903.551	13.876	269-36-13	89-58-14	12.549	-852121.661499
倍面積							414.093871
面積							207.0469355

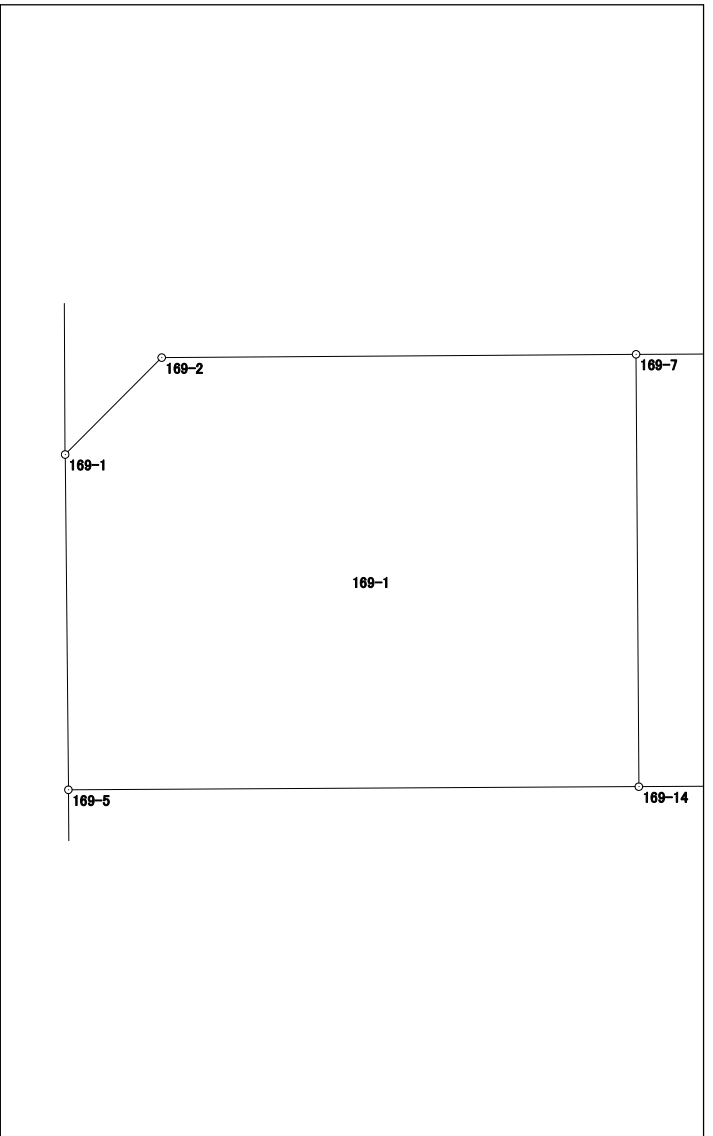


# 面積計算書（座標法）

世界測地系（測地成果2011）

所 在	地 番	公簿地目	現況地目	地 積	所 有 者
前橋市六供町三丁目	169-2			88.30 m <sup>2</sup>	

点 名	X 座標	Y 座標	辺 長	方 向 角	測 角	DX	倍 積 (Y×DX)
169-116	40600.452	-67896.488	12.650	359-37-59	89-55-13	12.685	-861266.950280
169-115	40613.102	-67896.569	6.982	269-40-18	90-02-19	12.610	-856175.735090
169-7	40613.062	-67903.551	12.645	179-37-59	89-57-41	-12.685	861356.544435
169-14	40600.417	-67903.470	6.982	89-42-46	90-04-47	-12.610	856262.756700
						倍面積	176.615765
						面 積	88.3078825

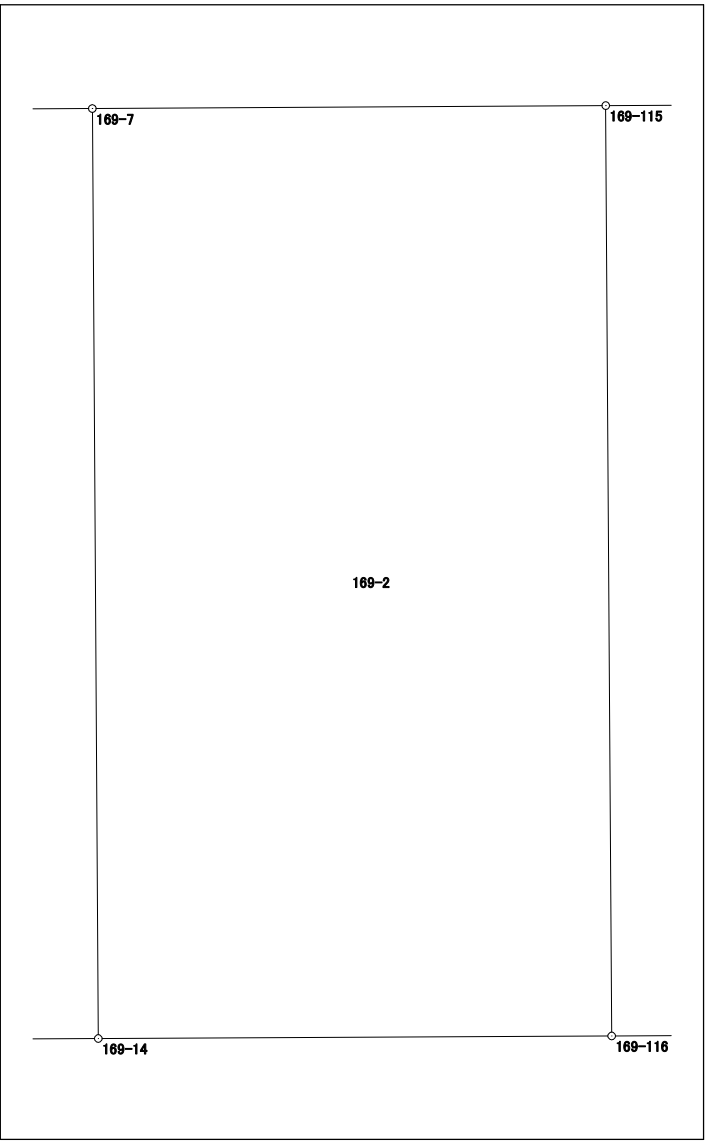

# 面積計算書 (座標法)

世界測地系 (測地成果2011)

所在	地番	公簿地目	現況地目	地積	所有者
前橋市六供町三丁目	169-3			106.05 m <sup>2</sup>	


点名	X座標	Y座標	辺長	方向角	測角	DX	倍積 (Y×DX)	
169-114	40613.134	-67891.114	12.648	179-37-43	89-58-59	-12.700	862217.147800	
169-113	40600.486	-67891.032	8.367	89-36-59	89-59-16	-12.592	854883.874944	
169-16	40600.542	-67882.665	12.644	359-48-19	90-11-20	12.700	-862109.845500	
169-9	40613.186	-67882.708	8.406	269-38-44	89-50-25	12.592	-854779.059136	
倍面積							212.118108	
面積							106.0590540	

# 面積計算書 (座標法)

世界測地系 (測地成果2011)

所在	地番	公簿地目	現況地目	地積	所有者
前橋市六供町三丁目	169-4			13.90 m <sup>2</sup>	

点名	X座標	Y座標	辺長	方向角	測角	DX	倍積 (Y×DX)
169-105	40600.543	-67881.566	12.646	359-48-35	89-51-43	12.647	-858498.165202
169-106	40613.189	-67881.608	1.100	269-50-37	90-02-02	12.643	-858227.169944
169-9	40613.186	-67882.708	12.644	179-48-19	89-57-42	-12.647	858512.608076
169-16	40600.542	-67882.665	1.099	89-56-52	90-08-33	-12.643	858240.533595
						倍面積	27.806525
						面積	13.9032625

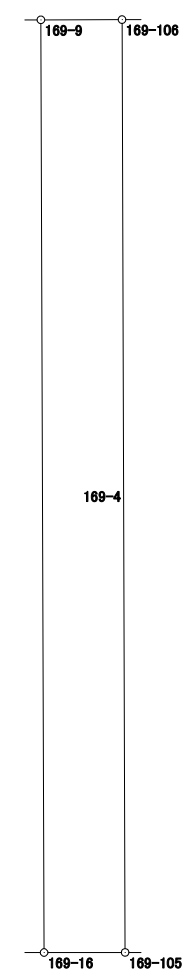

# 面積計算書 (座標法)

世界測地系 (測地成果2011)

所在	地番	公簿地目	現況地目	地積	所有者
前橋市六供町三丁目	169-5			102.45 m <sup>2</sup>	


点名	X座標	Y座標	辺長	方向角	測角	DX	倍積 (Y×DX)	
169-110	40600.998	-67873.463	12.211	359-48-27	138-53-35	12.661	-859345.915043	
169-109	40613.209	-67873.504	8.104	269-51-31	90-03-04	12.191	-827445.887264	
169-106	40613.189	-67881.608	12.646	179-48-35	89-57-04	-12.666	859788.446928	
169-105	40600.543	-67881.566	7.713	89-57-46	90-09-11	-12.641	858090.875806	
169-6	40600.548	-67873.853	0.595	40-54-52	130-57-06	0.455	-30882.603115	
						倍面積	204.917312	
						面積	102.4586560	

# 面積計算書（座標法）

世界測地系（測地成果2011）

所 在	地 番	公簿地目	現況地目	地 積	所 有 者
前橋市六供町三丁目	169-6			453.87 m <sup>2</sup>	

点 名	X 座標	Y 座標	辺 長	方 向 角	測 角	DX	倍 積 (Y×DX)
169-27	40579.543	-67900.991	8.869	89-33-39	89-51-01	-3.099	210425.171109
169-11	40579.611	-67892.122	27.787	41-06-25	131-32-46	21.005	-1426074.022610
169-6	40600.548	-67873.853	7.713	269-57-46	48-51-21	20.932	-1420735.490996
169-105	40600.543	-67881.566	1.099	269-56-52	179-59-06	-0.006	407.289396
169-16	40600.542	-67882.665	8.367	269-36-59	179-40-07	-0.057	3869.311905
169-113	40600.486	-67891.032	3.242	269-36-40	179-59-41	-0.078	5295.500496
169-111	40600.464	-67894.274	0.237	269-30-59	179-54-19	-0.024	1629.462576
169-15	40600.462	-67894.511	1.977	269-42-37	180-11-38	-0.012	814.734132
169-116	40600.452	-67896.488	6.982	269-42-46	180-00-09	-0.045	3055.341960
169-14	40600.417	-67903.470	16.686	269-41-15	179-58-29	-0.126	8555.837220
169-5	40600.326	-67920.156	5.409	179-37-07	89-55-52	-5.500	373560.858000
169-24	40594.917	-67920.120	2.018	44-40-44	45-03-37	-3.974	269914.556880
169-25	40596.352	-67918.701	17.622	89-37-46	224-57-02	1.549	-105206.067849
169-26	40596.466	-67901.079	11.919	179-42-07	270-04-21	-11.805	801572.237595
169-103	40584.547	-67901.017	1.837	179-41-17	179-59-10	-13.756	934046.389852
169-101	40582.710	-67901.007	3.167	179-42-38	180-01-21	-5.004	339776.639028

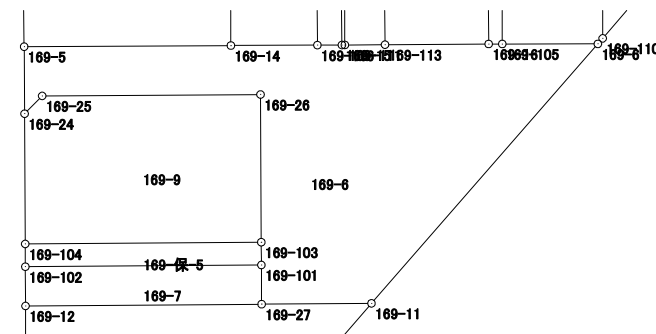

倍面積	907.748694
面 積	453.8743470

# 面積計算書 (座標法)

世界測地系 (測地成果2011)

所 在	地 番	公簿地目	現況地目	地 積	所 有 者
前橋市六供町三丁目	169-7			60.34 m <sup>2</sup>	

点 名	X 座標	Y 座標	辺 長	方 向 角	測 角	DX	倍 積 (Y×DX)	
169-101	40582.710	-67901.007	19.055	269-34-55	89-52-17	3.028	-205604.249196	
169-102	40582.571	-67920.061	3.167	179-43-43	90-08-48	-3.306	224543.721666	
169-12	40579.404	-67920.046	19.056	89-34-55	89-51-12	-3.028	205661.899288	
169-27	40579.543	-67900.991	3.167	359-42-38	90-07-43	3.306	-224480.676246	
						倍面積	120.695512	
						面 積	60.3477560	





## 面積計算書 (座標法)

世界測地系 (測地成果2011)

所 在	地 番	公簿地目	現況地目	地 積	所 有 者
前橋市六供町三丁目	169-8-2			235.18 m <sup>2</sup>	


点 名	X 座標	Y 座標	辺 長	方 向 角	測 角	DX	倍 積 (Y×DX)	
169-12	40579.404	-67920.046	10.007	179-37-20	90-02-25	-10.146	689116.786716	
169-29	40569.397	-67919.980	19.138	89-31-05	89-53-45	-9.846	668740.123080	
169-28	40569.558	-67900.843	13.309	40-56-30	131-25-25	10.214	-693539.210402	
169-11	40579.611	-67892.122	8.869	269-33-39	48-37-09	9.985	-677902.838170	
169-27	40579.543	-67900.991	19.056	269-34-55	180-01-16	-0.207	14055.505137	
						倍面積	470.366361	
						面 積	235.1831805	

# 面積計算書 (座標法)

世界測地系 (測地成果2011)

所在	地番	公簿地目	現況地目	地積	所有者
前橋市六供町三丁目	169-9			226.20 m <sup>2</sup>	

点名	X座標	Y座標	辺長	方向角	測角	DX	倍積 (Y×DX)
169-104	40584.408	-67920.070	19.054	89-34-55	89-51-16	-10.370	704331.125900
169-103	40584.547	-67901.017	11.919	359-42-07	90-07-12	12.058	-818750.462986
169-26	40596.466	-67901.079	17.622	269-37-46	89-55-39	11.805	-801572.237595
169-25	40596.352	-67918.701	2.018	224-40-44	135-02-58	-1.549	105206.067849
169-24	40594.917	-67920.120	10.509	179-43-39	135-02-55	-11.944	811237.913280
倍面積							452.406448
面積							226.2032240

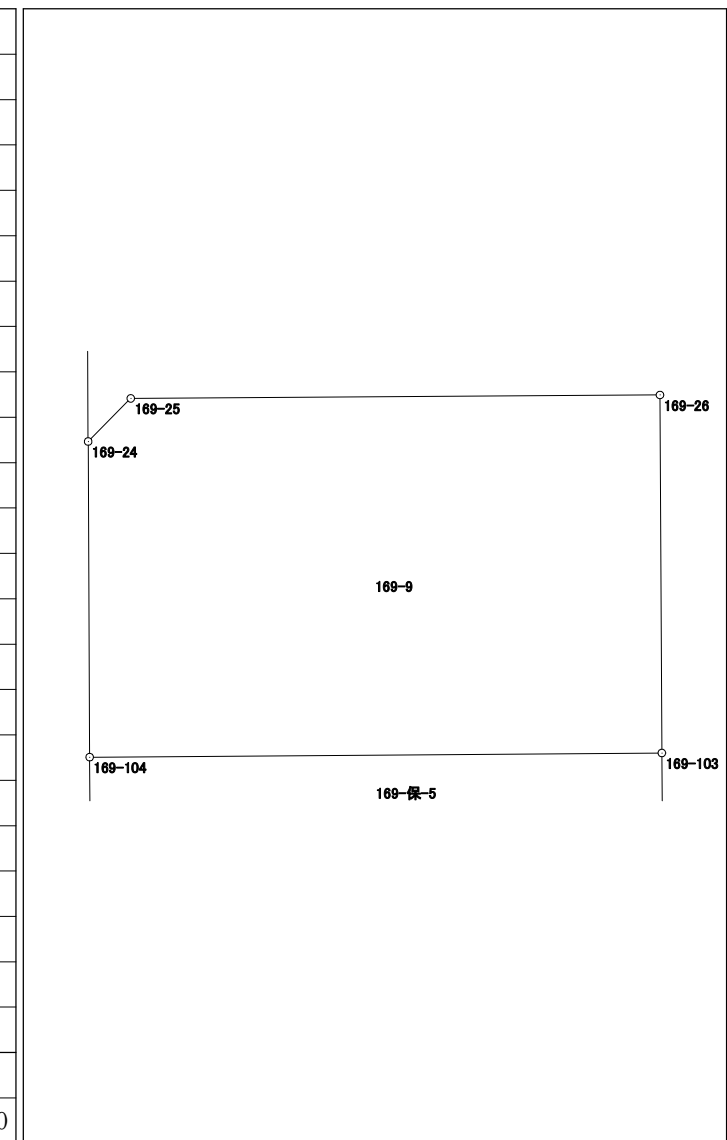








# 面積計算書 (座標法)

世界測地系 (測地成果2011)

所 在	地 番	公簿地目	現況地目	地 積	所 有 者
前橋市六供町三丁目	169-保-4			22.00 m <sup>2</sup>	

点 名	X 座標	Y 座標	辺 長	方 向 角	測 角	DX	倍 積 (Y×DX)
169-107	40613.220	-67869.051	7.104	179-48-23	89-56-43	-7.119	483159.774069
169-108	40606.116	-67869.027	9.421	40-54-55	41-06-32	0.015	-1018.035405
169-3	40613.235	-67862.857	6.194	269-51-40	48-56-45	7.104	-482097.736128
						倍面積	44.002536
						面 積	22.0012680

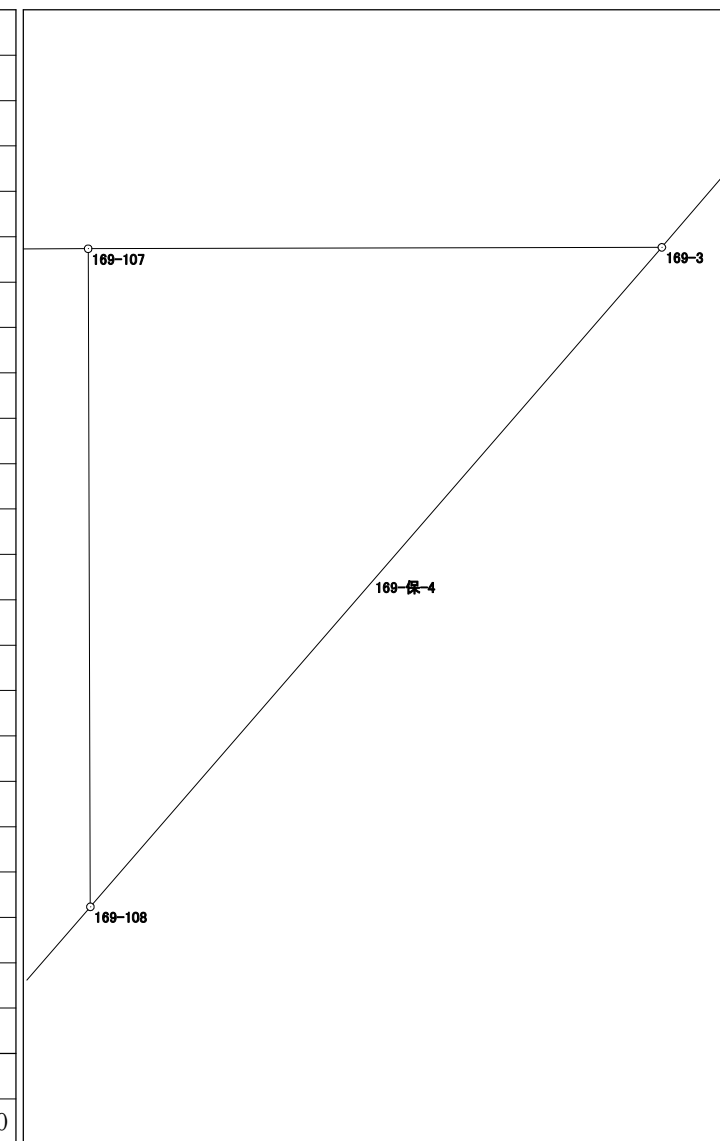





# 面積計算書（座標法）

世界測地系（測地成果2011）

所 在	地 番	公簿地目	現況地目	地 積	所 有 者
前橋市六供町三丁目	169-保-6			25.00 m <sup>2</sup>	

点 名	X 座 標	Y 座 標	辺 長	方 向 角	測 角	D X	倍 積 (Y×DX)
169-115	40613.102	-67896.569	12.650	179-37-59	89-57-07	-12.661	859638.460109
169-116	40600.452	-67896.488	1.977	89-42-37	90-04-38	-12.640	858211.608320
169-15	40600.462	-67894.511	12.651	359-37-43	89-55-06	12.661	-859612.403771
169-8	40613.113	-67894.593	1.976	269-40-52	90-03-09	12.640	-858187.655520

