



170街区 画地出来形確認図 (2311.44m²)

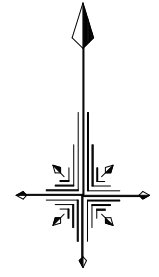

S=1/500

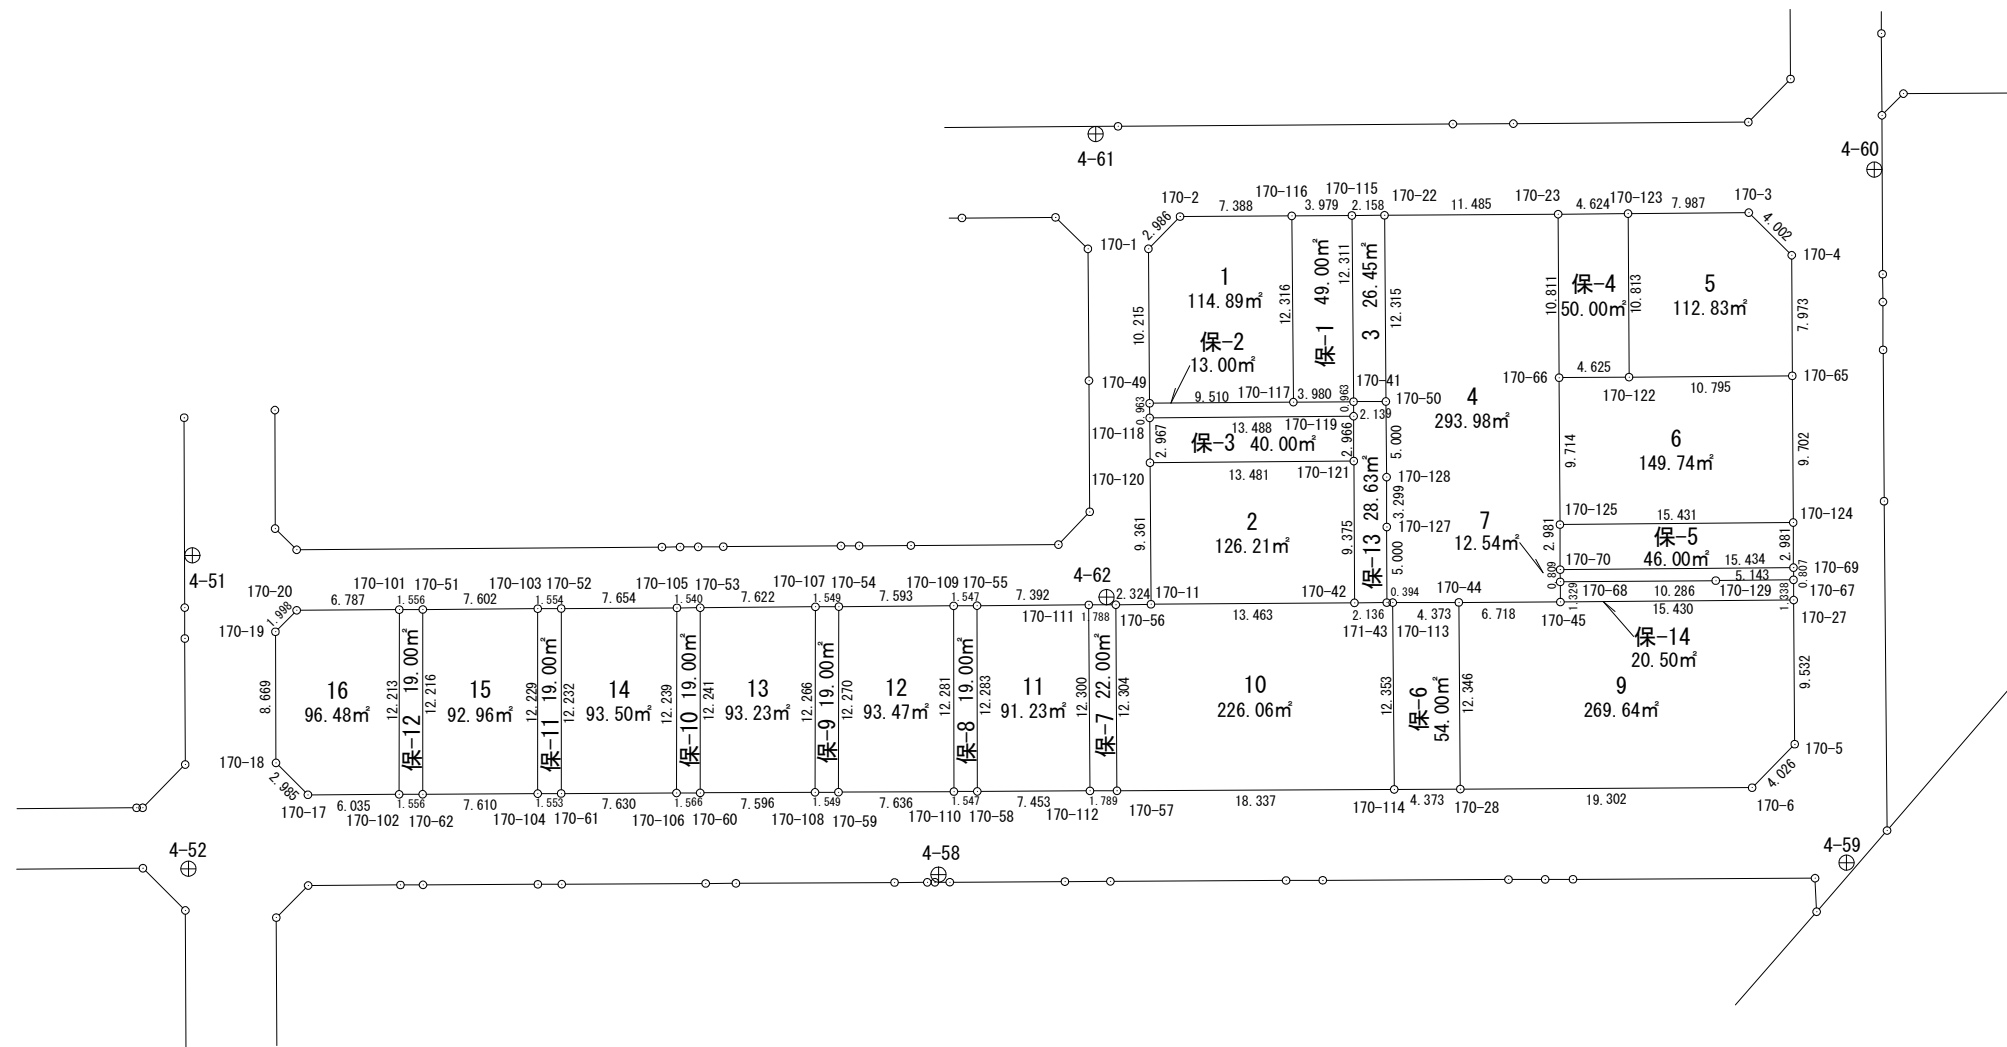

面積計算書（座標法）

世界測地系（測地成果2011）

所 在	地 番	公簿地目	現況地目	地 積	所 有 者
前橋市六供町三丁目	170-5			112.83 m ²	

点 名	X 座標	Y 座標	辺 長	方 向 角	測 角	DX	倍 積 (Y×DX)	
170-123	40588.415	-67936.917	10.813	179-38-04	90-05-37	-10.877	738949.846209	
170-122	40577.602	-67936.848	10.795	89-32-18	89-54-14	-10.726	728690.631648	
170-65	40577.689	-67926.053	7.973	359-45-20	90-13-02	8.060	-547483.987180	
170-4	40585.662	-67926.087	4.002	314-44-13	134-58-53	10.790	-732922.478730	
170-3	40588.479	-67928.930	7.987	269-32-27	134-48-14	2.753	-187008.344290	
							倍面積	
							面 積	112.8338285

面積計算書 (座標法)

世界測地系 (測地成果2011)

所 在	地 番	公簿地目	現況地目	地 積	所 有 者
前橋市六供町三丁目	170-9			269.64 m ²	


点 名	X 座標	Y 座標	辺 長	方 向 角	測 角	DX	倍 積 (Y×DX)	
170-44	40562.706	-67948.109	12.346	179-32-43	89-46-32	-12.373	840721.952657	
170-28	40550.360	-67948.011	19.302	89-43-26	90-10-43	-12.253	832566.978783	
170-6	40550.453	-67928.709	4.026	44-24-22	134-40-56	2.969	-201680.337021	
170-5	40553.329	-67925.892	9.532	359-34-45	135-10-23	12.408	-842824.467936	
170-27	40562.861	-67925.962	15.430	269-31-29	89-56-44	9.404	-638775.746648	
170-45	40562.733	-67941.391	6.718	269-46-11	180-14-42	-0.155	10530.915605	
							倍面積	539.295440
							面 積	269.6477200

面積計算書 (座標法)

世界測地系 (測地成果2011)

所在	地番	公簿地目	現況地目	地積	所有者
前橋市六供町三丁目	170-10			226.06 m ²	

点名	X座標	Y座標	辺長	方向角	測角	DX	倍積 (Y×DX)
170-114	40550.339	-67952.384	12.353	359-32-44	89-49-36	12.443	-845531.514112
170-113	40562.692	-67952.482	0.394	269-51-16	90-18-32	12.352	-839349.057664
171-43	40562.691	-67952.876	2.136	269-35-52	179-44-36	-0.016	1087.246016
170-42	40562.676	-67955.012	13.463	269-35-45	179-59-53	-0.110	7475.051320
170-11	40562.581	-67968.475	2.324	269-18-35	179-42-50	-0.123	8360.122425
170-56	40562.553	-67970.799	12.304	179-38-12	90-19-37	-12.332	838215.893268
170-57	40550.249	-67970.721	18.337	89-43-08	90-04-56	-12.214	830194.386294
						倍面積	452.127547
						面積	226.0637735

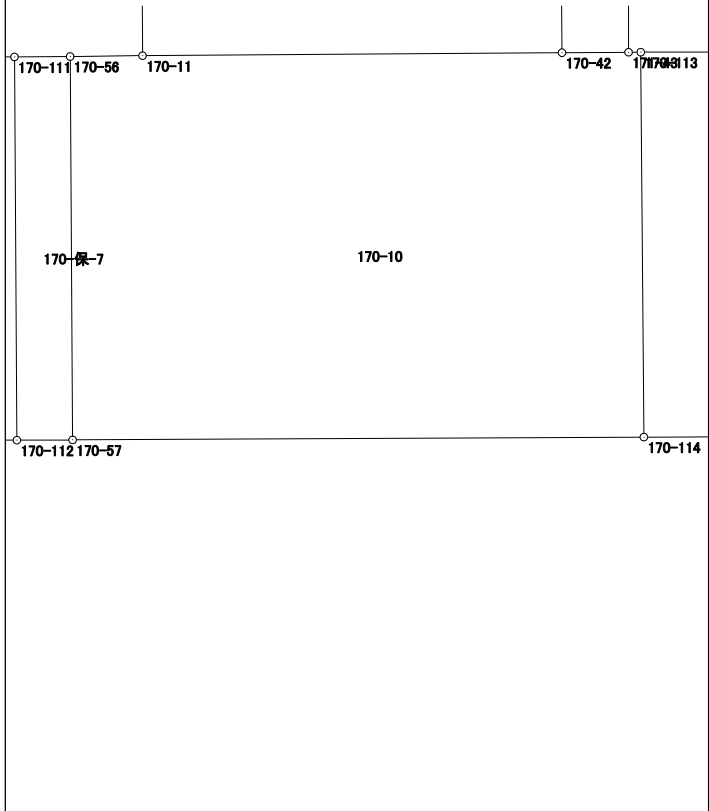


面積計算書（座標法）

世界測地系（測地成果2011）

所在	地番	公簿地目	現況地目	地積	所有者
前橋市六供町三丁目	170-11			91.23 m ²	

点名	X座標	Y座標	辺長	方向角	測角	DX	倍積 (Y×DX)
170-112	40550.241	-67972.510	12.300	359-38-29	89-54-38	12.335	-838440.910850
170-111	40562.541	-67972.587	7.392	269-35-49	89-57-20	12.248	-832528.245576
170-55	40562.489	-67979.979	12.283	179-55-31	90-19-42	-12.335	838533.040965
170-58	40550.206	-67979.963	7.453	89-43-51	89-48-20	-12.248	832618.586824
						倍面積	182.471363
						面積	91.2356815

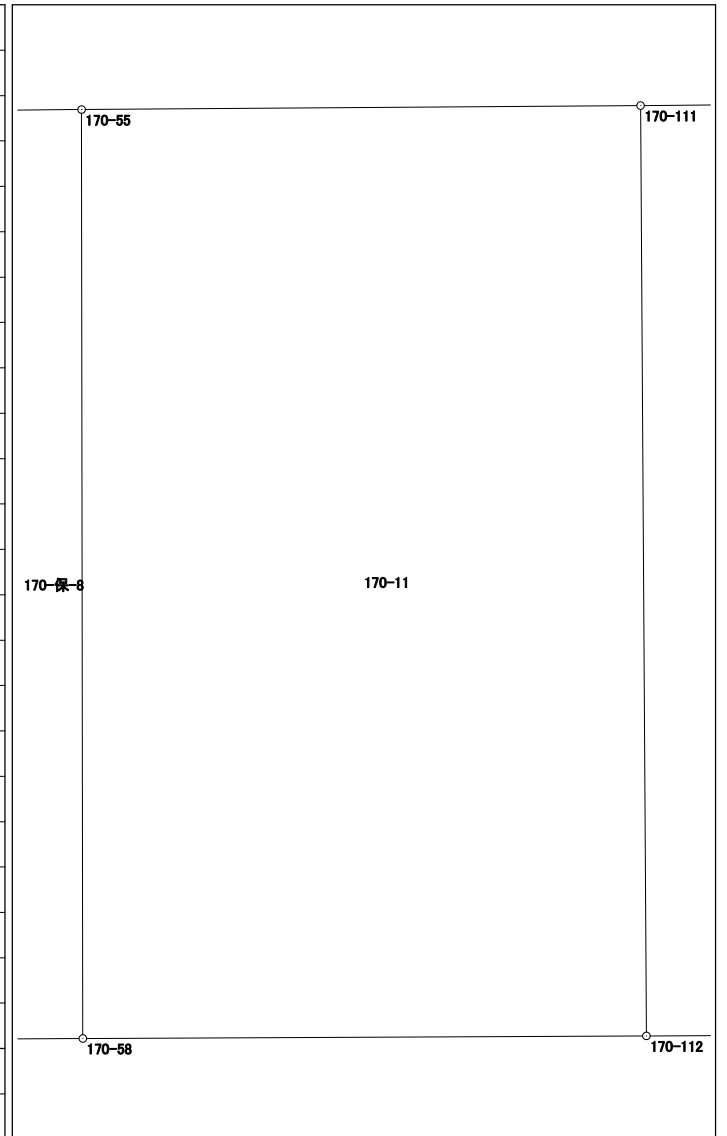

面積計算書 (座標法)

世界測地系 (測地成果2011)

所在	地番	公簿地目	現況地目	地積	所有者
前橋市六供町三丁目	170-12			93.47 m ²	

点名	X座標	Y座標	辺長	方向角	測角	DX	倍積 (Y×DX)	
170-110	40550.197	-67981.510	12.281	359-55-31	90-14-25	12.323	-837736.147730	
170-109	40562.478	-67981.526	7.593	269-36-00	89-40-29	12.228	-831278.099928	
170-54	40562.425	-67989.119	12.270	180-07-34	90-31-34	-12.323	837829.913437	
170-59	40550.155	-67989.146	7.636	89-41-06	89-33-32	-12.228	831371.277288	
							倍面積	186.943067
							面積	93.4715335

面積計算書 (座標法)

世界測地系 (測地成果2011)

所 在	地 番	公簿地目	現況地目	地 積	所 有 者
前橋市六供町三丁目	170-13			93.23 m ²	


点 名	X 座標	Y 座標	辺 長	方 向 角	測 角	DX	倍 積 (Y×DX)	
170-108	40550.147	-67990.695	12.266	0-07-34	90-23-24	12.301	-836353.539195	
170-107	40562.413	-67990.668	7.622	269-32-56	89-25-22	12.206	-829894.093608	
170-53	40562.353	-67998.290	12.241	180-00-17	90-27-21	-12.301	836446.965290	
170-60	40550.112	-67998.291	7.596	89-44-10	89-43-53	-12.206	829987.139946	
							倍面積	186.472433
							面 積	93.2362165

面積計算書 (座標法)

世界測地系 (測地成果2011)

所在	地番	公簿地目	現況地目	地積	所有者
前橋市六供町三丁目	170-14			93.50 m ²	

点名	X座標	Y座標	辺長	方向角	測角	DX	倍積 (Y×DX)
170-106	40550.105	-67999.857	12.239	0-07-35	90-24-15	12.276	-834766.244532
170-105	40562.344	-67999.830	7.654	269-40-14	89-32-39	12.195	-829257.926850
170-52	40562.300	-68007.484	12.232	180-00-51	90-20-37	-12.276	834859.873584
170-61	40550.068	-68007.487	7.630	89-43-20	89-42-29	-12.195	829351.303965

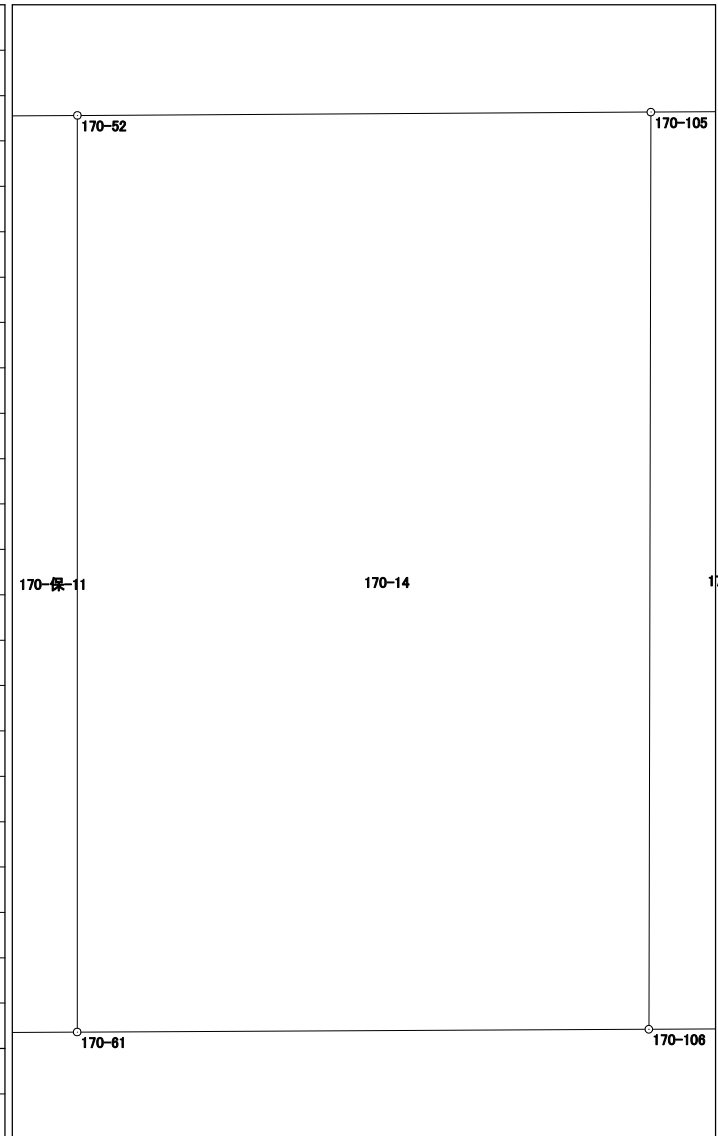

倍面積	187.006167
面積	93.5030835

面積計算書 (座標法)

世界測地系 (測地成果2011)

所 在	地 番	公簿地目	現況地目	地 積	所 有 者
前橋市六供町三丁目	170-15			92.96 m ²	

点 名	X 座標	Y 座標	辺 長	方 向 角	測 角	DX	倍 積 (Y×DX)		
170-104	40550.060	-68009.040	12.229	0-00-34	90-18-38	12.269	-834402.911760		
170-103	40562.289	-68009.038	7.602	269-36-02	89-35-28	12.176	-828078.046688		
170-51	40562.236	-68016.640	12.216	180-02-49	90-26-47	-12.269	834496.156160		
170-62	40550.020	-68016.650	7.610	89-41-56	89-39-07	-12.176	828170.730400		
							倍面積		185.928112
							面 積		92.9640560

