



188街区 画地出来形確認図 (5777.48m²)

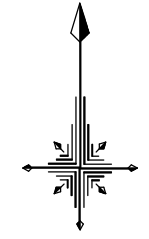

S=1/500

3. 3. 10江田天川大島線

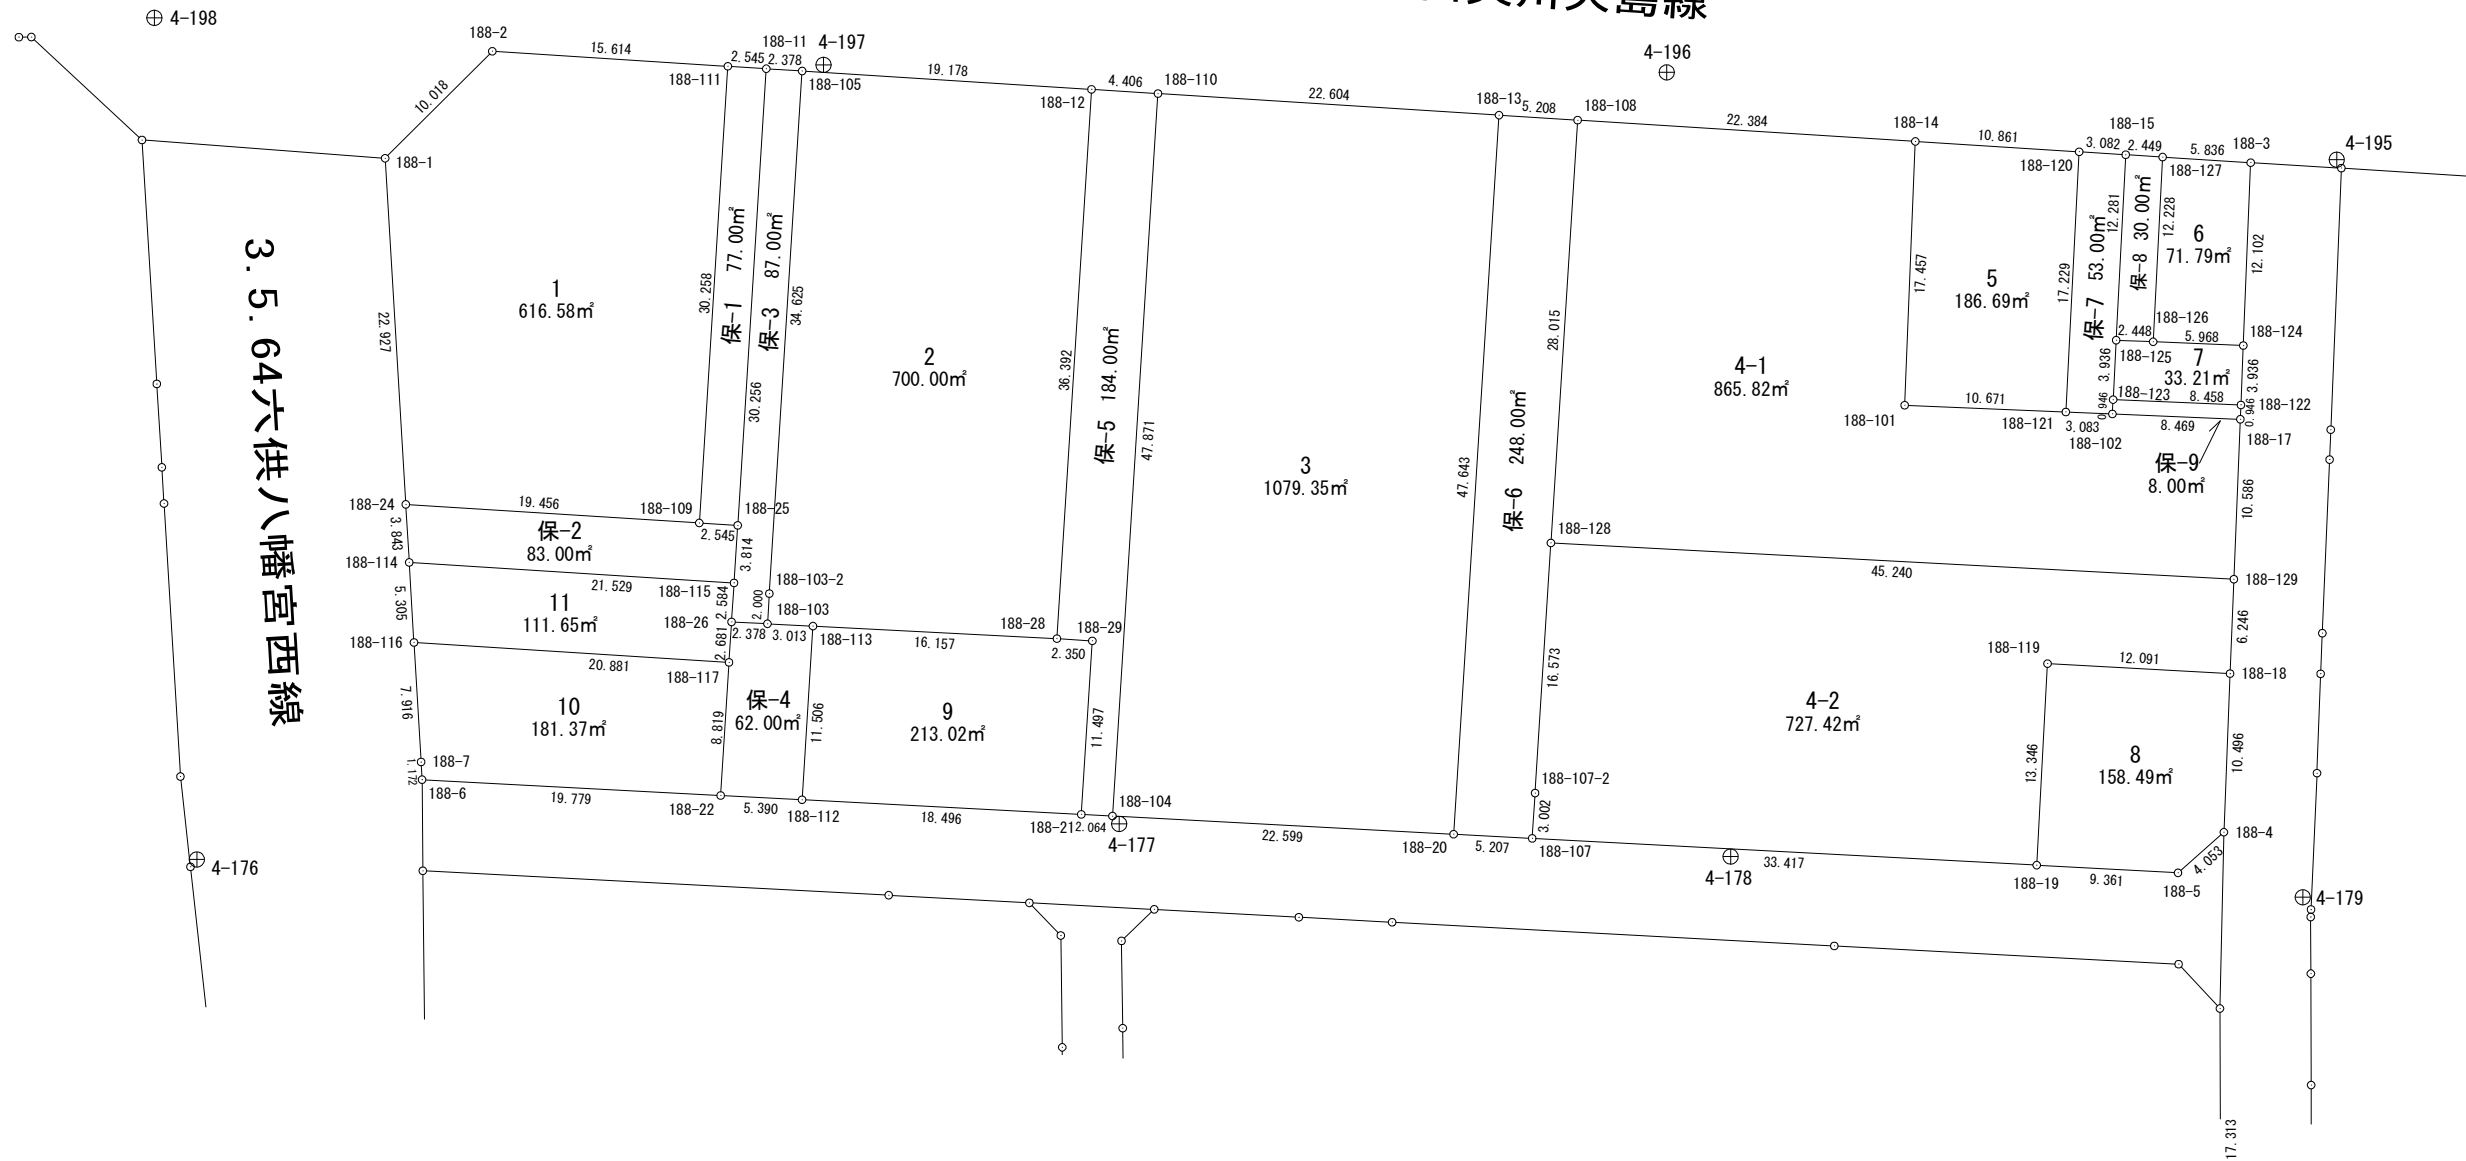


面積計算書 (座標法)

世界測地系 (測地成果2011)

所在	地番	公簿地目	現況地目	地積	所有者
前橋市六供町三丁目	188-3			1079.35 m ²	

点名	X座標	Y座標	辺長	方向角	測角	DX	倍積 (Y×DX)
188-110	41186.396	-68104.373	47.871	183-36-27	89-58-49	-46.346	3156365.271058
188-104	41138.620	-68107.385	22.599	93-02-56	89-26-29	-48.978	3335763.502530
188-20	41137.418	-68084.818	47.643	3-36-54	90-33-58	46.346	-3155458.975028
188-13	41184.966	-68081.814	22.604	273-37-38	90-00-44	48.978	-3334511.086092

倍面積	2158.712468
面積	1079.3562340

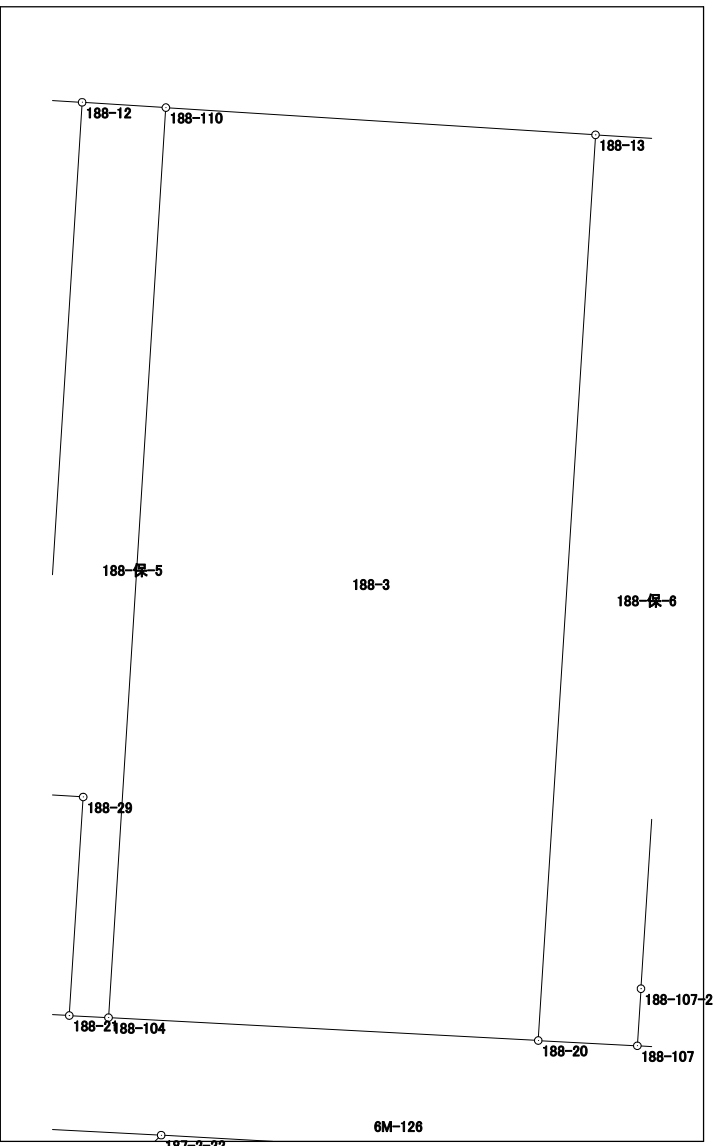


面積計算書（座標法）

世界測地系（測地成果2011）

所 在	地 番	公簿地目	現況地目	地 積	所 有 者
前橋市六供町三丁目	188-5			186.69 m ²	

点 名	X 座 標	Y 座 標	辺 長	方 向 角	測 角	DX	倍 積 (Y×DX)
188-121	41165.339	-68044.320	17.229	2-56-16	90-32-13	16.759	-1140354.758880
188-120	41182.545	-68043.437	10.861	273-36-39	90-40-23	17.890	-1217297.087930
188-14	41183.229	-68054.276	17.457	182-19-04	88-42-25	-16.759	1140521.611484
188-101	41165.786	-68054.982	10.671	92-24-03	90-04-59	-17.890	1217503.627980
						倍面積	373.392654
						面 積	186.6963270

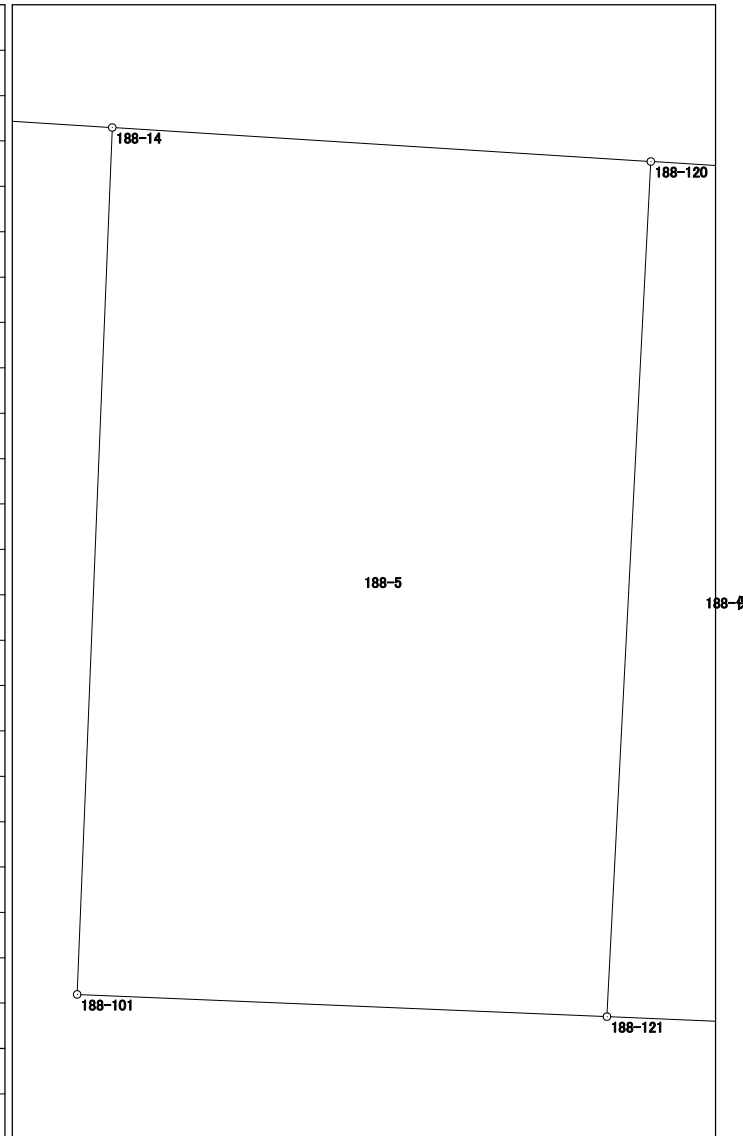


面積計算書 (座標法)

世界測地系 (測地成果2011)

所 在	地 番	公簿地目	現況地目	地 積	所 有 者
前橋市六供町三丁目	188-6			71.79 m ²	

点 名	X 座標	Y 座標	辺 長	方 向 角	測 角	DX	倍 積 (Y×DX)
188-127	41182.196	-68037.917	12.228	182-56-21	89-18-15	-11.842	805705.013114
188-126	41169.984	-68038.544	5.968	92-24-03	89-27-42	-12.462	847896.335328
188-124	41169.734	-68032.581	12.102	2-18-40	89-54-37	11.842	-805641.824202
188-3	41181.826	-68032.093	5.836	273-38-06	91-19-26	12.462	-847815.942966
倍面積							143.581274
面 積							71.7906370

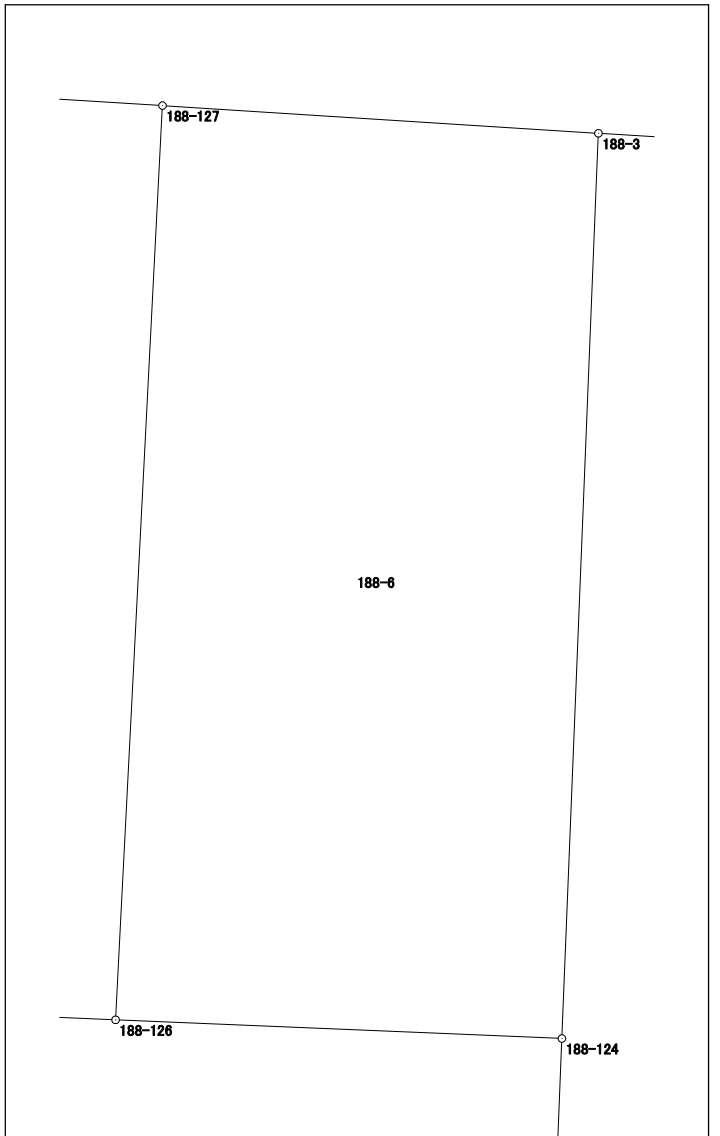


面積計算書（座標法）

世界測地系（測地成果2011）

所 在	地 番	公簿地目	現況地目	地 積	所 有 者
前橋市六供町三丁目	188-8			158.49 m ²	

点 名	X 座標	Y 座標	辺 長	方 向 角	測 角	DX	倍 積 (Y×DX)
188-119	41148.698	-68045.531	13.346	183-04-46	89-57-01	-12.667	861932.741177
188-19	41135.371	-68046.248	9.361	93-07-01	90-02-15	-13.836	941487.887328
188-5	41134.862	-68036.901	4.053	48-27-37	135-20-36	2.179	-148252.407279
188-4	41137.550	-68033.867	10.496	2-14-00	133-46-23	13.176	-896414.231592
188-18	41148.038	-68033.458	12.091	273-07-45	90-53-45	11.148	-758436.989784
						倍面積	316.999850
						面 積	158.4999250

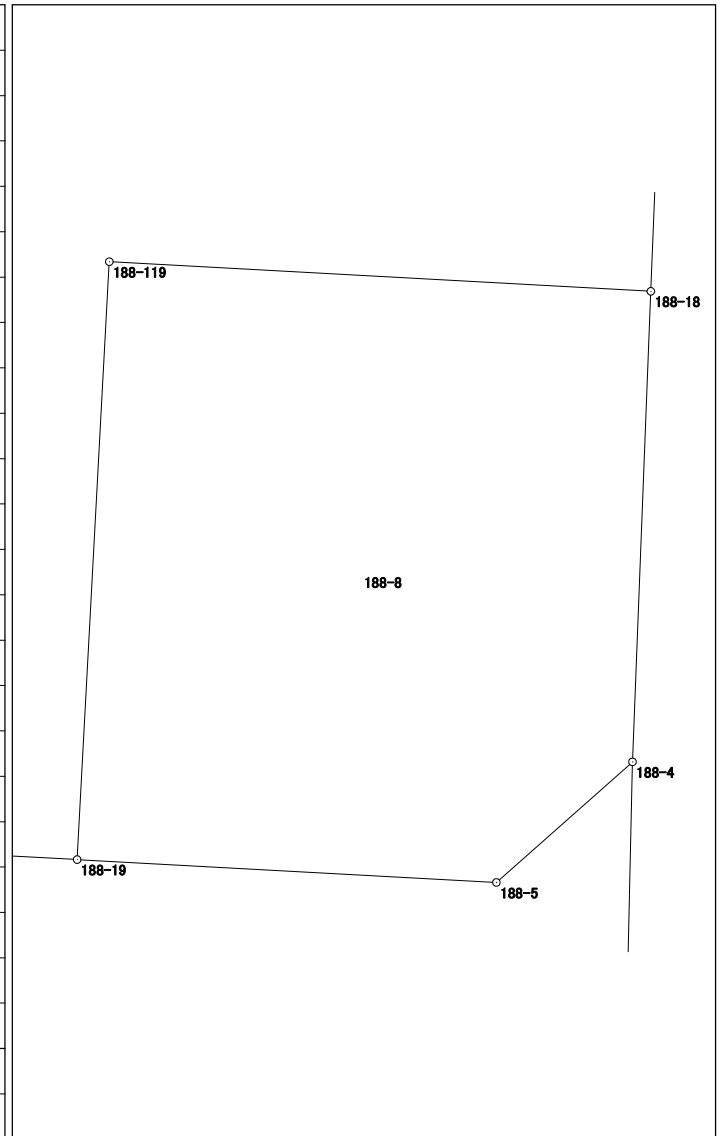


面積計算書 (座標法)

世界測地系 (測地成果2011)

所在	地番	公簿地目	現況地目	地積	所有者
前橋市六供町三丁目	188-11			111.65 m ²	

点名	X座標	Y座標	辺長	方向角	測角	DX	倍積 (Y×DX)
188-116	41150.097	-68153.587	20.881	93-36-58	97-01-12	-6.613	450699.670831
188-117	41148.780	-68132.748	2.681	3-35-32	89-58-34	1.359	-92592.404532
188-26	41151.456	-68132.580	2.584	3-38-19	180-02-47	5.255	-358036.707900
188-115	41154.035	-68132.416	21.529	273-36-59	89-58-40	3.937	-268237.321792
188-114	41155.393	-68153.902	5.305	176-35-46	82-58-47	-3.938	268390.066076
						倍面積	223.302683
						面積	111.6513415

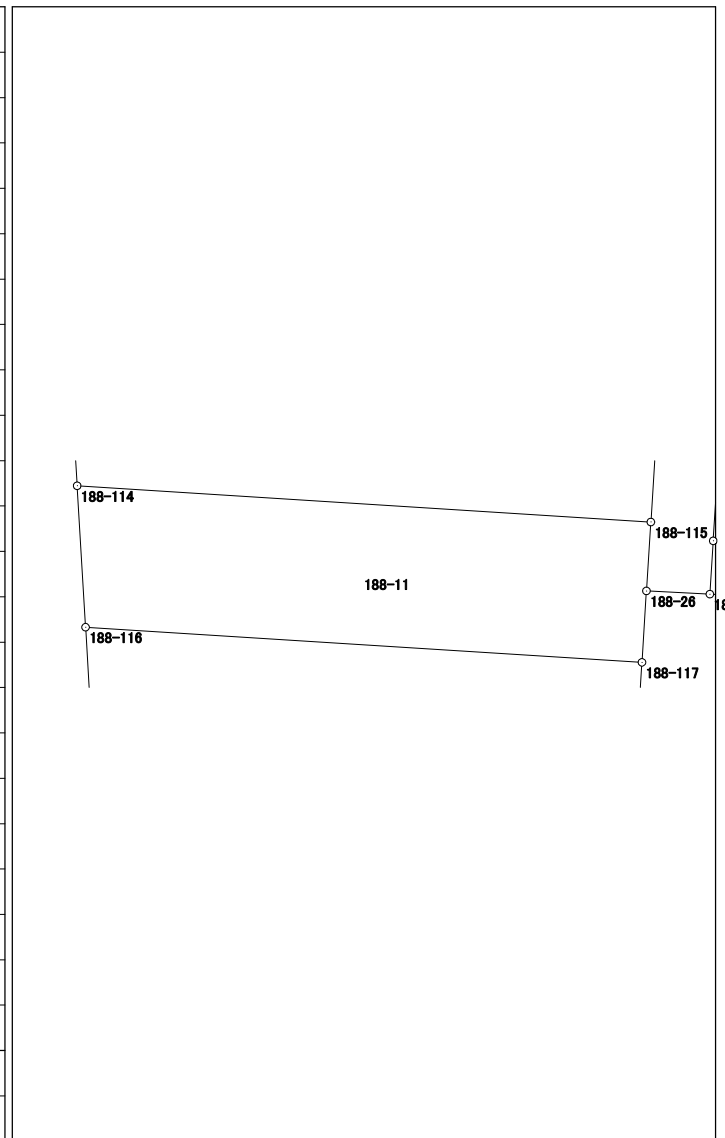


面積計算書 (座標法)

世界測地系 (測地成果2011)

所在	地番	公簿地目	現況地目	地積	所有者
前橋市六供町三丁目	188-保-1			77.00 m ²	

点名	X座標	Y座標	辺長	方向角	測角	DX	倍積 (Y×DX)
188-111	41188.200	-68132.823	30.258	183-34-52	89-55-54	-30.037	2046505.604451
188-109	41158.001	-68134.713	2.545	93-36-16	90-01-24	-30.359	2068501.751967
188-25	41157.841	-68132.173	30.256	3-34-53	89-58-37	30.037	-2046486.080401
188-11	41188.038	-68130.283	2.545	273-38-58	90-04-05	30.359	-2068367.261597
						倍面積	154.014420
						面積	77.0072100

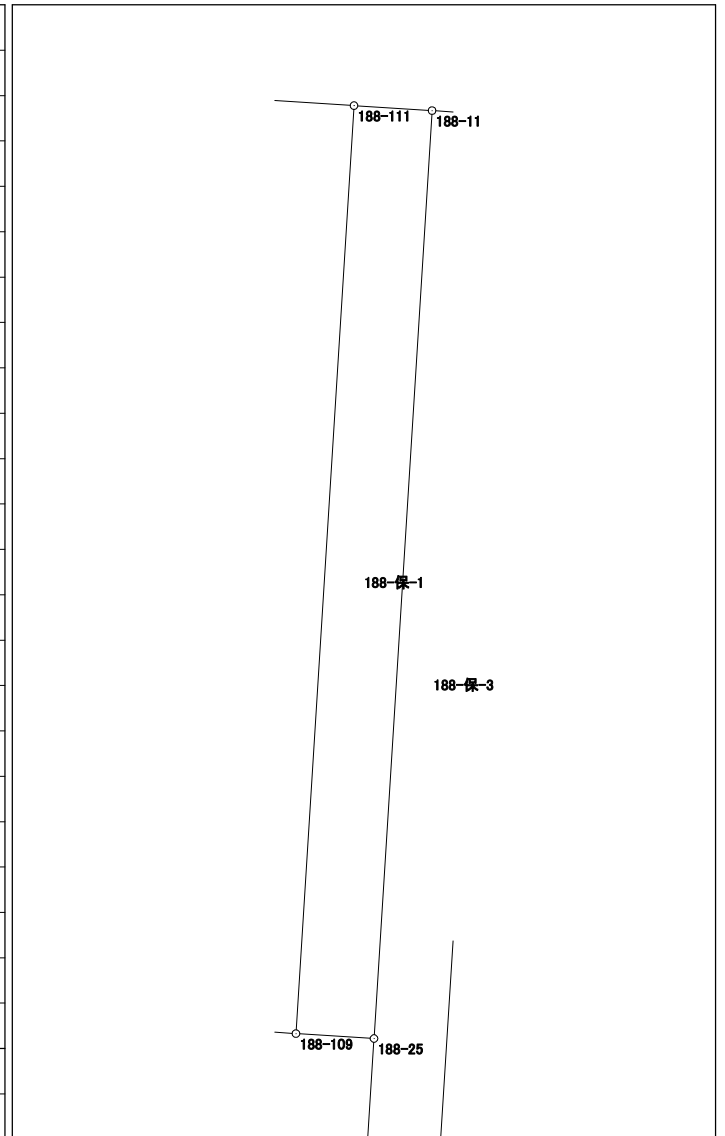


面積計算書 (座標法)

世界測地系 (測地成果2011)

所在	地番	公簿地目	現況地目	地積	所有者
前橋市六供町三丁目	188-保-3			87.00 m ²	

点名	X座標	Y座標	辺長	方向角	測角	DX	倍積 (Y×DX)
188-105	41187.887	-68127.910	2.378	273-38-27	90-02-52	34.708	-2364583.500280
188-11	41188.038	-68130.283	30.256	183-34-53	89-56-26	-30.046	2047042.483018
188-25	41157.841	-68132.173	3.814	183-39-11	180-04-18	-34.003	2316698.278519
188-115	41154.035	-68132.416	2.584	183-38-19	179-59-08	-6.385	435025.476160
188-26	41151.456	-68132.580	2.378	92-56-26	89-18-07	-2.701	184026.098580
188-103	41151.334	-68130.205	2.000	3-35-01	90-38-35	1.874	-127676.004170
188-103-2	41153.330	-68130.080	34.625	3-35-35	180-00-34	36.553	-2490358.814240
						倍面積	174.017587
						面積	87.0087935

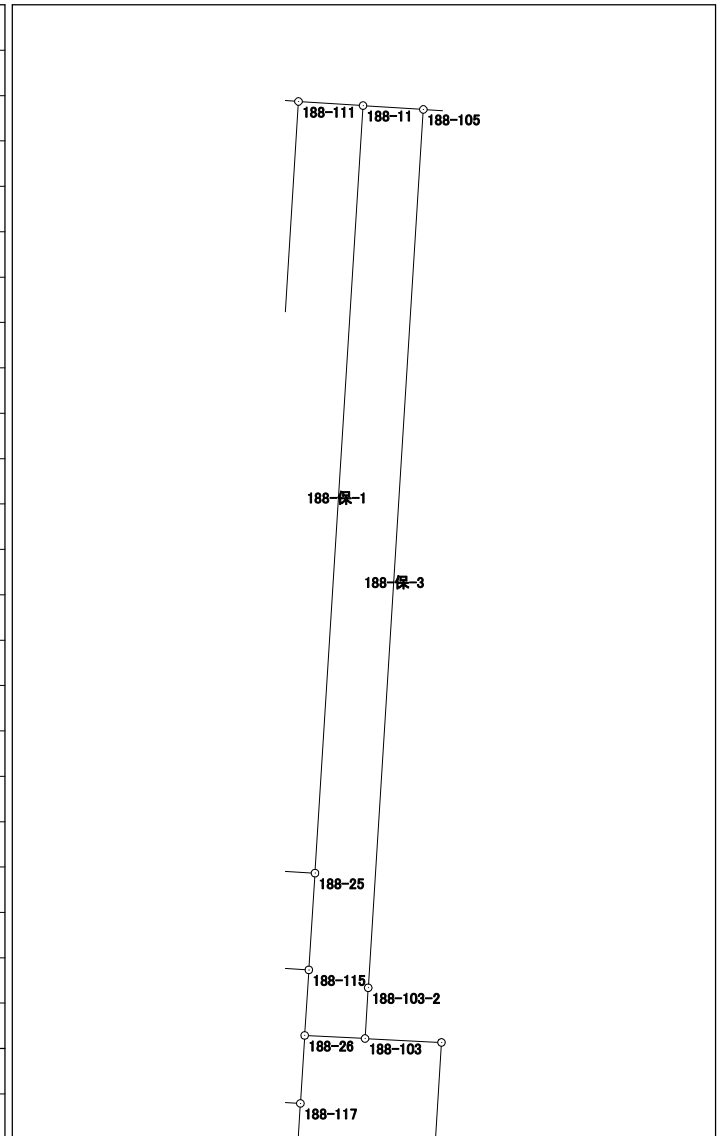


面積計算書（座標法）

世界測地系（測地成果2011）

所 在	地 番	公簿地目	現況地目	地 積	所 有 者
前橋市六供町三丁目	188-保-4			62.00 m ²	

点 名	X 座標	Y 座標	辺 長	方 向 角	測 角	DX	倍 積 (Y×DX)
188-113	41151.180	-68127.196	3.013	272-55-47	89-20-13	11.637	-792796.179852
188-103	41151.334	-68130.205	2.378	272-56-26	180-00-39	0.276	-18803.936580
188-26	41151.456	-68132.580	2.681	183-35-32	90-39-06	-2.554	174010.609320
188-117	41148.780	-68132.748	8.819	183-35-19	179-59-47	-11.478	782027.681544
188-22	41139.978	-68133.300	5.390	92-59-18	89-23-59	-9.083	618854.763900
188-112	41139.697	-68127.917	11.506	3-35-34	90-36-16	11.202	-763168.926234
倍面積						124.012098	
面 積						62.0060490	

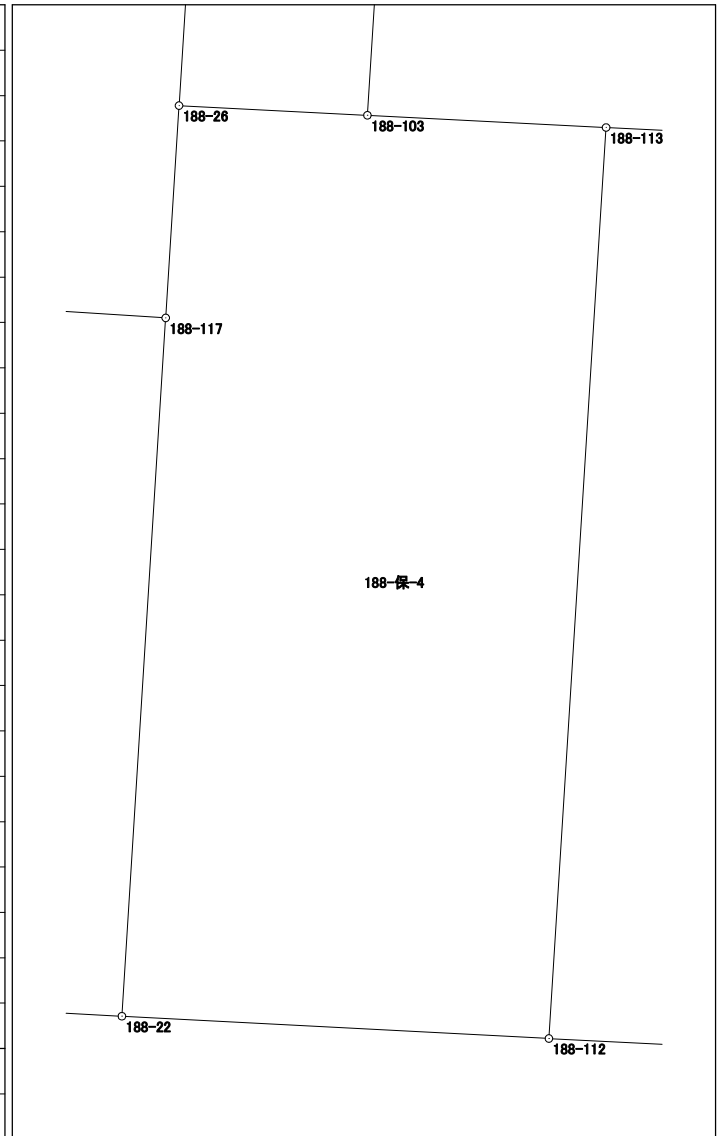

面積計算書 (座標法)

世界測地系 (測地成果2011)

所在	地番	公簿地目	現況地目	地積	所有者
前橋市六供町三丁目	188-保-9			8.00 m ²	

点名	X座標	Y座標	辺長	方向角	測角	DX	倍積 (Y×DX)
188-122	41165.801	-68032.740	8.458	272-23-55	90-05-45	1.299	-88374.529260
188-123	41166.155	-68041.191	0.946	182-58-06	90-34-11	-0.591	40212.343881
188-102	41165.210	-68041.240	8.469	92-23-44	89-25-38	-1.299	88385.570760
188-17	41164.856	-68032.778	0.946	2-18-10	89-54-26	0.591	-40207.371798
						倍面積	16.013583
						面積	8.0067915

