



19-1街区 (2843.50m²)
 19-2街区 (1261.99m²)
画地出来形確認図

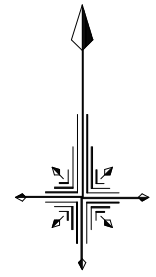

S=1/500

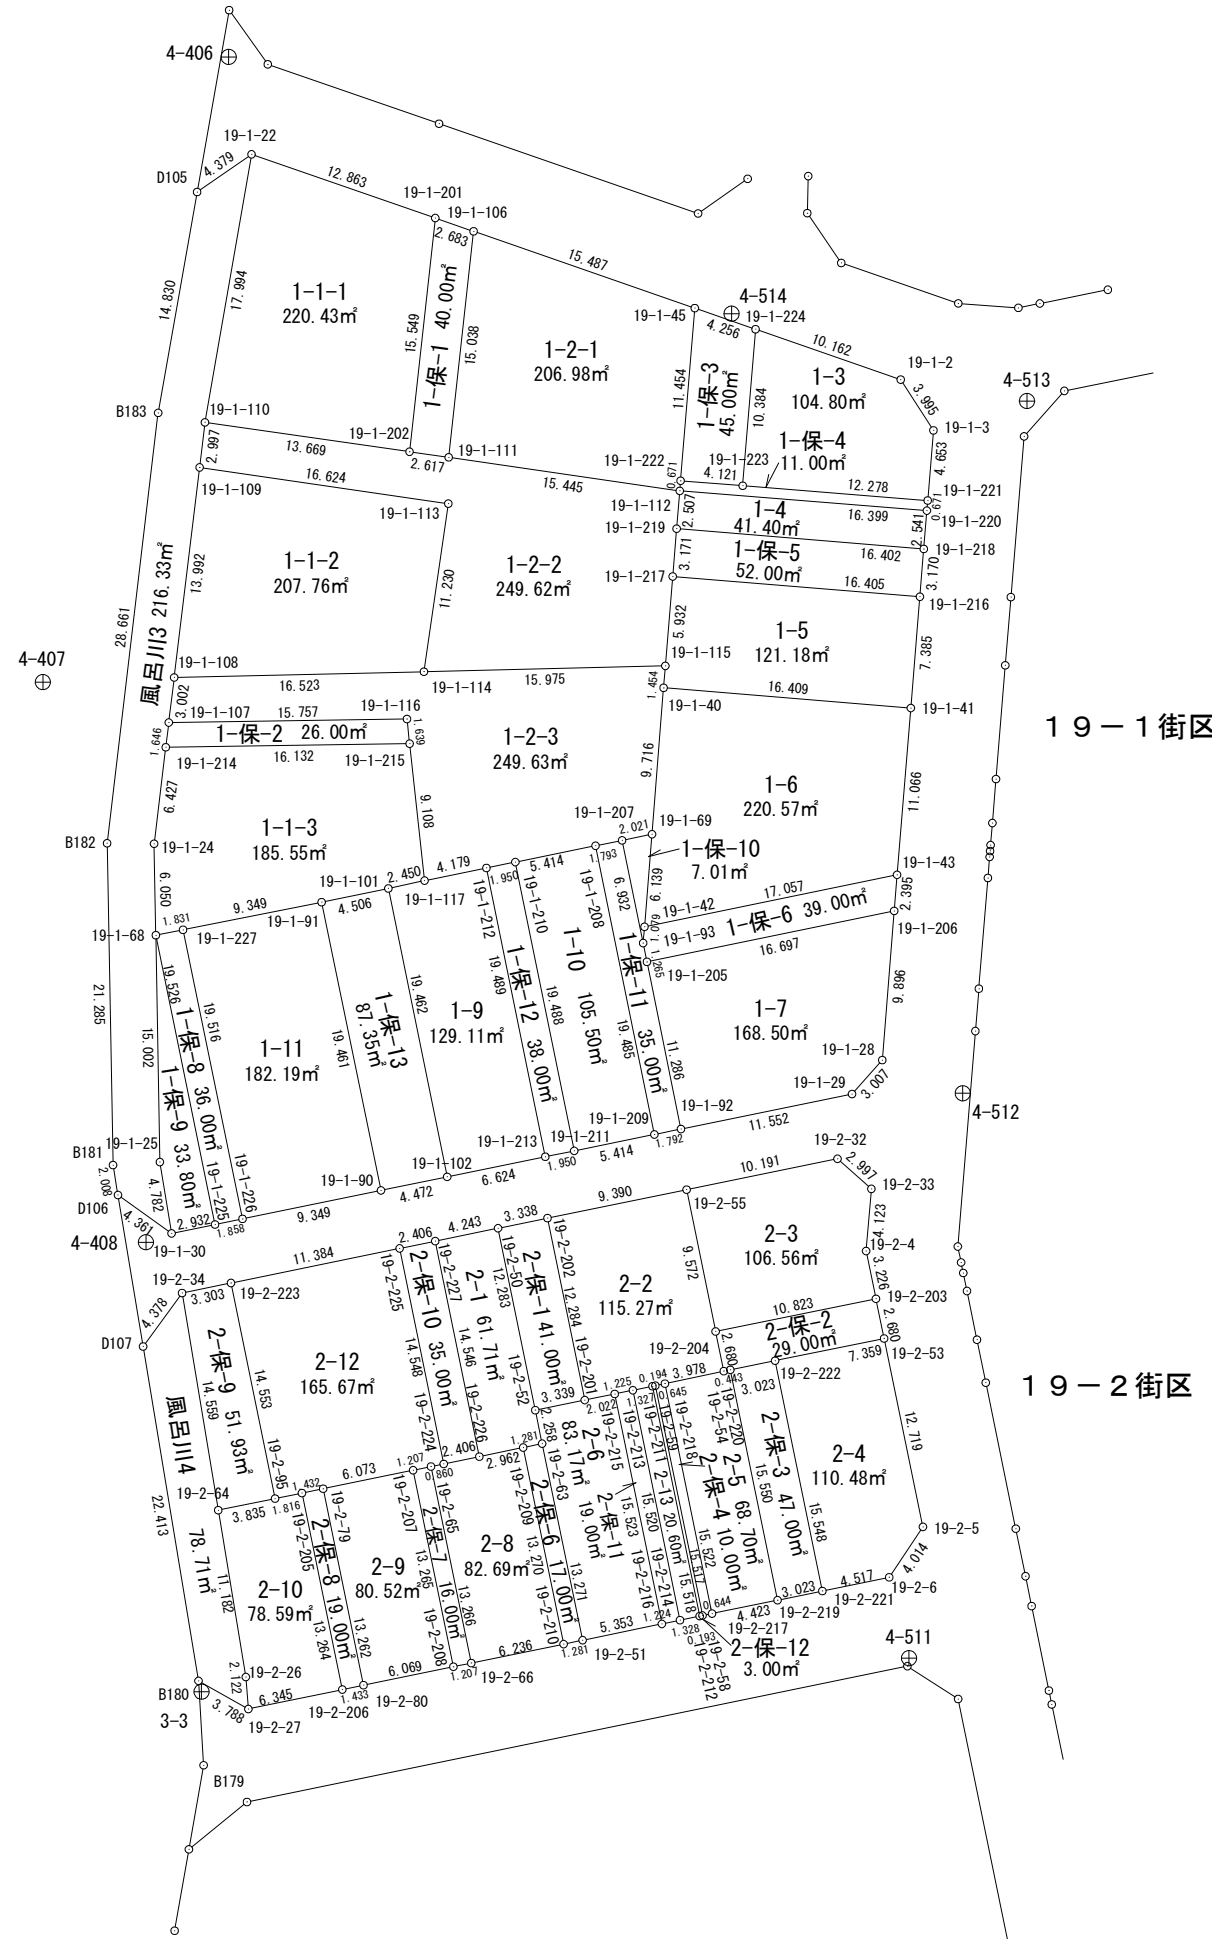

19-1街区


19-2街区

面積計算書 (座標法)

世界測地系 (測地成果2011)

所在	地番	公簿地目	現況地目	地積	所有者
前橋市六供町一丁目	19-2-4			110.48 m ²	

点名	X座標	Y座標	辺長	方向角	測角	DX	倍積 (Y×DX)
19-2-221	41667.261	-68534.326	4.517	78-25-44	90-01-25	-14.325	981754.219950
19-2-6	41668.167	-68529.901	4.014	33-45-12	135-19-28	4.243	-290772.369943
19-2-5	41671.504	-68527.671	12.719	348-20-50	134-35-38	15.794	-1082326.035774
19-2-53	41683.961	-68530.240	7.359	258-29-08	90-08-18	10.988	-753010.277120
19-2-222	41682.492	-68537.451	15.548	168-24-19	89-55-11	-16.700	1144575.431700
						倍面積	220.968813
						面積	110.4844065

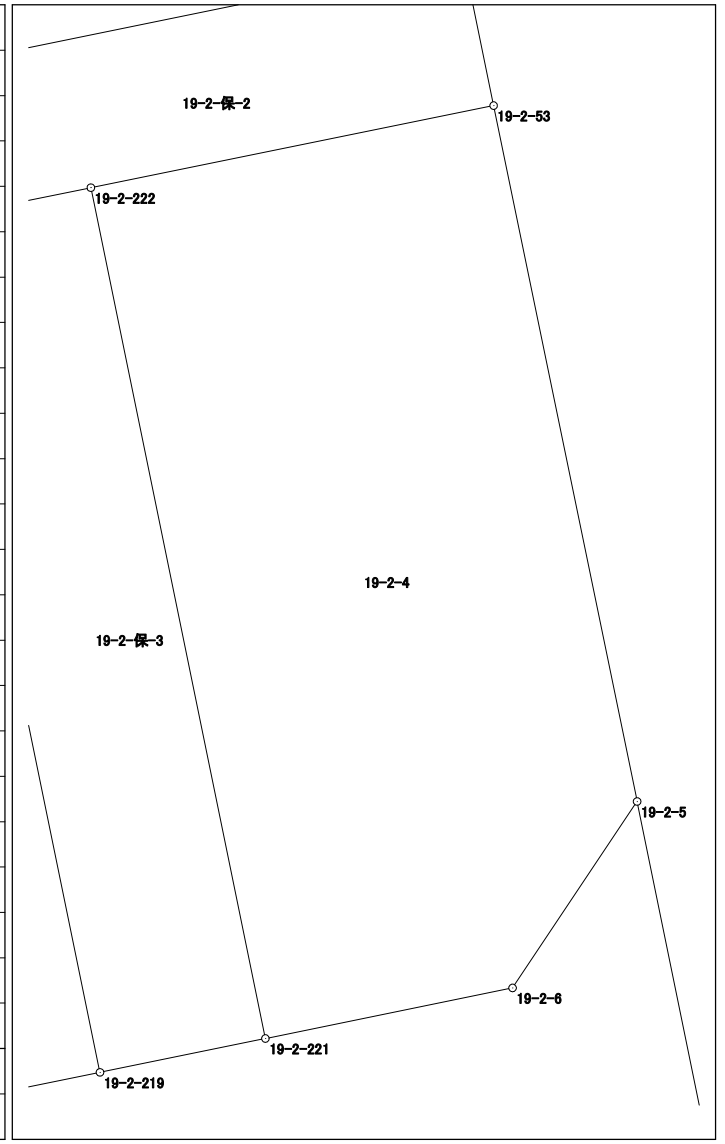


面積計算書（座標法）

世界測地系（測地成果2011）

所 在	地 番	公簿地目	現況地目	地 積	所 有 者
前橋市六供町一丁目	19-2-保-7			16.00 m ²	

点 名	X 座標	Y 座標	辺 長	方 向 角	測 角	DX	倍 積 (Y×DX)
19-2-66	41662.496	-68557.548	13.266	348-24-23	89-58-38	13.237	-907496.262876
19-2-65	41675.491	-68560.214	1.207	258-22-58	89-58-35	12.752	-874279.848928
19-2-207	41675.248	-68561.396	13.265	168-24-20	90-01-22	-13.237	907547.198852
19-2-208	41662.254	-68558.730	1.207	78-25-45	90-01-25	-12.752	874260.924960
						倍面積	32.012008
						面 積	16.0060040

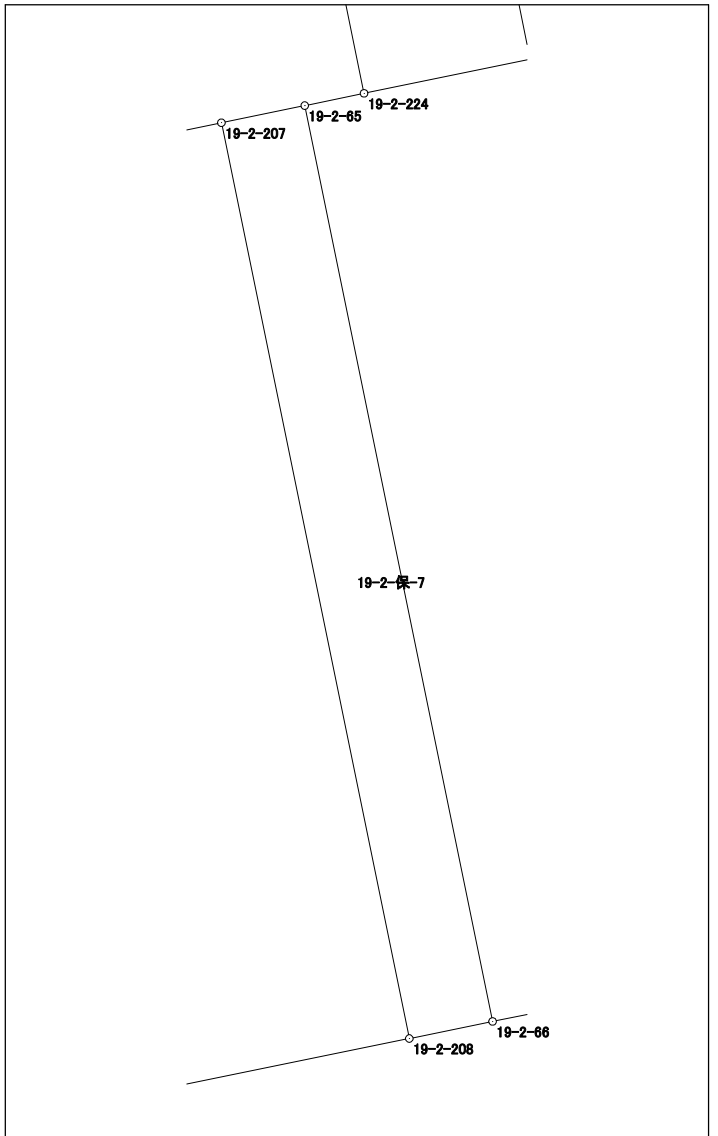


面積計算書（座標法）

世界測地系（測地成果2011）

所 在	地 番	公簿地目	現況地目	地 積	所 有 者
前橋市六供町一丁目	19-2-保-8			19.00 m ²	

点 名	X 座標	Y 座標	辺 長	方 向 角	測 角	DX	倍 積 (Y×DX)
19-2-79	41674.027	-68567.345	1.432	258-21-38	89-58-14	12.702	-870942.416190
19-2-205	41673.738	-68568.748	13.264	168-23-31	90-01-53	-13.282	910730.110936
19-2-206	41660.745	-68566.079	1.433	78-16-56	89-53-25	-12.702	870926.335458
19-2-80	41661.036	-68564.676	13.262	348-23-24	90-06-28	13.282	-910676.026632
						倍面積	38.003572
						面 積	19.0017860

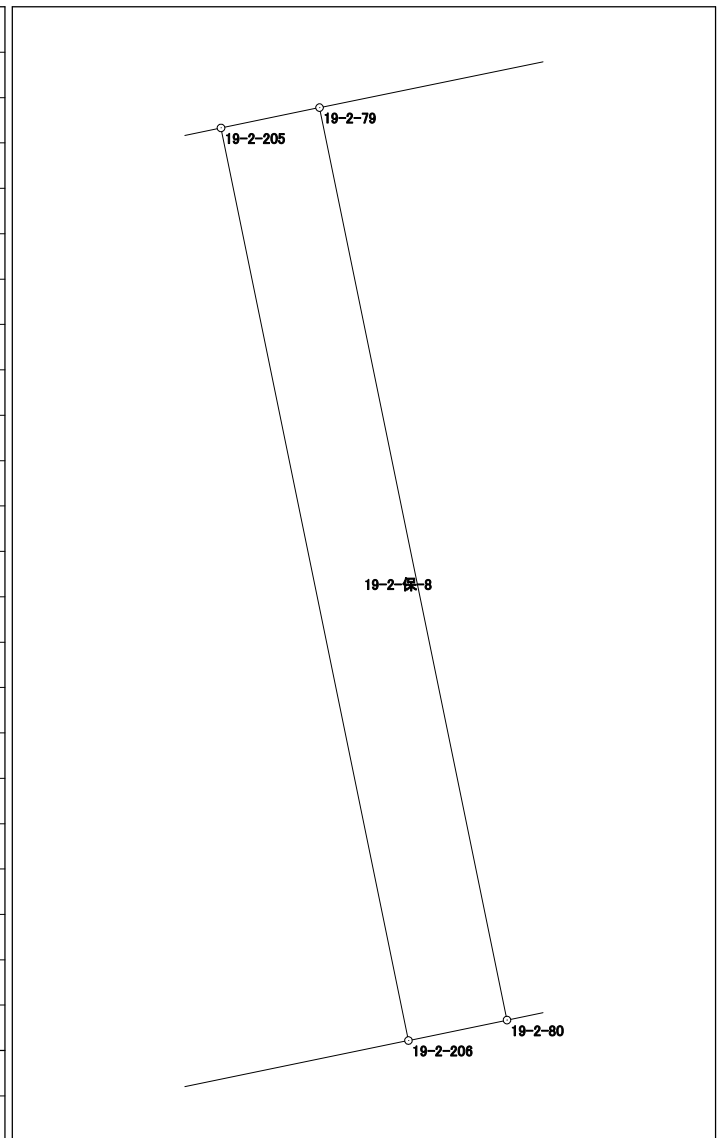

面積計算書（座標法）

世界測地系（測地成果2011）

所 在	地 番	公簿地目	現況地目	地 積	所 有 者
前橋市六供町一丁目	19-2-保-11			19.00 m ²	

点 名	X 座標	Y 座標	辺 長	方 向 角	測 角	DX	倍 積 (Y×DX)
19-2-213	41680.537	-68546.860	1.225	258-27-39	90-03-01	14.959	-1025392.478740
19-2-215	41680.292	-68548.060	15.523	168-24-31	89-56-52	-15.451	1059136.075060
19-2-216	41665.086	-68544.941	1.224	78-21-35	89-57-04	-14.959	1025363.772419
19-2-214	41665.333	-68543.742	15.520	348-24-38	90-03-03	15.451	-1059069.357642
						倍面積	38.011097
						面 積	19.0055485

