

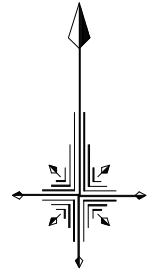


207 (2/2) 街区 画地出来形確認図 (93550.16m²)

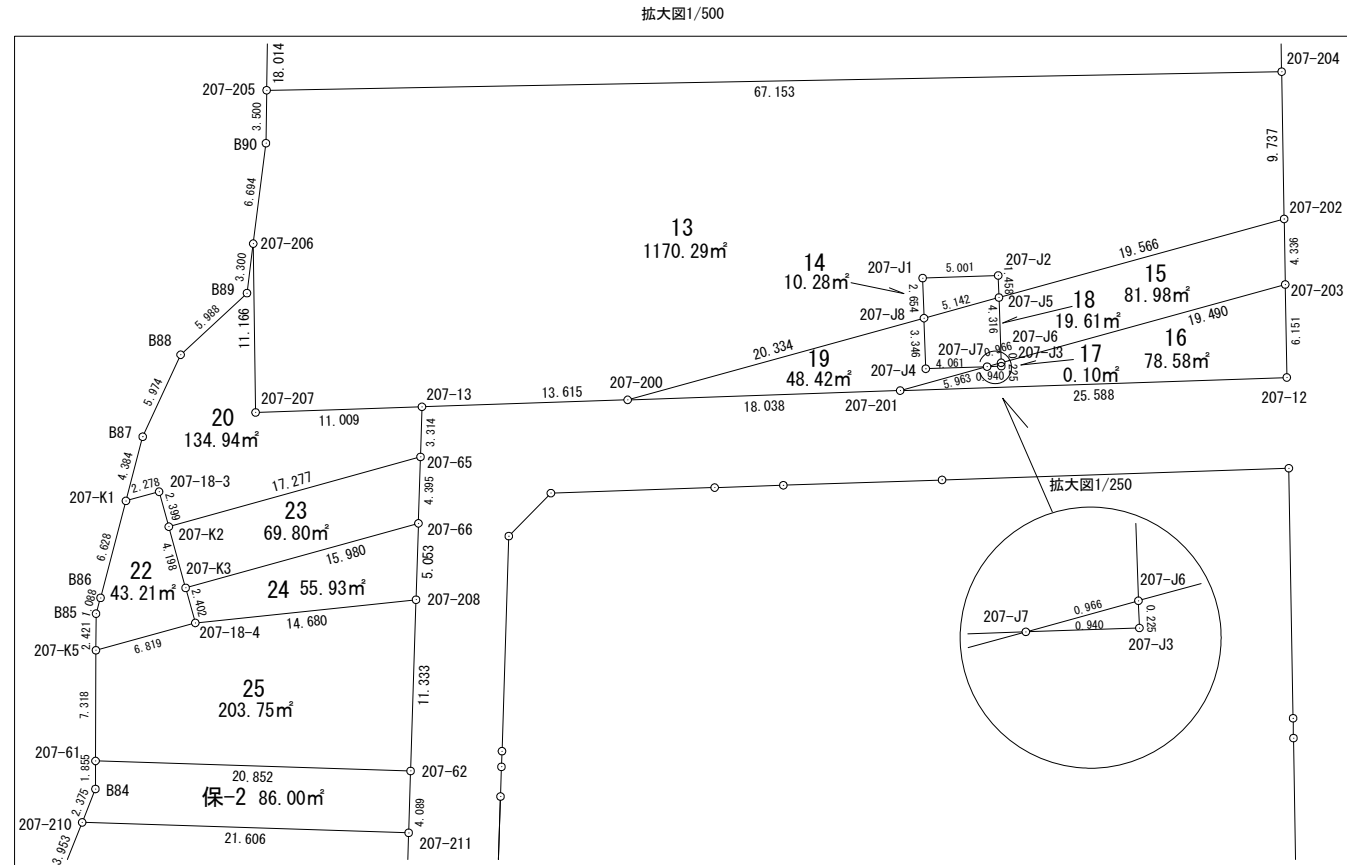

S=1/2000

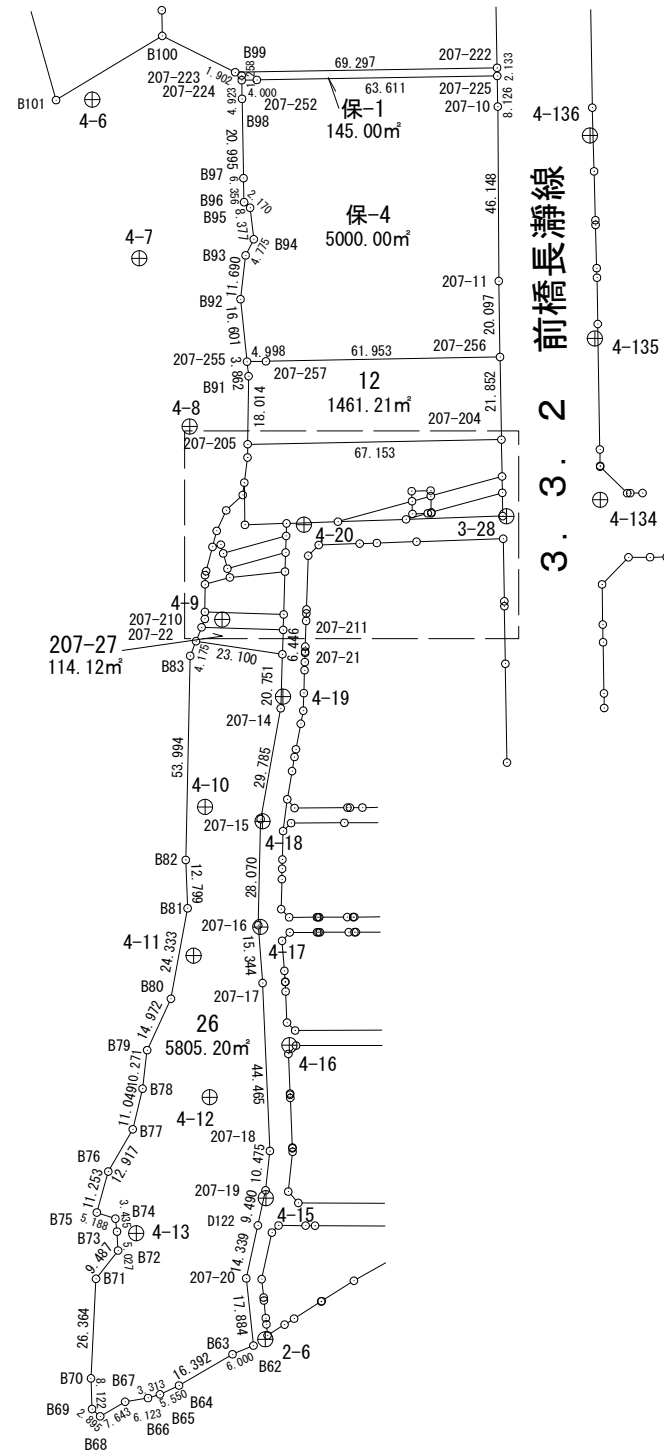


面積計算書（座標法）

世界測地系（測地成果2011）

所在	地番	公簿地目	現況地目	地積	所有者
前橋市六供町三丁目	207-7			8982.85 m ²	

点名	X座標	Y座標	辺長	方向角	測角	DX	倍積 (Y×DX)
207-229	41165.179	-68490.831	26.565	161-58-47	89-19-03	-28.540	1954728.316740
207-230	41139.917	-68482.613	85.857	81-58-08	99-59-21	-13.267	908558.826671
207-232	41151.912	-68397.598	54.970	169-16-21	267-18-13	-42.014	2873656.682372
207-231	41097.903	-68387.366	71.569	80-48-08	91-31-47	-42.569	2911181.783254
207-215	41109.343	-68316.717	0.520	351-35-21	90-47-13	11.954	-816658.035018
207-83	41109.857	-68316.793	8.023	350-59-10	179-23-49	8.438	-576457.099334
207-82	41117.781	-68318.050	8.014	350-14-38	179-15-28	15.822	-1080928.187100
207-81	41125.679	-68319.408	8.019	349-32-47	179-18-09	15.784	-1078353.535872
207-80	41133.565	-68320.863	8.016	349-04-37	179-31-50	15.757	-1076531.838291
207-6	41141.436	-68322.382	42.182	348-45-27	179-40-50	49.244	-3364467.379208
207-5	41182.809	-68330.606	12.030	308-26-20	139-40-53	48.852	-3338086.764312
207-4	41190.288	-68340.029	4.918	268-59-11	140-32-51	7.392	-505169.494368
207-3	41190.201	-68344.946	6.106	269-08-12	180-09-01	-0.179	12233.745334
207-98	41190.109	-68351.051	6.109	268-26-01	179-17-49	-0.259	17702.922209
207-99	41189.942	-68357.158	6.108	267-37-34	179-11-33	-0.420	28710.006360
207-100	41189.689	-68363.261	6.089	266-37-11	178-59-37	-0.612	41838.315732
207-101	41189.330	-68369.339	6.106	265-43-35	179-06-24	-0.814	55652.641946
207-102	41188.875	-68375.428	6.105	265-17-33	179-33-58	-0.956	65366.909168
207-103	41188.374	-68381.512	6.102	264-47-28	179-29-55	-1.055	72142.495160
207-104	41187.820	-68387.589	6.114	263-43-37	178-56-09	-1.222	83569.633758
207-105	41187.152	-68393.666	3.668	262-52-30	179-08-53	-1.123	76806.086918
207-106	41186.697	-68397.306	4.025	262-14-47	179-22-17	-0.998	68260.511388

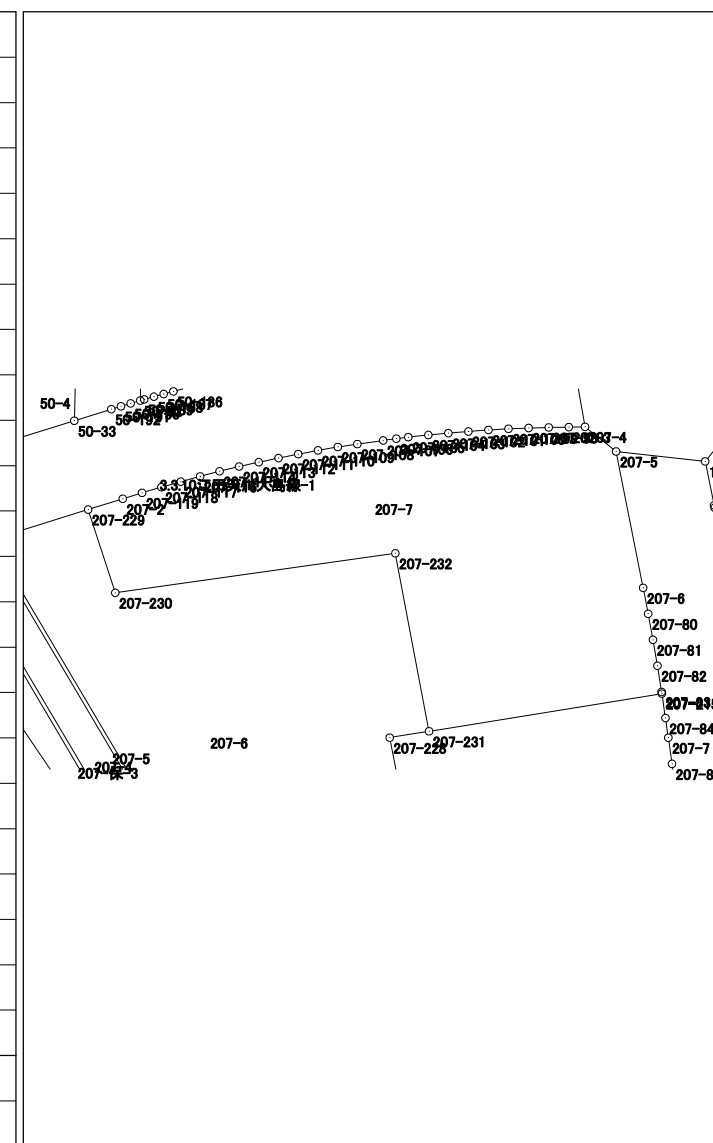

倍面積	
面積	


面積計算書 (座標法)

世界測地系 (測地成果2011)

所在	地番	公簿地目	現況地目	地積	所有者
前橋市六供町三丁目	207-8			17528.72 m ²	

点名	X座標	Y座標	辺長	方向角	測角	DX	倍積 (Y×DX)
207-228	41095.969	-68399.308	13.628	168-58-02	88-09-59	-15.310	1047193.405480
207-213	41082.593	-68396.700	0.454	264-18-52	275-20-50	-13.421	917952.110700
207-268	41082.548	-68397.152	199.865	175-33-31	91-14-39	-199.310	13632236.365120
207-267	40883.283	-68381.675	15.106	62-20-15	66-46-44	-192.252	13146513.782100
J4-6KO	40890.296	-68368.296	34.356	90-11-00	207-50-45	6.903	-471946.347288
J4-5	40890.186	-68333.940	11.587	90-10-59	179-59-59	-0.147	10045.089180
J4-4	40890.149	-68322.353	2.574	90-10-41	179-59-42	-0.045	3074.505885
J4-2KO	40890.141	-68319.779	0.990	359-00-58	88-50-17	0.982	-67090.022978
J4-2	40891.131	-68319.796	14.412	89-05-22	270-04-24	1.219	-83281.831324
J4-1	40891.360	-68305.386	0.011	90-00-00	180-54-38	0.229	-15641.933394
J4-1KO	40891.360	-68305.375	2.796	359-08-22	89-08-22	2.796	-190981.828500
207-95	40894.156	-68305.417	110.247	359-01-54	179-53-32	113.027	-7720356.367259
207-9	41004.387	-68307.280	8.022	358-47-08	179-45-14	118.251	-8077404.167280
207-94	41012.407	-68307.450	8.003	358-16-53	179-29-45	16.019	-1094217.041550
207-93	41020.406	-68307.690	8.028	357-36-56	179-20-03	16.020	-1094289.193800
207-92	41028.427	-68308.024	7.781	356-54-48	179-17-52	15.791	-1078652.006984
207-91	41036.197	-68308.443	8.013	356-25-20	179-30-32	15.767	-1077019.220781
207-90	41044.194	-68308.943	8.026	355-52-38	179-27-18	16.002	-1093079.705886
207-8	41052.199	-68309.520	9.960	354-27-05	178-34-27	17.918	-1223969.979360
207-89	41062.112	-68310.483	6.066	353-54-55	179-27-50	15.945	-1089210.651435
207-88	41068.144	-68311.126	4.005	352-52-17	178-57-22	10.006	-683521.126756
207-87	41072.118	-68311.623	8.027	353-13-03	180-20-46	11.945	-815982.336735

倍面積
面積

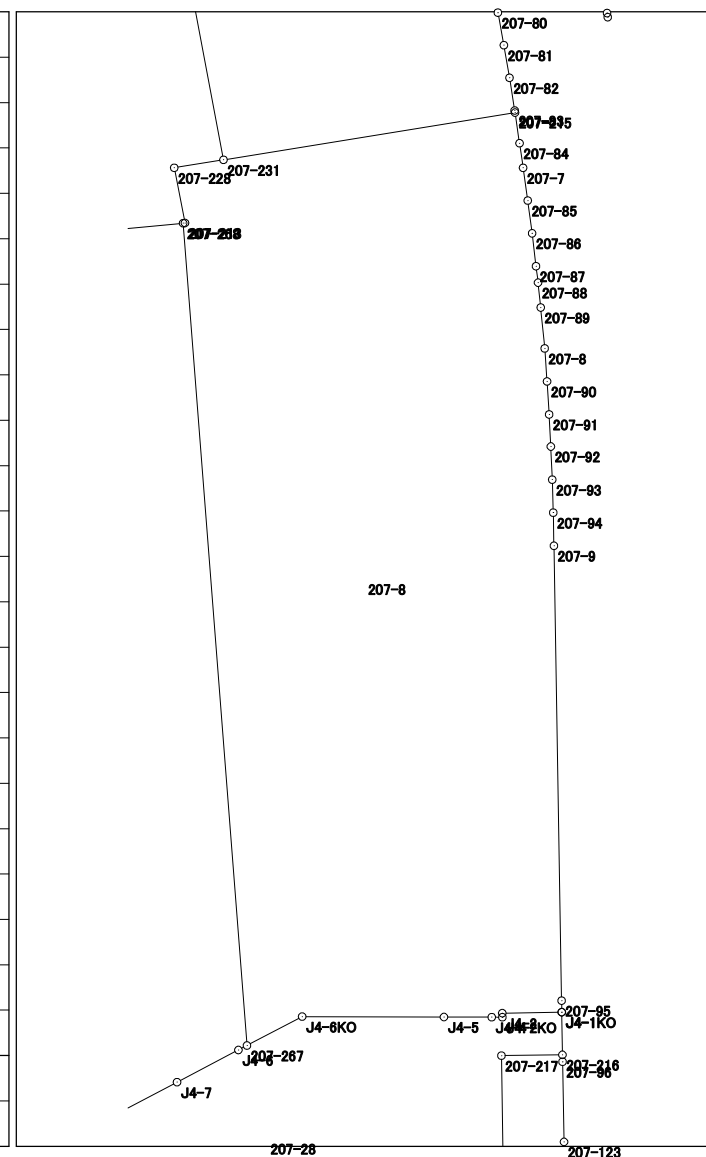


面積計算書 (座標法)

世界測地系 (測地成果2011)

所在	地番	公簿地目	現況地目	地積	所有者
前橋市六供町三丁目	207-9			14957.34 m ²	

点名	X座標	Y座標	辺長	方向角	測角	Dx	倍積 (Y×Dx)
207-238	41079.018	-68433.295	34.642	169-12-08	84-46-50	-37.559	2570286.126905
207-243	41044.989	-68426.805	8.919	259-03-29	269-51-21	-35.722	2444342.328210
207-244	41043.296	-68435.562	7.609	171-34-53	92-31-24	-9.220	630975.881640
207-237	41035.769	-68434.448	12.749	242-37-15	251-02-22	-13.390	916337.258720
207-242	41029.906	-68445.769	1.113	242-40-31	180-03-16	-6.374	436273.331606
207-246	41029.395	-68446.758	10.048	242-39-53	179-59-22	-5.125	350789.634750
207-248	41024.781	-68455.684	1.160	242-38-22	179-58-29	-5.147	352341.405548
207-250	41024.248	-68456.714	2.765	242-39-23	180-01-01	-1.803	123427.455342
207-251	41022.978	-68459.170	20.474	242-39-50	180-00-27	-10.672	730596.262240
207-235	41013.576	-68477.358	66.355	327-36-48	264-56-58	46.632	-3193236.158256
207-236	41069.610	-68512.900	13.240	283-56-46	136-19-58	59.225	-4057676.502500
207-240	41072.801	-68525.750	30.247	333-13-29	229-16-43	30.195	-2069135.021250
207-239	41099.805	-68539.376	9.040	243-45-29	90-32-00	23.007	-1576885.423632
207-265	41095.808	-68547.484	265.434	150-24-38	86-39-09	-234.815	16095977.455460
207-266	40864.990	-68416.418	20.132	62-07-12	91-42-34	-221.404	15147668.610872
J4-7	40874.404	-68398.623	16.790	62-20-43	180-13-31	17.207	-1176935.105961
J4-6	40882.197	-68383.751	2.343	62-23-06	180-02-23	8.879	-607179.325129
207-267	40883.283	-68381.675	199.865	355-33-31	113-10-25	200.351	-13700336.967925
207-268	41082.548	-68397.152	36.315	264-25-18	88-51-47	195.735	-13387716.546720

倍面積	29914.699920
面積	14957.3499600

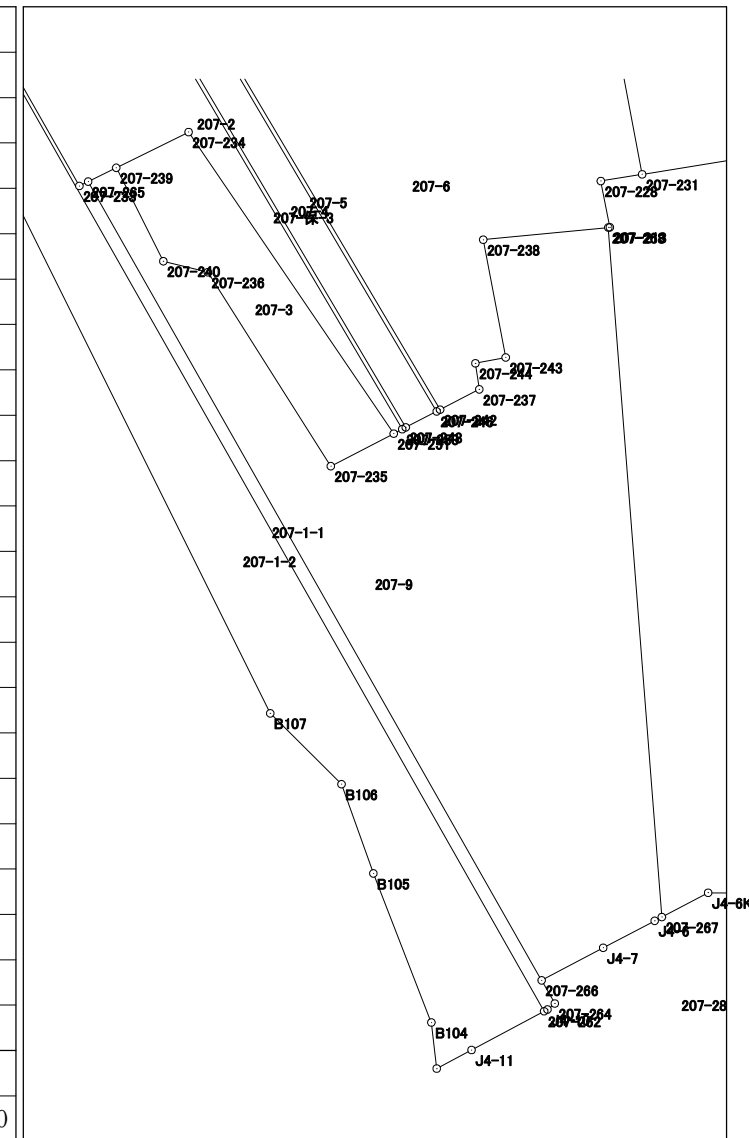


面積計算書（座標法）

世界測地系（測地成果2011）

所在	地番	公簿地目	現況地目	地積	所有者
前橋市六供町三丁目	207-26			5805.20 m ²	

点名	X座標	Y座標	辺長	方向角	測角	DX	倍積 (Y×DX)
207-22	40620.207	-68382.992	4.175	201-37-04	103-00-40	-0.424	28994.388608
B83	40616.326	-68384.530	53.994	181-15-54	159-38-50	-57.862	3956865.674860
B82	40562.345	-68385.722	12.799	177-49-10	176-33-16	-66.771	4566183.043662
B81	40549.555	-68385.235	24.333	190-25-04	192-35-54	-36.722	2511242.599670
B80	40525.623	-68389.635	14.972	204-51-49	194-26-45	-37.516	2565705.546660
B79	40512.039	-68395.930	10.271	186-52-01	162-00-12	-23.781	1626523.611330
B78	40501.842	-68397.158	11.049	193-32-08	186-40-07	-20.939	1432168.091362
B77	40491.100	-68399.744	12.917	210-04-28	196-32-20	-21.920	1499322.388480
B76	40479.922	-68406.217	11.253	195-38-31	165-34-03	-22.014	1505894.461038
B75	40469.086	-68409.251	5.188	108-22-07	92-43-36	-12.471	853131.769221
B74	40467.451	-68404.327	3.435	172-54-37	244-32-30	-5.044	345031.425388
B73	40464.042	-68403.903	5.027	176-45-00	183-50-23	-8.428	576508.094484
B72	40459.023	-68403.618	9.487	218-00-32	221-15-32	-12.494	854634.803292
B71	40451.548	-68409.460	26.364	182-54-33	144-54-01	-33.805	2312581.795300
B70	40425.218	-68410.798	8.122	178-01-28	175-06-55	-34.447	2356546.758706
B69	40417.101	-68410.518	2.895	131-37-31	133-36-03	-10.040	686841.600720
B68	40415.178	-68408.354	7.643	59-47-18	108-09-47	1.923	-131549.264742
B67	40419.024	-68401.749	6.123	80-42-19	200-55-01	4.835	-330722.456415
B66	40420.013	-68395.706	3.313	72-59-33	172-17-14	1.958	-133918.792348
B65	40420.982	-68392.538	5.550	65-05-16	172-05-43	3.307	-226174.123166
B64	40423.320	-68387.504	16.392	59-43-17	174-38-01	10.603	-725112.704912
B63	40431.585	-68373.348	6.000	67-26-23	187-43-06	10.567	-722501.168316

倍面積	
面積	

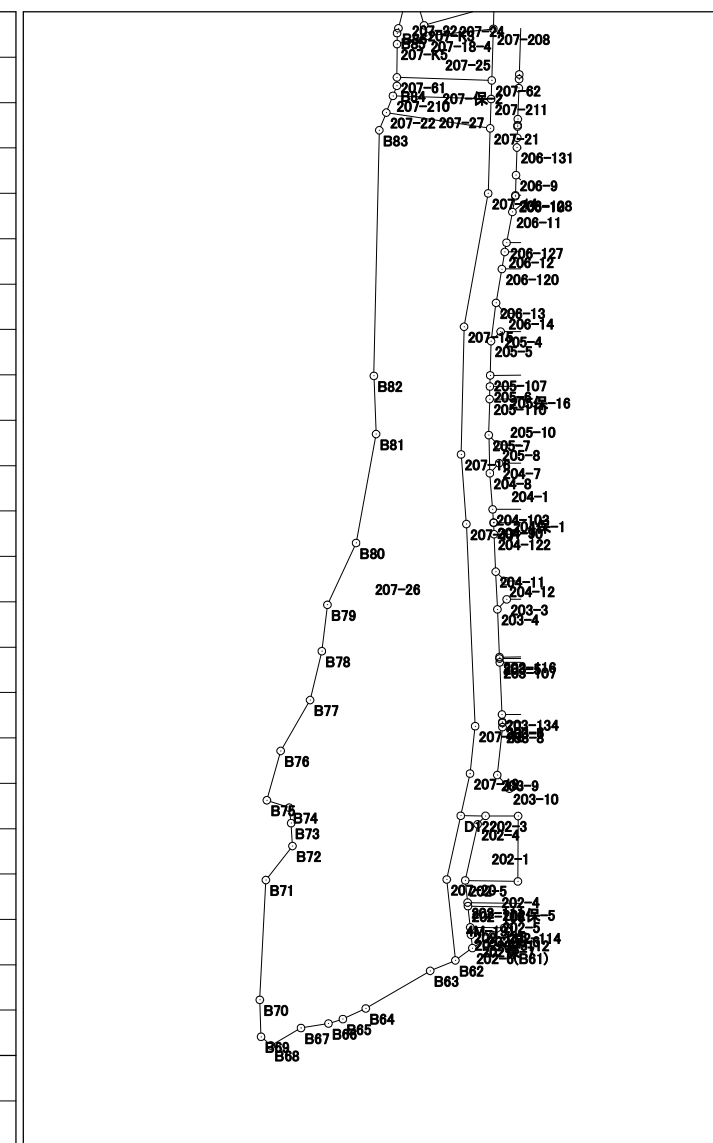


面積計算書 (座標法)

世界測地系 (測地成果2011)

所在	地番	公簿地目	現況地目	地積	所有者
前橋市六供町三丁目	207-28			5733.41 m ²	

点名	X座標	Y座標	辺長	方向角	測角	DX	倍積 (Y×DX)
J4-11KO	40839.500	-68446.749	5.222	173-24-06	111-27-03	-10.554	722386.988946
B103	40834.313	-68446.149	5.637	137-51-42	144-27-36	-9.367	641135.077683
207-219	40830.133	-68442.367	123.201	89-02-01	131-10-19	-2.102	143865.855434
207-218	40832.211	-68319.184	48.623	359-02-10	90-00-09	50.694	-3463372.713696
207-217	40880.827	-68320.002	14.785	89-11-24	270-09-14	48.825	-3335724.097650
207-216	40881.036	-68305.218	10.325	359-07-44	89-56-20	10.533	-719458.861194
J4-1KO	40891.360	-68305.375	0.011	270-00-00	90-52-16	10.324	-705184.691500
J4-1	40891.360	-68305.386	14.412	269-05-22	179-05-22	-0.229	15641.933394
J4-2	40891.131	-68319.796	0.990	179-00-58	89-55-36	-1.219	83281.831324
J4-2KO	40890.141	-68319.779	2.574	270-10-41	271-09-43	-0.982	67090.022978
J4-4	40890.149	-68322.353	11.587	270-10-59	180-00-18	0.045	-3074.505885
J4-5	40890.186	-68333.940	34.356	270-11-00	180-00-01	0.147	-10045.089180
J4-6KO	40890.296	-68368.296	15.106	242-20-15	152-09-15	-6.903	471946.347288
207-267	40883.283	-68381.675	2.343	242-23-06	180-02-51	-8.099	553823.185825
J4-6	40882.197	-68383.751	16.790	242-20-43	179-57-37	-8.879	607179.325129
J4-7	40874.404	-68398.623	20.132	242-07-12	179-46-29	-17.207	1176935.105961
207-266	40864.990	-68416.418	7.695	150-24-24	88-17-12	-16.105	1101846.411890
207-264	40858.299	-68412.618	2.729	230-29-15	260-04-51	-8.427	576513.131886
J4-10	40856.563	-68414.723	1.098	241-57-52	191-28-37	-2.252	154069.956196
207-262	40856.047	-68415.692	23.776	241-57-07	179-59-15	-11.696	800189.933632
J4-11	40844.867	-68436.676	11.414	241-57-03	179-59-56	-16.547	1132421.677772

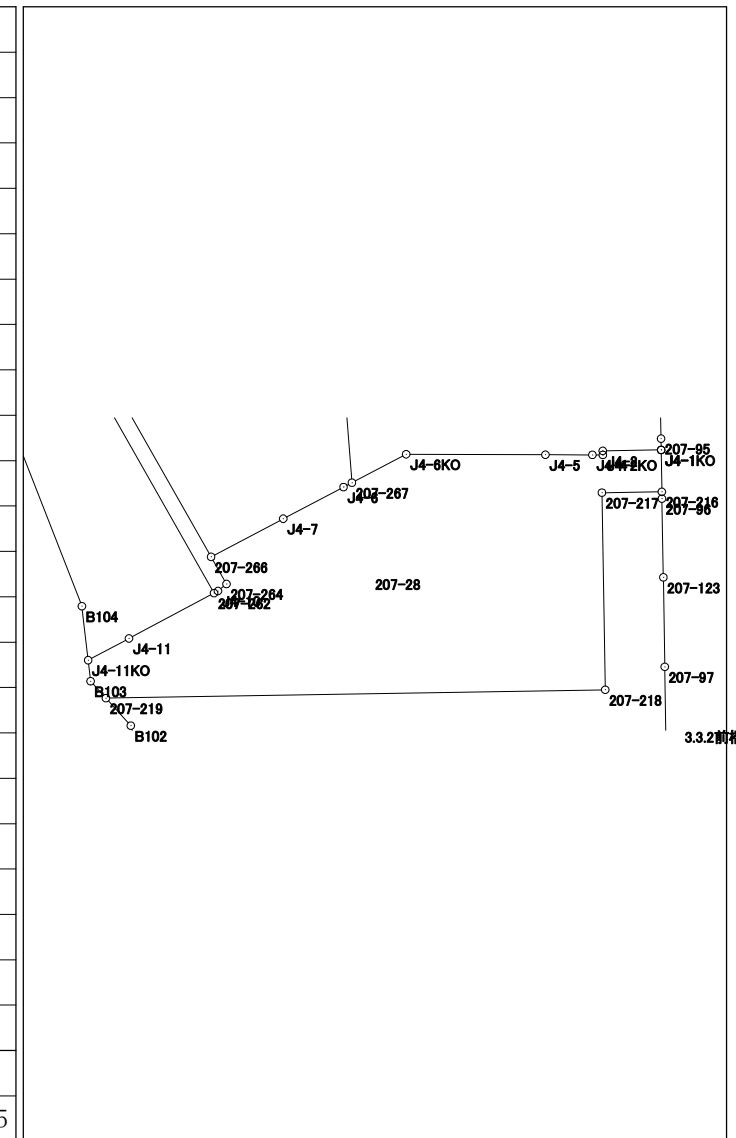

倍面積	11466.826233
面積	5733.4131165

