


3-3街区 画地出来形確認図 (744.12㎡)
 3-4街区 (773.77㎡) (拡大図)

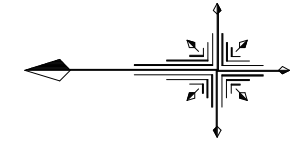

S=1/250

