



3-3街区 画地出来形確認図 (744.12㎡)
 3-4街区 (773.77㎡) (拡大図)

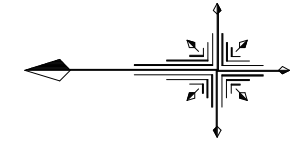

S=1/250

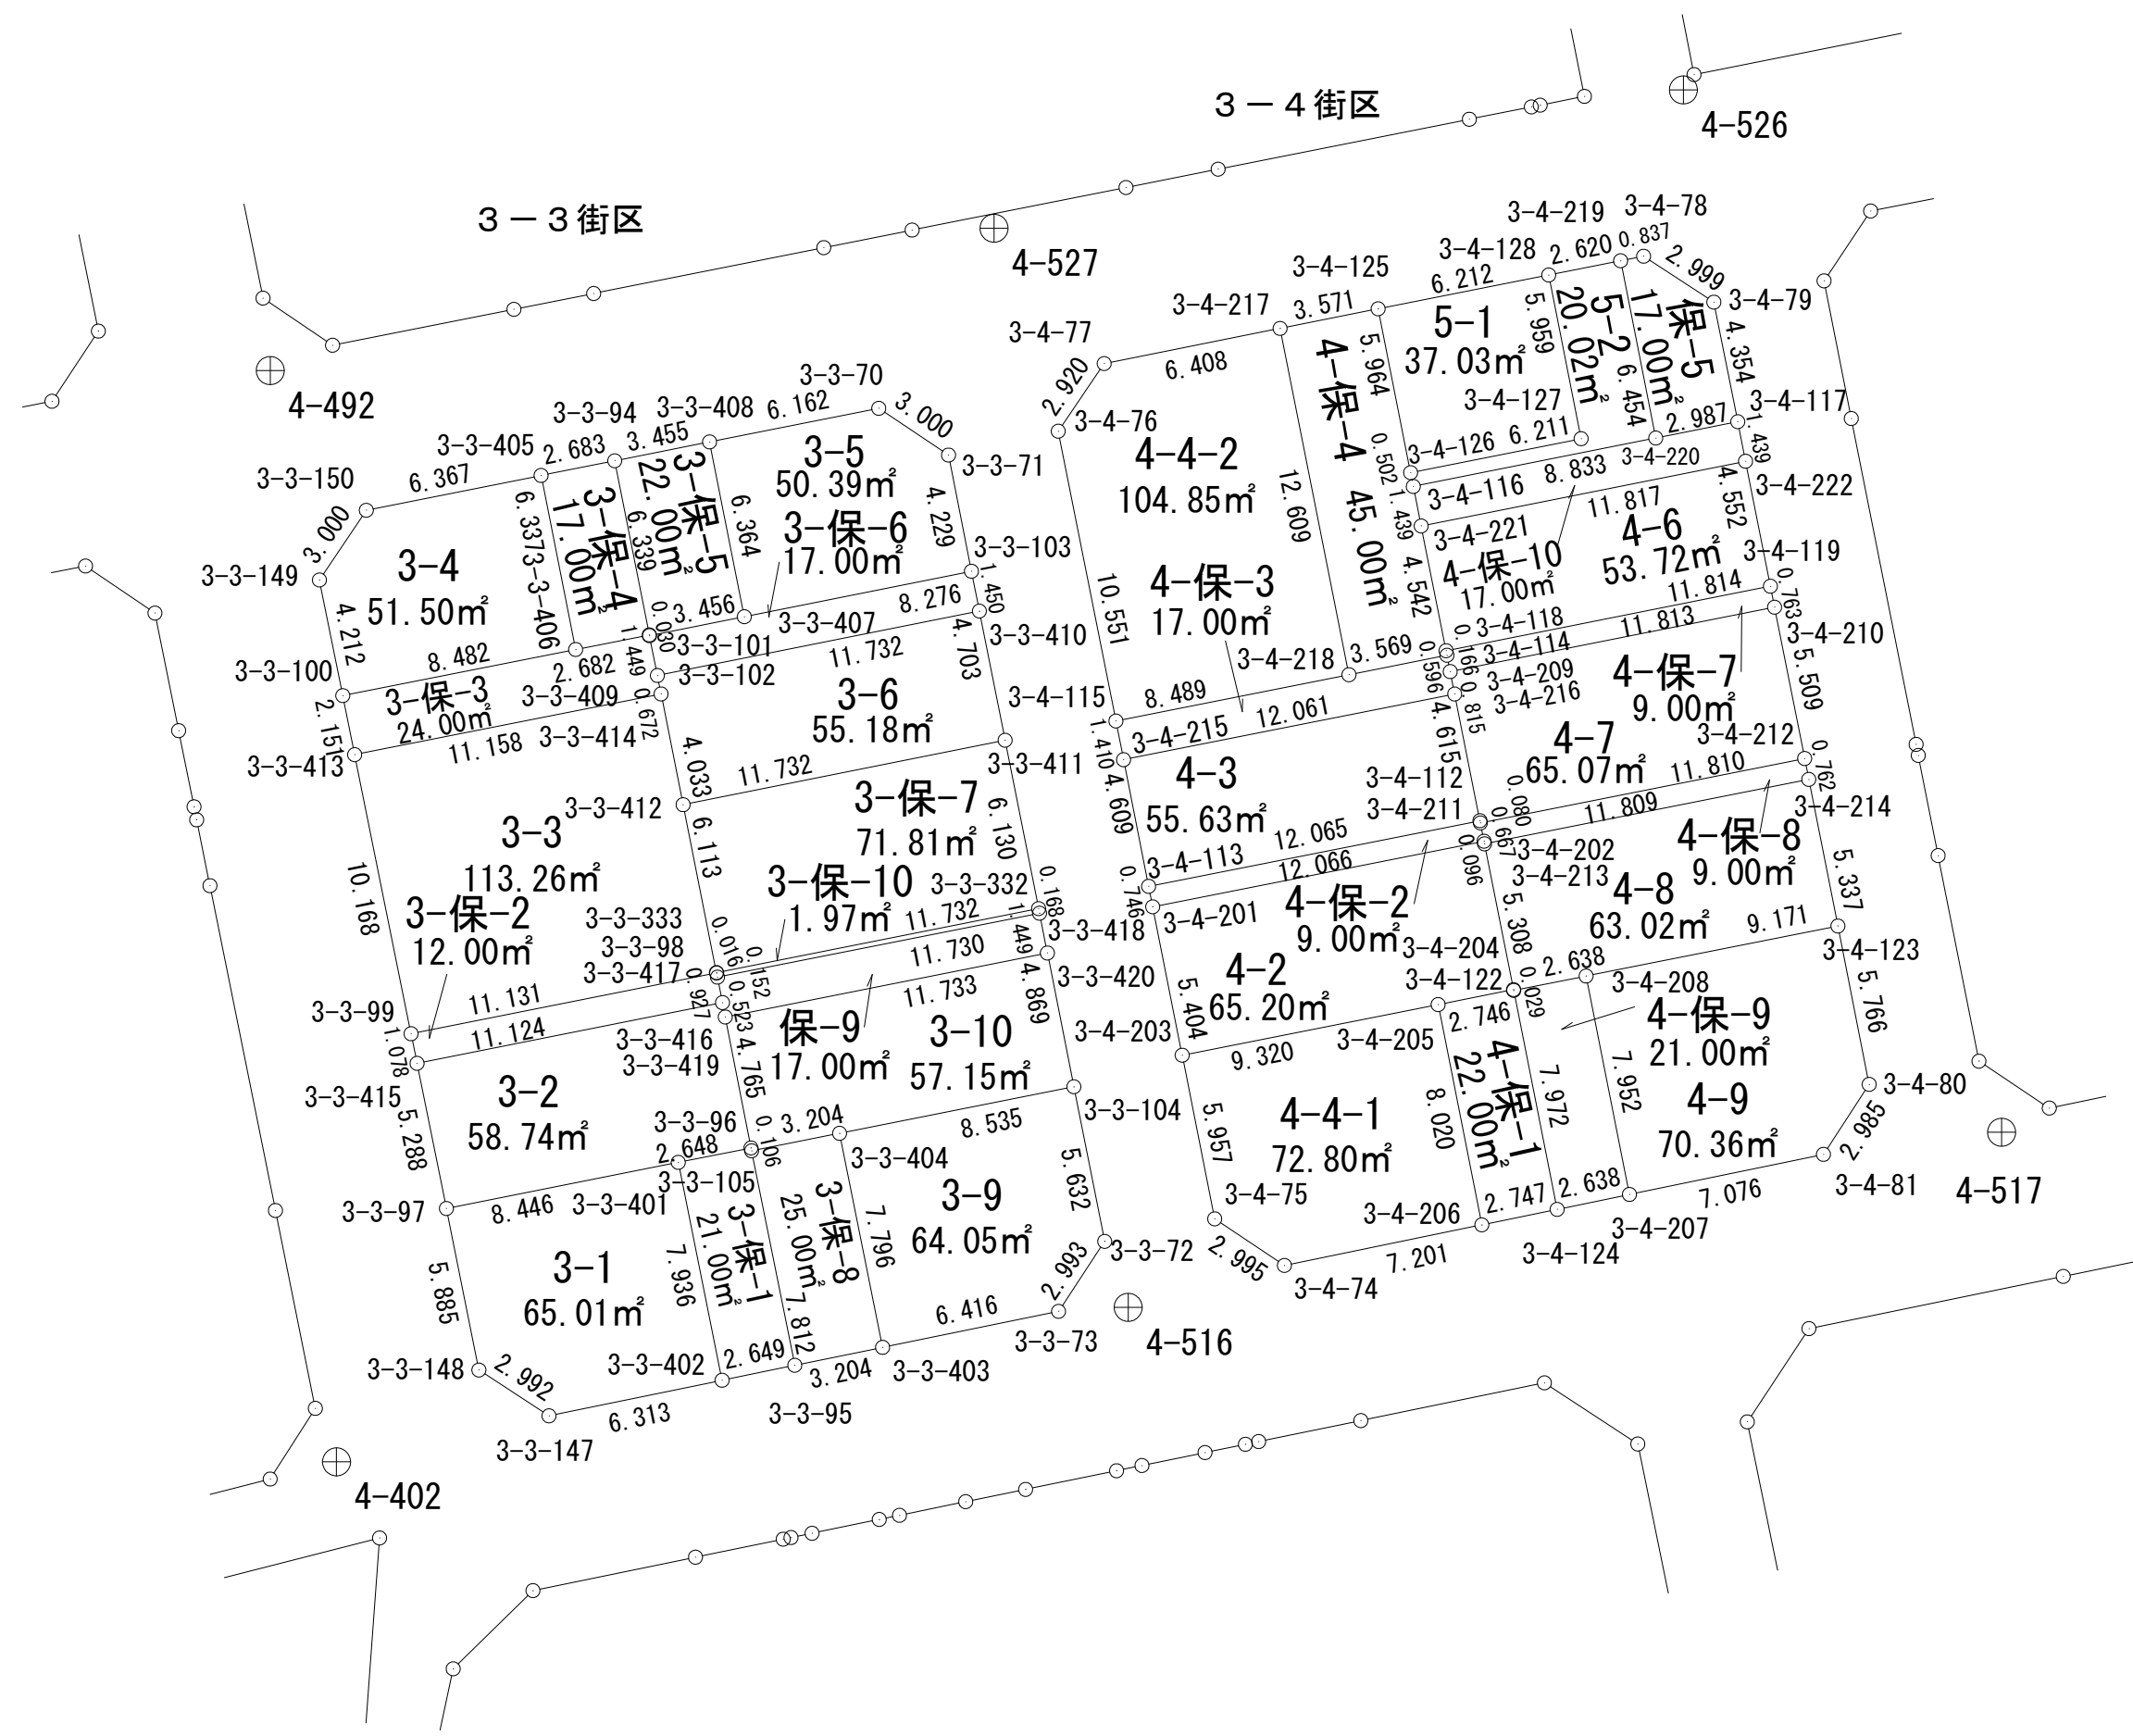


面積計算書 (座標法)

世界測地系 (測地成果2011)

所 在	地 番	公簿地目	現況地目	地 積	所 有 者
前橋市六供町一丁目	3-4-9			70.36 m ²	

点 名	X 座標	Y 座標	辺 長	方 向 角	測 角	DX	倍 積 (Y×DX)
3-4-207	41800.277	-68504.080	7.076	168-20-27	89-34-23	-8.479	580846.094320
3-4-81	41793.347	-68502.650	2.985	123-09-47	134-49-20	-8.563	586588.191950
3-4-80	41791.714	-68500.151	5.766	78-49-49	135-40-02	-0.516	35346.077916
3-4-123	41792.831	-68494.494	9.171	348-46-11	89-56-22	10.112	-692616.323328
3-4-208	41801.826	-68496.280	7.952	258-46-04	89-59-53	7.446	-510023.300880
倍面積							140.739978
面 積							70.3699890

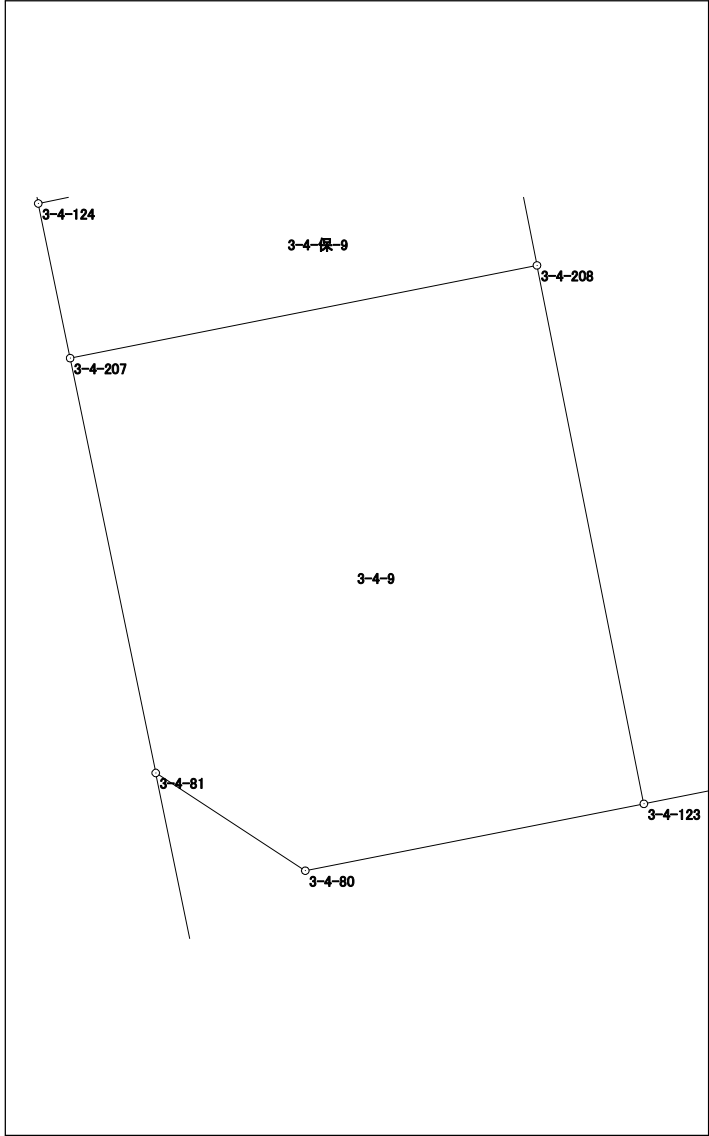


面積計算書（座標法）

世界測地系（測地成果2011）

所 在	地 番	公簿地目	現況地目	地 積	所 有 者
前橋市六供町一丁目	3-4-保-2			9.00 m ²	

点 名	X 座標	Y 座標	辺 長	方 向 角	測 角	DX	倍 積 (Y×DX)
3-4-112	41805.619	-68490.734	12.065	348-48-27	90-23-59	11.852	-811752.179368
3-4-113	41817.455	-68493.076	0.746	258-47-44	89-59-17	11.691	-800752.551516
3-4-201	41817.310	-68493.808	12.066	168-48-30	90-00-46	-11.982	820692.807456
3-4-202	41805.473	-68491.466	0.667	78-45-27	89-56-57	-11.707	801829.592462
3-4-211	41805.603	-68490.812	0.080	78-24-28	179-39-01	0.146	-9999.658552
						倍面積	18.010482
						面 積	9.0052410

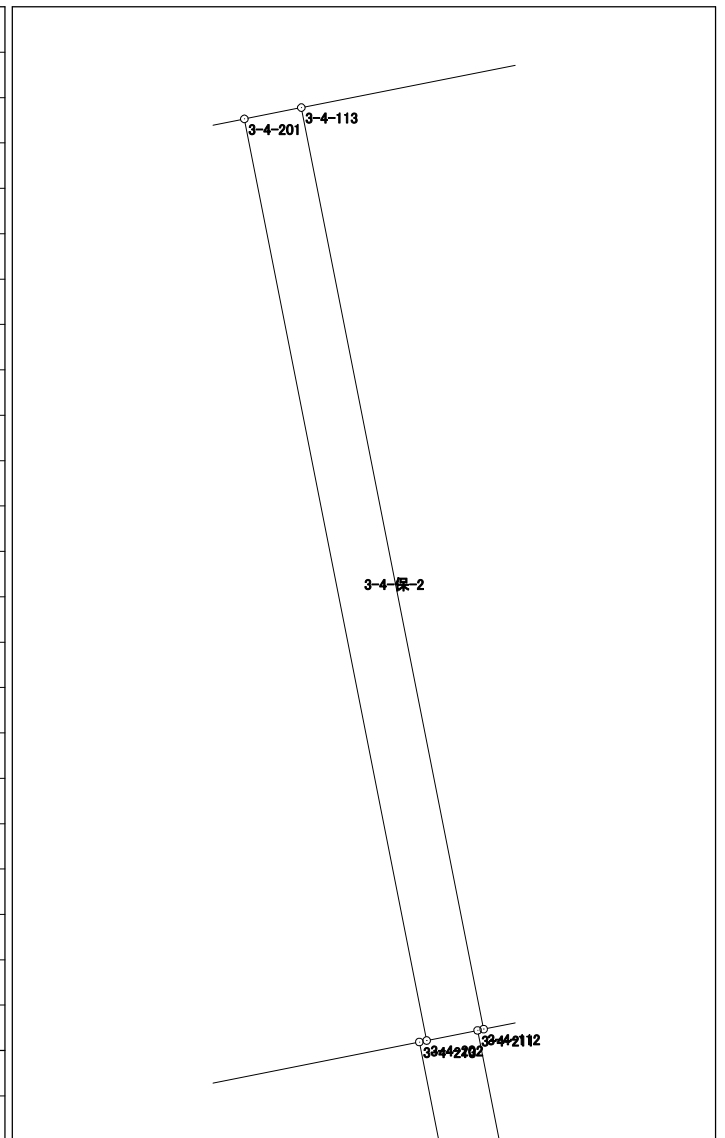


面積計算書 (座標法)

世界測地系 (測地成果2011)

所在	地番	公簿地目	現況地目	地積	所有者
前橋市六供町一丁目	3-4-保-3			17.00 m ²	

点名	X座標	Y座標	辺長	方向角	測角	DX	倍積 (Y×DX)
3-4-114	41806.797	-68484.825	3.569	348-46-19	90-06-03	3.618	-247778.096850
3-4-218	41810.298	-68485.520	8.489	348-46-44	180-00-25	11.828	-810046.730560
3-4-115	41818.625	-68487.172	1.410	258-47-37	90-00-53	8.053	-551527.196116
3-4-215	41818.351	-68488.555	12.061	168-46-43	89-59-06	-12.104	828985.469720
3-4-216	41806.521	-68486.208	0.815	78-44-43	89-58-00	-11.671	799302.533568
3-4-209	41806.680	-68485.409	0.596	78-40-16	179-55-33	0.276	-18901.972884
						倍面積	34.006878
						面積	17.0034390

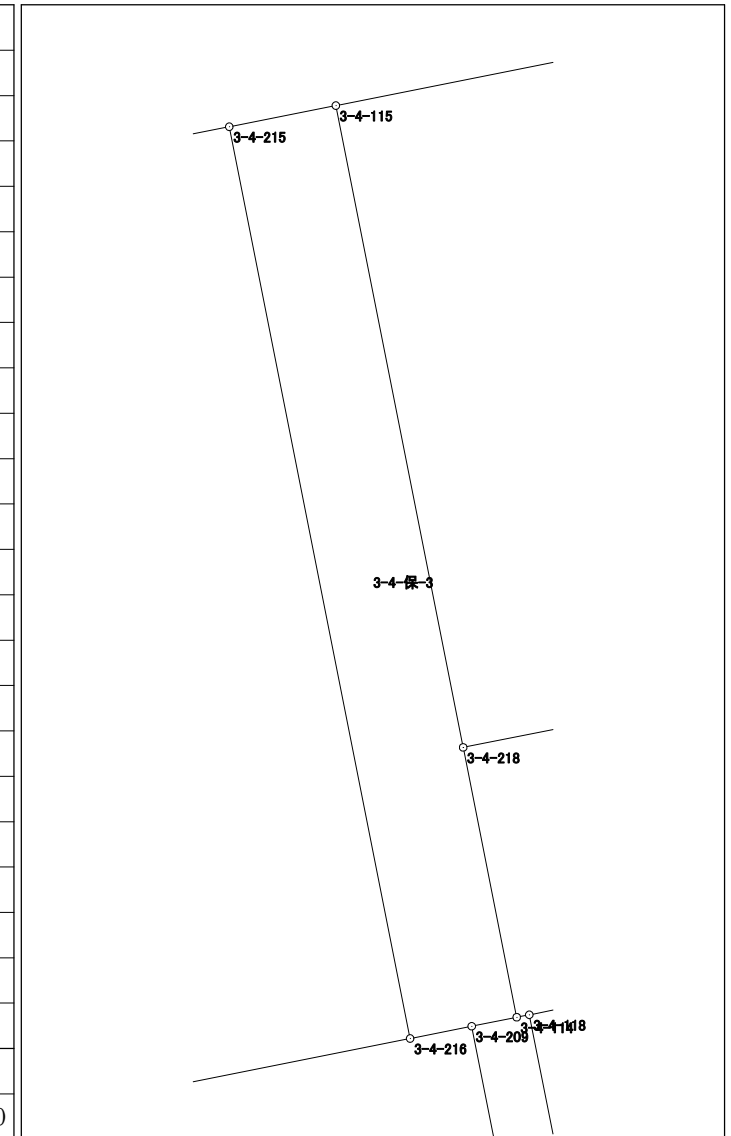

面積計算書 (座標法)

世界測地系 (測地成果2011)

所在	地番	公簿地目	現況地目	地積	所有者
前橋市六供町一丁目	3-4-保-4			45.00 m ²	

点名	X座標	Y座標	辺長	方向角	測角	DX	倍積 (Y×DX)	
3-4-118	41806.829	-68484.662	4.542	78-42-44	179-49-09	0.921	-63074.373702	
3-4-221	41807.718	-68480.208	1.439	78-41-52	179-59-08	1.171	-80190.323568	
3-4-116	41808.000	-68478.797	0.502	78-58-51	180-16-59	0.378	-25884.985266	
3-4-126	41808.096	-68478.304	5.964	78-46-29	179-47-38	1.257	-86077.228128	
3-4-125	41809.257	-68472.454	3.571	348-41-47	89-55-18	4.663	-319287.053002	
3-4-217	41812.759	-68473.154	12.609	258-44-40	90-02-53	1.041	-71280.553314	
3-4-218	41810.298	-68485.520	3.569	168-46-19	90-01-39	-5.962	408310.670240	
3-4-114	41806.797	-68484.825	0.166	78-53-35	90-07-16	-3.469	237573.857925	
						倍面積	90.011185	
						面積	45.0055925	

