


3-5街区 画地出来形確認図 (987.71m²) (拡大図)

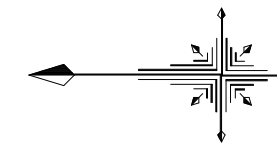

S=1/250




面積計算書 (座標法)

世界測地系 (測地成果2011)

所 在	地 番	公簿地目	現況地目	地 積	所 有 者
前橋市六供町一丁目	3-5-4			52.05 m ²	

点 名	X 座標	Y 座標	辺 長	方 向 角	測 角	D _X	倍 積 (Y×D _X)
3-5-303	41776.632	-68465.975	7.296	348-45-12	89-57-56	8.544	-584973.290400
3-5-166	41783.788	-68467.398	7.137	258-44-14	89-59-02	5.762	-394509.147276
3-5-165	41782.394	-68474.398	6.075	168-45-44	90-01-30	-7.353	503492.248494
3-5-309	41776.435	-68473.214	1.214	168-44-44	179-59-00	-7.150	489583.480100
3-5-304	41775.244	-68472.977	7.138	78-47-16	90-02-32	0.197	-13489.176469
						倍面積	104.114449
						面 積	52.0572245

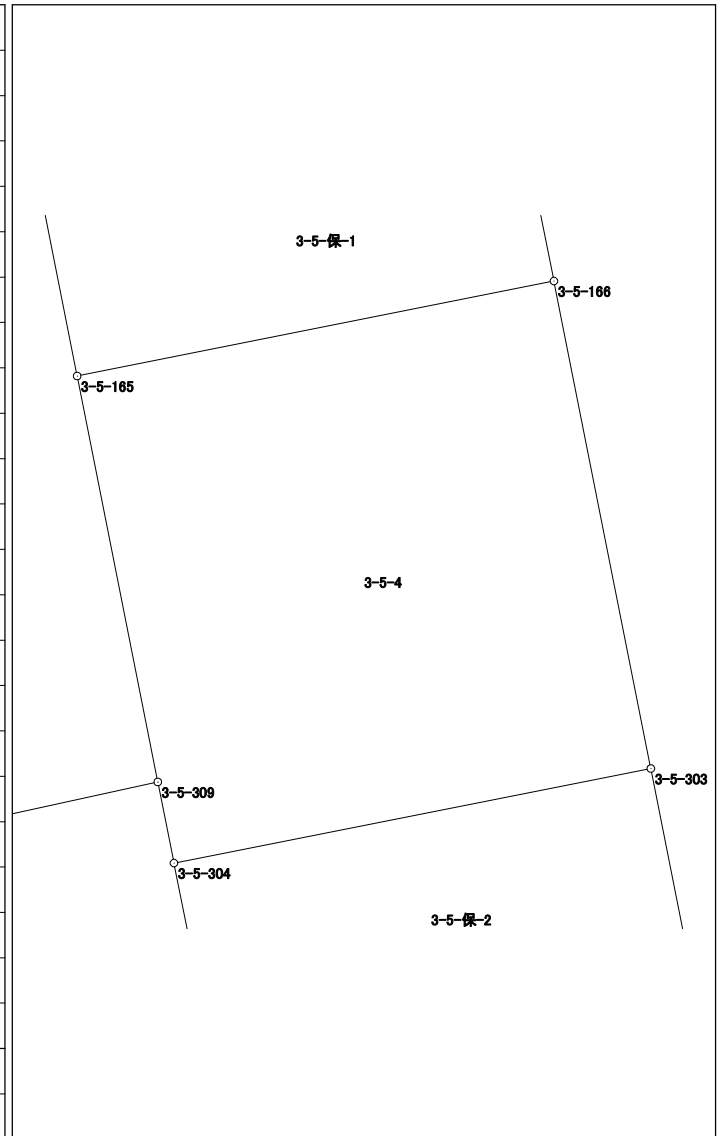


面積計算書 (座標法)

世界測地系 (測地成果2011)

所 在	地 番	公簿地目	現況地目	地 積	所 有 者
前橋市六供町一丁目	3-5-5			53.48 m ²	

点 名	X 座標	Y 座標	辺 長	方 向 角	測 角	DX	倍 積 (Y×DX)
3-5-305	41770.023	-68471.939	7.807	168-45-28	89-58-24	-9.046	619397.160194
3-5-162	41762.366	-68470.417	5.046	78-39-00	89-53-32	-6.664	456286.858888
3-5-152	41763.359	-68465.470	2.995	33-18-48	134-39-48	3.496	-239355.283120
3-5-151	41765.862	-68463.825	5.660	348-42-00	135-23-12	8.053	-551339.182725
3-5-306	41771.412	-68464.934	7.141	258-47-04	90-05-04	4.161	-284882.590374
						倍面積	106.962863
						面 積	53.4814315

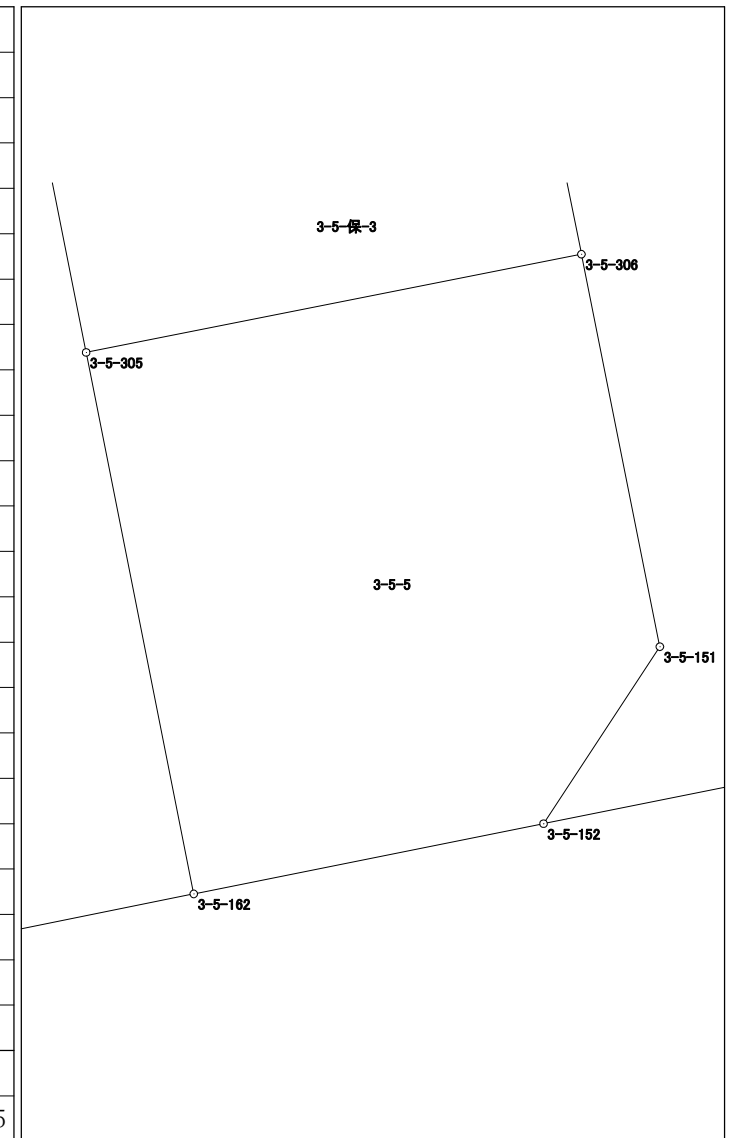


面積計算書 (座標法)

世界測地系 (測地成果2011)

所 在	地 番	公簿地目	現況地目	地 積	所 有 者
前橋市六供町一丁目	3-5-10			65.70 m ²	

点 名	X 座標	Y 座標	辺 長	方 向 角	測 角	DX	倍 積 (Y×DX)
3-5-160	41761.111	-68476.638	11.125	348-48-33	90-05-20	11.420	-782003.205960
3-5-159	41772.024	-68478.797	1.078	77-34-30	268-45-57	11.145	-763196.192565
3-5-308	41772.256	-68477.744	5.259	77-35-30	180-01-00	1.362	-93266.687328
3-5-164	41773.386	-68472.608	1.894	348-46-02	91-10-32	2.988	-204596.152704
3-5-304	41775.244	-68472.977	1.214	348-44-44	179-58-42	3.049	-208774.106873
3-5-309	41776.435	-68473.214	11.871	257-36-19	88-51-35	-1.357	92918.151398
3-5-310	41773.887	-68484.808	3.109	168-45-31	91-09-12	-5.597	383309.470376
3-5-126	41770.838	-68484.202	2.213	77-38-03	88-52-32	-2.575	176346.820150
3-5-323	41771.312	-68482.040	0.723	77-37-02	179-58-59	0.629	-43075.203160
3-5-158	41771.467	-68481.334	11.074	168-47-04	271-10-02	-10.708	733298.124472
3-5-157	41760.604	-68479.180	2.592	78-43-13	89-56-09	-10.356	709170.388080
倍面積						131.405886	
面 積						65.7029430	

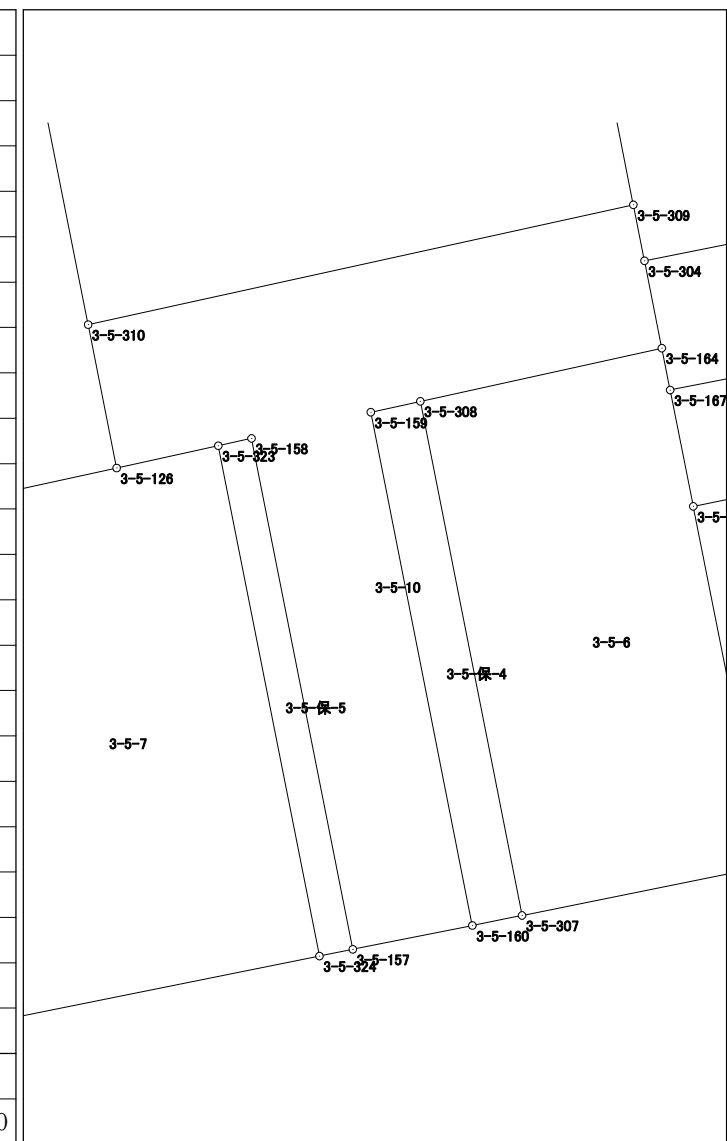


面積計算書（座標法）

世界測地系（測地成果2011）

所 在	地 番	公簿地目	現況地目	地 積	所 有 者
前橋市六供町一丁目	3-5-11			27.14 m ²	


点 名	X 座 標	Y 座 標	辺 長	方 向 角	測 角	DX	倍 積 (Y×DX)
3-5-313	41789.959	-68488.403	3.647	258-46-24	89-56-00	6.574	-450242.761322
3-5-315	41789.249	-68491.980	5.794	168-50-01	90-03-37	-6.394	437937.720120
3-5-317	41783.565	-68490.858	1.671	168-49-04	179-59-03	-7.323	501558.553134
3-5-316	41781.926	-68490.534	3.646	78-08-40	89-19-36	-0.890	60956.575260
3-5-314	41782.675	-68486.966	7.424	348-50-24	90-41-44	8.033	-550155.797878
						倍面積	54.289314
						面 積	27.1446570

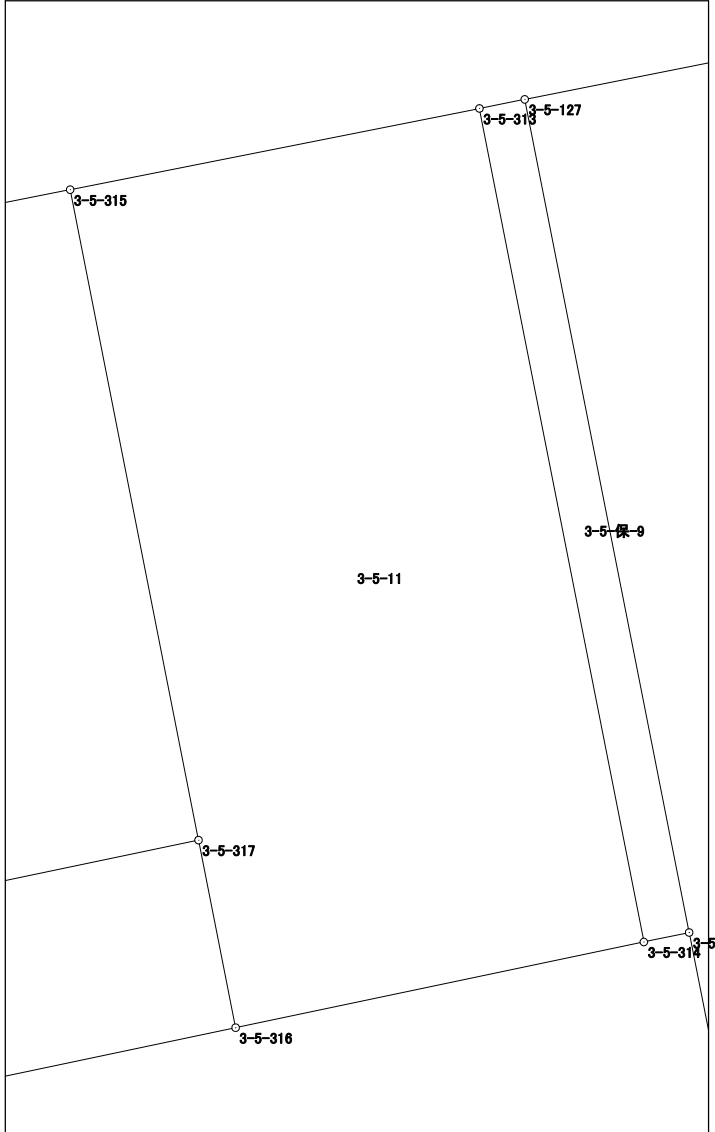

面積計算書（座標法）

世界測地系（測地成果2011）

所 在	地 番	公簿地目	現況地目	地 積	所 有 者
前橋市六供町一丁目	3-5-保-2			20.00 m ²	

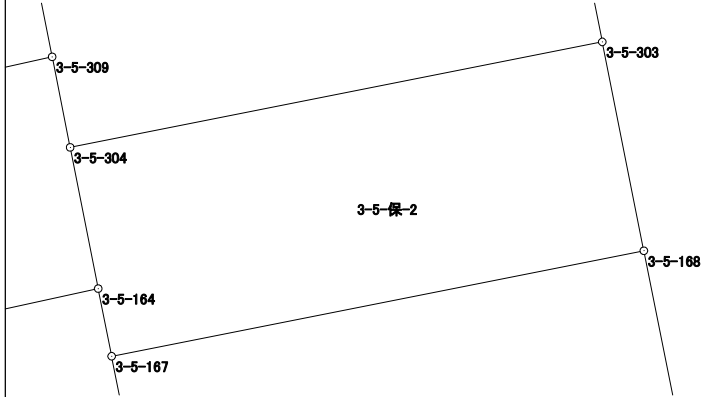
点 名	X 座標	Y 座標	辺 長	方 向 角	測 角	DX	倍 積 (Y×DX)	
3-5-167	41772.496	-68472.431	7.139	78-47-21	90-02-14	0.498	-34099.270638	
3-5-168	41773.884	-68465.428	2.802	348-44-32	89-57-11	4.136	-283173.010208	
3-5-303	41776.632	-68465.975	7.138	258-47-16	90-02-44	1.360	-93113.726000	
3-5-304	41775.244	-68472.977	1.894	168-46-02	89-58-46	-3.246	222263.283342	
3-5-164	41773.386	-68472.608	0.907	168-45-07	179-59-05	-2.748	188162.726784	
							倍面積	
							面 積	20.0016400

面積計算書（座標法）

世界測地系（測地成果2011）

所 在	地 番	公簿地目	現況地目	地 積	所 有 者
前橋市六供町一丁目	3-5-保-5			8.00 m ²	

点 名	X 座標	Y 座標	辺 長	方 向 角	測 角	DX	倍 積 (Y×DX)
3-5-157	41760.604	-68479.180	11.074	348-47-04	90-11-15	11.006	-753681.855080
3-5-158	41771.467	-68481.334	0.723	257-37-02	88-49-58	10.708	-733298.124472
3-5-323	41771.312	-68482.040	11.062	168-47-15	91-10-13	-11.006	753713.332240
3-5-324	41760.461	-68479.889	0.723	78-35-49	89-48-34	-10.708	733282.651412
倍面積						16.004100	
面 積						8.0020500	

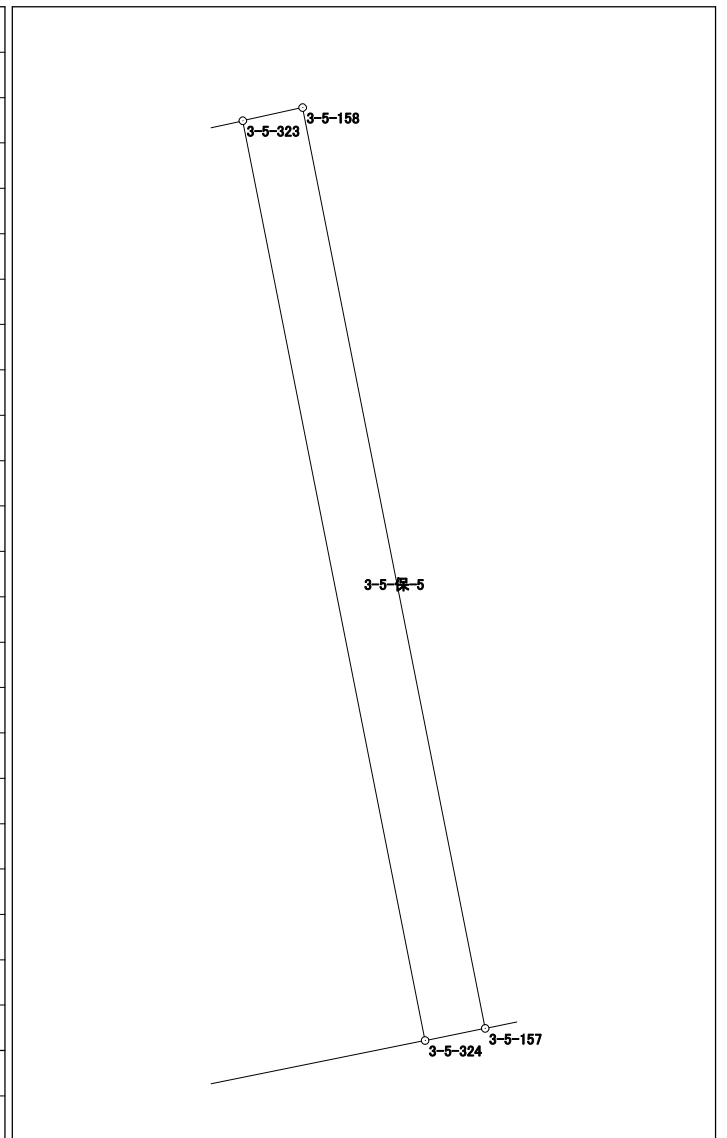

面積計算書 (座標法)

世界測地系 (測地成果2011)

所 在	地 番	公簿地目	現況地目	地 積	所 有 者
前橋市六供町一丁目	3-5-保-9			3.00 m ²	

点 名	X 座標	Y 座標	辺 長	方 向 角	測 角	DX	倍 積 (Y×DX)
3-5-127	41790.038	-68488.007	0.404	258-43-04	89-53-02	7.201	-493182.138407
3-5-313	41789.959	-68488.403	7.424	168-50-24	90-07-20	-7.363	504280.111289
3-5-314	41782.675	-68486.966	0.405	78-09-45	89-19-21	-7.201	493174.642166
3-5-146	41782.758	-68486.570	7.420	348-50-02	90-40-17	7.363	-504266.614910
倍面積							6.000138
面 積							3.0000690

