



48-3 (1/2) 街区 画地出来形確認図 (9556.24m<sup>2</sup>)  
 48-4 街区 (7033.26m<sup>2</sup>)

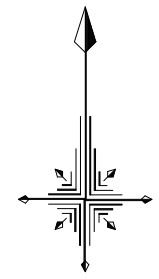

S=1/1000

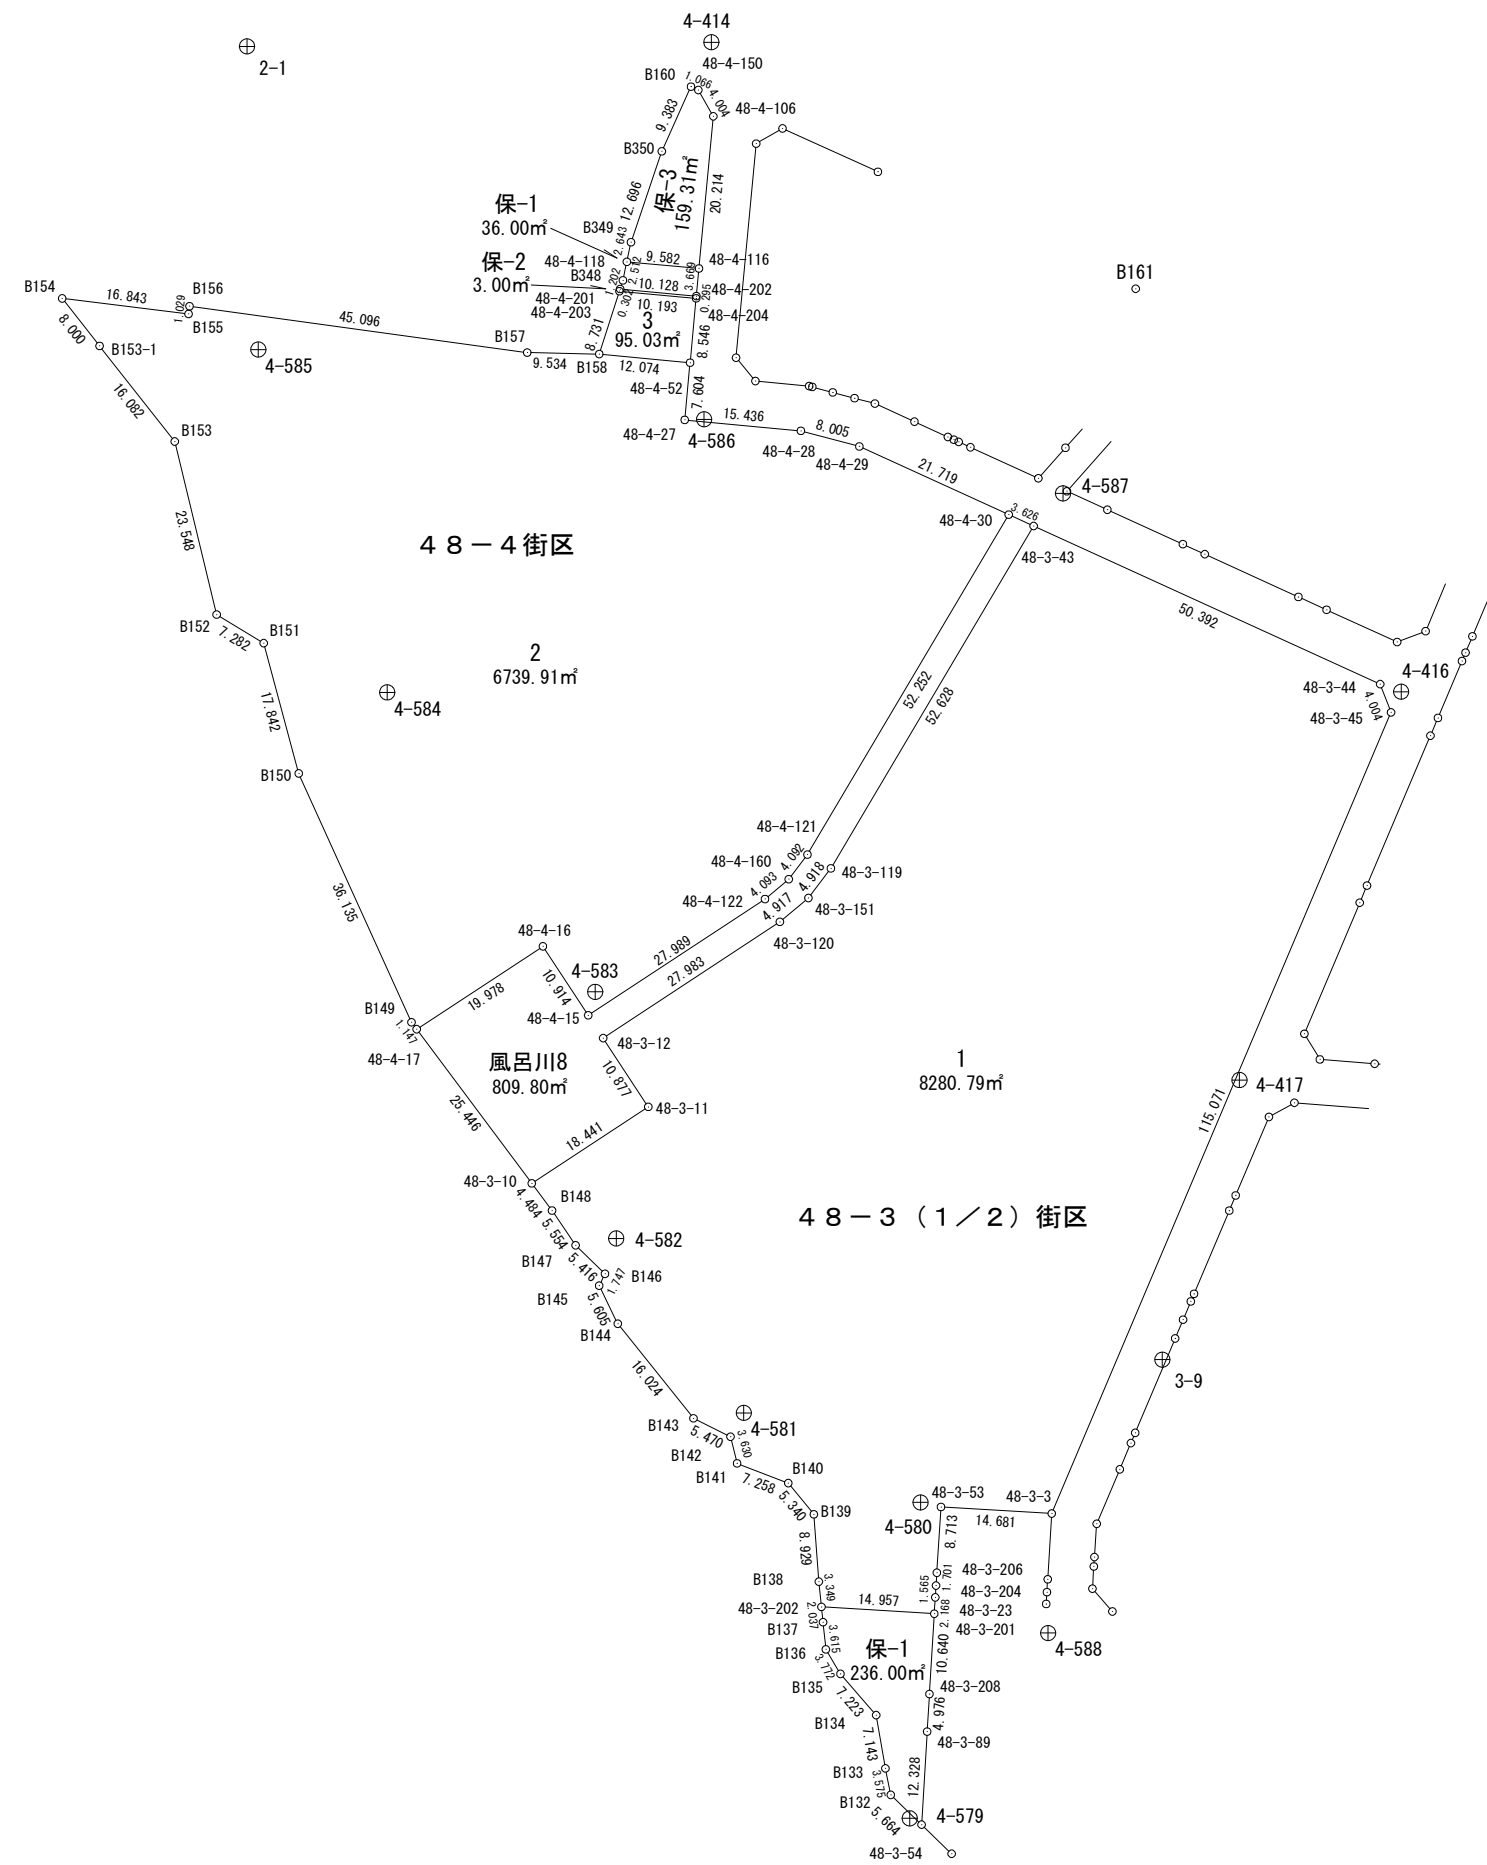

# 面積計算書（座標法）

世界測地系（測地成果2011）

所在	地番	公簿地目	現況地目	地積	所有者
前橋市南町二丁目	48-4-2			6739.91 m <sup>2</sup>	

点名	X座標	Y座標	辺長	方向角	測角	DX	倍積 (Y×DX)
48-4-52	41521.406	-68716.576	12.074	275-24-30	90-00-46	8.708	-598383.943808
B158	41522.544	-68728.596	9.534	271-09-57	175-45-27	1.332	-91546.489872
B157	41522.738	-68738.128	45.096	277-48-54	186-38-57	6.326	-434837.397728
B156	41528.870	-68782.805	1.029	187-05-26	89-16-32	5.111	-351548.916355
B155	41527.849	-68782.932	16.843	276-59-51	269-54-25	1.031	-70915.202892
B154	41529.901	-68799.650	8.000	141-47-32	44-47-41	-4.234	291297.718100
B153-1	41523.615	-68794.702	16.082	141-47-33	180-00-01	-18.923	1301802.145946
B153	41510.978	-68784.755	23.548	166-23-26	204-35-53	-35.524	2443509.636620
B152	41488.091	-68779.214	7.282	121-16-17	134-52-51	-26.667	1834135.299738
B151	41484.311	-68772.990	17.842	164-56-22	223-40-05	-21.009	1444851.746910
B150	41467.082	-68768.354	36.135	155-37-00	170-40-38	-50.141	3448114.037914
B149	41434.170	-68753.436	1.147	143-15-36	167-38-36	-33.831	2325997.493316
48-4-17	41433.251	-68752.750	19.978	56-43-33	93-27-57	10.042	-690415.115500
48-4-16	41444.212	-68736.047	10.914	146-42-27	269-58-54	1.838	-126336.854386
48-4-15	41435.089	-68730.056	27.989	56-40-30	89-58-03	6.254	-429837.770224
48-4-122	41450.466	-68706.669	4.093	50-07-28	173-26-58	18.001	-1236788.748669
48-4-160	41453.090	-68703.528	4.092	37-12-52	167-05-24	5.883	-404182.855224
48-4-121	41456.349	-68701.053	52.252	30-37-58	173-25-06	48.219	-3312696.074607
48-4-30	41501.309	-68674.429	21.719	294-31-25	83-53-27	53.975	-3706702.305275
48-4-29	41510.324	-68694.189	8.005	284-56-58	170-25-33	11.080	-761131.614120
48-4-28	41512.389	-68701.923	15.436	275-22-44	170-25-46	3.512	-241281.153576
48-4-27	41513.836	-68717.291	7.604	5-23-44	270-01-00	9.017	-619623.812947
						倍面積	13479.823361
						面積	6739.9116805

