



56街区 画地出来形確認図 (2340.79m²)

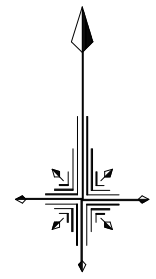

S=1/500

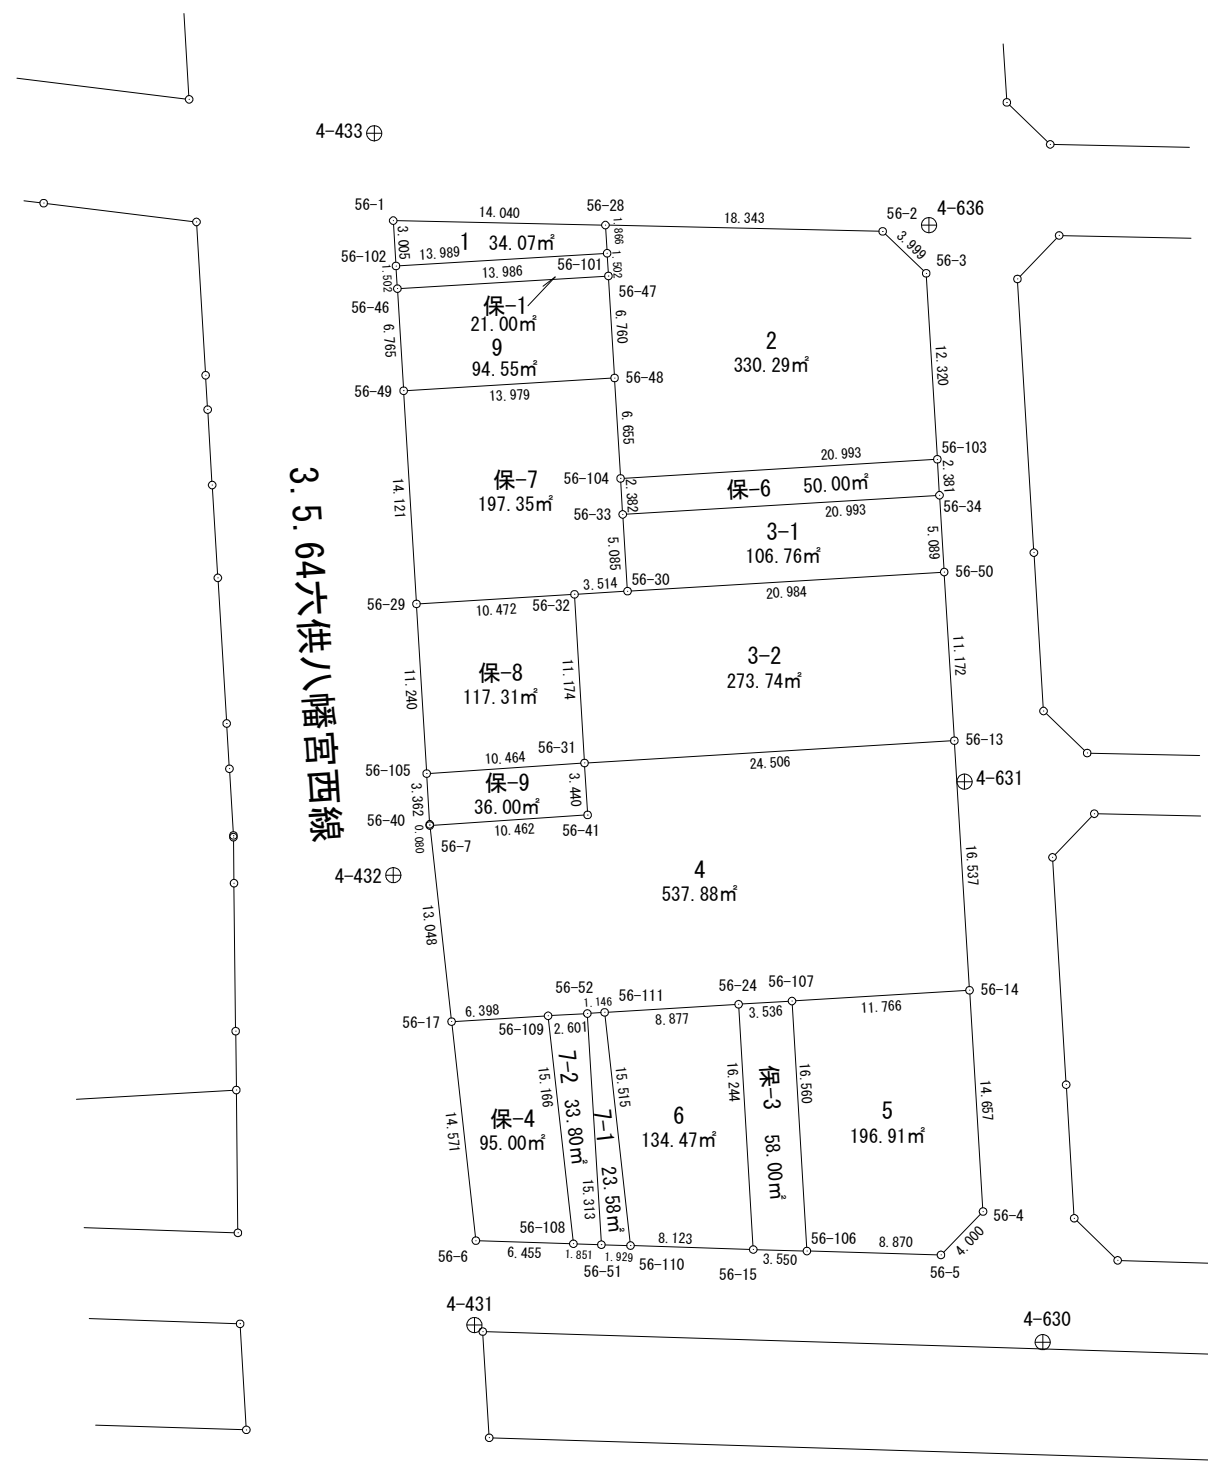


面積計算書（座標法）

世界測地系（測地成果2011）

所 在	地 番	公簿地目	現況地目	地 積	所 有 者
前橋市六供町二丁目	56-2			330.29 m ²	

点 名	X 座標	Y 座標	辺 長	方 向 角	測 角	DX	倍 積 (Y×DX)
56-103	41322.372	-68130.430	12.320	356-34-30	90-02-06	13.565	-924189.282950
56-3	41334.670	-68131.166	3.999	313-54-21	137-19-51	15.071	-1026804.802786
56-2	41337.443	-68134.047	18.343	271-17-47	137-23-26	3.188	-217211.341836
56-28	41337.858	-68152.385	1.866	176-37-15	85-19-28	-1.448	98684.653480
56-101	41335.995	-68152.275	1.502	176-38-25	180-01-10	-3.362	229127.948550
56-47	41334.496	-68152.187	6.760	176-32-54	179-54-29	-8.247	562051.086189
56-48	41327.748	-68151.780	6.655	176-35-50	180-02-56	-13.391	912620.485980
56-104	41321.105	-68151.385	20.993	86-32-24	89-56-34	-5.376	366381.845760

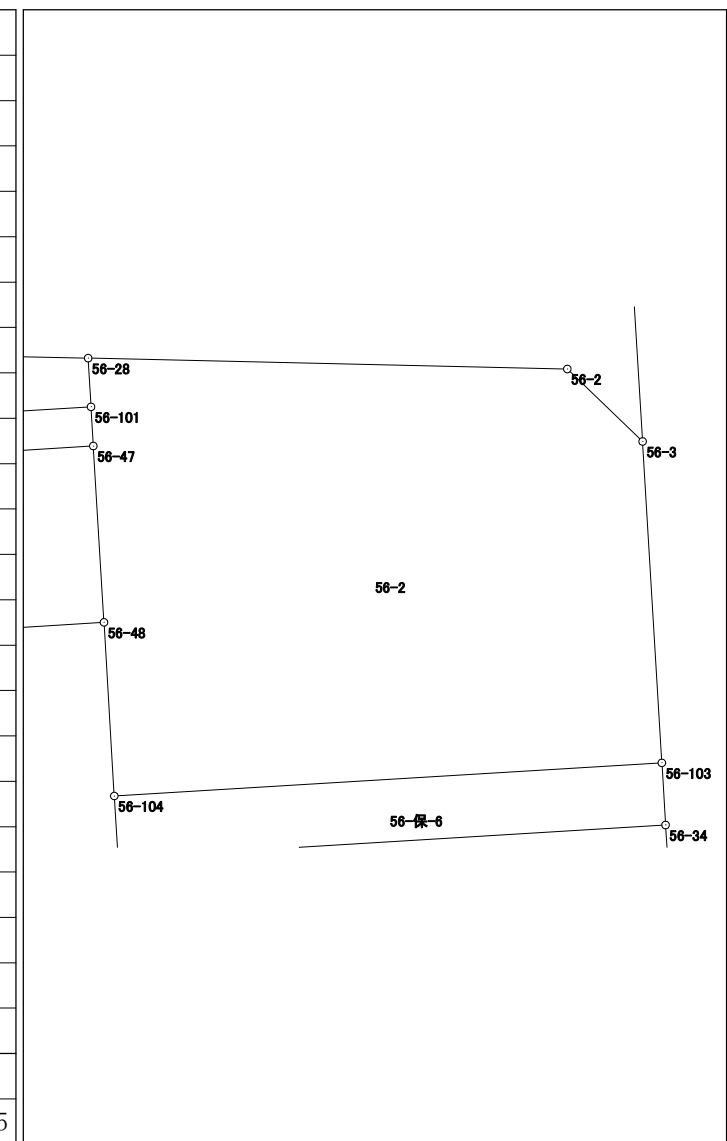

倍面積	660.592387
面 積	330.2961935

面積計算書（座標法）

世界測地系（測地成果2011）

所在	地番	公簿地目	現況地目	地積	所有者
前橋市六供町二丁目	56-3-2			273.74 m ²	

点名	X座標	Y座標	辺長	方向角	測角	DX	倍積 (Y×DX)
56-30	41313.652	-68150.922	3.514	266-34-27	180-01-39	-1.474	100454.459028
56-32	41313.442	-68154.430	11.174	176-36-12	90-01-45	-11.364	774506.942520
56-31	41302.288	-68153.768	24.506	86-32-49	89-56-37	-9.678	659592.166704
56-13	41303.764	-68129.306	11.172	356-33-43	90-00-54	12.628	-860336.876168
56-50	41314.916	-68129.976	20.984	266-32-48	89-59-05	9.888	-673669.202688
						倍面積	547.489396
						面積	273.7446980




面積計算書 (座標法)

世界測地系 (測地成果2011)

所在	地番	公簿地目	現況地目	地積	所有者
前橋市六供町二丁目	56-7-1			23.58 m ²	

点名	X座標	Y座標	辺長	方向角	測角	DX	倍積 (Y×DX)
56-52	41285.720	-68153.580	15.313	176-31-59	90-23-13	-15.362	1046975.295960
56-51	41270.435	-68152.654	1.929	91-43-23	95-11-24	-15.343	1045666.170322
56-110	41270.377	-68150.726	15.515	353-40-06	81-56-43	15.362	-1046931.452812
56-111	41285.797	-68152.437	1.146	266-08-46	92-28-40	15.343	-1045662.840891
						倍面積	47.172579
						面積	23.5862895

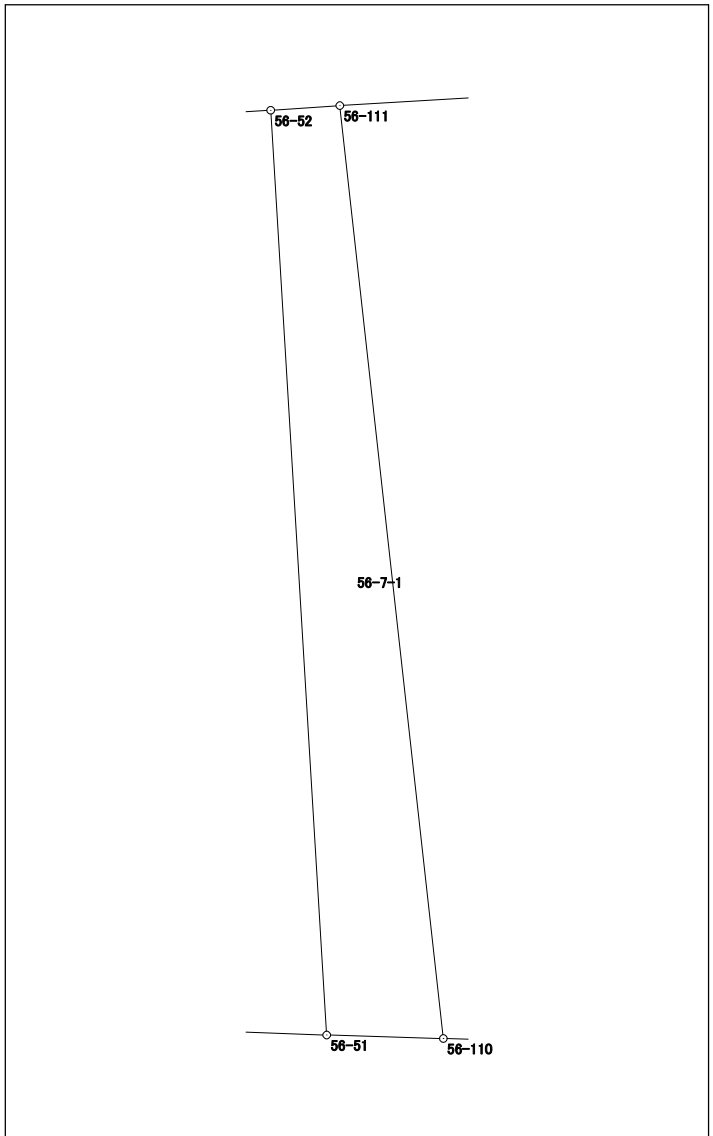


面積計算書 (座標法)

世界測地系 (測地成果2011)

所在	地番	公簿地目	現況地目	地積	所有者
前橋市六供町二丁目	56-保-3			58.00 m ²	

点名	X座標	Y座標	辺長	方向角	測角	DX	倍積 (Y×DX)
56-24	41286.332	-68143.576	16.244	176-34-48	90-02-57	-16.429	1119530.810104
56-15	41270.117	-68142.607	3.550	91-38-47	95-03-59	-16.317	1111882.918419
56-106	41270.015	-68139.058	16.560	356-34-47	84-56-00	16.429	-1119456.583882
56-107	41286.546	-68140.046	3.536	266-31-51	89-57-04	16.317	-1111841.130582

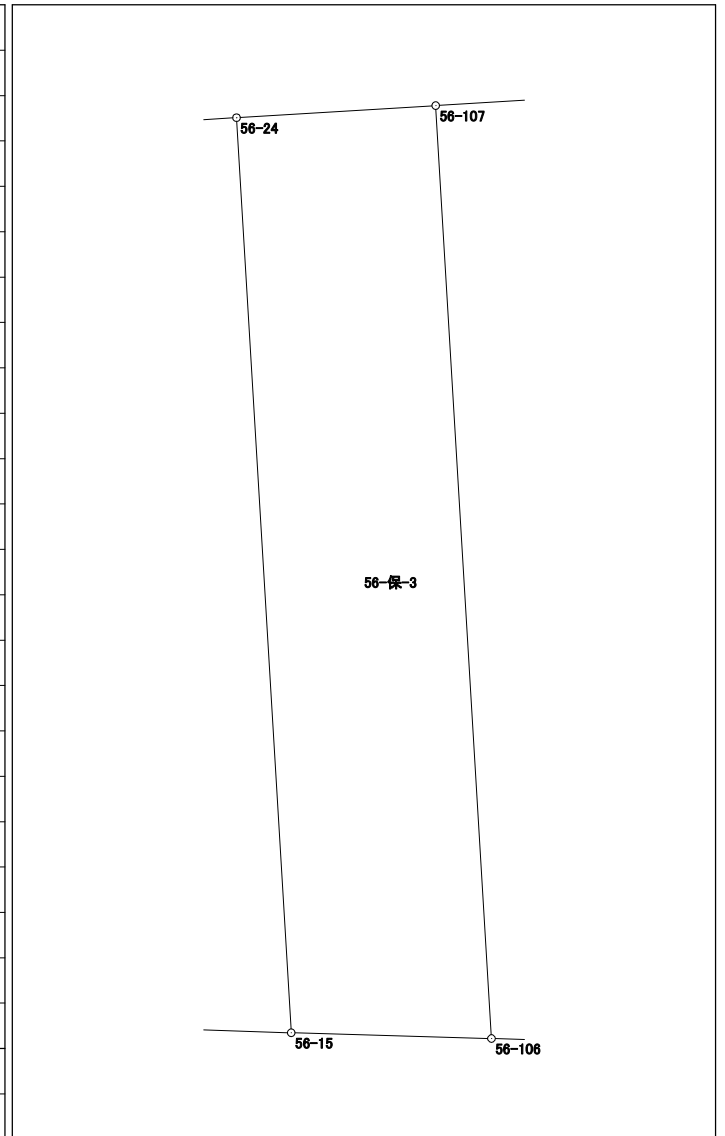

倍面積	116.014059
面積	58.0070295

面積計算書（座標法）

世界測地系（測地成果2011）

所 在	地 番	公簿地目	現況地目	地 積	所 有 者
前橋市六供町二丁目	56-保-4			95.00 m ²	

点 名	X 座標	Y 座標	辺 長	方 向 角	測 角	DX	倍 積 (Y×DX)
56-6	41270.704	-68160.956	6.455	91-49-43	98-09-38	-14.688	1001148.121728
56-108	41270.498	-68154.504	15.166	353-39-59	81-50-16	14.867	-1013253.010968
56-109	41285.571	-68156.177	6.398	266-33-00	92-53-01	14.688	-1001077.927776
56-17	41285.186	-68162.563	14.571	173-40-05	87-07-05	-14.867	1013372.824121
						倍面積	190.007105
						面 積	95.0035525

