



# 58街区 画地出来形確認図 (2806.28m<sup>2</sup>)

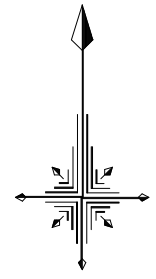

S=1/500

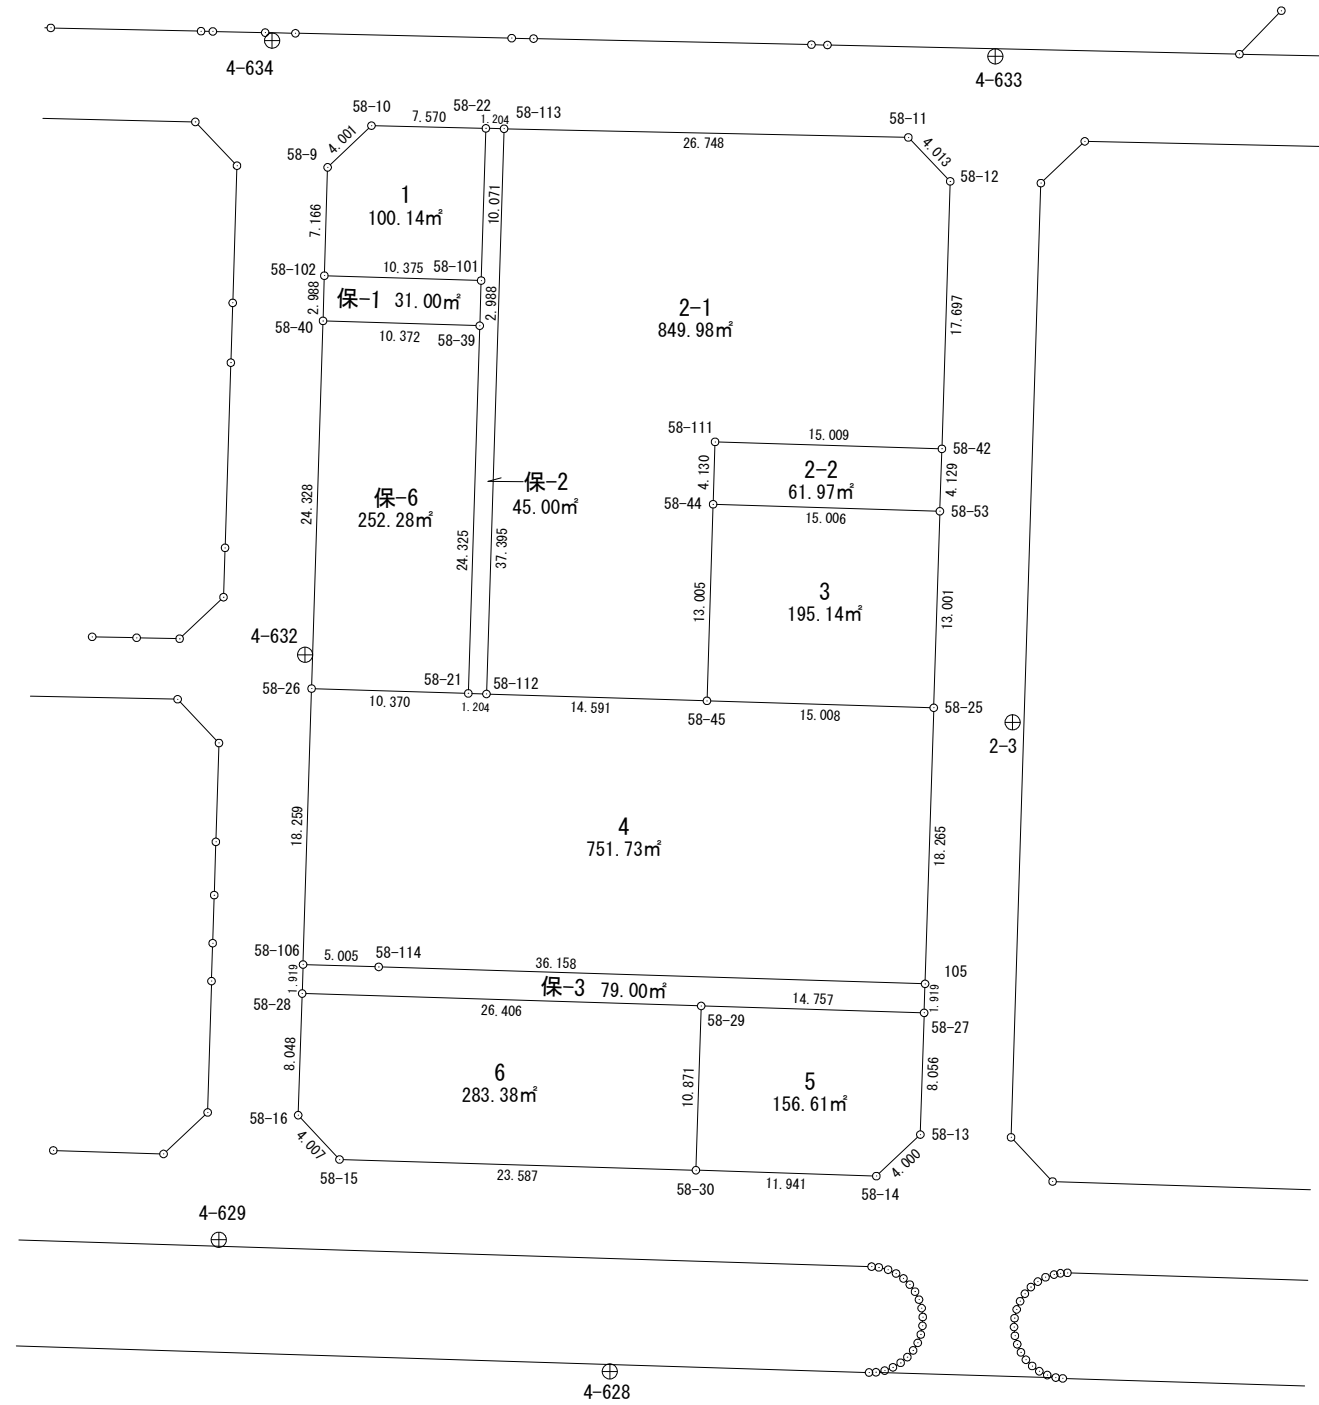


# 面積計算書（座標法）

世界測地系（測地成果2011）

所 在	地 番	公簿地目	現況地目	地 積	所 有 者
前橋市六供町二丁目	58-1			100.14 m <sup>2</sup>	

点 名	X 座標	Y 座標	辺 長	方 向 角	測 角	DX	倍 積 (Y×DX)
58-101	41325.194	-68034.704	10.071	1-46-52	89-59-30	9.742	-662794.086368
58-22	41335.260	-68034.391	7.570	271-20-50	89-33-58	10.244	-696944.301404
58-10	41335.438	-68041.959	4.001	226-26-53	135-06-03	-2.579	175480.212261
58-9	41332.681	-68044.859	7.166	181-43-09	135-16-16	-9.920	675005.001280
58-102	41325.518	-68045.074	10.375	91-47-22	90-04-13	-7.487	509453.469038
						倍面積	200.294807
						面 積	100.1474035

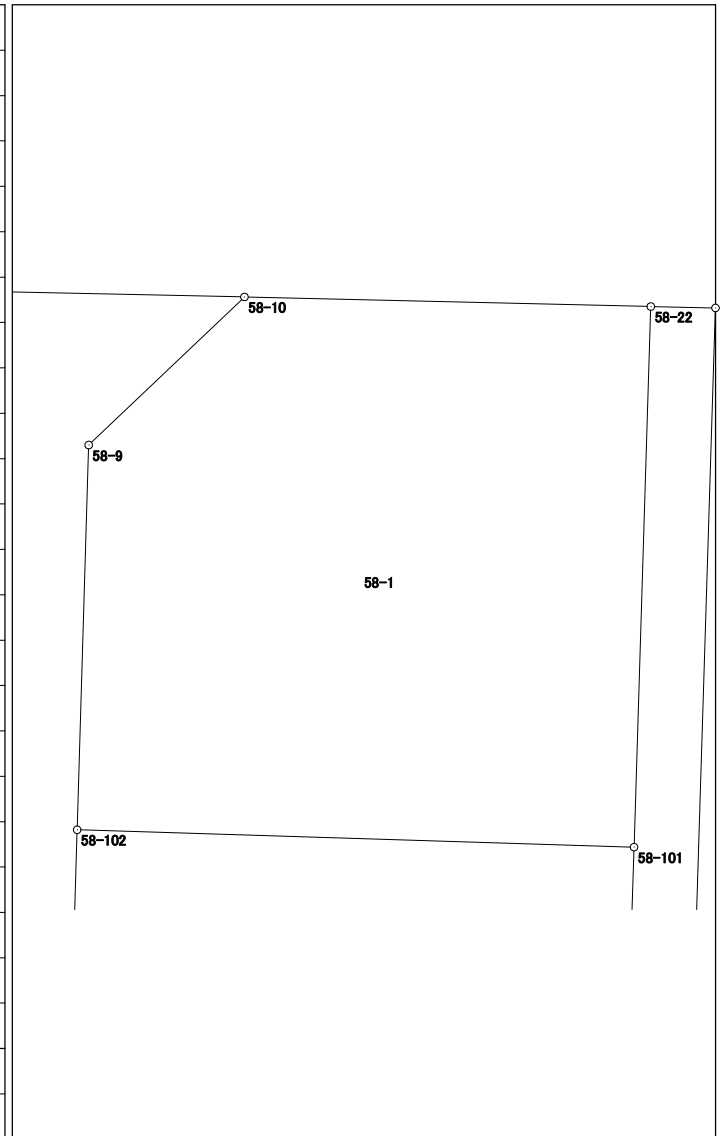




# 面積計算書（座標法）

世界測地系（測地成果2011）

所 在	地 番	公簿地目	現況地目	地 積	所 有 者
前橋市六供町二丁目	58-2-2			61.97 m <sup>2</sup>	

点 名	X 座標	Y 座標	辺 長	方 向 角	測 角	DX	倍 積 (Y×DX)
58-111	41314.530	-68019.229	4.130	181-48-14	90-02-10	-3.665	249290.474285
58-44	41310.402	-68019.359	15.006	91-45-51	89-57-37	-4.590	312208.857810
58-53	41309.940	-68004.360	4.129	1-50-45	90-04-54	3.665	-249235.979400
58-42	41314.067	-68004.227	15.009	271-46-04	89-55-19	4.590	-312139.401930
						倍面積	123.950765
						面 積	61.9753825

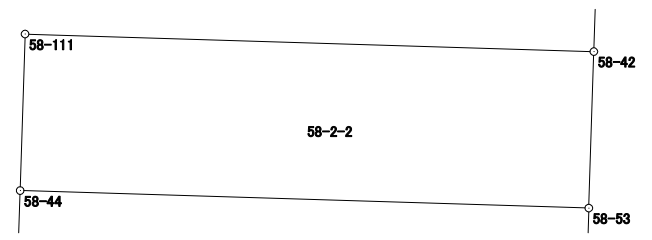








# 面積計算書 (座標法)

世界測地系 (測地成果2011)

所在	地番	公簿地目	現況地目	地積	所有者
前橋市六供町二丁目	58-6			283.38 m <sup>2</sup>	

点名	X座標	Y座標	辺長	方向角	測角	D <sub>X</sub>	倍積 (Y×D <sub>X</sub> )
58-30	41266.362	-68020.496	10.871	1-49-45	90-06-06	10.154	-690680.116384
58-29	41277.227	-68020.149	26.406	271-46-46	89-57-01	11.685	-794815.441065
58-28	41278.047	-68046.542	8.048	181-52-47	90-06-01	-7.224	491568.219408
58-16	41270.003	-68046.806	4.007	136-58-55	135-06-08	-10.974	746745.649044
58-15	41267.073	-68044.072	23.587	91-43-39	134-44-44	-3.641	247748.466152

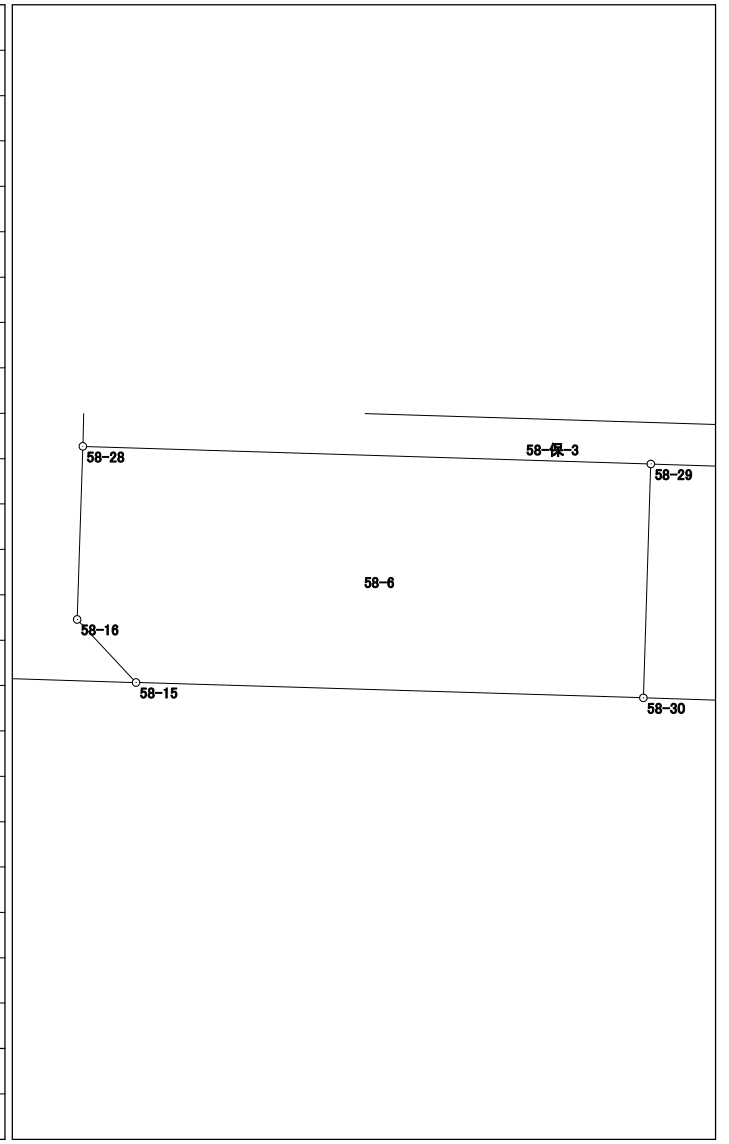

倍面積	566.777155
面積	283.3885775









