



63-2街区 画地出来形確認図 (2506.12m²)

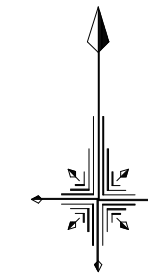


S=1/500

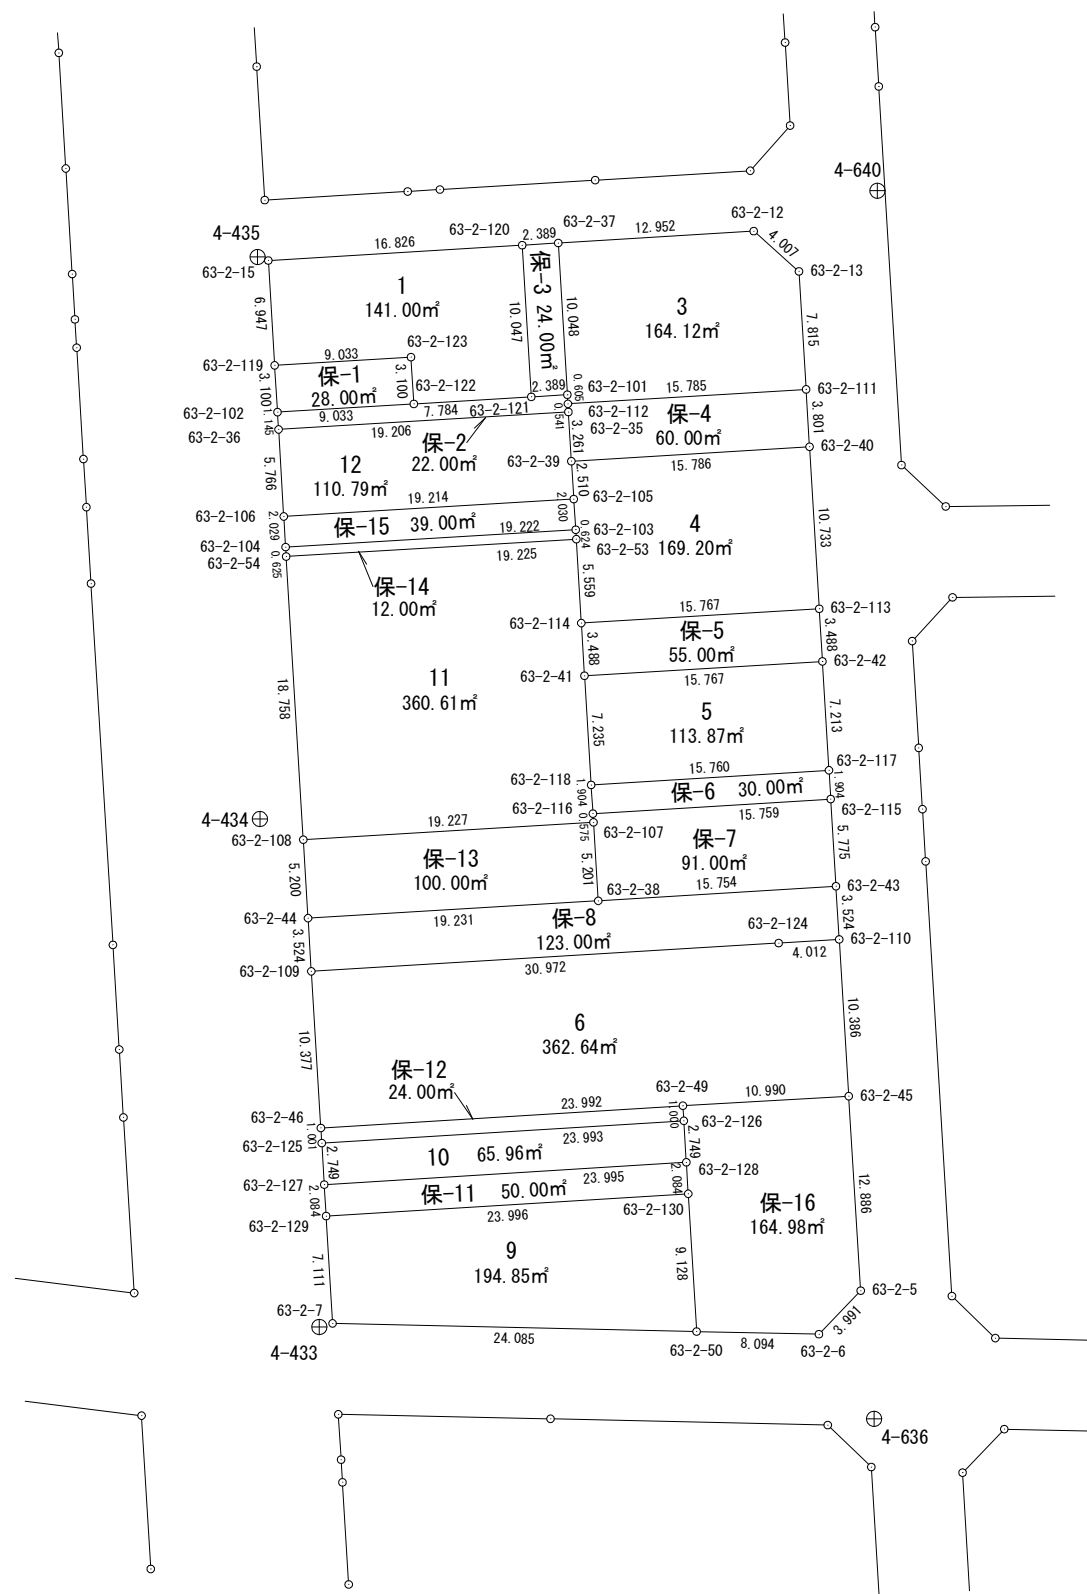

面積計算書（座標法）

世界測地系（測地成果2011）

所 在	地 番	公簿地目	現況地目	地 積	所 有 者
前橋市六供町二丁目	63-2-9			194.85 m ²	

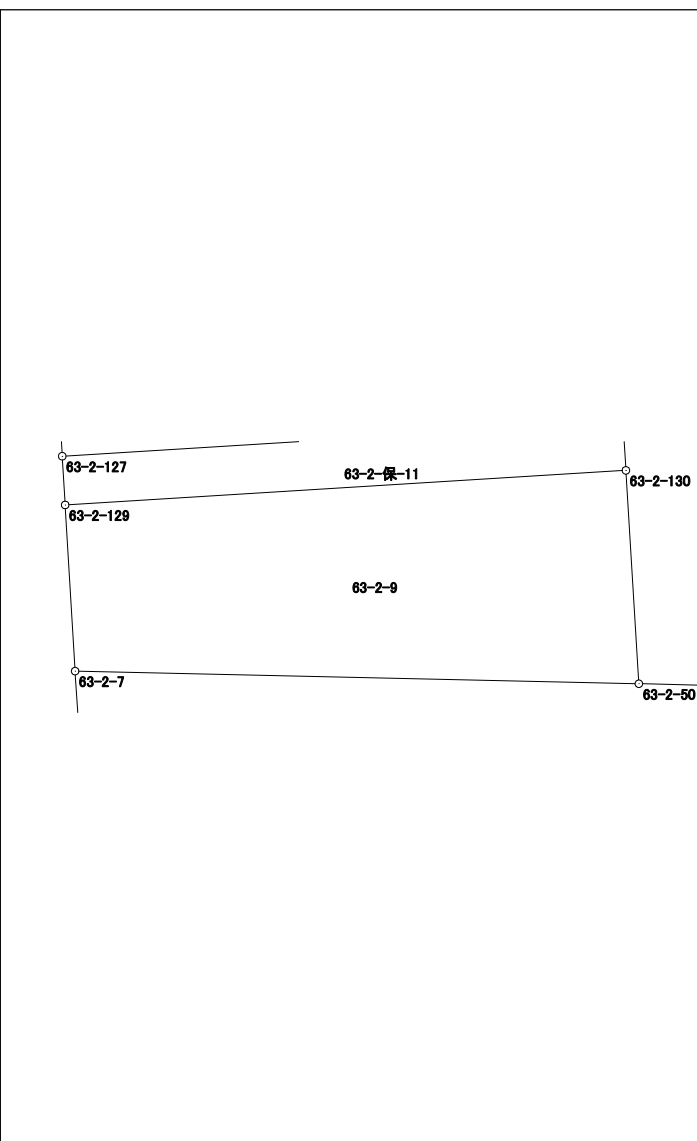
点 名	X 座標	Y 座標	辺 長	方 向 角	測 角	DX	倍 積 (Y×DX)				
63-2-129	41351.265	-68167.227	7.111	176-34-24	90-05-51	-8.573	584397.637071				
63-2-7	41344.167	-68166.802	24.085	91-16-48	94-42-24	-7.636	520521.700072				
63-2-50	41343.629	-68142.723	9.128	356-31-36	85-14-48	8.573	-584187.564279				
63-2-130	41352.740	-68143.276	23.996	266-28-33	89-56-57	7.636	-520342.055536				
倍面積							389.717328				
面 積							194.8586640				

面積計算書（座標法）

世界測地系（測地成果2011）

所在	地番	公簿地目	現況地目	地積	所有者
前橋市六供町二丁目	63-2-10			65.96 m ²	

点名	X座標	Y座標	辺長	方向角	測角	DX	倍積 (Y×DX)
63-2-126	41357.564	-68143.569	23.993	266-28-32	89-57-30	1.269	-86474.189061
63-2-125	41356.089	-68167.517	2.749	176-33-32	90-05-00	-4.219	287598.754223
63-2-127	41353.345	-68167.352	23.995	86-28-33	89-55-01	-1.269	86504.369688
63-2-128	41354.820	-68143.402	2.749	356-31-02	90-02-29	4.219	-287497.013038
						倍面積	131.921812
						面積	65.9609060

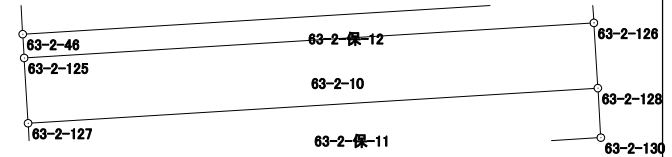


面積計算書 (座標法)

世界測地系 (測地成果2011)

所 在	地 番	公簿地目	現況地目	地 積	所 有 者
前橋市六供町二丁目	63-2-12			110.79 m ²	

点 名	X 座標	Y 座標	辺 長	方 向 角	測 角	DX	倍 積 (Y×DX)
63-2-105	41398.676	-68150.850	2.510	356-22-05	89-47-47	3.654	-249023.205900
63-2-39	41401.181	-68151.009	3.261	356-35-21	180-13-16	5.760	-392549.811840
63-2-35	41404.436	-68151.203	19.206	266-33-30	89-58-09	2.102	-143253.828706
63-2-36	41403.283	-68170.374	5.766	176-34-47	90-01-17	-6.909	470989.113966
63-2-106	41397.527	-68170.030	19.214	86-34-18	89-59-31	-4.607	314059.328210
						倍面積	221.595730
						面 積	110.7978650

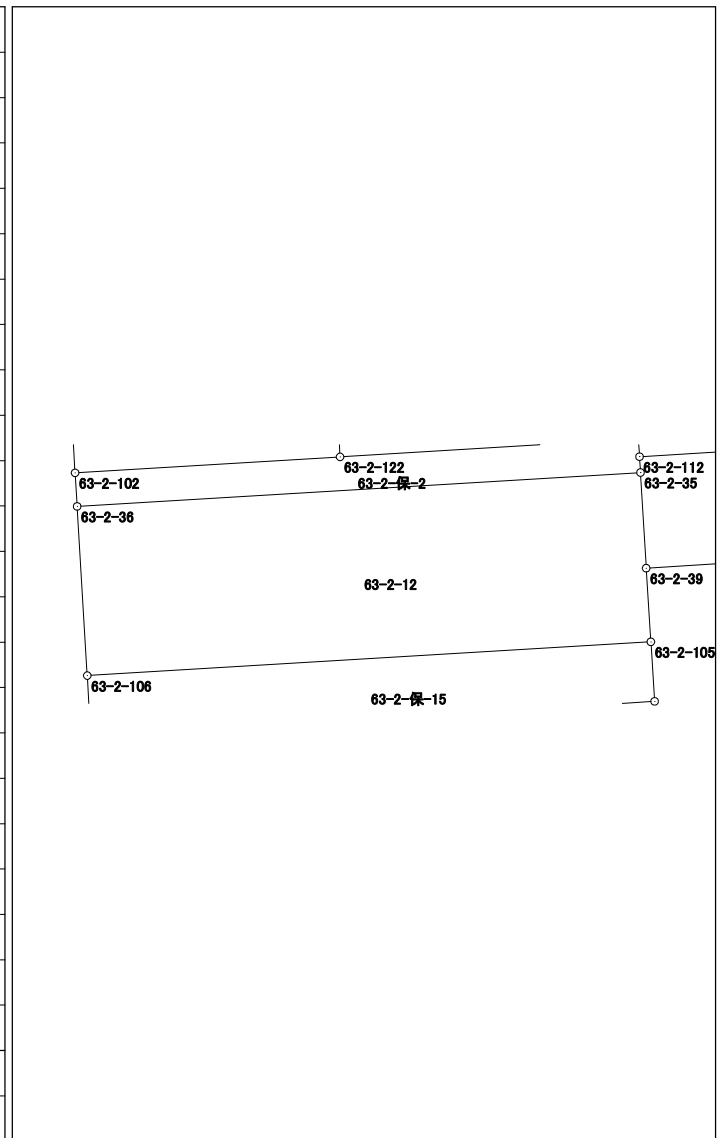


面積計算書（座標法）

世界測地系（測地成果2011）

所在	地番	公簿地目	現況地目	地積	所有者
前橋市六供町二丁目	63-2-保-3			24.00 m ²	

点名	X座標	Y座標	辺長	方向角	測角	DX	倍積 (Y×DX)
63-2-101	41405.580	-68151.272	10.048	356-34-15	90-00-07	10.173	-693302.890056
63-2-37	41415.610	-68151.873	2.389	266-32-41	89-58-26	9.886	-673749.416478
63-2-120	41415.466	-68154.258	10.047	176-34-14	90-01-33	-10.173	693333.266634
63-2-121	41405.437	-68153.657	2.389	86-34-08	89-59-54	-9.886	673767.053102
倍面積						48.013202	
面積						24.0066010	

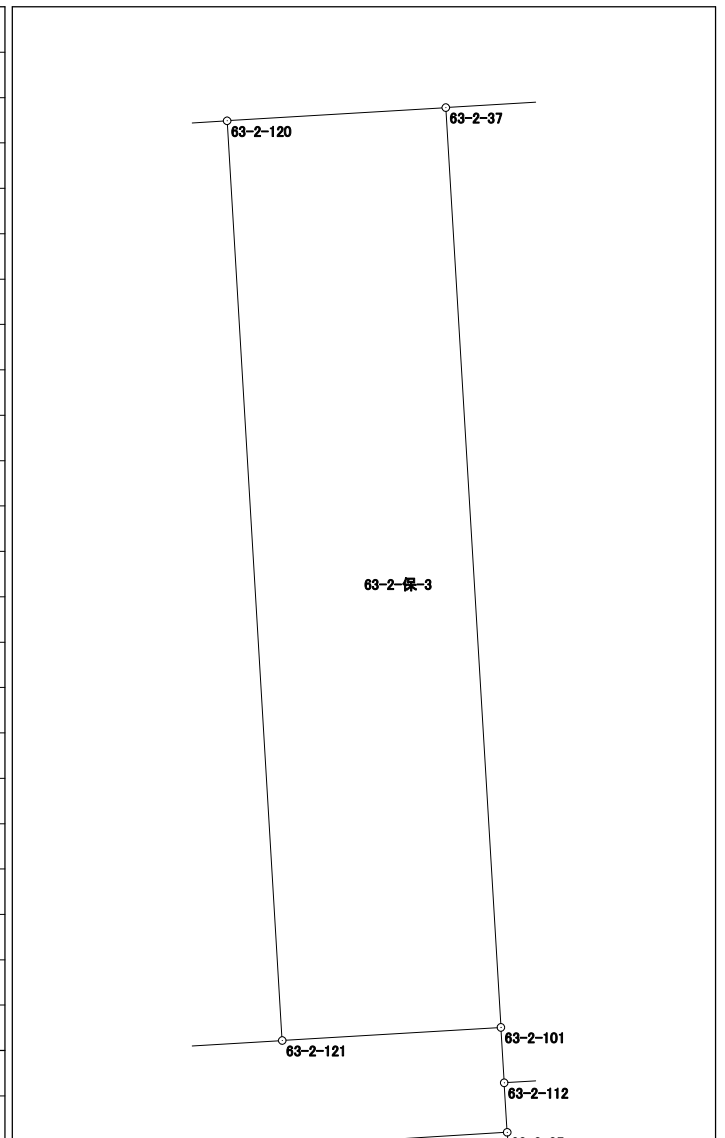

面積計算書 (座標法)

世界測地系 (測地成果2011)

所 在	地 番	公簿地目	現況地目	地 積	所 有 者
前橋市六供町二丁目	63-2-保-4			60.00 m ²	

点 名	X 座標	Y 座標	辺 長	方 向 角	測 角	DX	倍 積 (Y×DX)					
63-2-40	41402.138	-68135.252	3.801	356-33-39	90-02-11	4.751	-323710.582252					
63-2-111	41405.932	-68135.480	15.785	266-31-40	89-58-01	2.838	-193368.492240					
63-2-112	41404.976	-68151.236	0.541	176-30-11	89-58-31	-1.496	101954.249056					
63-2-35	41404.436	-68151.203	3.261	176-35-21	180-05-10	-3.795	258633.815385					
63-2-39	41401.181	-68151.009	15.786	86-31-28	89-56-07	-2.298	156611.018682					
							倍面積			120.008631		
							面 積			60.0043155		

面積計算書（座標法）

世界測地系（測地成果2011）

所在	地番	公簿地目	現況地目	地積	所有者
前橋市六供町二丁目	63-2-保-7			91.00 m ²	

点名	X座標	Y座標	辺長	方向角	測角	DX	倍積 (Y×DX)	
63-2-38	41372.110	-68149.228	15.754	86-29-04	89-59-24	-4.225	287930.488300	
63-2-43	41373.076	-68133.504	5.775	356-32-44	90-03-40	6.731	-458606.615424	
63-2-115	41378.841	-68133.852	15.759	266-29-08	89-56-24	4.799	-326974.355748	
63-2-116	41377.875	-68149.581	0.575	176-30-38	90-01-30	-1.540	104950.354740	
63-2-107	41377.301	-68149.546	5.201	176-29-40	179-59-02	-5.765	392882.132690	
倍面積							182.004558	
面積							91.0022790	

面積計算書 (座標法)

世界測地系 (測地成果2011)

所 在	地 番	公簿地目	現況地目	地 積	所 有 者
前橋市六供町二丁目	63-2-保-11			50.00 m ²	

点 名	X 座標	Y 座標	辺 長	方 向 角	測 角	DX	倍 積 (Y×DX)	
63-2-128	41354.820	-68143.402	23.995	266-28-33	89-56-33	0.605	-41226.758210	
63-2-127	41353.345	-68167.352	2.084	176-33-39	90-05-06	-3.555	242334.936360	
63-2-129	41351.265	-68167.227	23.996	86-28-33	89-54-54	-0.605	41241.172335	
63-2-130	41352.740	-68143.276	2.084	356-32-00	90-03-27	3.555	-242249.346180	
						倍面積	100.004305	
						面 積	50.0021525	

面積計算書 (座標法)

世界測地系 (測地成果2011)

所 在	地 番	公簿地目	現況地目	地 積	所 有 者
前橋市六供町二丁目	63-2-保-12			24.00 m ²	


点 名	X 座標	Y 座標	辺 長	方 向 角	測 角	DX	倍 積 (Y×DX)		
63-2-46	41357.088	-68167.577	1.001	176-33-47	90-05-07	-2.473	168578.417921		
63-2-125	41356.089	-68167.517	23.993	86-28-32	89-54-45	0.476	-32447.738092		
63-2-126	41357.564	-68143.569	1.000	356-30-08	90-01-36	2.473	-168519.046137		
63-2-49	41358.562	-68143.630	23.992	266-28-40	89-58-32	-0.476	32436.367880		
						倍面積	48.001572		
						面 積	24.0007860		

面積計算書 (座標法)

世界測地系 (測地成果2011)

所在	地番	公簿地目	現況地目	地積	所有者
前橋市六供町二丁目	63-2-保-13			100.00 m ²	

点名	X座標	Y座標	辺長	方向角	測角	Dx	倍積 (Y×Dx)
63-2-44	41370.963	-68168.425	19.231	86-34-51	90-02-33	-4.044	275673.110700
63-2-38	41372.110	-68149.228	5.201	356-29-40	89-54-49	6.338	-431929.807064
63-2-107	41377.301	-68149.546	19.227	266-34-48	90-05-08	4.044	-275596.764024
63-2-108	41376.154	-68168.739	5.200	176-32-18	89-57-30	-6.338	432053.467782

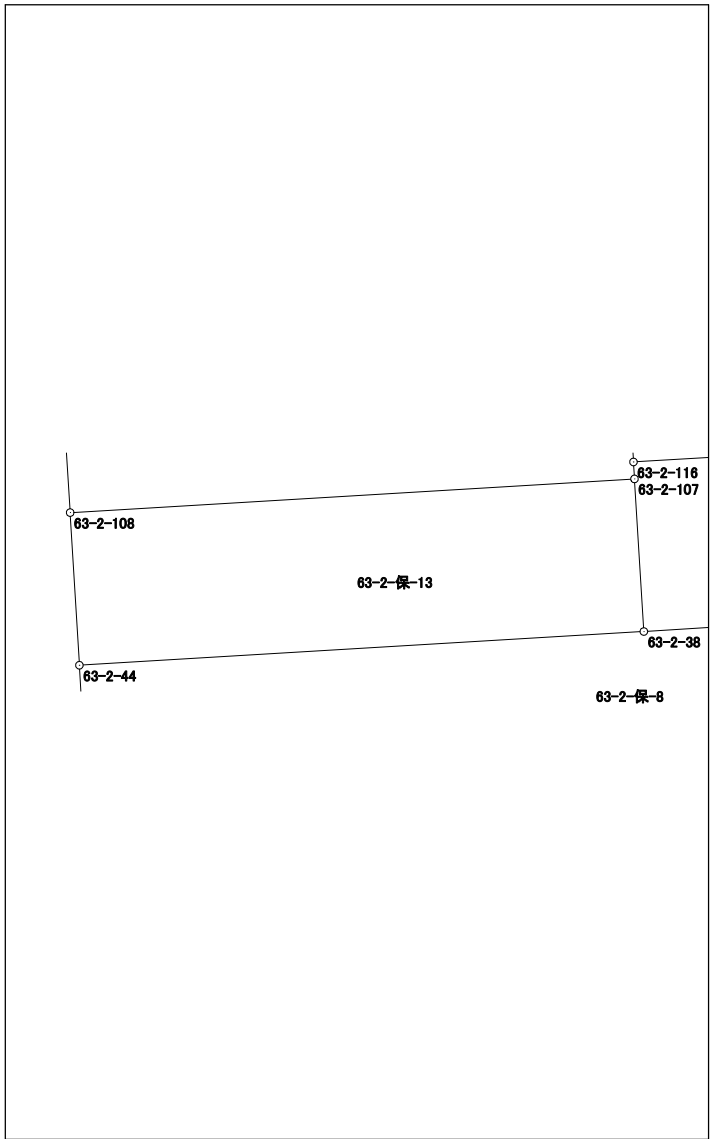

倍面積	200.007394
面積	100.0036970

面積計算書 (座標法)

世界測地系 (測地成果2011)

所在	地番	公簿地目	現況地目	地積	所有者
前橋市六供町二丁目	63-2-保-14			12.00 m ²	


点名	X座標	Y座標	辺長	方向角	測角	DX	倍積 (Y×DX)	
63-2-54	41394.878	-68169.872	19.225	86-34-25	89-58-01	0.525	-35789.182800	
63-2-53	41396.027	-68150.681	0.624	356-19-35	89-45-10	1.772	-120763.006732	
63-2-103	41396.650	-68150.721	19.222	266-34-34	90-14-59	-0.525	35779.128525	
63-2-104	41395.502	-68169.909	0.625	176-36-24	90-01-50	-1.772	120797.078748	
						倍面積	24.017741	
						面積	12.0088705	

面積計算書（座標法）

世界測地系（測地成果2011）

所 在	地 番	公簿地目	現況地目	地 積	所 有 者
前橋市六供町二丁目	63-2-保-15			39.00 m ²	

点 名	X 座標	Y 座標	辺 長	方 向 角	測 角	DX	倍 積 (Y×DX)
63-2-103	41396.650	-68150.721	2.030	356-21-24	89-46-50	3.174	-216310.388454
63-2-105	41398.676	-68150.850	19.214	266-34-18	90-12-54	0.877	-59768.295450
63-2-106	41397.527	-68170.030	2.029	176-34-50	90-00-32	-3.174	216371.675220
63-2-104	41395.502	-68169.909	19.222	86-34-34	89-59-44	-0.877	59785.010193
						倍面積	78.001509
						面 積	39.0007545

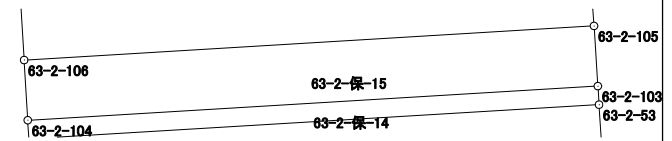

面積計算書 (座標法)

所在	地番	公簿地目	現況地目	地積	所有者
前橋市六供町二丁目	63-2-保-16			164.98 m ²	

点名	X座標	Y座標	辺長	方向角	測角	DX	倍積 (Y×DX)
63-2-49	41358.562	-68143.630	1.000	176-30-08	89-47-19	-1.628	110937.829640
63-2-126	41357.564	-68143.569	2.749	176-31-02	180-00-54	-3.742	254993.235198
63-2-128	41354.820	-68143.402	2.084	176-32-00	180-00-58	-4.824	328723.771248
63-2-130	41352.740	-68143.276	9.128	176-31-36	179-59-36	-11.191	762591.401716
63-2-50	41343.629	-68142.723	8.094	91-15-11	94-43-35	-9.288	632909.611224
63-2-6	41343.452	-68134.631	3.991	43-51-10	132-35-59	2.701	-184031.638331
63-2-5	41346.330	-68131.866	12.886	356-28-35	132-37-25	15.740	-1072395.570840
63-2-45	41359.192	-68132.658	10.990	266-42-49	90-14-14	12.232	-833398.672656

