



# 68-1街区 画地出来形確認図 (5947.94m<sup>2</sup>)

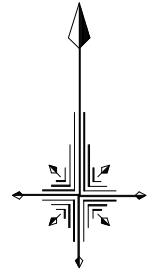

S=1/500

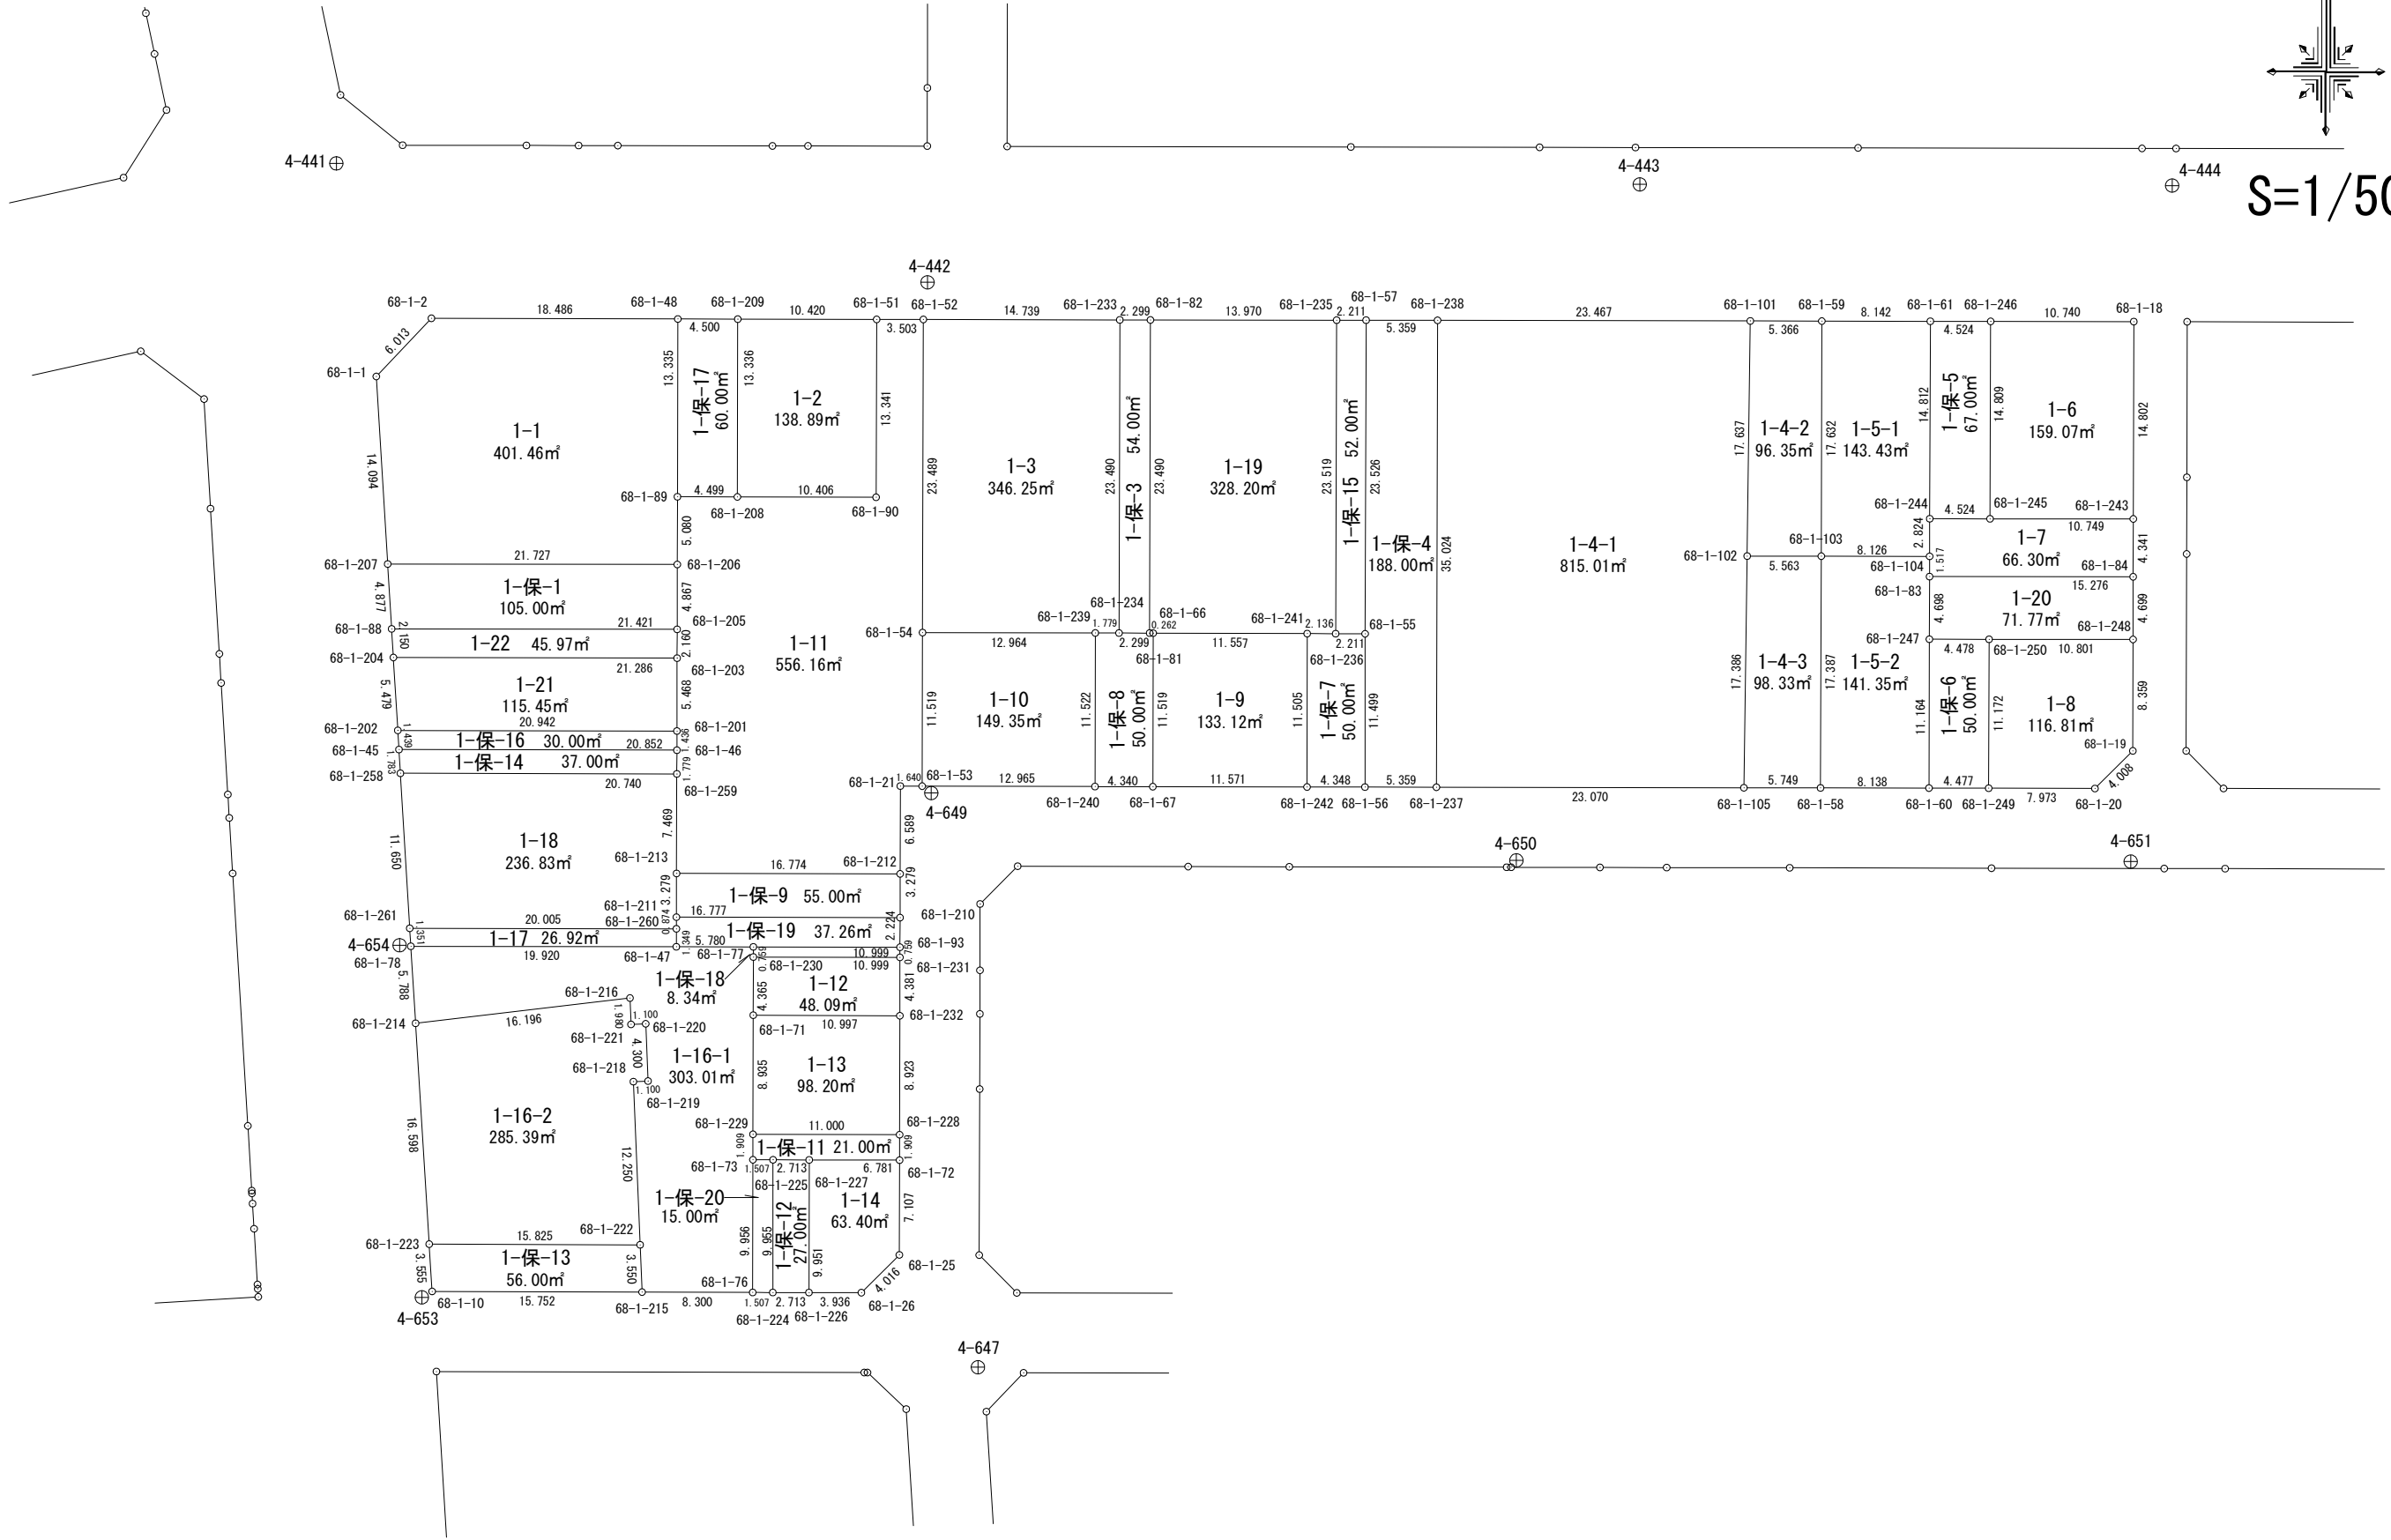


# 面積計算書 (座標法)

世界測地系 (測地成果2011)

所 在	地 番	公簿地目	現況地目	地 積	所 有 者
前橋市六供町二丁目	68-1-1			401.46 m <sup>2</sup>	

点 名	X 座標	Y 座標	辺 長	方 向 角	測 角	DX	倍 積 (Y×DX)
68-1-206	41613.662	-68161.395	5.080	0-07-27	90-02-04	5.046	-343942.399170
68-1-89	41618.742	-68161.384	13.335	0-07-13	179-59-46	18.415	-1255191.886360
68-1-48	41632.077	-68161.356	18.486	270-09-29	90-02-16	13.386	-912407.911416
68-1-2	41632.128	-68179.842	6.013	223-27-49	133-18-20	-4.313	294059.658546
68-1-1	41627.764	-68183.978	14.094	176-31-05	133-03-16	-18.432	1256767.082496
68-1-207	41613.696	-68183.122	21.727	90-05-23	93-34-18	-14.102	961518.386444

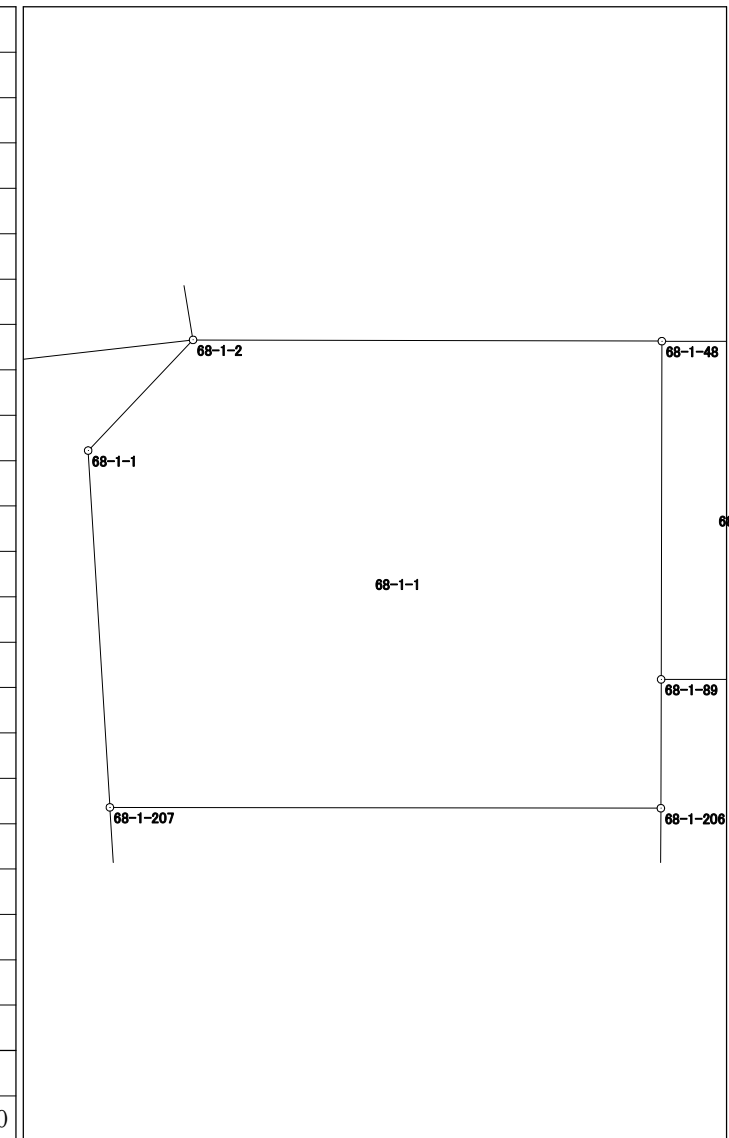


倍面積	802.930540
面 積	401.4652700

# 面積計算書 (座標法)

世界測地系 (測地成果2011)

所在	地番	公簿地目	現況地目	地積	所有者
前橋市六供町二丁目	68-1-2			138.89 m <sup>2</sup>	

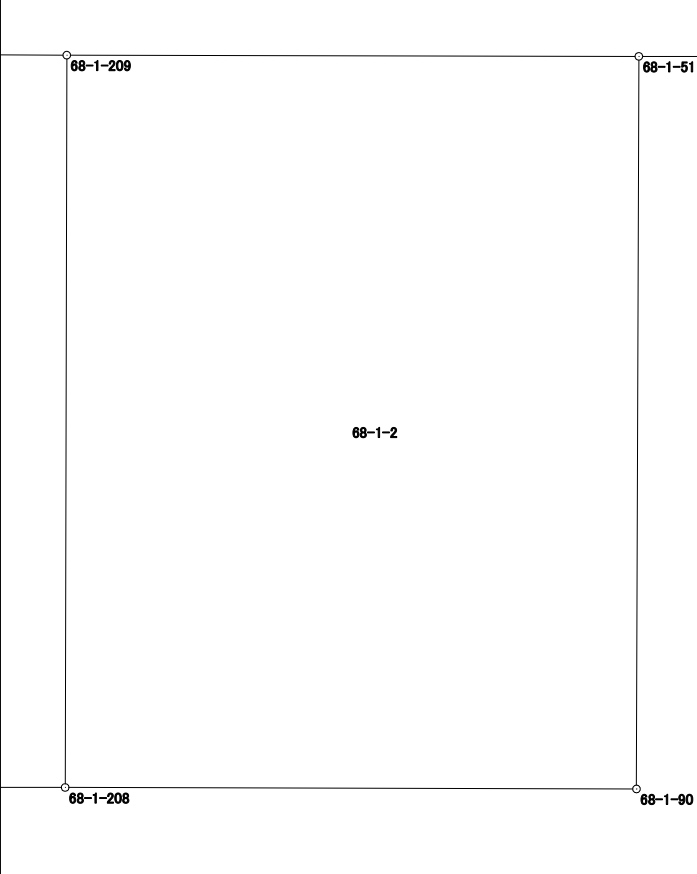
点名	X座標	Y座標	辺長	方向角	測角	DX	倍積 (Y×DX)	<div style="border: 1px solid black; padding: 10px; width: fit-content; margin: auto;">  </div>				
68-1-208	41618.731	-68156.885	10.406	90-08-55	90-01-26	-13.363	910780.454255					
68-1-90	41618.704	-68146.479	13.341	0-11-05	90-02-10	13.314	-907302.221406					
68-1-51	41632.045	-68146.436	10.420	270-07-15	89-56-10	13.363	-910640.824268					
68-1-209	41632.067	-68156.856	13.336	180-07-29	90-00-14	-13.314	907440.380784					
							倍面積					277.789365
							面積					138.8946825

# 面積計算書（座標法）

世界測地系（測地成果2011）

所在	地番	公簿地目	現況地目	地積	所有者
前橋市六供町二丁目	68-1-3			346.25 m <sup>2</sup>	

点名	X座標	Y座標	辺長	方向角	測角	DX	倍積 (Y×DX)
68-1-233	41632.009	-68128.194	14.739	270-07-14	89-58-36	23.521	-1602443.251074
68-1-52	41632.040	-68142.933	23.489	180-09-13	90-01-59	-23.458	1598496.922314
68-1-54	41608.551	-68142.996	12.964	90-07-25	89-58-12	-23.517	1602518.836932
68-1-239	41608.523	-68130.032	1.779	90-07-44	180-00-19	-0.032	2180.161024
68-1-234	41608.519	-68128.253	23.490	0-08-38	90-00-54	23.486	-1600060.149958

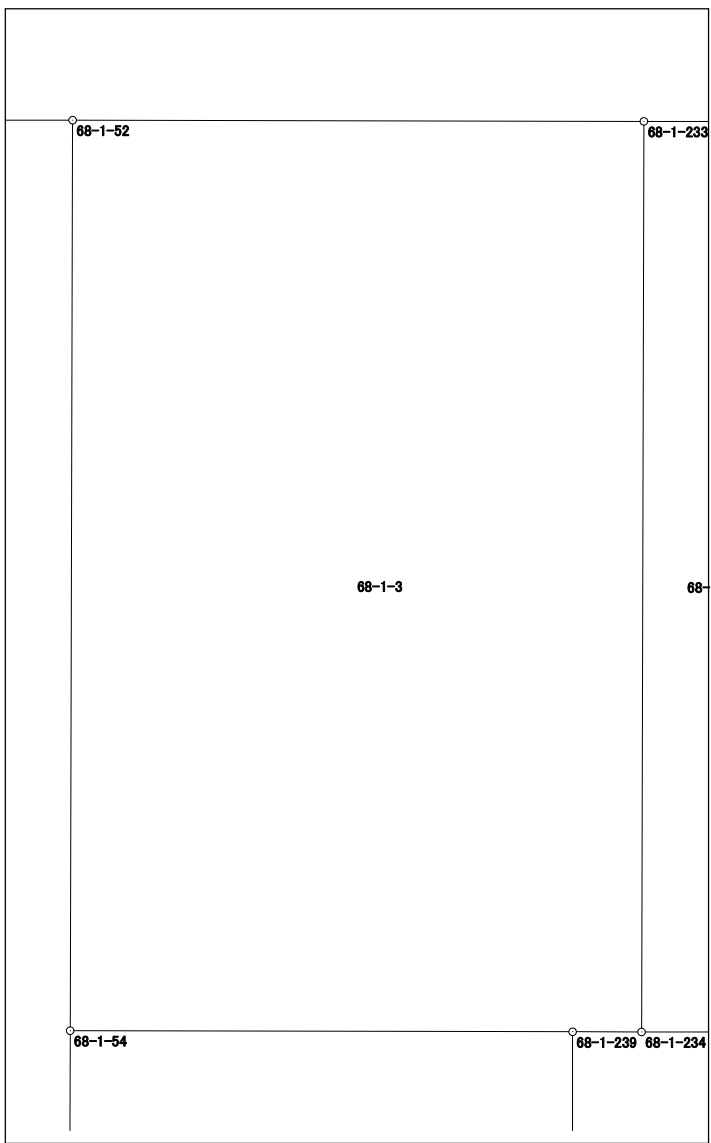

倍面積	692.519238
面積	346.2596190

# 面積計算書 (座標法)

世界測地系 (測地成果2011)

所在	地番	公簿地目	現況地目	地積	所有者
前橋市六供町二丁目	68-1-4-1			815.01 m <sup>2</sup>	


点名	X座標	Y座標	辺長	方向角	測角	DX	倍積 (Y×DX)	
68-1-237	41596.952	-68104.439	23.070	90-06-24	89-58-09	-35.067	2388218.362413	
68-1-105	41596.909	-68081.369	17.386	0-48-27	90-42-03	17.341	-1180599.019829	
68-1-102	41614.293	-68081.124	17.637	0-46-00	179-57-33	35.019	-2384132.881356	
68-1-101	41631.928	-68080.888	23.467	270-07-02	89-21-02	17.683	-1203874.342504	
68-1-238	41631.976	-68104.355	35.024	180-08-15	90-01-13	-34.976	2382017.920480	
							倍面積	1630.039204
							面積	815.0196020

# 面積計算書 (座標法)

世界測地系 (測地成果2011)

所在	地番	公簿地目	現況地目	地積	所有者
前橋市六供町二丁目	68-1-4-2			96.35 m <sup>2</sup>	

点名	X座標	Y座標	辺長	方向角	測角	DX	倍積 (Y×DX)
68-1-101	41631.928	-68080.888	17.637	180-46-00	90-38-57	-17.624	1199857.570112
68-1-102	41614.293	-68081.124	5.563	90-04-57	89-18-57	-17.643	1201155.270732
68-1-103	41614.285	-68075.561	17.632	0-07-36	90-02-39	17.624	-1199763.687064
68-1-59	41631.917	-68075.522	5.366	270-07-03	89-59-27	17.643	-1201056.434646
						倍面積	192.719134
						面積	96.3595670

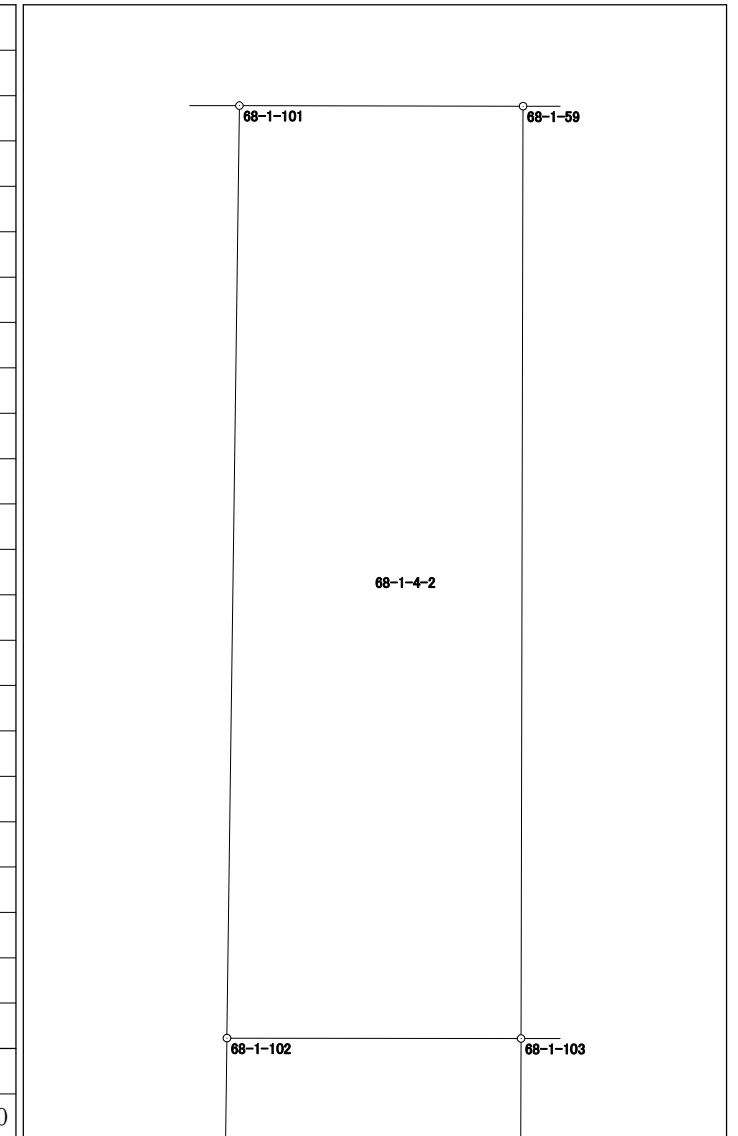


## 面積計算書（座標法）

世界測地系（測地成果2011）

所在	地番	公簿地目	現況地目	地積	所有者
前橋市六供町二丁目	68-1-4-3			98.33 m <sup>2</sup>	

点名	X座標	Y座標	辺長	方向角	測角	DX	倍積 (Y×DX)
68-1-102	41614.293	-68081.124	17.386	180-48-27	90-43-30	-17.376	1182977.610624
68-1-105	41596.909	-68081.369	5.749	90-06-35	89-18-08	-17.395	1184275.413755
68-1-58	41596.898	-68075.620	17.387	0-11-40	90-05-05	17.376	-1182881.973120
68-1-103	41614.285	-68075.561	5.563	270-04-57	89-53-17	17.395	-1184174.383595

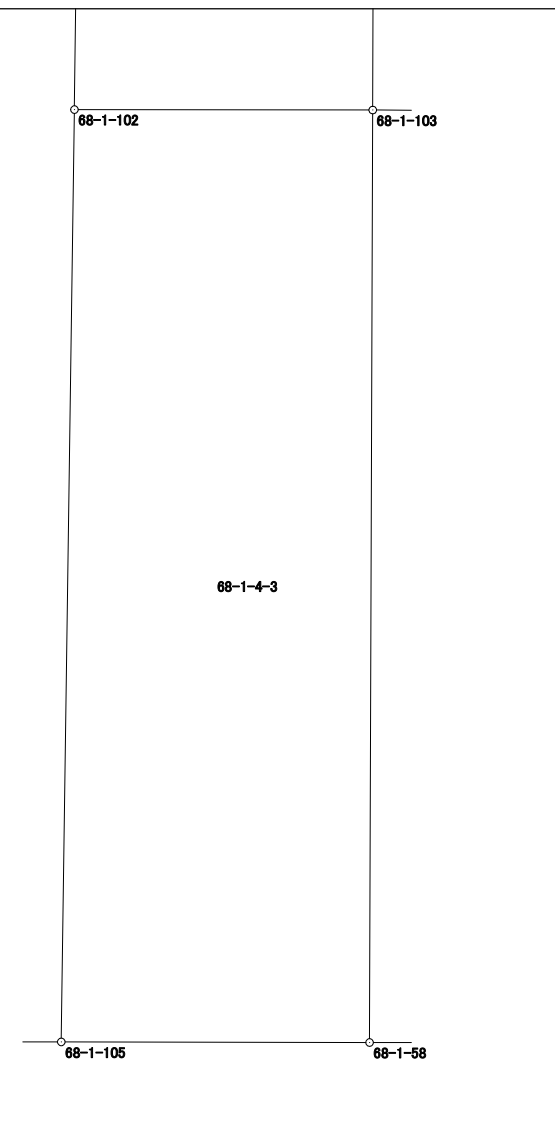


倍面積	196.667664
面積	98.3338320

## 面積計算書 (座標法)

世界測地系 (測地成果2011)

所 在	地 番	公簿地目	現況地目	地 積	所 有 者
前橋市六供町二丁目	68-1-5-1			143.43 m <sup>2</sup>	

点 名	X 座標	Y 座標	辺 長	方 向 角	測 角	DX	倍 積 (Y×DX)
68-1-59	41631.917	-68075.522	17.632	180-07-36	90-02-07	-17.619	1199422.622118
68-1-103	41614.285	-68075.561	8.126	90-07-12	89-59-36	-17.649	1201465.576089
68-1-104	41614.268	-68067.435	2.824	0-10-57	90-03-45	2.807	-191065.290045
68-1-244	41617.092	-68067.426	14.812	0-10-41	179-59-44	17.636	-1200437.124936
68-1-61	41631.904	-68067.380	8.142	270-05-29	89-54-48	14.825	-1009098.908500

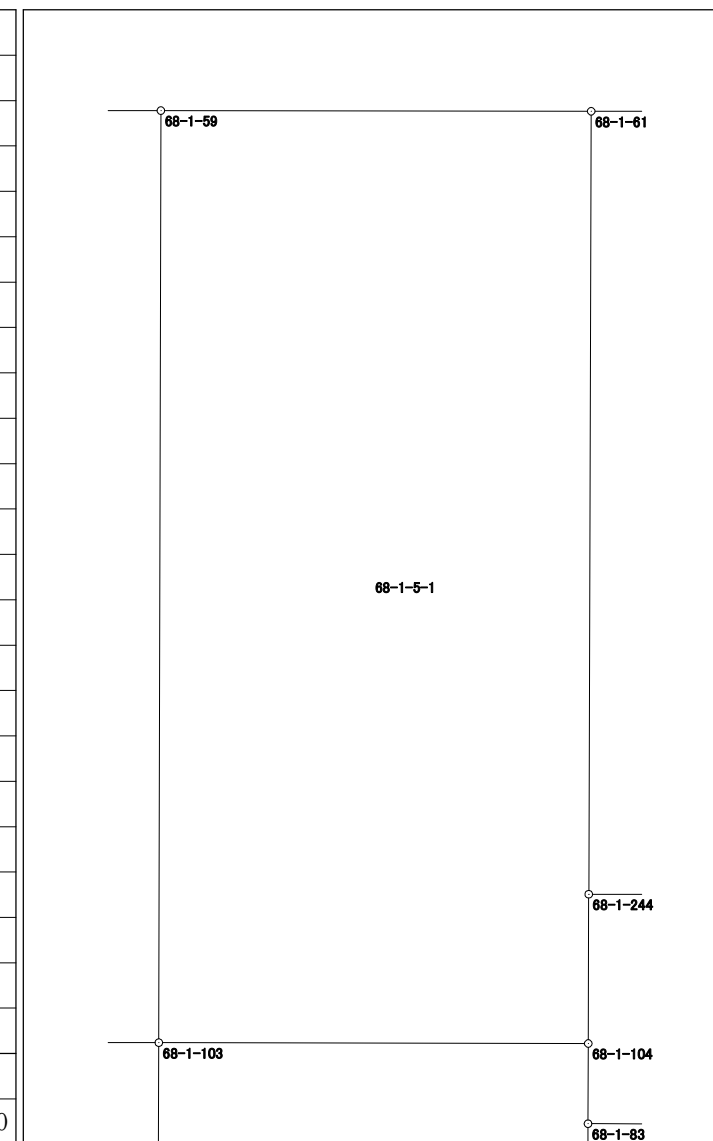

倍面積	286.874726
面 積	143.4373630




# 面積計算書（座標法）

世界測地系（測地成果2011）

所在	地番	公簿地目	現況地目	地積	所有者
前橋市六供町二丁目	68-1-5-2			141.35 m <sup>2</sup>	

点名	X座標	Y座標	辺長	方向角	測角	DX	倍積 (Y×DX)
68-1-103	41614.285	-68075.561	17.387	180-11-40	90-04-28	-17.370	1182472.494570
68-1-58	41596.898	-68075.620	8.138	90-03-48	89-52-08	-17.396	1184243.485520
68-1-60	41596.889	-68067.482	11.164	0-09-14	90-05-26	11.155	-759292.761710
68-1-247	41608.053	-68067.452	4.698	0-08-47	179-59-33	15.862	-1079685.923624
68-1-83	41612.751	-68067.440	1.517	0-11-20	180-02-33	6.215	-423039.139600
68-1-104	41614.268	-68067.435	8.126	270-07-12	89-55-52	1.534	-104415.445290
						倍面積	282.709866
						面積	141.3549330

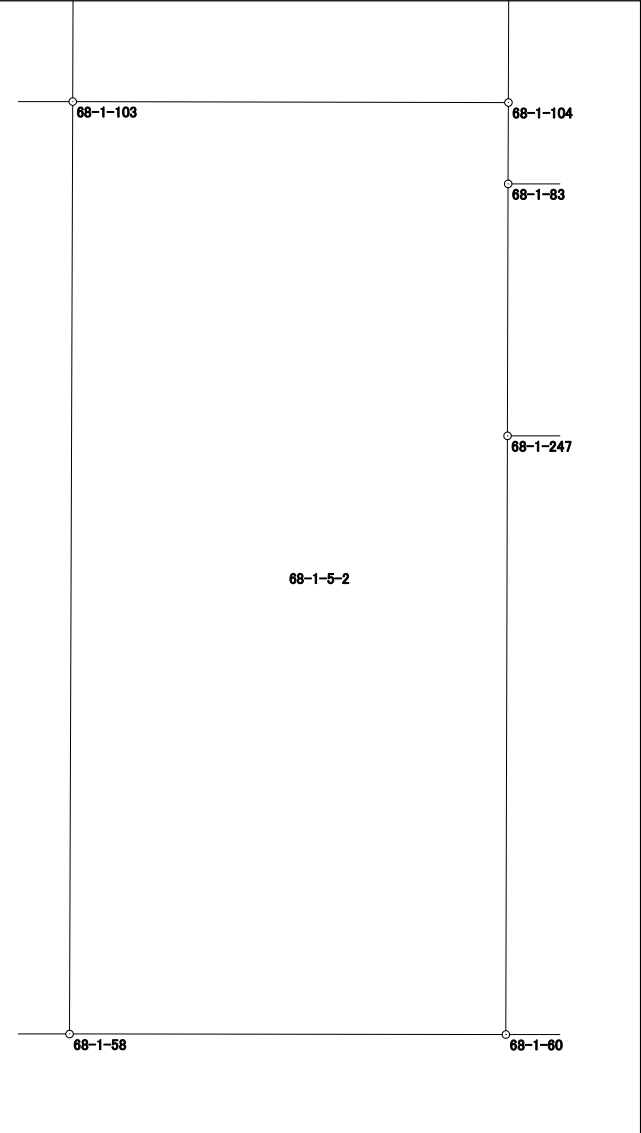




# 面積計算書 (座標法)

世界測地系 (測地成果2011)

所在	地番	公簿地目	現況地目	地積	所有者
前橋市六供町二丁目	68-1-7			66.30 m <sup>2</sup>	

点名	X座標	Y座標	辺長	方向角	測角	Dx	倍積 (Y×Dx)
68-1-83	41612.751	-68067.440	15.276	90-03-09	89-51-49	-1.531	104211.250640
68-1-84	41612.737	-68052.164	4.341	0-08-43	90-05-34	4.327	-294461.713628
68-1-243	41617.078	-68052.153	10.749	270-03-12	89-54-29	4.351	-296094.917703
68-1-245	41617.088	-68062.902	4.524	270-03-02	179-59-50	0.014	-952.880628
68-1-244	41617.092	-68067.426	2.824	180-10-57	90-07-55	-2.820	191950.141320
68-1-104	41614.268	-68067.435	1.517	180-11-20	180-00-23	-4.341	295480.735335
						倍面積	132.615336
						面積	66.3076680

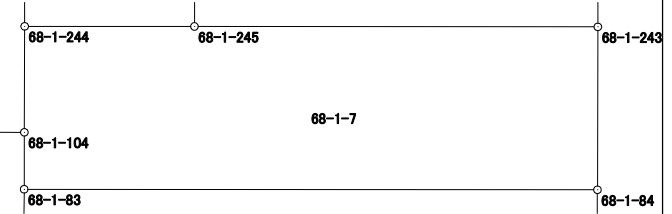



# 面積計算書（座標法）

世界測地系（測地成果2011）

所 在	地 番	公簿地目	現況地目	地 積	所 有 者
前橋市六供町二丁目	68-1-9			133.12 m <sup>2</sup>	


点 名	X 座標	Y 座標	辺 長	方 向 角	測 角	DX	倍 積 (Y×DX)	
68-1-241	41608.475	-68114.135	11.557	270-10-25	90-07-08	11.540	-786037.117900	
68-1-66	41608.510	-68125.692	11.519	180-07-28	89-57-03	-11.484	782355.446928	
68-1-67	41596.991	-68125.717	11.571	90-06-14	89-58-46	-11.540	786170.774180	
68-1-242	41596.970	-68114.146	11.505	0-03-17	89-57-03	11.484	-782222.852664	
倍面積							266.250544	
面 積							133.1252720	

# 面積計算書（座標法）

世界測地系（測地成果2011）

所在	地番	公簿地目	現況地目	地積	所有者
前橋市六供町二丁目	68-1-10			149.35 m <sup>2</sup>	

点名	X座標	Y座標	辺長	方向角	測角	DX	倍積 (Y×DX)
68-1-239	41608.523	-68130.032	12.964	270-07-25	89-59-57	11.550	-786901.869600
68-1-54	41608.551	-68142.996	11.519	180-07-46	90-00-21	-11.491	783031.167036
68-1-53	41597.032	-68143.022	12.965	90-08-13	90-00-27	-11.550	787051.904100
68-1-240	41597.001	-68130.057	11.522	0-07-28	89-59-15	11.491	-782882.484987
						倍面積	298.716549
						面積	149.3582745

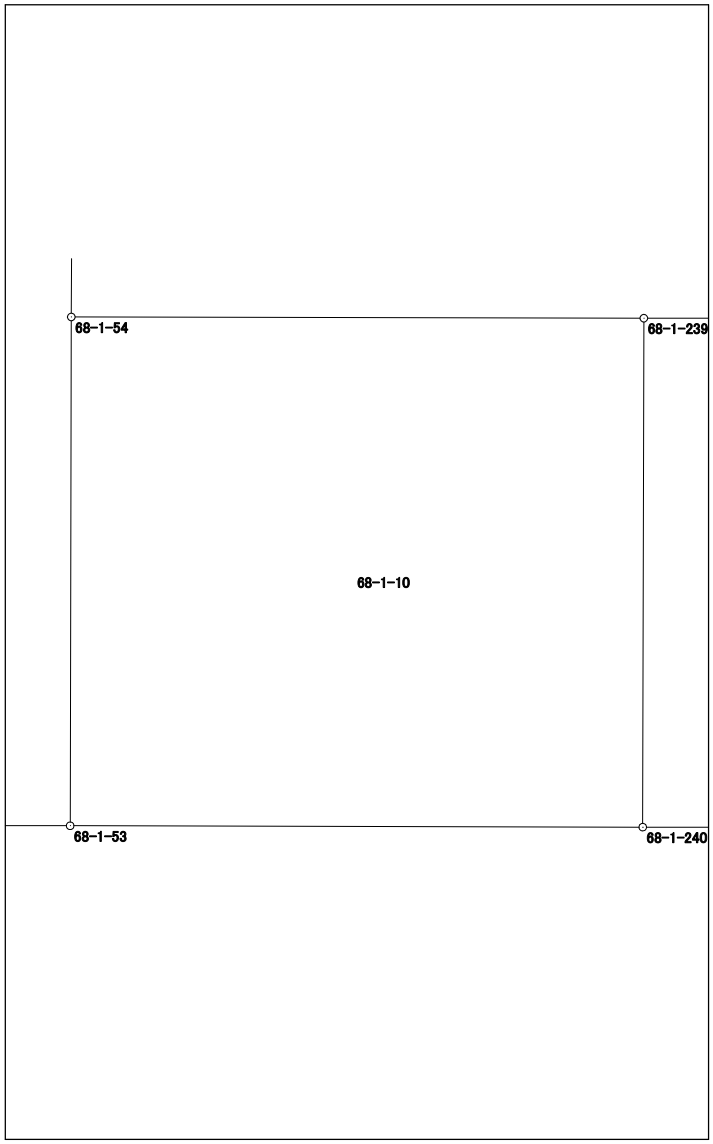


















# 面積計算書 (座標法)

世界測地系 (測地成果2011)

所 在	地 番	公簿地目	現況地目	地 積	所 有 者
前橋市六供町二丁目	68-1-18			236.83 m <sup>2</sup>	

点 名	X 座標	Y 座標	辺 長	方 向 角	測 角	DX	倍 積 (Y×DX)
68-1-260	41586.330	-68161.464	0.874	0-11-48	90-05-16	0.836	-56982.983904
68-1-211	41587.204	-68161.461	3.279	0-10-29	179-58-41	4.153	-283074.547533
68-1-213	41590.483	-68161.451	7.469	0-10-08	179-59-39	10.748	-732599.275348
68-1-259	41597.952	-68161.429	20.740	270-07-28	89-57-20	7.514	-512164.977506
68-1-258	41597.997	-68182.169	11.650	176-33-19	86-25-51	-11.584	789822.245696
68-1-261	41586.368	-68181.469	20.005	90-06-32	93-33-13	-11.667	795473.198823
倍面積						473.660228	
面 積						236.8301140	

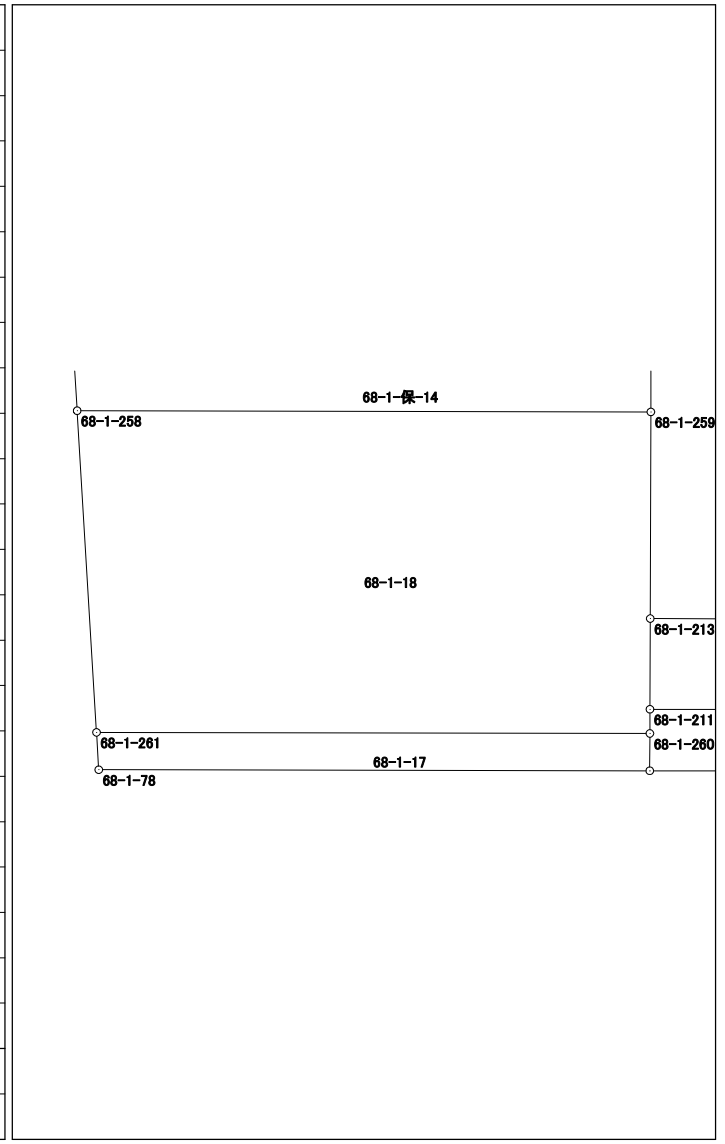




# 面積計算書（座標法）

世界測地系（測地成果2011）

所在	地番	公簿地目	現況地目	地積	所有者
前橋市六供町二丁目	68-1-20			71.77 m <sup>2</sup>	

点名	X座標	Y座標	辺長	方向角	測角	DX	倍積 (Y×DX)
68-1-84	41612.737	-68052.164	15.276	270-03-09	89-56-34	4.713	-320729.848932
68-1-83	41612.751	-68067.440	4.698	180-08-47	90-05-38	-4.684	318827.888960
68-1-247	41608.053	-68067.452	4.478	90-03-04	89-54-17	-4.702	320053.159304
68-1-250	41608.049	-68062.974	10.801	90-03-30	180-00-26	-0.015	1020.944610
68-1-248	41608.038	-68052.173	4.699	0-06-35	90-03-05	4.688	-319028.587024
						倍面積	143.556918
						面積	71.7784590

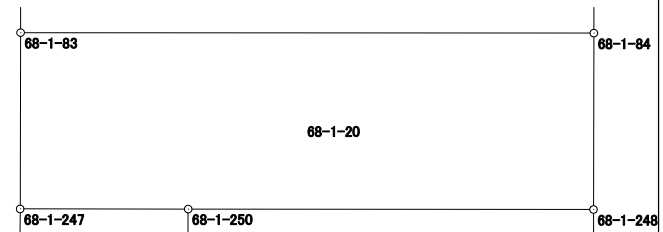






# 面積計算書 (座標法)

世界測地系 (測地成果2011)

所在	地番	公簿地目	現況地目	地積	所有者
前橋市六供町二丁目	68-1-22			45.97 m <sup>2</sup>	

点名	X座標	Y座標	辺長	方向角	測角	DX	倍積 (Y×DX)
68-1-88	41608.828	-68182.826	2.150	176-30-24	86-25-06	-2.113	144070.311338
68-1-204	41606.682	-68182.695	21.286	90-07-35	93-37-11	-2.193	149524.650135
68-1-203	41606.635	-68161.409	2.160	0-06-22	89-58-47	2.113	-144025.057217
68-1-205	41608.795	-68161.405	21.421	270-05-18	89-58-56	2.193	-149477.961165
						倍面積	91.943091
						面積	45.9715455

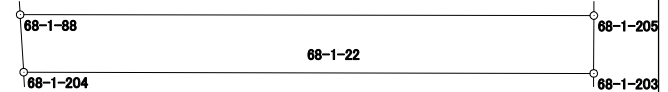


# 面積計算書 (座標法)

世界測地系 (測地成果2011)

所在	地番	公簿地目	現況地目	地積	所有者
前橋市六供町二丁目	68-1-保-1			105.00 m <sup>2</sup>	

点名	X座標	Y座標	辺長	方向角	測角	DX	倍積 (Y×DX)
68-1-88	41608.828	-68182.826	21.421	90-05-18	93-34-05	-4.901	334164.030226
68-1-205	41608.795	-68161.405	4.867	0-07-04	90-01-46	4.834	-329492.231770
68-1-206	41613.662	-68161.395	21.727	270-05-23	89-58-19	4.901	-334058.996895
68-1-207	41613.696	-68183.122	4.877	176-31-13	86-25-50	-4.834	329597.211748
						倍面積	210.013309
						面積	105.0066545

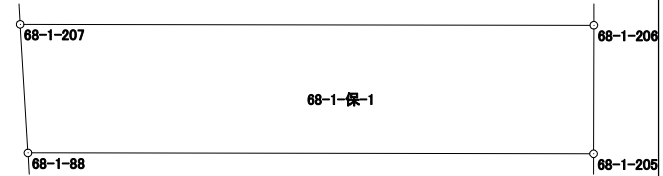


# 面積計算書（座標法）

世界測地系（測地成果2011）

所 在	地 番	公簿地目	現況地目	地 積	所 有 者
前橋市六供町二丁目	68-1-保-3			54.00 m <sup>2</sup>	

点 名	X 座標	Y 座標	辺 長	方 向 角	測 角	DX	倍 積 (Y×DX)
68-1-81	41608.514	-68125.954	23.490	0-08-38	90-01-09	23.485	-1599938.029690
68-1-82	41632.004	-68125.895	2.299	270-07-29	89-58-51	23.495	-1600617.903025
68-1-233	41632.009	-68128.194	23.490	180-08-38	90-01-09	-23.485	1599990.636090
68-1-234	41608.519	-68128.253	2.299	90-07-29	89-58-51	-23.495	1600673.304235
						倍面積	108.007610
						面 積	54.0038050

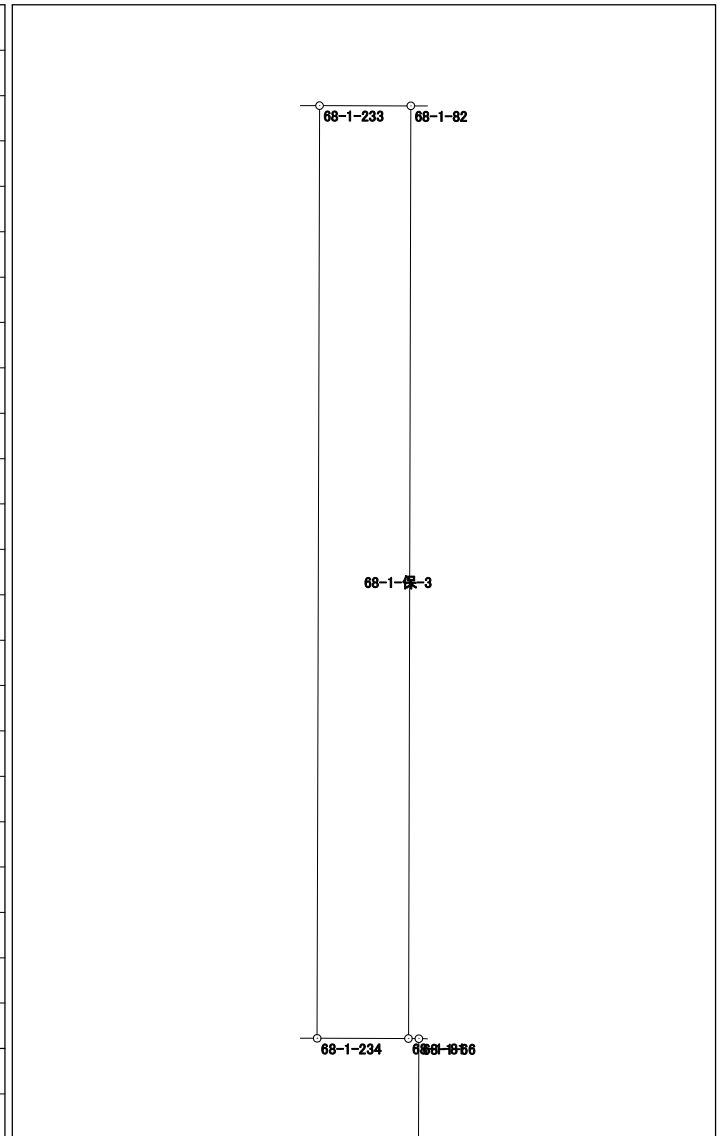


# 面積計算書 (座標法)

世界測地系 (測地成果2011)

所在	地番	公簿地目	現況地目	地積	所有者
前橋市六供町二丁目	68-1-保-4			188.00 m <sup>2</sup>	

点名	X座標	Y座標	辺長	方向角	測角	DX	倍積 (Y×DX)
68-1-55	41608.461	-68109.788	11.499	180-02-59	179-52-10	-35.025	2385545.324700
68-1-56	41596.962	-68109.798	5.359	90-06-25	90-03-26	-11.509	783875.665182
68-1-237	41596.952	-68104.439	35.024	0-08-15	90-01-50	35.014	-2384608.827146
68-1-238	41631.976	-68104.355	5.359	270-07-03	89-58-48	35.035	-2386036.077425
68-1-57	41631.987	-68109.714	23.526	180-10-49	90-03-46	-23.515	1601599.924710

倍面積	376.010021
面積	188.0050105

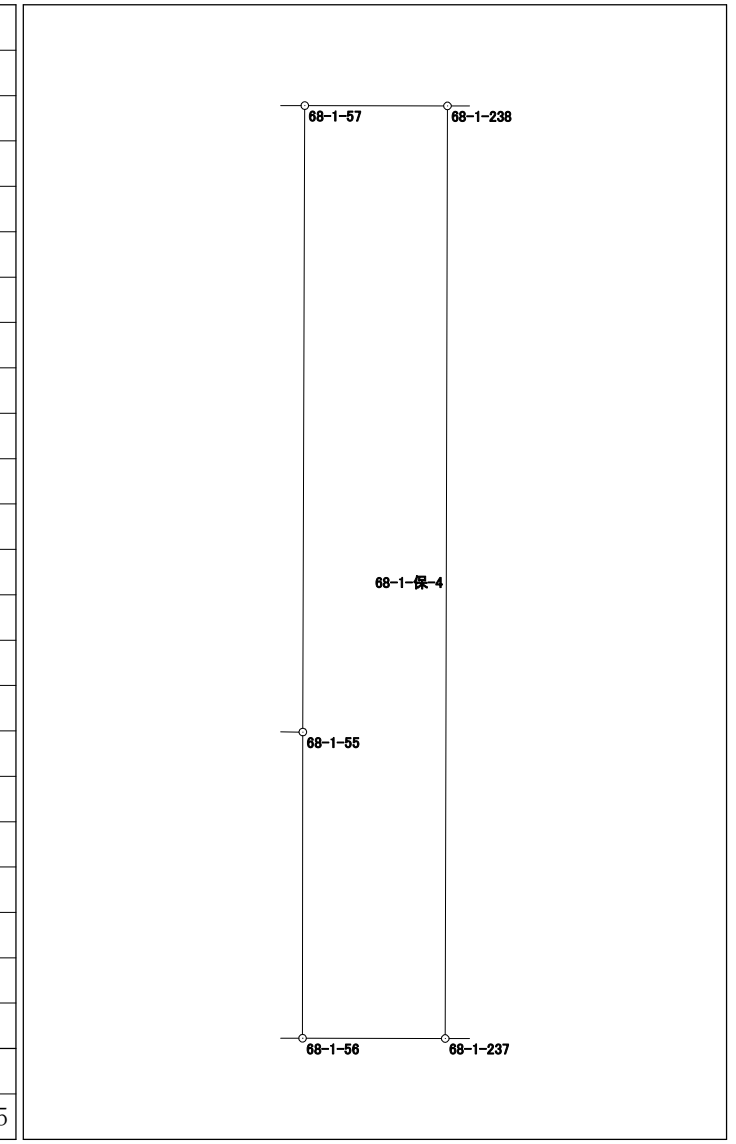


# 面積計算書（座標法）

世界測地系（測地成果2011）

所在	地番	公簿地目	現況地目	地積	所有者
前橋市六供町二丁目	68-1-保-5			67.00 m <sup>2</sup>	

点名	X座標	Y座標	辺長	方向角	測角	DX	倍積 (Y×DX)
68-1-61	41631.904	-68067.380	14.812	180-10-41	90-05-22	-14.805	1007737.560900
68-1-244	41617.092	-68067.426	4.524	90-03-02	89-52-21	-14.816	1008486.983616
68-1-245	41617.088	-68062.902	14.809	0-10-41	90-07-39	14.805	-1007671.264110
68-1-246	41631.897	-68062.856	4.524	270-05-19	89-54-38	14.816	-1008419.274496
						倍面積	134.005910
						面積	67.0029550

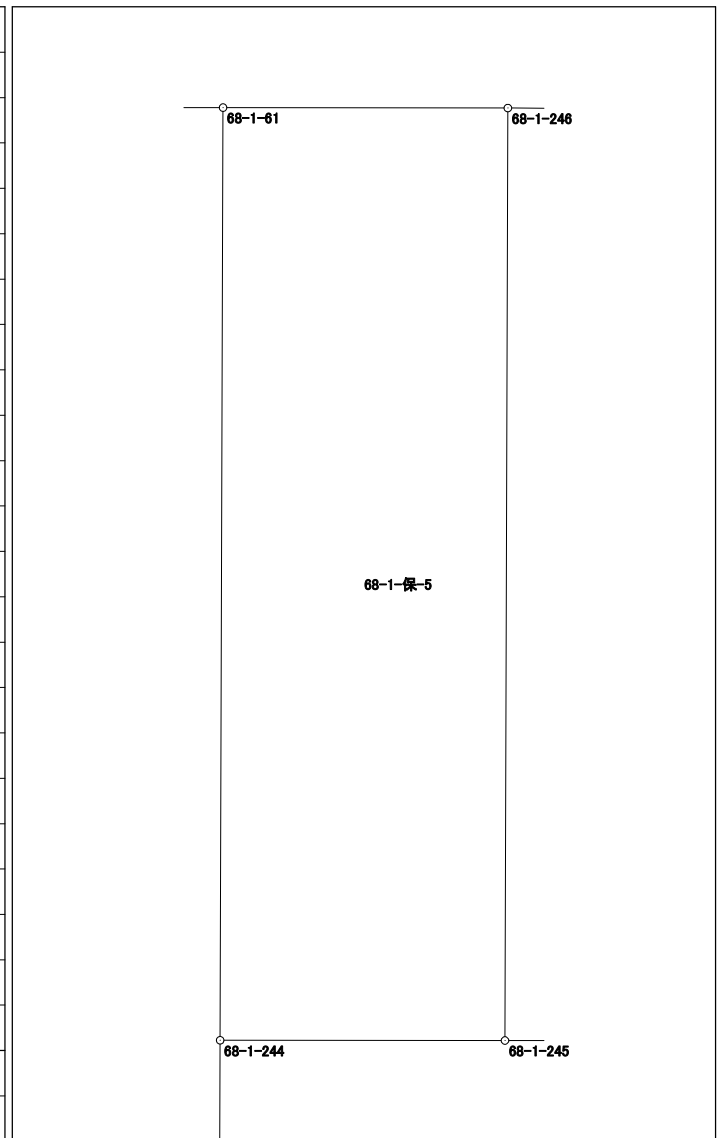


# 面積計算書（座標法）

世界測地系（測地成果2011）

所 在	地 番	公簿地目	現況地目	地 積	所 有 者
前橋市六供町二丁目	68-1-保-6			50.00 m <sup>2</sup>	

点 名	X 座 標	Y 座 標	辺 長	方 向 角	測 角	DX	倍 積 (Y×DX)
68-1-247	41608.053	-68067.452	11.164	180-09-14	90-06-10	-11.160	759632.764320
68-1-60	41596.889	-68067.482	4.477	90-09-13	89-59-59	-11.176	760722.178832
68-1-249	41596.877	-68063.005	11.172	0-09-32	90-00-19	11.160	-759583.135800
68-1-250	41608.049	-68062.974	4.478	270-03-04	89-53-32	11.176	-760671.797424

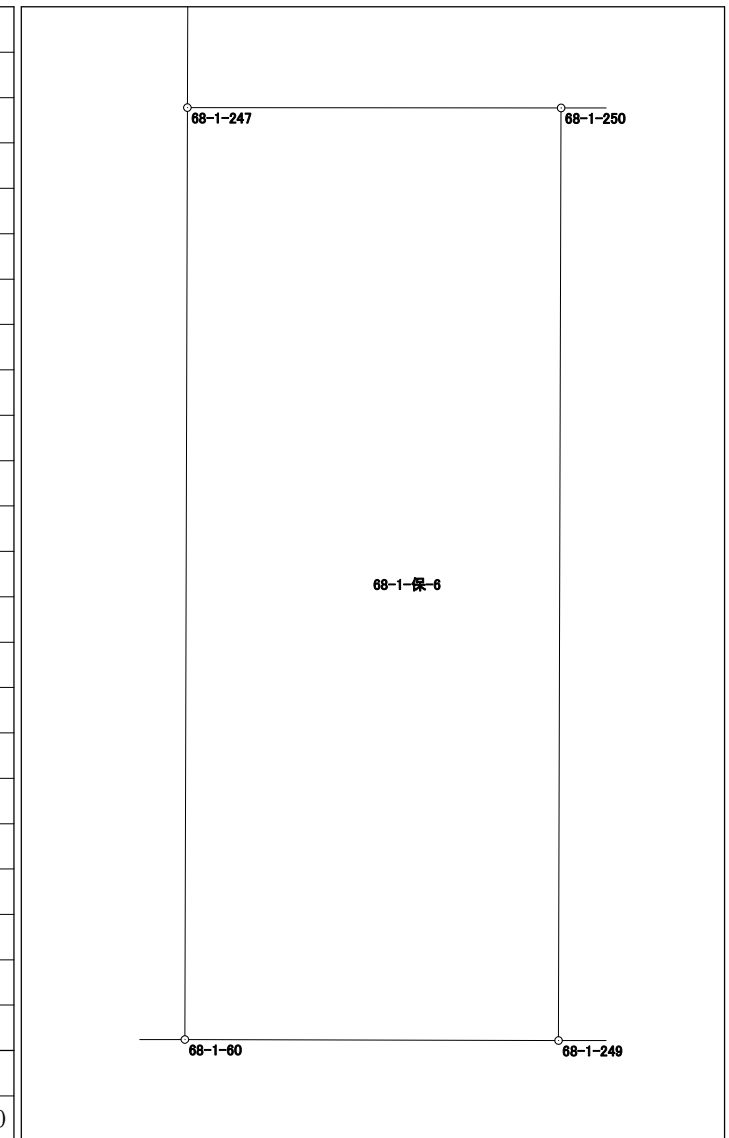


倍面積	100.009928
面 積	50.0049640

# 面積計算書 (座標法)

世界測地系 (測地成果2011)

所在	地番	公簿地目	現況地目	地積	所有者
前橋市六供町二丁目	68-1-保-7			50.00 m <sup>2</sup>	

点名	X座標	Y座標	辺長	方向角	測角	DX	倍積 (Y×DX)
68-1-56	41596.962	-68109.798	11.499	0-02-59	89-56-39	11.491	-782649.688818
68-1-55	41608.461	-68109.788	2.211	270-12-26	90-09-27	11.507	-783739.330516
68-1-236	41608.469	-68111.999	2.136	270-09-39	179-57-13	0.014	-953.567986
68-1-241	41608.475	-68114.135	11.505	180-03-17	89-53-38	-11.499	783244.438365
68-1-242	41596.970	-68114.146	4.348	90-06-20	90-03-03	-11.513	784198.162898
						倍面積	100.013943
						面積	50.0069715

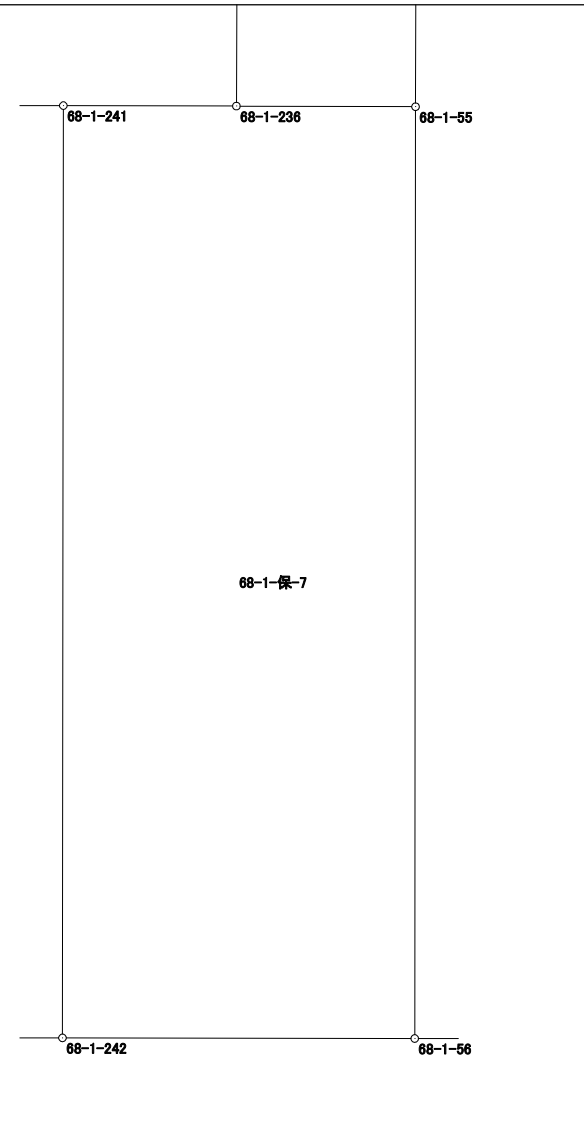














# 面積計算書 (座標法)

世界測地系 (測地成果2011)

所在	地番	公簿地目	現況地目	地積	所有者
前橋市六供町二丁目	68-1-保-14			37.00 m <sup>2</sup>	

点名	X座標	Y座標	辺長	方向角	測角	DX	倍積 (Y×DX)
68-1-45	41599.777	-68182.276	1.783	176-33-36	86-26-01	-1.734	118228.066584
68-1-258	41597.997	-68182.169	20.740	90-07-28	93-33-52	-1.825	124432.458425
68-1-259	41597.952	-68161.429	1.779	0-09-40	90-02-12	1.734	-118191.917886
68-1-46	41599.731	-68161.424	20.852	270-07-35	89-57-55	1.825	-124394.598800
						倍面積	74.008323
						面積	37.0041615

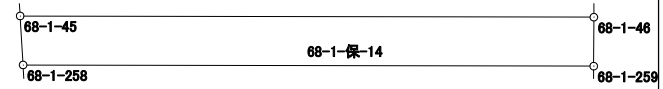



# 面積計算書（座標法）

世界測地系（測地成果2011）

所 在	地 番	公簿地目	現況地目	地 積	所 有 者
前橋市六供町二丁目	68-1-保-16			30.00 m <sup>2</sup>	

点 名	X 座標	Y 座標	辺 長	方 向 角	測 角	DX	倍 積 (Y×DX)		
68-1-45	41599.777	-68182.276	20.852	90-07-35	93-35-36	-1.482	101046.133032		
68-1-46	41599.731	-68161.424	1.436	0-07-11	89-59-36	1.390	-94744.379360		
68-1-201	41601.167	-68161.421	20.942	270-07-33	90-00-22	1.482	-101015.225922		
68-1-202	41601.213	-68182.363	1.439	176-31-59	86-24-26	-1.390	94773.484570		
							倍面積		60.012320
							面 積		30.0061600





# 面積計算書 (座標法)

世界測地系 (測地成果2011)

所 在	地 番	公簿地目	現況地目	地 積	所 有 者
前橋市六供町二丁目	68-1-保-18			8.34 m <sup>2</sup>	

点 名	X 座標	Y 座標	辺 長	方 向 角	測 角	DX	倍 積 (Y×DX)	
68-1-93	41584.947	-68144.689	10.999	270-08-26	90-03-54	0.786	-53561.725554	
68-1-77	41584.974	-68155.688	0.759	180-04-32	89-56-06	-0.732	49889.963616	
68-1-230	41584.215	-68155.689	10.999	90-08-26	90-03-54	-0.786	53570.371554	
68-1-231	41584.188	-68144.690	0.759	0-04-32	89-56-06	0.732	-49881.913080	
						倍面積	16.696536	
						面 積	8.3482680	

# 面積計算書（座標法）

世界測地系（測地成果2011）

所 在	地 番	公簿地目	現況地目	地 積	所 有 者
前橋市六供町二丁目	68-1-保-19			37.26 m <sup>2</sup>	

点 名	X 座標	Y 座標	辺 長	方 向 角	測 角	DX	倍 積 (Y×DX)	
68-1-47	41584.981	-68161.468	5.780	90-04-10	89-53-58	-1.356	92426.950608	
68-1-77	41584.974	-68155.688	10.999	90-08-26	180-04-16	-0.034	2317.293392	
68-1-93	41584.947	-68144.689	2.224	0-07-44	89-59-18	2.197	-149713.881733	
68-1-210	41587.171	-68144.684	16.777	270-06-46	89-59-02	2.257	-153802.551788	
68-1-211	41587.204	-68161.461	0.874	180-11-48	90-05-02	-0.841	57323.788701	
68-1-260	41586.330	-68161.464	1.349	180-10-12	179-58-24	-2.223	151522.934472	
							倍面積	74.533652
							面 積	37.2668260