



69-1街区 画地出来形確認図 (5272.67m²)

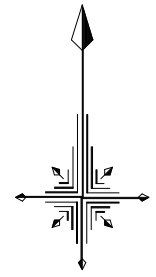

S=1/500

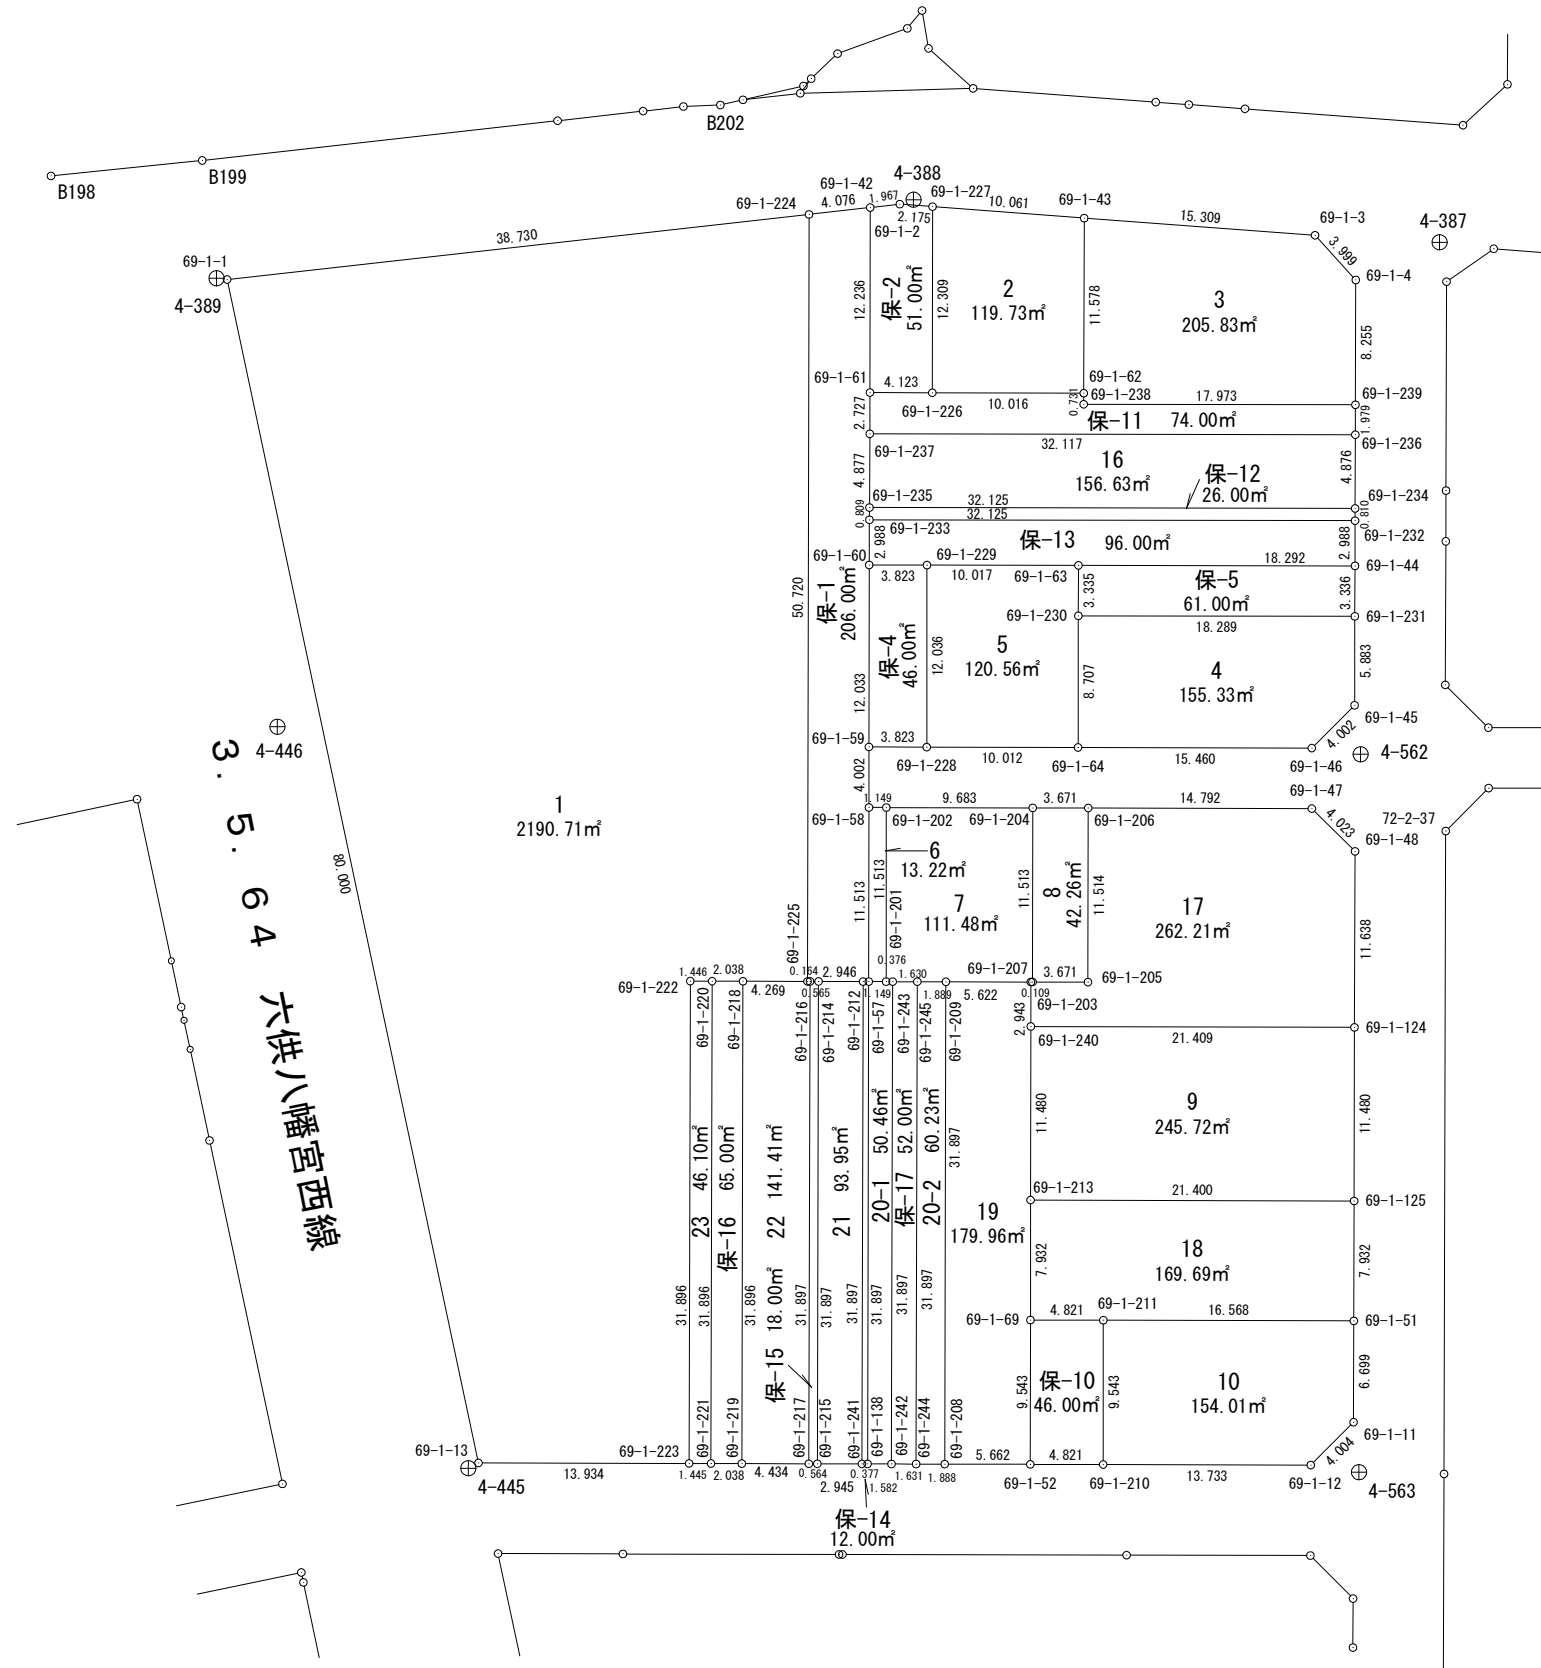

面積計算書（座標法）

世界測地系（測地成果2011）

所 在	地 番	公簿地目	現況地目	地 積	所 有 者
前橋市六供町一丁目	69-1-2			119.73 m ²	


点 名	X 座標	Y 座標	辺 長	方 向 角	測 角	DX	倍 積 (Y×DX)		
69-1-226	41783.992	-68170.346	10.016	90-10-18	90-05-50	-12.339	841153.899294		
69-1-62	41783.962	-68160.330	11.578	0-09-30	89-59-12	11.548	-787115.490840		
69-1-43	41795.540	-68160.298	10.061	274-20-17	94-10-47	12.339	-841029.917022		
69-1-227	41796.301	-68170.330	12.309	180-04-28	85-44-11	-11.548	787230.970840		
倍面積							239.462272		
面 積							119.7311360		

面積計算書 (座標法)

世界測地系 (測地成果2011)

所在	地番	公簿地目	現況地目	地積	所有者
前橋市六供町一丁目	69-1-3			205.83 m ²	

点名	X座標	Y座標	辺長	方向角	測角	DX	倍積 (Y×DX)
69-1-43	41795.540	-68160.298	11.578	180-09-30	85-55-04	-10.446	712002.472908
69-1-62	41783.962	-68160.330	0.731	180-09-24	179-59-54	-12.309	838985.501970
69-1-238	41783.231	-68160.332	17.973	90-06-19	89-56-55	-0.764	52074.493648
69-1-239	41783.198	-68142.359	8.255	0-09-35	90-03-16	8.222	-560266.475698
69-1-4	41791.453	-68142.336	3.999	317-38-05	137-28-30	11.210	-763875.586560
69-1-3	41794.408	-68145.031	15.309	274-14-26	136-36-21	4.087	-278508.741697
倍面積							411.664571
面積							205.8322855

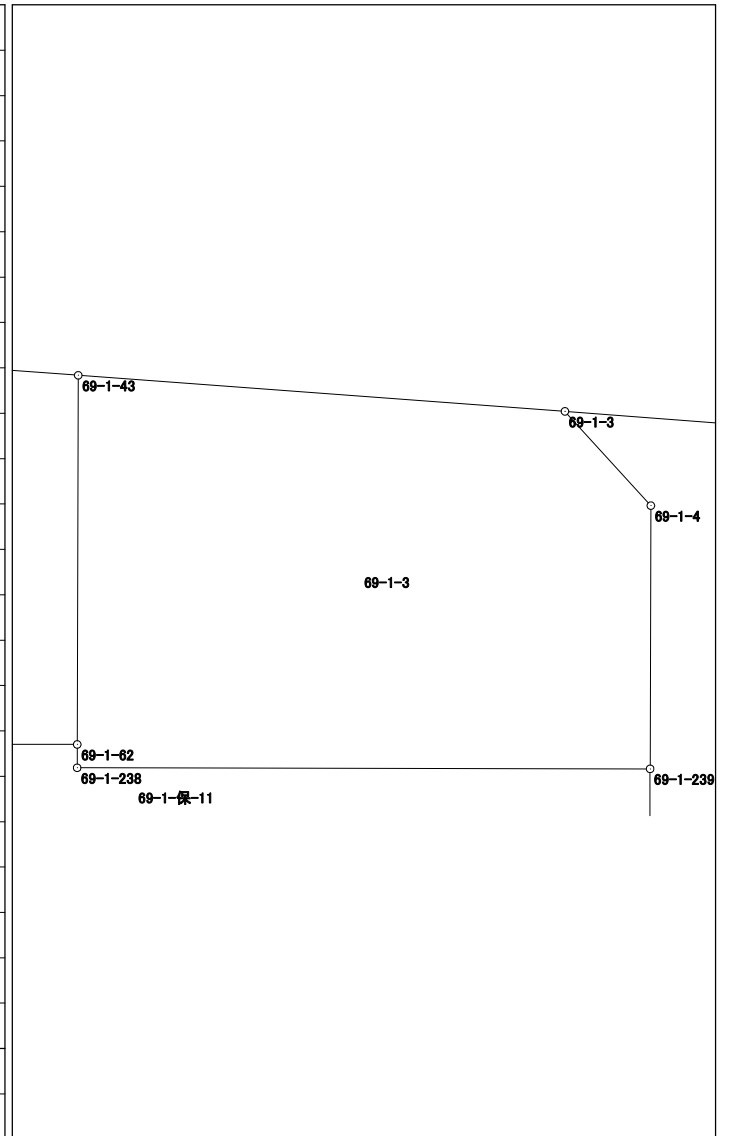


面積計算書 (座標法)

世界測地系 (測地成果2011)

所在	地番	公簿地目	現況地目	地積	所有者
前橋市六供町一丁目	69-1-4			155.33 m ²	

点名	X座標	Y座標	辺長	方向角	測角	DX	倍積 (Y×DX)	
69-1-230	41769.243	-68160.687	8.707	180-06-43	90-00-20	-8.673	591157.638351	
69-1-64	41760.536	-68160.704	15.460	90-08-54	90-02-11	-8.747	596201.677888	
69-1-46	41760.496	-68145.244	4.002	45-00-00	134-51-06	2.790	-190125.230760	
69-1-45	41763.326	-68142.414	5.883	0-09-21	135-09-21	8.713	-593724.853182	
69-1-231	41769.209	-68142.398	18.289	270-06-23	89-57-02	5.917	-403198.568966	
							倍面積	310.663331
							面積	155.3316655

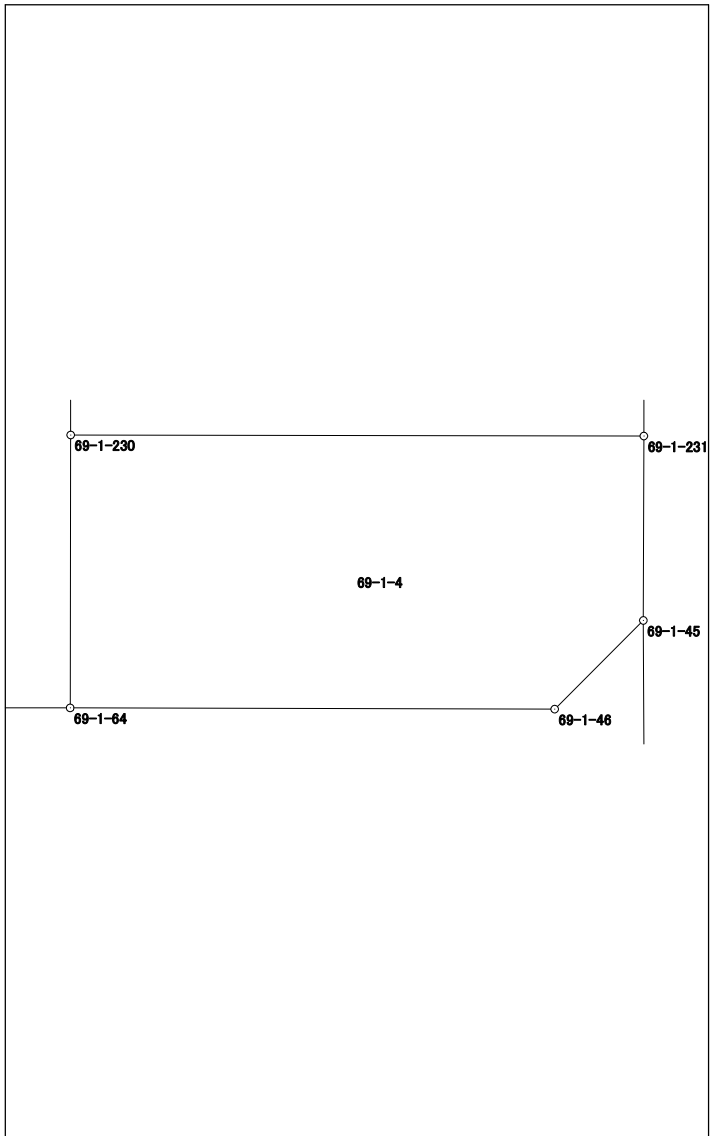

面積計算書 (座標法)

世界測地系 (測地成果2011)

所 在	地 番	公簿地目	現況地目	地 積	所 有 者
前橋市六供町一丁目	69-1-5			120.56 m ²	

点 名	X 座標	Y 座標	辺 長	方 向 角	測 角	DX	倍 積 (Y×DX)	
69-1-228	41760.561	-68170.716	10.012	90-08-35	90-03-27	-12.061	822207.005676	
69-1-64	41760.536	-68160.704	8.707	0-06-43	89-58-08	8.682	-591771.232128	
69-1-230	41769.243	-68160.687	3.335	0-06-11	179-59-28	12.042	-820790.992854	
69-1-63	41772.578	-68160.681	10.017	270-06-31	90-00-20	3.354	-228610.924074	
69-1-229	41772.597	-68170.698	12.036	180-05-08	89-58-37	-12.017	819207.277866	
							倍面積	
							面 積	120.5672430

面積計算書（座標法）

世界測地系（測地成果2011）

所 在	地 番	公簿地目	現況地目	地 積	所 有 者
前橋市六供町一丁目	69-1-6			13.22 m ²	


点 名	X 座標	Y 座標	辺 長	方 向 角	測 角	DX	倍 積 (Y×DX)			
69-1-57	41745.056	-68174.551	1.149	90-08-59	90-04-30	-11.516	785098.129316			
69-1-201	41745.053	-68173.402	11.513	0-04-29	89-55-30	11.510	-784675.857020			
69-1-202	41756.566	-68173.387	1.149	270-08-59	90-04-30	11.516	-785084.724692			
69-1-58	41756.569	-68174.536	11.513	180-04-29	89-55-30	-11.510	784688.909360			
							倍面積	26.456964		
							面 積	13.2284820		

面積計算書 (座標法)

世界測地系 (測地成果2011)

所 在	地 番	公簿地目	現況地目	地 積	所 有 者
前橋市六供町一丁目	69-1-7			111.48 m ²	

点 名	X 座標	Y 座標	辺 長	方 向 角	測 角	DX	倍 積 (Y×DX)
69-1-202	41756.566	-68173.387	11.513	180-04-29	89-55-58	-11.489	783244.043243
69-1-201	41745.053	-68173.402	0.433	90-07-56	90-03-27	-11.514	784948.550628
69-1-243	41745.052	-68172.969	1.630	90-08-26	180-00-30	-0.005	340.864845
69-1-245	41745.048	-68171.339	1.889	90-09-06	180-00-40	-0.009	613.542051
69-1-209	41745.043	-68169.450	5.622	90-08-34	179-59-28	-0.019	1295.219550
69-1-207	41745.029	-68163.828	0.109	90-00-00	179-51-26	-0.014	954.293592
69-1-203	41745.029	-68163.719	11.513	0-04-29	90-04-29	11.513	-784768.896847
69-1-204	41756.542	-68163.704	9.683	270-08-31	90-04-02	11.537	-786404.653048

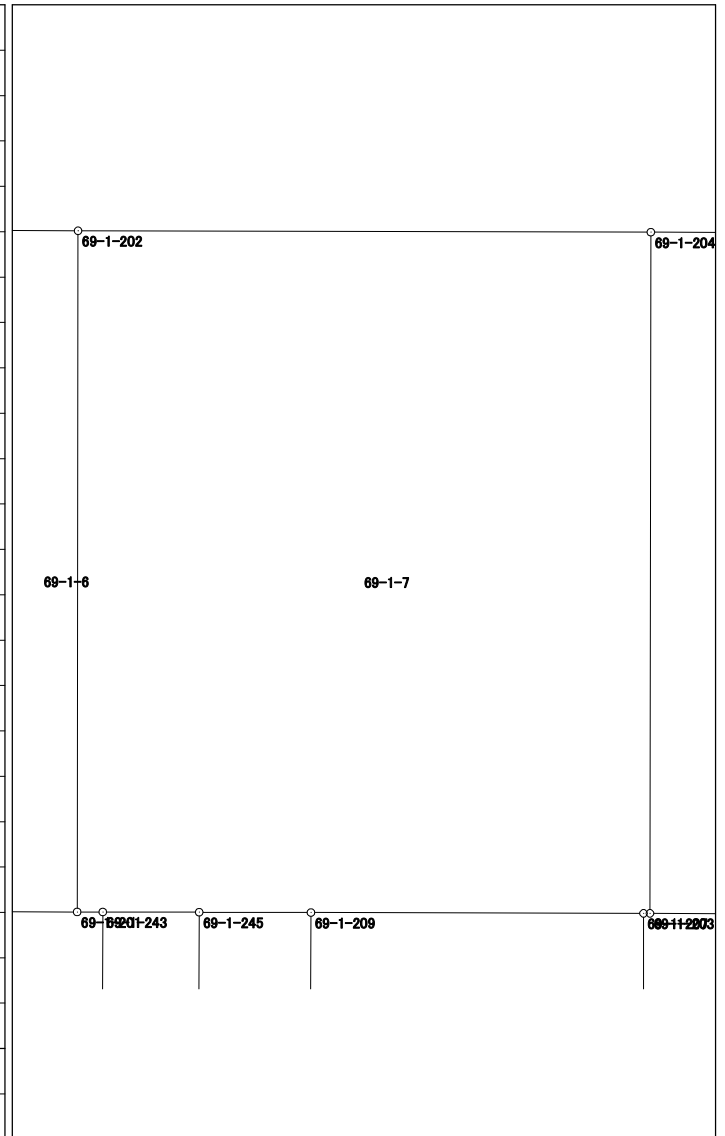


倍面積	222.964014
面 積	111.4820070

面積計算書（座標法）

世界測地系（測地成果2011）

所 在	地 番	公簿地目	現況地目	地 積	所 有 者
前橋市六供町一丁目	69-1-8			42.26 m ²	

点 名	X 座標	Y 座標	辺 長	方 向 角	測 角	DX	倍 積 (Y×DX)
69-1-204	41756.542	-68163.704	11.513	180-04-29	89-56-03	-11.504	784155.250816
69-1-203	41745.029	-68163.719	3.671	90-09-22	90-04-53	-11.523	785450.534037
69-1-205	41745.019	-68160.048	11.514	0-04-29	89-55-07	11.504	-784113.192192
69-1-206	41756.533	-68160.033	3.671	270-08-26	90-03-57	11.523	-785408.060259
						倍面積	84.532402
						面 積	42.2662010

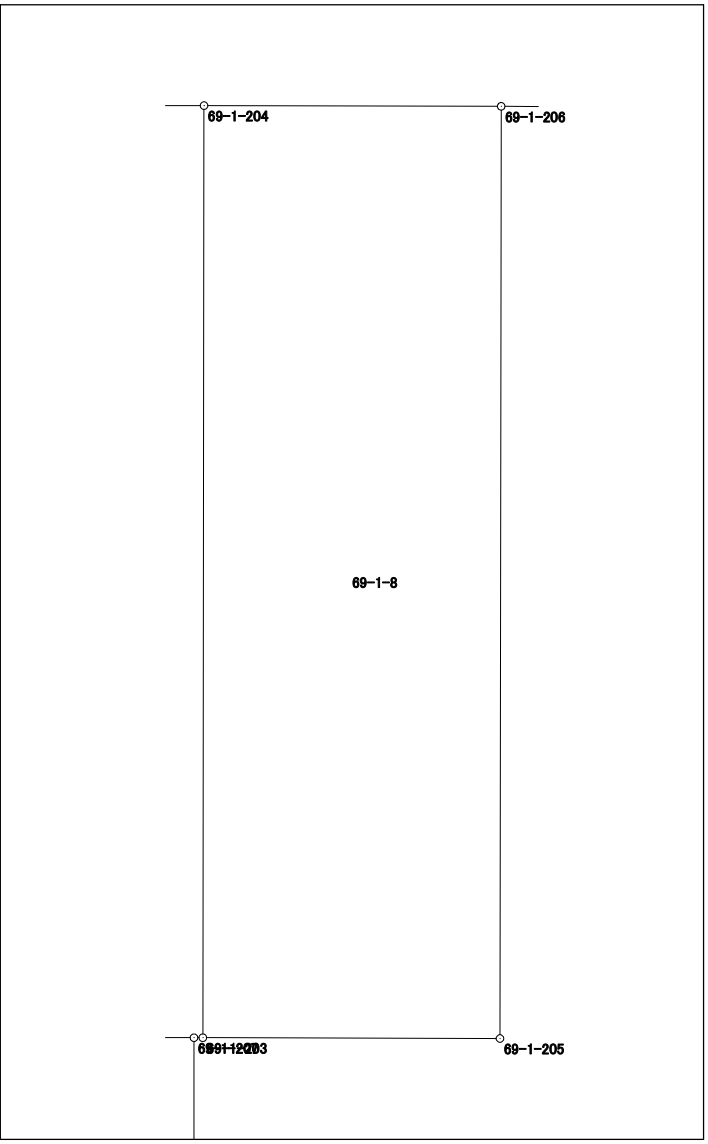

面積計算書（座標法）

世界測地系（測地成果2011）

所 在	地 番	公簿地目	現況地目	地 積	所 有 者
前橋市六供町一丁目	69-1-9			245.72 m ²	


点 名	X 座標	Y 座標	辺 長	方 向 角	測 角	DX	倍 積 (Y×DX)	
69-1-213	41730.606	-68163.845	21.400	90-09-29	90-05-17	-11.539	786542.607455	
69-1-125	41730.547	-68142.445	11.480	0-06-53	89-57-24	11.421	-778254.864345	
69-1-124	41742.027	-68142.422	21.409	270-09-28	90-02-35	11.539	-786295.407458	
69-1-240	41742.086	-68163.831	11.480	180-04-12	89-54-44	-11.421	778499.113851	
倍面積							491.449503	
面 積							245.7247515	

面積計算書（座標法）

世界測地系（測地成果2011）

所 在	地 番	公簿地目	現況地目	地 積	所 有 者
前橋市六供町一丁目	69-1-10			154.01 m ²	

点 名	X 座標	Y 座標	辺 長	方 向 角	測 角	DX	倍 積 (Y×DX)
69-1-210	41713.118	-68159.044	13.733	90-09-01	90-05-03	-9.579	652895.482476
69-1-12	41713.082	-68145.311	4.004	44-56-58	134-47-57	2.798	-190670.580178
69-1-11	41715.916	-68142.482	6.699	0-08-43	135-11-45	9.533	-649602.280906
69-1-51	41722.615	-68142.465	16.568	270-09-33	90-00-50	6.745	-459620.926425
69-1-211	41722.661	-68159.033	9.543	180-03-58	89-54-25	-9.497	647306.336401

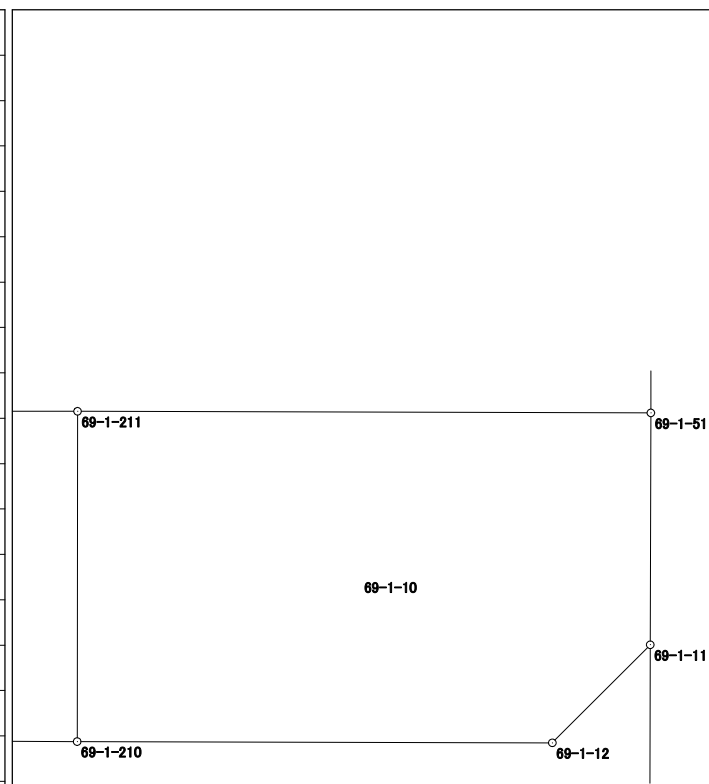


倍面積	308.031368
面 積	154.0156840

面積計算書 (座標法)

世界測地系 (測地成果2011)

所 在	地 番	公簿地目	現況地目	地 積	所 有 者
前橋市六供町一丁目	69-1-19			179.96 m ²	

点 名	X 座標	Y 座標	辺 長	方 向 角	測 角	DX	倍 積 (Y×DX)
69-1-208	41713.146	-68169.527	5.662	90-09-06	90-00-48	-31.912	2175425.945624
69-1-52	41713.131	-68163.865	9.543	0-03-58	89-54-52	9.528	-649465.305720
69-1-69	41722.674	-68163.854	7.932	0-03-54	179-59-56	17.475	-1191163.348650
69-1-213	41730.606	-68163.845	11.480	0-04-12	180-00-18	19.412	-1323196.559140
69-1-240	41742.086	-68163.831	2.943	0-03-30	179-59-18	14.423	-983126.934513
69-1-207	41745.029	-68163.828	5.622	270-08-34	90-05-04	2.957	-201560.439396
69-1-209	41745.043	-68169.450	31.897	180-08-18	89-59-44	-31.883	2173446.574350
						倍面積	359.932555
						面 積	179.9662775

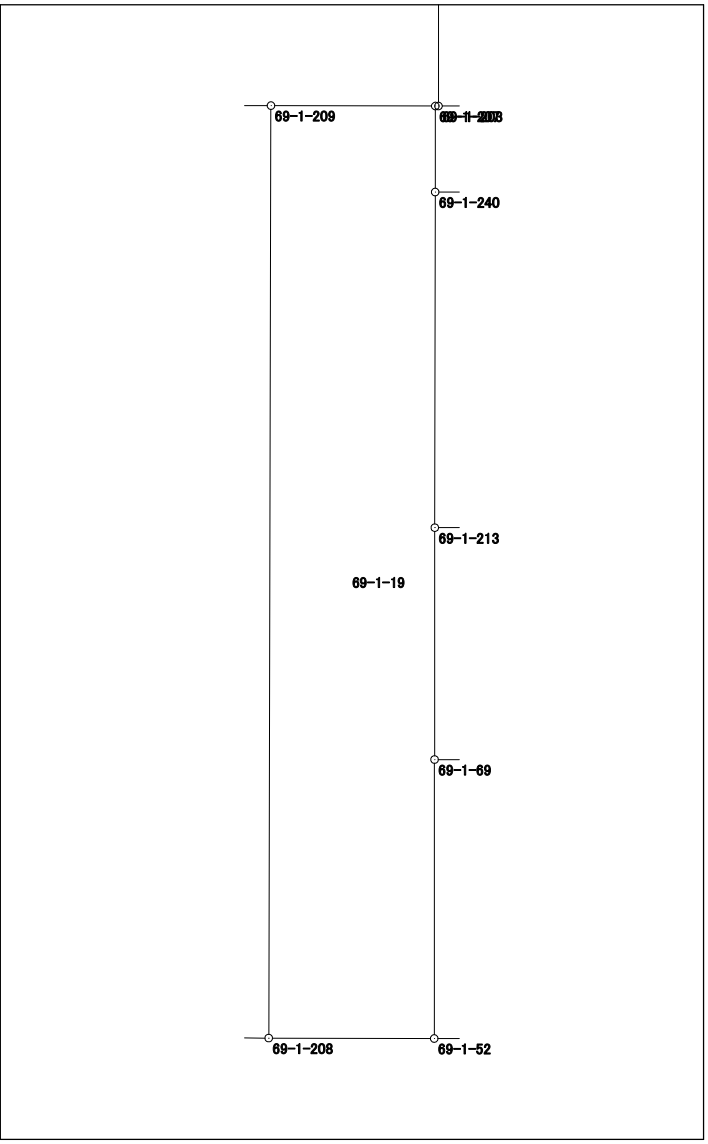


面積計算書（座標法）

世界測地系（測地成果2011）

所在	地番	公簿地目	現況地目	地積	所有者
前橋市六供町一丁目	69-1-20-2			60.23 m ²	

点名	X座標	Y座標	辺長	方向角	測角	DX	倍積 (Y×DX)
69-1-244	41713.151	-68171.415	1.888	90-09-06	90-00-55	-31.902	2174804.481330
69-1-208	41713.146	-68169.527	31.897	0-08-18	89-59-12	31.892	-2174062.555084
69-1-209	41745.043	-68169.450	1.889	270-09-06	90-00-48	31.902	-2174741.793900
69-1-245	41745.048	-68171.339	31.897	180-08-11	89-59-05	-31.892	2174120.343388

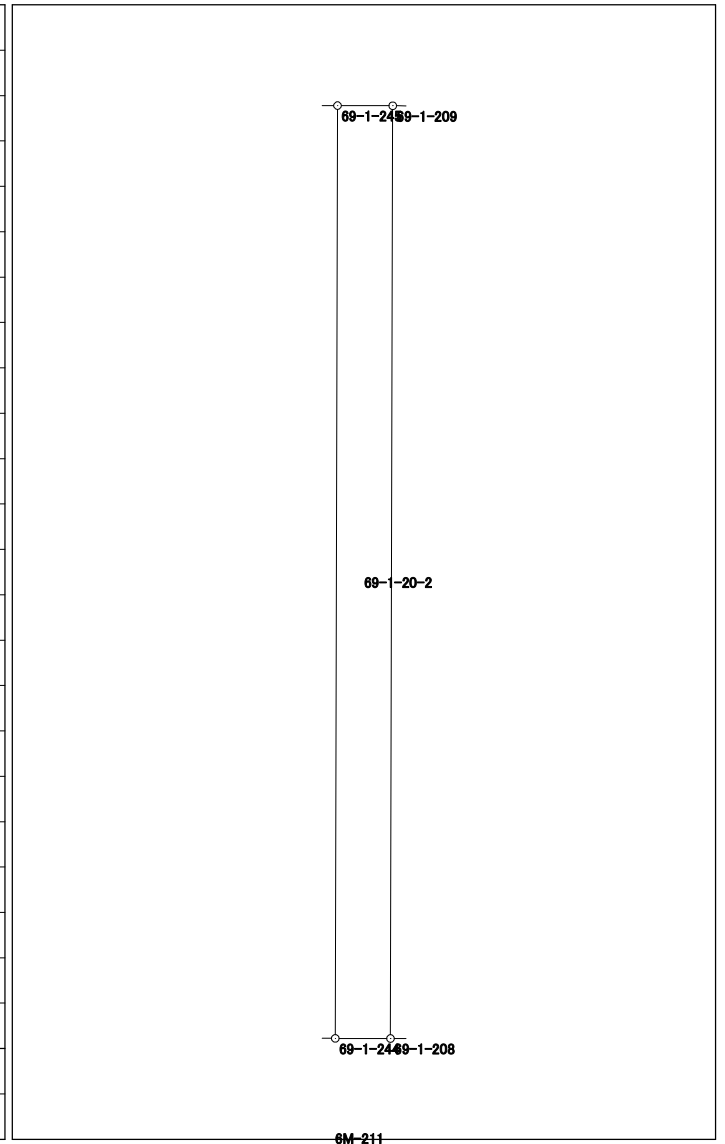


倍面積	120.475734
面積	60.2378670

面積計算書 (座標法)

世界測地系 (測地成果2011)

所 在	地 番	公簿地目	現況地目	地 積	所 有 者
前橋市六供町一丁目	69-1-21			93.95 m ²	

点 名	X 座標	Y 座標	辺 長	方 向 角	測 角	DX	倍 積 (Y×DX)
69-1-212	41745.057	-68174.927	2.946	270-09-20	90-00-56	31.905	-2175121.045935
69-1-214	41745.065	-68177.873	31.897	180-08-18	89-58-58	-31.889	2174124.192097
69-1-215	41713.168	-68177.950	2.945	90-09-20	90-01-02	-31.905	2175217.494750
69-1-241	41713.160	-68175.005	31.897	0-08-24	89-59-04	31.889	-2174032.734445

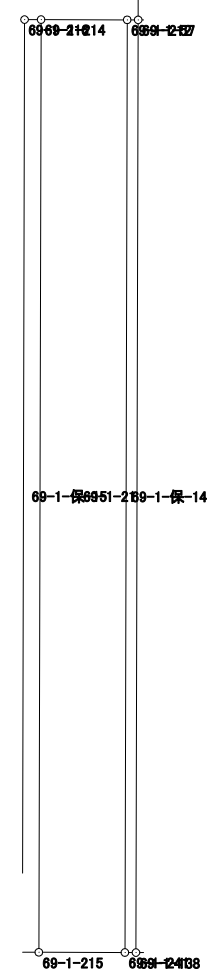

倍面積	187.906467
面 積	93.9532335


面積計算書 (座標法)

世界測地系 (測地成果2011)

所在	地番	公簿地目	現況地目	地積	所有者
前橋市六供町一丁目	69-1-23			46.10 m ²	

点名	X座標	Y座標	辺長	方向角	測角	DX	倍積 (Y×DX)
69-1-220	41745.082	-68184.909	1.446	270-09-31	90-01-13	31.900	-2175098.597100
69-1-222	41745.086	-68186.355	31.896	180-08-11	89-58-40	-31.892	2174599.233660
69-1-223	41713.190	-68186.431	1.445	90-09-31	90-01-20	-31.900	2175147.148900
69-1-221	41713.186	-68184.986	31.896	0-08-18	89-58-47	31.892	-2174555.573512

倍面積	92.211948
面積	46.1059740

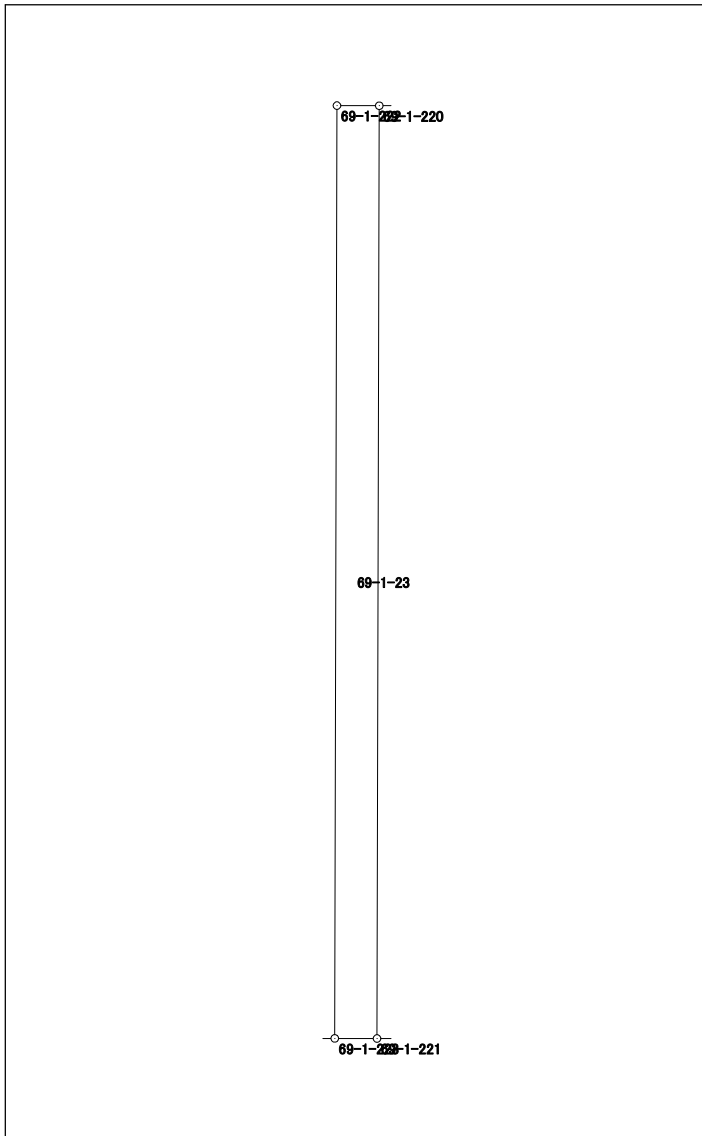


面積計算書（座標法）

世界測地系（測地成果2011）

所在	地番	公簿地目	現況地目	地積	所有者
前橋市六供町一丁目	69-1-保-1			206.00 m ²	

点名	X 座標	Y 座標	辺長	方向角	測角	DX	倍積 (Y×DX)
69-1-61	41784.005	-68174.469	12.236	0-04-30	179-48-07	14.963	-1020094.579647
69-1-42	41796.241	-68174.453	4.076	263-35-29	83-30-59	11.781	-803163.230793
69-1-224	41795.786	-68178.504	50.720	180-06-39	96-31-10	-51.175	3489034.942200
69-1-225	41745.066	-68178.602	0.164	90-00-00	89-53-21	-50.720	3458018.693440
69-1-216	41745.066	-68178.438	0.565	90-06-05	180-06-05	-0.001	68.178438
69-1-214	41745.065	-68177.873	2.946	90-09-20	180-03-15	-0.009	613.600857
69-1-212	41745.057	-68174.927	0.376	90-09-09	179-59-49	-0.009	613.574343
69-1-57	41745.056	-68174.551	11.513	0-04-29	89-55-20	11.512	-784825.431112
69-1-58	41756.569	-68174.536	4.002	359-57-25	179-52-56	15.515	-1057727.926040
69-1-59	41760.571	-68174.539	12.033	0-05-09	180-07-44	16.035	-1093178.732865
69-1-60	41772.604	-68174.521	2.988	0-17-15	180-12-06	15.021	-1024049.479941
69-1-233	41775.592	-68174.506	0.809	0-08-30	179-51-15	3.797	-258858.599282
69-1-235	41776.401	-68174.504	4.877	0-15-30	180-07-00	5.686	-387640.229744
69-1-237	41781.278	-68174.482	2.727	0-16-23	180-00-53	7.604	-518398.761128
						倍面積	412.018726
						面積	206.0093630

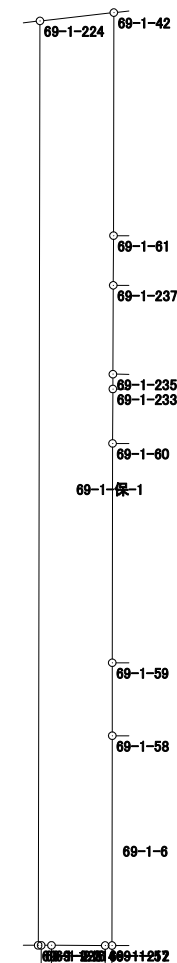


面積計算書（座標法）

世界測地系（測地成果2011）

所 在	地 番	公簿地目	現況地目	地 積	所 有 者
前橋市六供町一丁目	69-1-保-2			51.00 m ²	

点 名	X 座標	Y 座標	辺 長	方 向 角	測 角	DX	倍 積 (Y×DX)
69-1-42	41796.241	-68174.453	12.236	180-04-30	96-38-37	-12.461	849521.858833
69-1-61	41784.005	-68174.469	4.123	90-10-50	90-06-20	-12.249	835069.070781
69-1-226	41783.992	-68170.346	12.309	0-04-28	89-53-38	12.296	-838222.574416
69-1-227	41796.301	-68170.330	2.175	274-21-01	94-16-33	12.474	-850356.696420
69-1-2	41796.466	-68172.499	1.967	263-25-53	169-04-52	-0.060	4090.349940
						倍面積	102.008718
						面 積	51.0043590

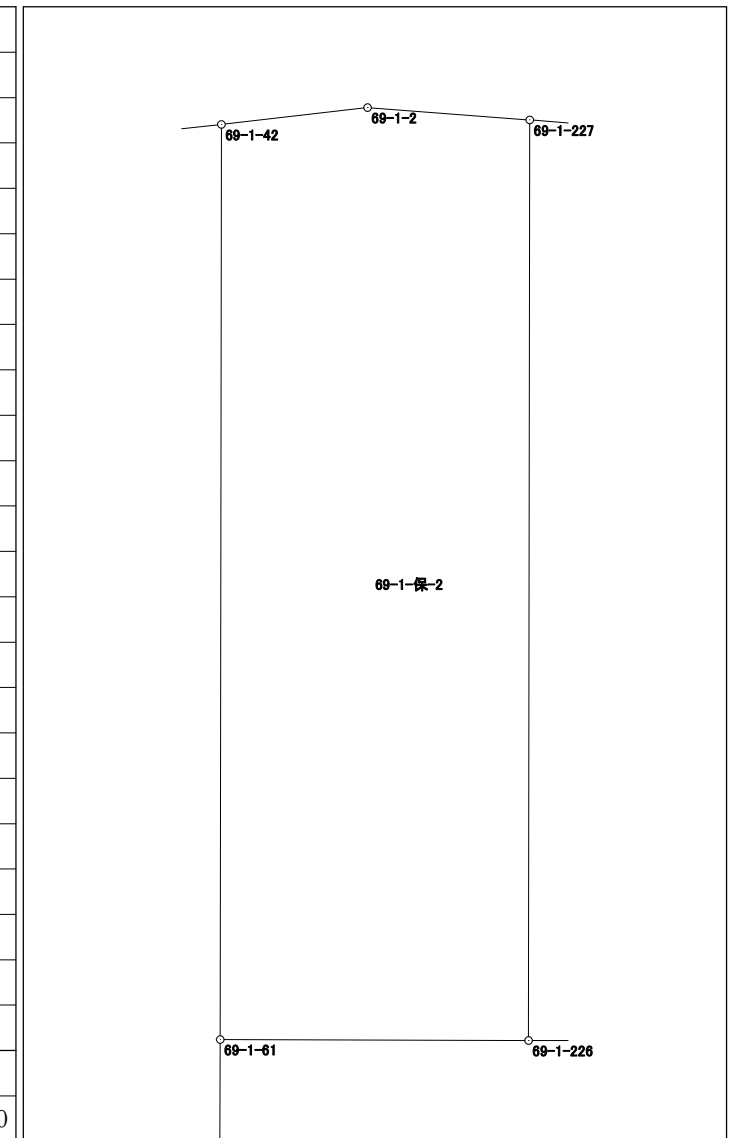

面積計算書 (座標法)

世界測地系 (測地成果2011)

所在	地番	公簿地目	現況地目	地積	所有者
前橋市六供町一丁目	69-1-保-4			46.00 m ²	


点名	X座標	Y座標	辺長	方向角	測角	DX	倍積 (Y×DX)		
69-1-60	41772.604	-68174.521	12.033	180-05-09	89-58-51	-12.026	819866.789546		
69-1-59	41760.571	-68174.539	3.823	90-09-00	90-03-51	-12.043	821025.973177		
69-1-228	41760.561	-68170.716	12.036	0-05-08	89-56-08	12.026	-819821.030616		
69-1-229	41772.597	-68170.698	3.823	270-06-18	90-01-10	12.043	-820979.716014		
							倍面積		92.016093
							面積		46.0080465

面積計算書（座標法）

世界測地系（測地成果2011）

所在	地番	公簿地目	現況地目	地積	所有者
前橋市六供町一丁目	69-1-保-10			46.00 m ²	

点名	X座標	Y座標	辺長	方向角	測角	DX	倍積 (Y×DX)
69-1-52	41713.131	-68163.865	4.821	90-09-16	90-05-18	-9.556	651373.893940
69-1-210	41713.118	-68159.044	9.543	0-03-58	89-54-42	9.530	-649555.689320
69-1-211	41722.661	-68159.033	4.821	270-09-16	90-05-18	9.556	-651327.719348
69-1-69	41722.674	-68163.854	9.543	180-03-58	89-54-42	-9.530	649601.528620

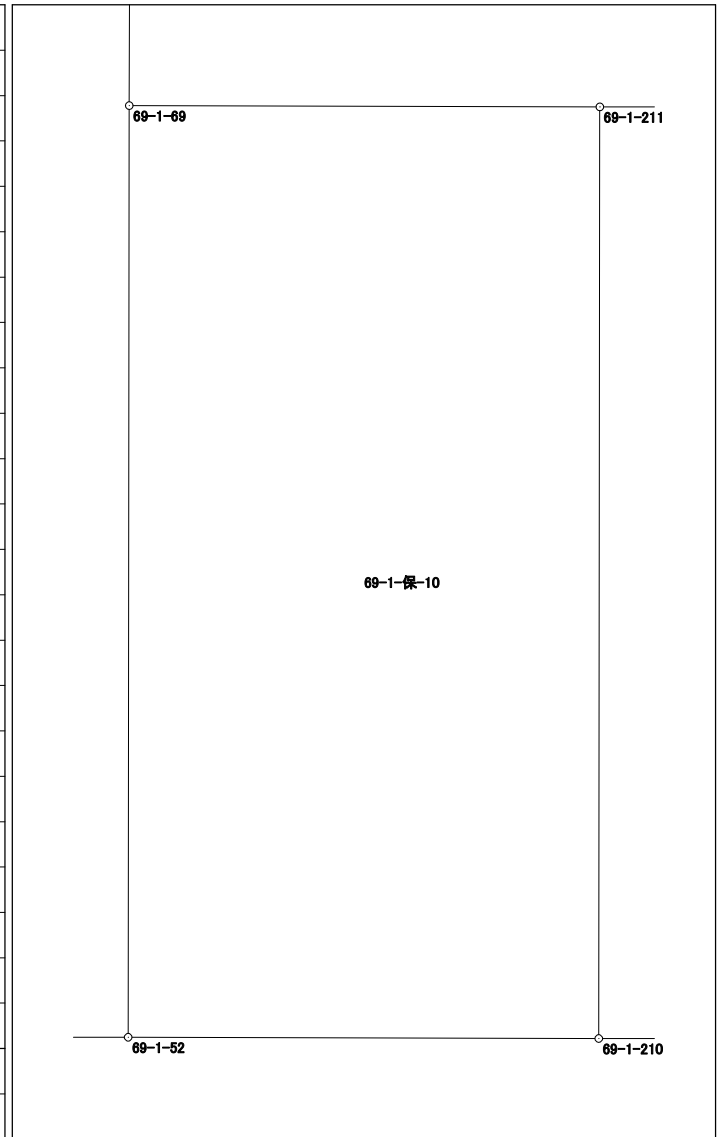

倍面積	92.013892
面積	46.0069460

面積計算書（座標法）

世界測地系（測地成果2011）

所 在	地 番	公簿地目	現況地目	地 積	所 有 者
前橋市六供町一丁目	69-1-保-11			74.00 m ²	


点 名	X 座標	Y 座標	辺 長	方 向 角	測 角	DX	倍 積 (Y×DX)	
69-1-61	41784.005	-68174.469	2.727	180-16-23	90-05-33	-2.714	185025.508866	
69-1-237	41781.278	-68174.482	32.117	90-06-19	89-49-56	-2.786	189934.106852	
69-1-236	41781.219	-68142.365	1.979	0-10-25	90-04-06	1.920	-130833.340800	
69-1-239	41783.198	-68142.359	17.973	270-06-19	89-55-54	2.012	-137102.426308	
69-1-238	41783.231	-68160.332	0.731	0-09-24	270-03-05	0.764	-52074.493648	
69-1-62	41783.962	-68160.330	10.016	270-10-18	90-00-54	0.761	-51870.011130	
69-1-226	41783.992	-68170.346	4.123	270-10-50	180-00-32	0.043	-2931.324878	
倍面積							148.018954	
面 積							74.0094770	

面積計算書（座標法）

世界測地系（測地成果2011）

所在	地番	公簿地目	現況地目	地積	所有者
前橋市六供町一丁目	69-1-保-12			26.00 m ²	

点名	X座標	Y座標	辺長	方向角	測角	DX	倍積 (Y×DX)
69-1-232	41775.533	-68142.381	0.810	0-08-29	90-02-10	0.751	-51174.928131
69-1-234	41776.343	-68142.379	32.125	270-06-12	89-57-43	0.868	-59147.584972
69-1-235	41776.401	-68174.504	0.809	180-08-30	90-02-18	-0.751	51199.052504
69-1-233	41775.592	-68174.506	32.125	90-06-19	89-57-49	-0.868	59175.471208
倍面積						52.010609	
面積						26.0053045	

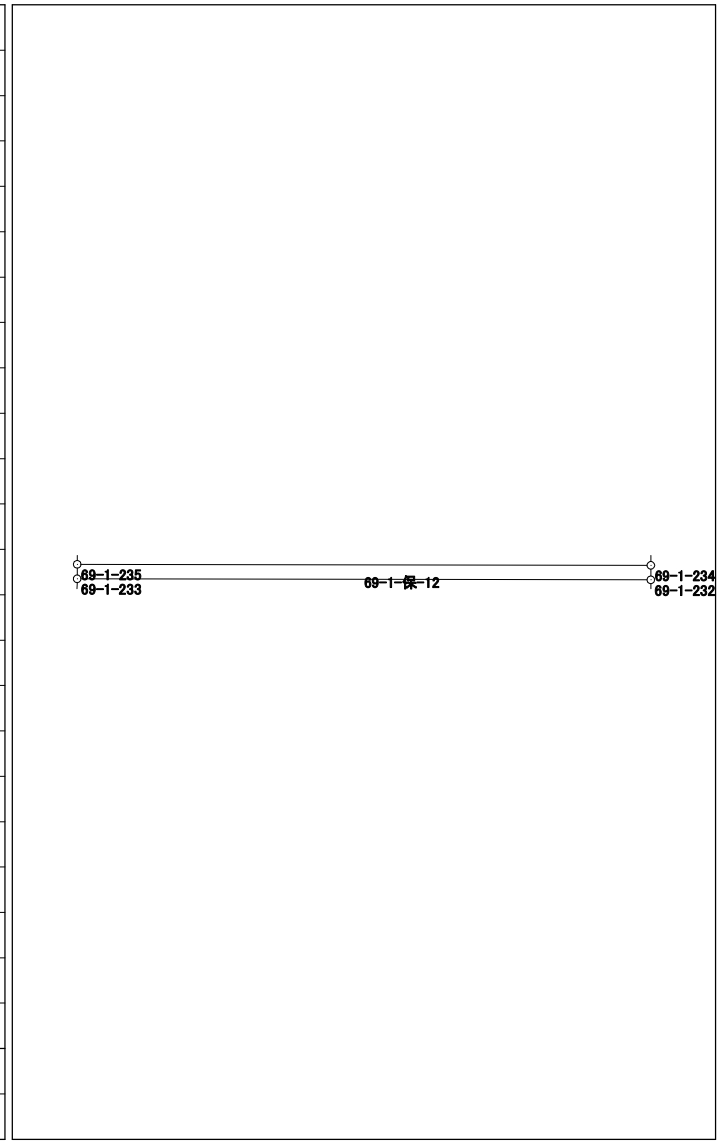

面積計算書 (座標法)

世界測地系 (測地成果2011)

所在	地番	公簿地目	現況地目	地積	所有者
前橋市六供町一丁目	69-1-保-15			18.00 m ²	

点名	X座標	Y座標	辺長	方向角	測角	DX	倍積 (Y×DX)
69-1-214	41745.065	-68177.873	0.565	270-06-05	89-57-47	31.898	-2174737.792954
69-1-216	41745.066	-68178.438	31.897	180-08-11	90-02-06	-31.896	2174619.458448
69-1-217	41713.169	-68178.514	0.564	90-06-06	89-57-55	-31.898	2174758.239572
69-1-215	41713.168	-68177.950	31.897	0-08-18	90-02-12	31.896	-2174603.893200
						倍面積	36.011866
						面積	18.0059330

