



70-1 街区
 70-2 街区
 70-3 街区

画地出来形確認図

(401.50 m²)
 (0.94 m²)
 (0.80 m²)

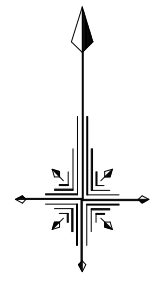

S=1/500

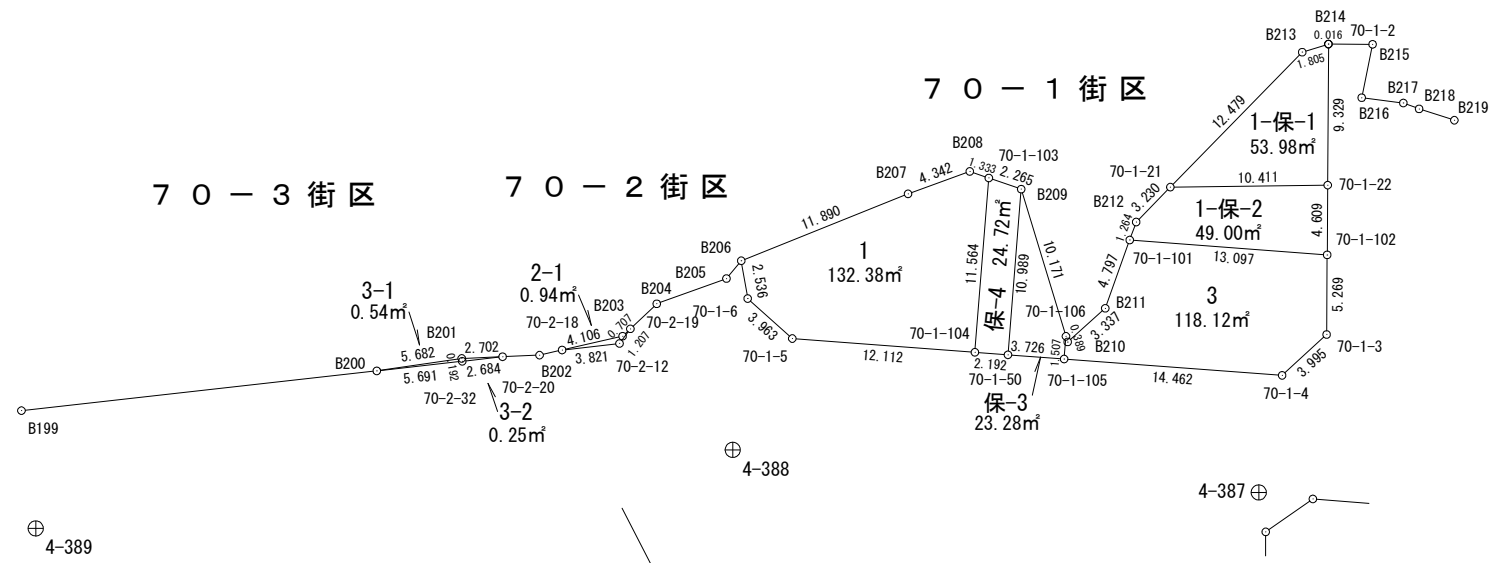

拡大図1/250

