



72-1 街区
72-2 街区

画地出来形確認図

(1401.56m²)
(2861.54m²)

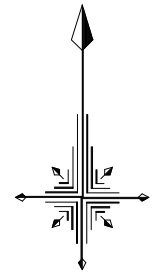

S=1/500

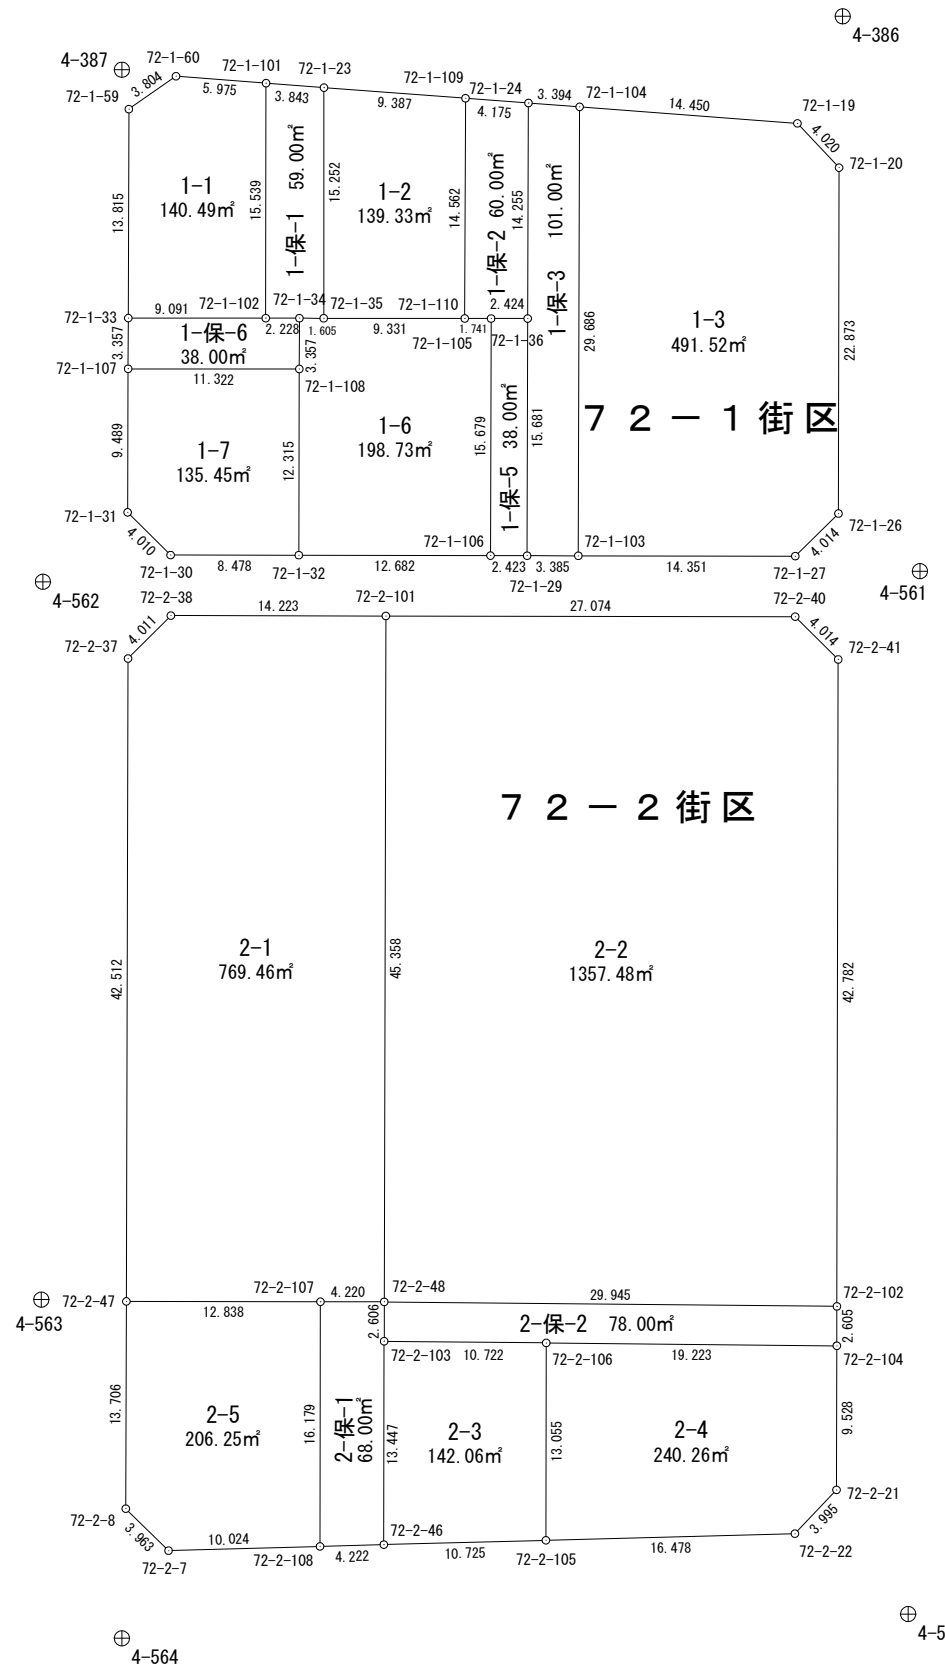


面積計算書 (座標法)

世界測地系 (測地成果2011)

所在	地番	公簿地目	現況地目	地積	所有者
前橋市六供町一丁目	72-2-2			1357.48 m ²	

点名	X座標	Y座標	辺長	方向角	測角	DX	倍積 (Y×DX)
72-2-48	41712.467	-68119.437	29.945	90-34-27	90-26-16	-45.658	3110197.254546
72-2-102	41712.167	-68089.494	42.782	0-06-55	89-32-28	42.482	-2892577.884108
72-2-41	41754.949	-68089.408	4.014	314-49-06	134-42-11	45.611	-3105625.988288
72-2-40	41757.778	-68092.255	27.074	270-05-58	135-16-52	2.876	-195833.325380
72-2-101	41757.825	-68119.329	45.358	180-08-11	90-02-13	-45.311	3086554.916319
						倍面積	2714.973089
						面積	1357.4865445

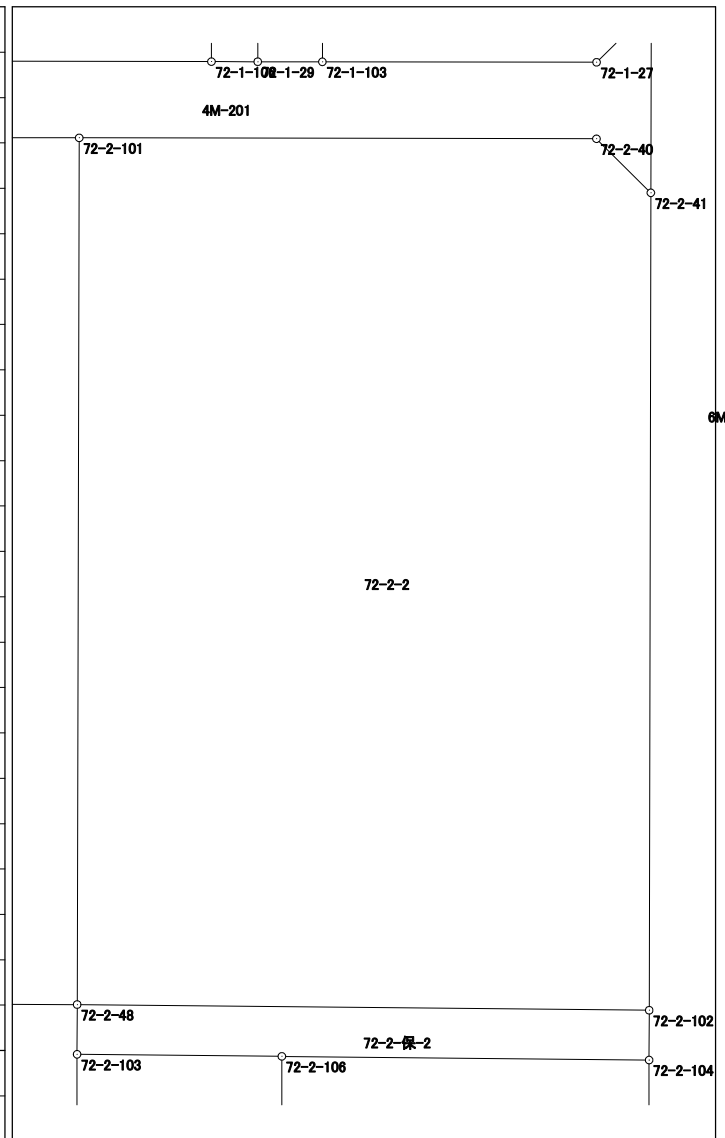

面積計算書（座標法）

世界測地系（測地成果2011）

所 在	地 番	公簿地目	現況地目	地 積	所 有 者
前橋市六供町一丁目	72-2-保-1			68.00 m ²	

点 名	X 座標	Y 座標	辺 長	方 向 角	測 角	DX	倍 積 (Y×DX)
72-2-46	41696.414	-68119.465	13.447	0-05-53	91-41-59	13.565	-924040.542725
72-2-103	41709.861	-68119.442	2.606	0-06-36	180-00-43	16.053	-1093521.402426
72-2-48	41712.467	-68119.437	4.220	270-06-31	89-59-55	2.614	-178064.208318
72-2-107	41712.475	-68123.657	16.179	180-05-57	89-59-26	-16.171	1101627.657347
72-2-108	41696.296	-68123.685	4.222	88-23-54	88-17-57	-16.061	1094134.504785
倍面積						136.008663	
面 積						68.0043315	

