



77街区 画地出来形確認図 (8743.75m²)

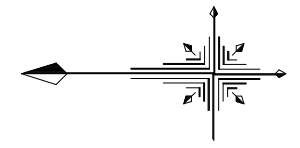

S=1/500

3. 4. 32 本町六供線

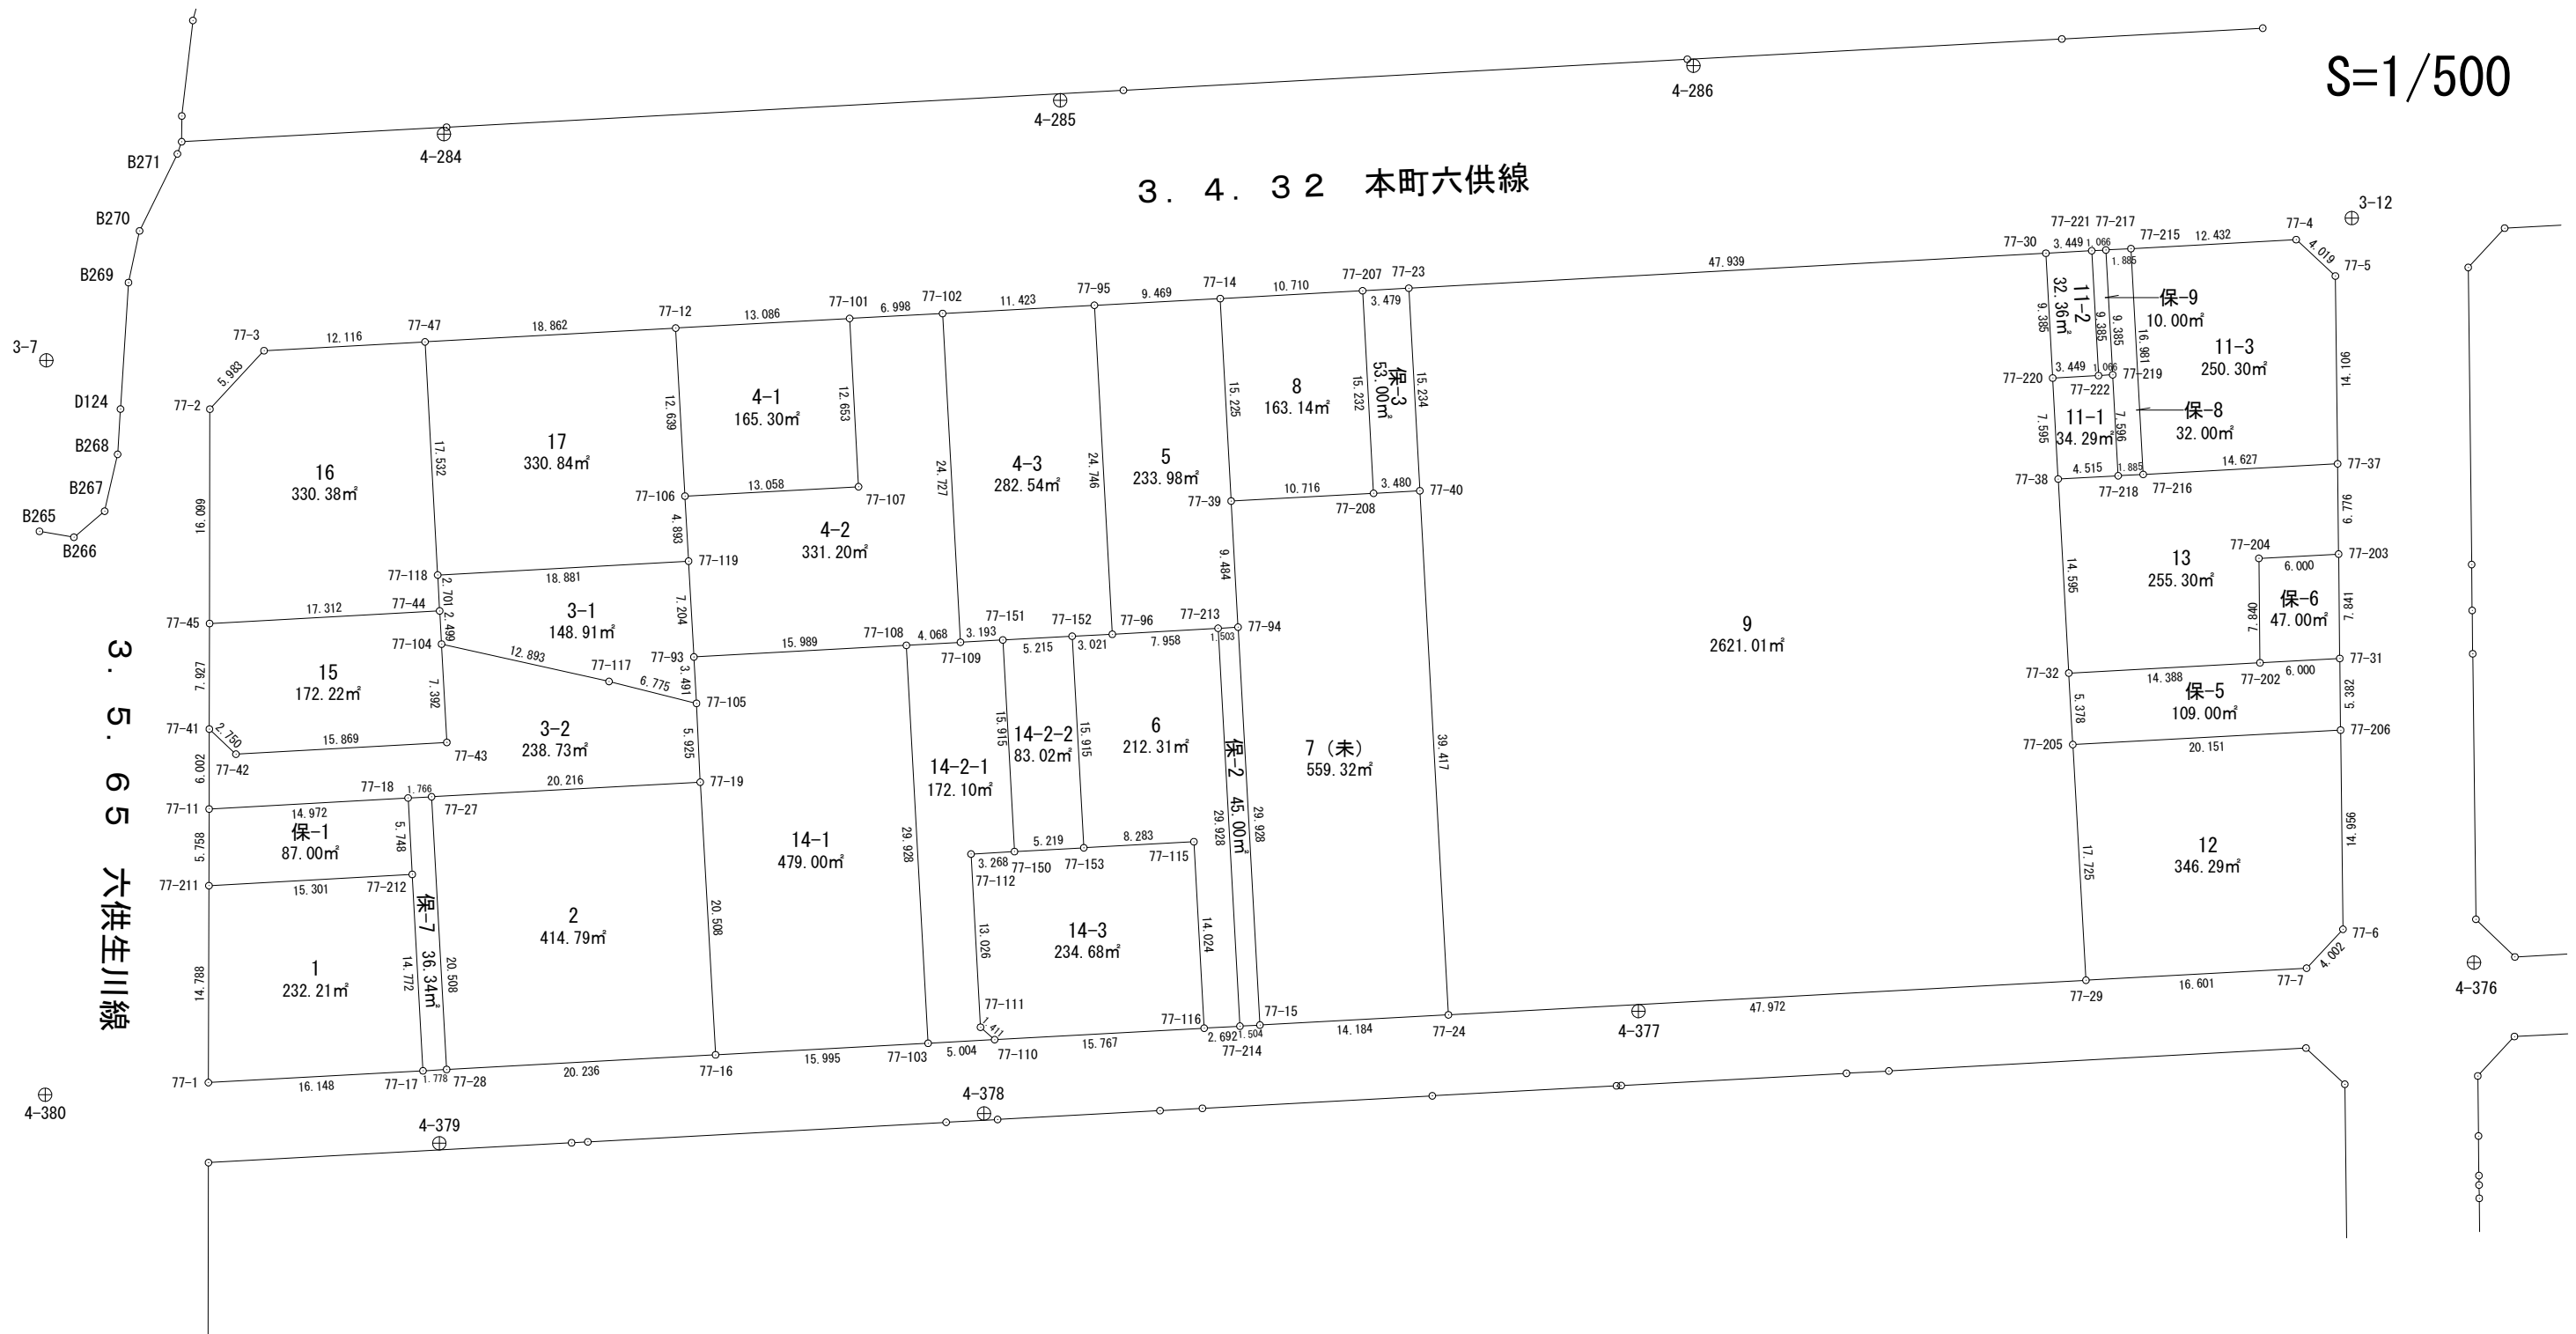

3. 5. 65 六供生川線

4-380

4-376

4-378

4-377

4-286

4-285

4-284

3-12

3-7

B271

B270

B269

D124

B268

B267

B265

B266

3. 5. 65 六供生川線

面積計算書（座標法）

世界測地系（測地成果2011）

所在	地番	公簿地目	現況地目	地積	所有者
前橋市六供町二丁目	77-11-1			34.29 m ²	


点名	X座標	Y座標	辺長	方向角	測角	DX	倍積 (Y×DX)	
77-218	41488.111	-67887.930	7.596	86-53-00	89-59-39	-4.095	278001.073350	
77-219	41488.524	-67880.345	1.066	356-52-47	89-59-47	1.477	-100259.269565	
77-222	41489.588	-67880.403	3.449	356-52-32	179-59-45	4.508	-306004.856724	
77-220	41493.032	-67880.591	7.595	266-52-59	90-00-27	3.031	-205746.071321	
77-38	41492.619	-67888.175	4.515	176-53-21	90-00-22	-4.921	334077.709175	
							倍面積	
							面積	34.2924575

面積計算書（座標法）

世界測地系（測地成果2011）

所 在	地 番	公簿地目	現況地目	地 積	所 有 者
前橋市六供町二丁目	77-12			346.29 m ²	

点 名	X 座標	Y 座標	辺 長	方 向 角	測 角	DX	倍 積 (Y×DX)
77-205	41491.522	-67908.118	17.725	266-47-53	89-53-04	19.132	-1299218.113576
77-29	41490.532	-67925.815	16.601	176-52-30	90-04-37	-17.566	1193184.866290
77-7	41473.956	-67924.910	4.002	133-05-46	136-13-16	-19.310	1311630.012100
77-6	41471.222	-67921.988	14.956	89-19-05	136-13-19	-2.556	173608.601328
77-206	41471.400	-67907.033	20.151	356-54-49	87-35-44	20.300	-1378512.769900
						倍面積	692.596242
						面 積	346.2981210

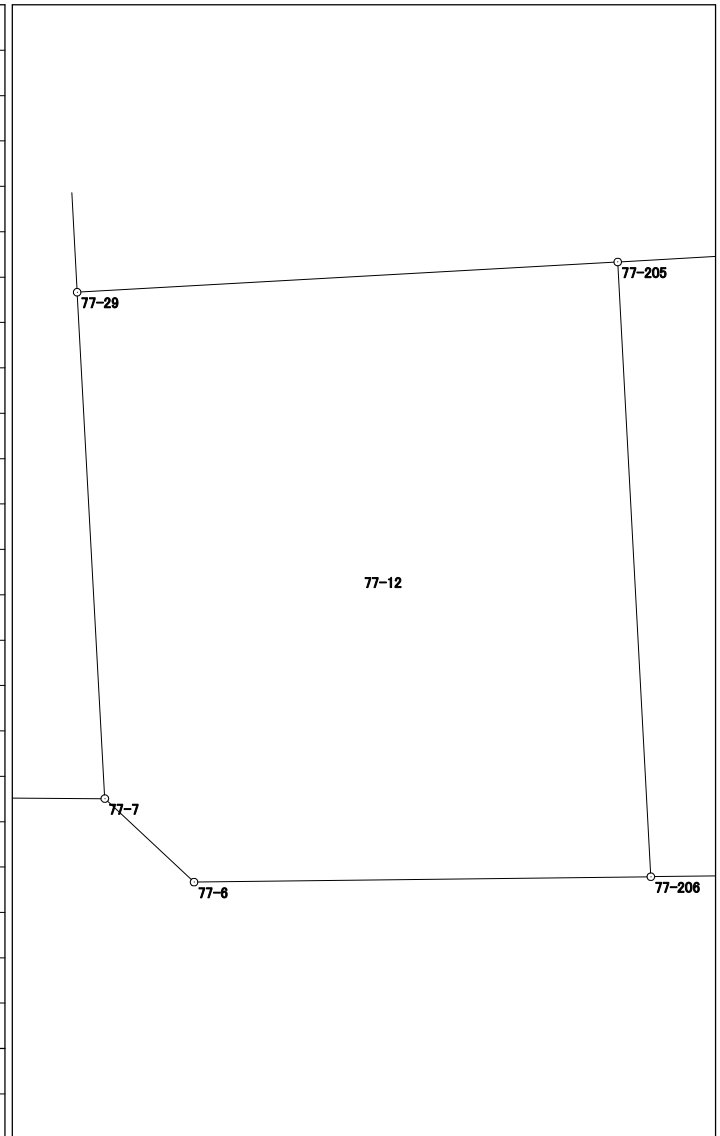

面積計算書 (座標法)

世界測地系 (測地成果2011)

所 在	地 番	公簿地目	現況地目	地 積	所 有 者
前橋市六供町二丁目	77-13			255.30 m ²	


点 名	X 座標	Y 座標	辺 長	方 向 角	測 角	DX	倍 積 (Y×DX)	
77-32	41491.822	-67902.748	14.388	176-54-59	90-02-48	-15.164	1029677.270672	
77-202	41477.455	-67901.974	7.840	89-22-17	92-27-18	-14.281	969708.090694	
77-204	41477.541	-67894.134	6.000	176-54-16	267-31-59	-5.905	400914.861270	
77-203	41471.550	-67893.810	6.776	89-22-27	92-28-11	-5.917	401727.673770	
77-37	41471.624	-67887.034	14.627	356-53-17	87-30-50	14.679	-996513.772086	
77-216	41486.229	-67887.828	1.885	356-53-52	180-00-35	16.487	-1119266.620236	
77-218	41488.111	-67887.930	4.515	356-53-21	179-59-29	6.390	-433803.872700	
77-38	41492.619	-67888.175	14.595	266-52-11	89-58-50	3.711	-251933.017425	
						倍面積	510.613959	
						面 積	255.3069795	

面積計算書 (座標法)

世界測地系 (測地成果2011)

所在	地番	公簿地目	現況地目	地積	所有者
前橋市六供町二丁目	77-14-1			479.00 m ²	

点名	X座標	Y座標	辺長	方向角	測角	DX	倍積 (Y×DX)
77-93	41595.125	-67901.537	3.491	266-46-52	89-54-14	15.769	-1070739.336953
77-105	41594.929	-67905.022	5.925	267-17-28	180-30-36	-0.476	32322.790472
77-19	41594.649	-67910.940	20.508	266-46-58	179-29-30	-1.431	97180.555140
77-16	41593.498	-67931.416	15.995	176-53-34	90-06-36	-17.122	1163121.704752
77-103	41577.527	-67930.549	29.928	86-52-20	89-58-46	-14.338	973988.211562
77-108	41579.160	-67900.666	15.989	356-52-38	90-00-18	17.598	-1194915.920268

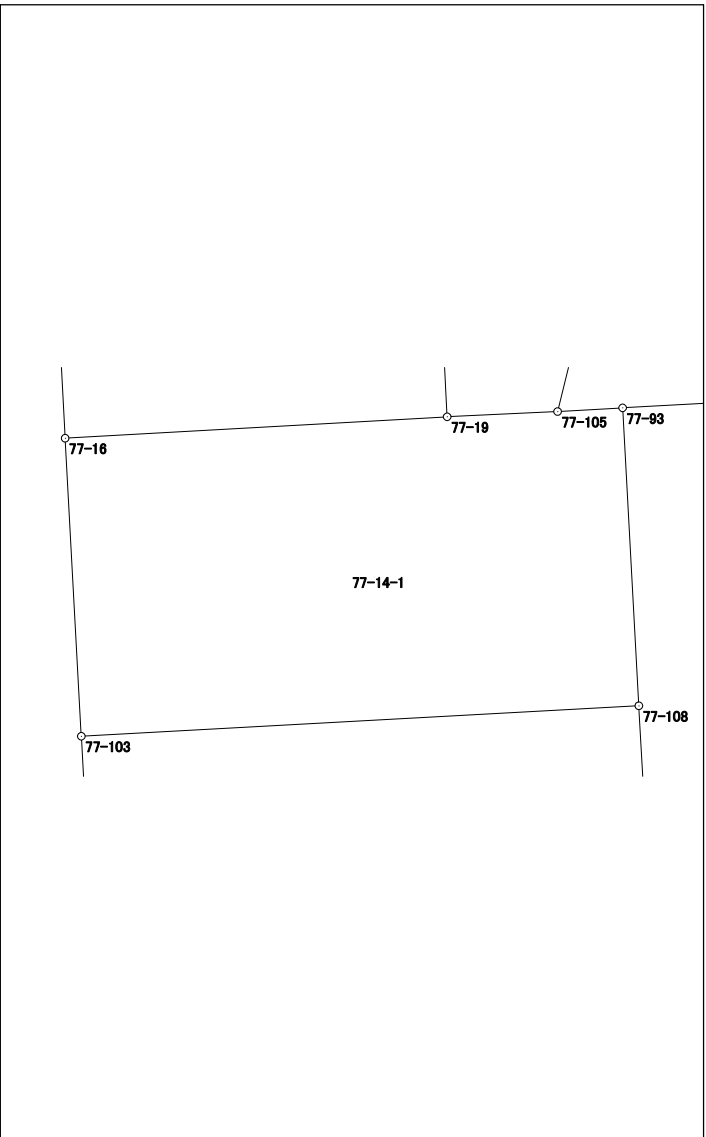


倍面積	958.004705
面積	479.0023525

面積計算書 (座標法)

世界測地系 (測地成果2011)

所在	地番	公簿地目	現況地目	地積	所有者
前橋市六供町二丁目	77-14-2-1			172.10 m ²	

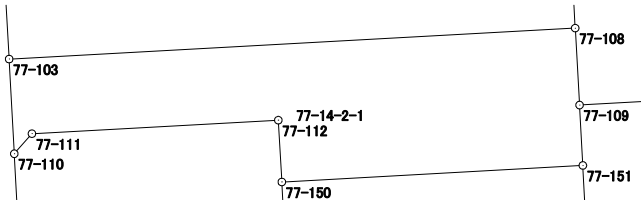
点名	X座標	Y座標	辺長	方向角	測角	DX	倍積 (Y×DX)		
77-103	41577.527	-67930.549	5.004	176-53-45	90-01-25	-6.630	450379.539870		
77-110	41572.530	-67930.278	1.411	41-19-24	44-25-39	-3.937	267441.504486		
77-111	41573.590	-67929.346	13.026	86-52-00	225-32-36	1.772	-120370.801112		
77-112	41574.302	-67916.339	3.268	176-44-15	269-52-15	-2.551	173254.580789		
77-150	41571.039	-67916.153	15.915	86-51-33	90-07-18	-2.391	162387.521823		
77-151	41571.911	-67900.262	3.193	356-54-42	90-03-09	4.060	-275675.063720		
77-109	41575.099	-67900.434	4.068	356-43-49	179-49-07	7.249	-492210.246066		
77-108	41579.160	-67900.666	29.928	266-52-20	90-08-31	2.428	-164862.817048		
							倍面積	344.219022	
							面積	172.1095110	

面積計算書 (座標法)

世界測地系 (測地成果2011)

所 在	地 番	公簿地目	現況地目	地 積	所 有 者
前橋市六供町二丁目	77-14-2-2			83.02 m ²	

点 名	X 座 標	Y 座 標	辺 長	方 向 角	測 角	D X	倍 積 (Y×DX)
77-150	41571.039	-67916.153	5.219	176-52-50	90-01-17	-6.083	413133.958699
77-153	41565.828	-67915.869	15.915	86-50-41	89-57-51	-4.335	294415.292115
77-152	41566.704	-67899.978	5.215	356-52-41	90-02-00	6.083	-413035.566174
77-151	41571.911	-67900.262	15.915	266-51-33	89-58-52	4.335	-294347.635770
						倍面積	166.048870
						面 積	83.0244350

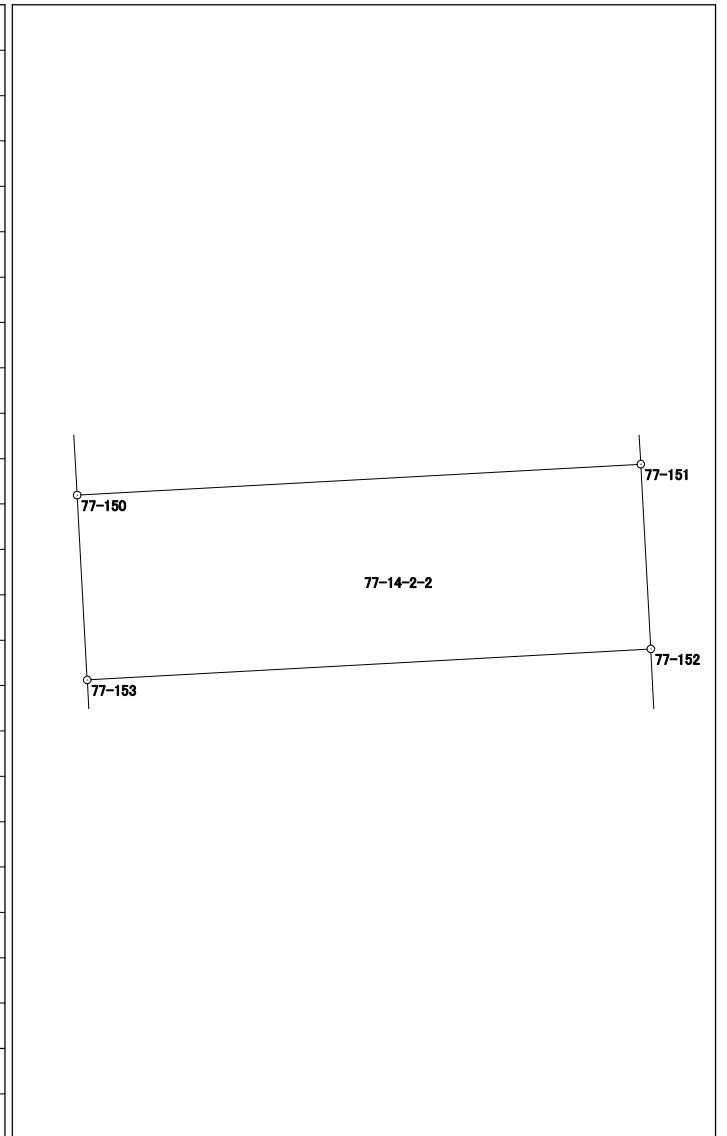


面積計算書（座標法）

世界測地系（測地成果2011）

所 在	地 番	公簿地目	現況地目	地 積	所 有 者
前橋市六供町二丁目	77-14-3			234.68 m ²	

点 名	X 座標	Y 座標	辺 長	方 向 角	測 角	DX	倍 積 (Y×DX)
77-110	41572.530	-67930.278	15.767	176-52-24	135-33-00	-16.804	1141500.391512
77-116	41556.786	-67929.418	14.024	86-50-55	89-58-31	-14.973	1017107.175714
77-115	41557.557	-67915.415	8.283	356-51-29	90-00-34	9.042	-614091.182430
77-153	41565.828	-67915.869	5.219	356-52-50	180-01-21	13.482	-915641.745858
77-150	41571.039	-67916.153	3.268	356-44-15	179-51-25	8.474	-575521.480522
77-112	41574.302	-67916.339	13.026	266-52-00	90-07-45	2.551	-173254.580789
77-111	41573.590	-67929.346	1.411	221-19-24	134-27-24	-1.772	120370.801112
						倍面積	469.378739
						面 積	234.6893695

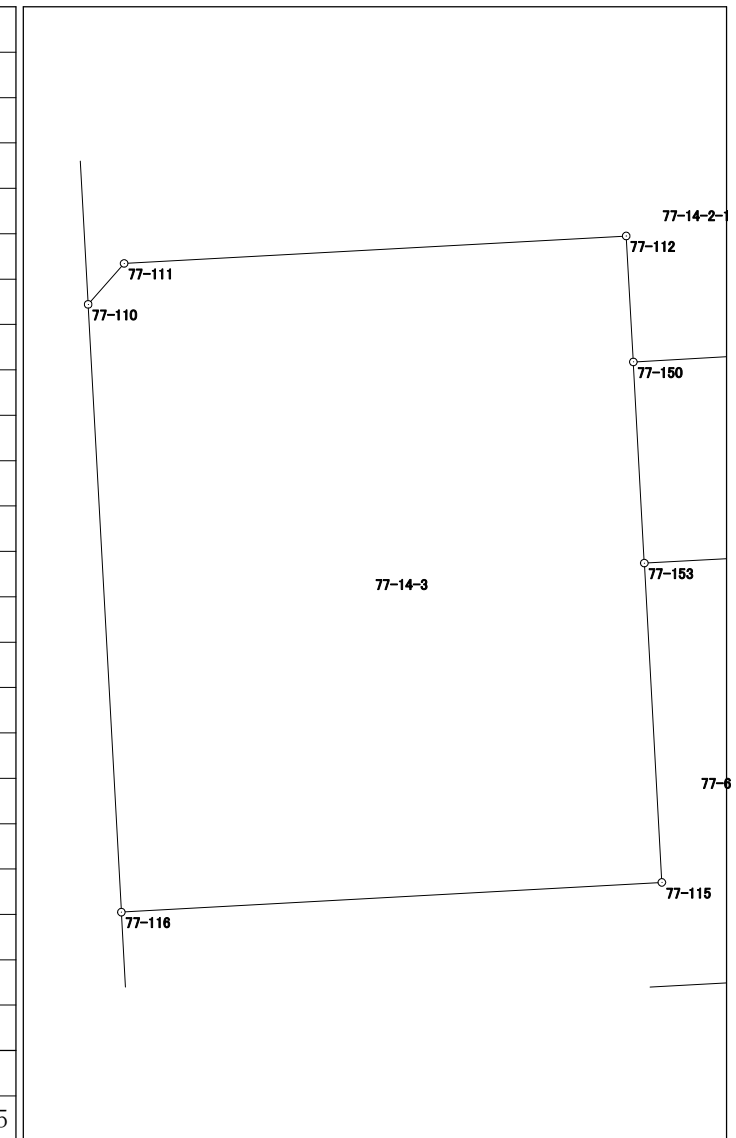


面積計算書 (座標法)

世界測地系 (測地成果2011)

所 在	地 番	公簿地目	現況地目	地 積	所 有 者
前橋市六供町二丁目	77-15			172.22 m ²	


点 名	X 座標	Y 座標	辺 長	方 向 角	測 角	DX	倍 積 (Y×DX)
77-41	41631.534	-67906.953	2.750	223-19-14	133-10-34	-1.981	134523.673893
77-42	41629.533	-67908.840	15.869	176-48-11	133-28-57	-17.845	1211833.249800
77-43	41613.689	-67907.955	7.392	86-55-44	90-07-33	-15.448	1049042.088840
77-104	41614.085	-67900.574	2.499	86-43-11	179-47-27	0.539	-36598.409386
77-44	41614.228	-67898.079	17.312	356-51-51	90-08-40	17.429	-1183395.618891
77-45	41631.514	-67899.026	7.927	270-08-40	93-16-49	17.306	-1175060.543956
倍面積							344.440300
面 積							172.2201500

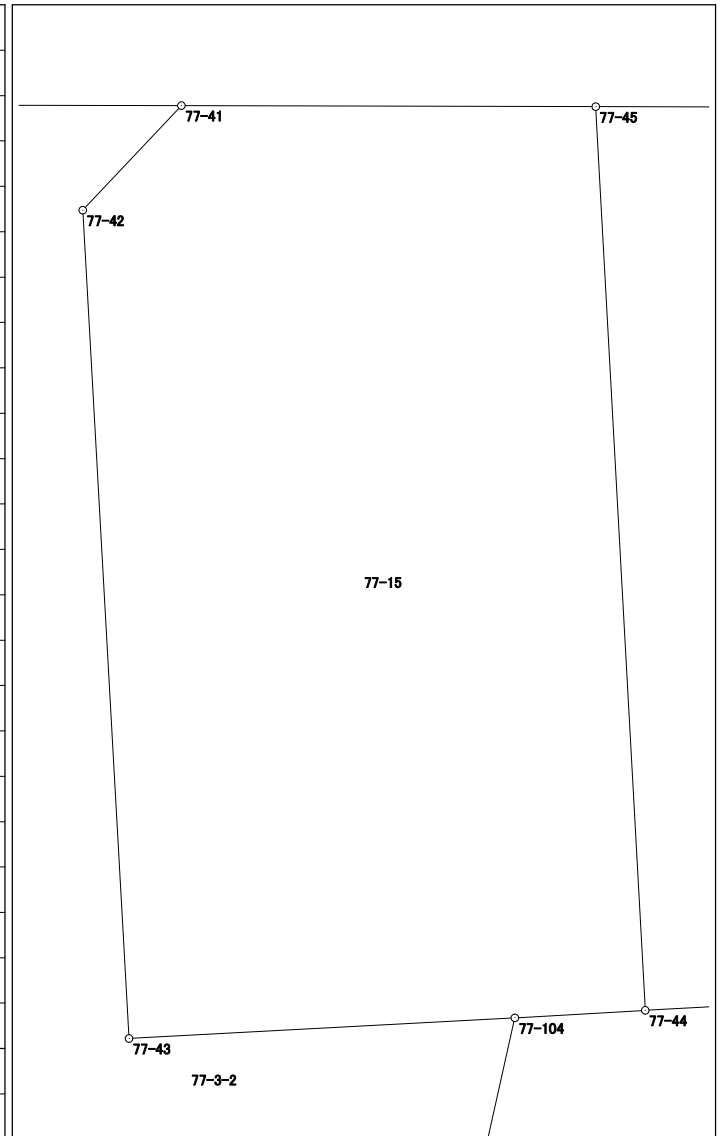

面積計算書（座標法）

所 在	地 番	公簿地目	現況地目	地 積	所 有 者
前橋市六供町二丁目	77-16			330.38 m ²	

点 名	X 座標	Y 座標	辺 長	方 向 角	測 角	DX	倍 積 (Y×DX)
77-45	41631.514	-67899.026	17.312	176-51-51	86-46-44	-17.262	1172072.986812
77-44	41614.228	-67898.079	2.701	86-52-49	90-00-58	-17.139	1163705.175981
77-118	41614.375	-67895.382	17.532	86-53-26	180-00-37	1.098	-74549.129436
77-47	41615.326	-67877.876	12.116	356-52-04	89-58-38	13.049	-885738.403924
77-3	41627.424	-67878.538	5.983	312-48-44	135-56-40	16.164	-1097188.688232
77-2	41631.490	-67882.927	16.099	270-05-07	137-16-23	4.090	-277641.171430
倍面積							660.769771
面 積							330.3848855

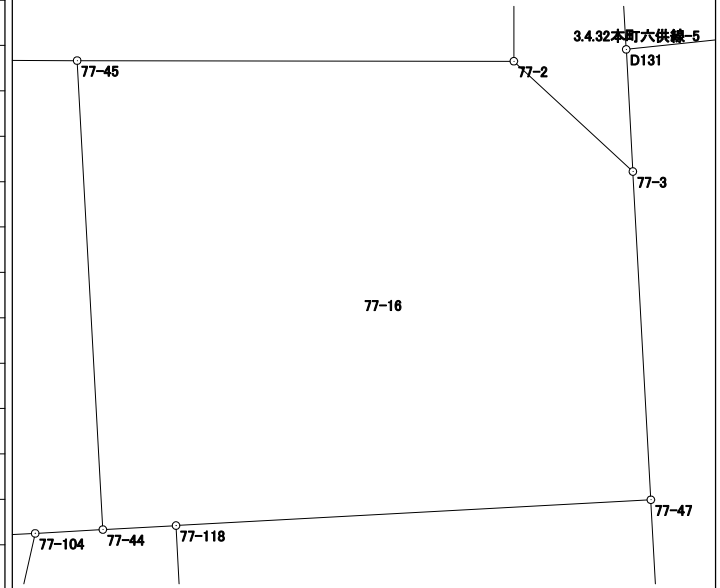


面積計算書 (座標法)

世界測地系 (測地成果2011)

所在	地番	公簿地目	現況地目	地積	所有者
前橋市六供町二丁目	77-17			330.84 m ²	

点名	X座標	Y座標	辺長	方向角	測角	DX	倍積 (Y×DX)
77-47	41615.326	-67877.876	17.532	266-53-26	90-02-32	17.882	-1213792.178632
77-118	41614.375	-67895.382	18.881	176-50-54	89-57-28	-19.803	1344532.249746
77-119	41595.523	-67894.344	4.893	86-49-29	89-58-35	-18.581	1261544.805864
77-106	41595.794	-67889.459	12.639	86-49-47	180-00-18	0.970	-65852.775230
77-12	41596.493	-67876.839	18.862	356-50-54	90-01-07	19.532	-1325770.419348

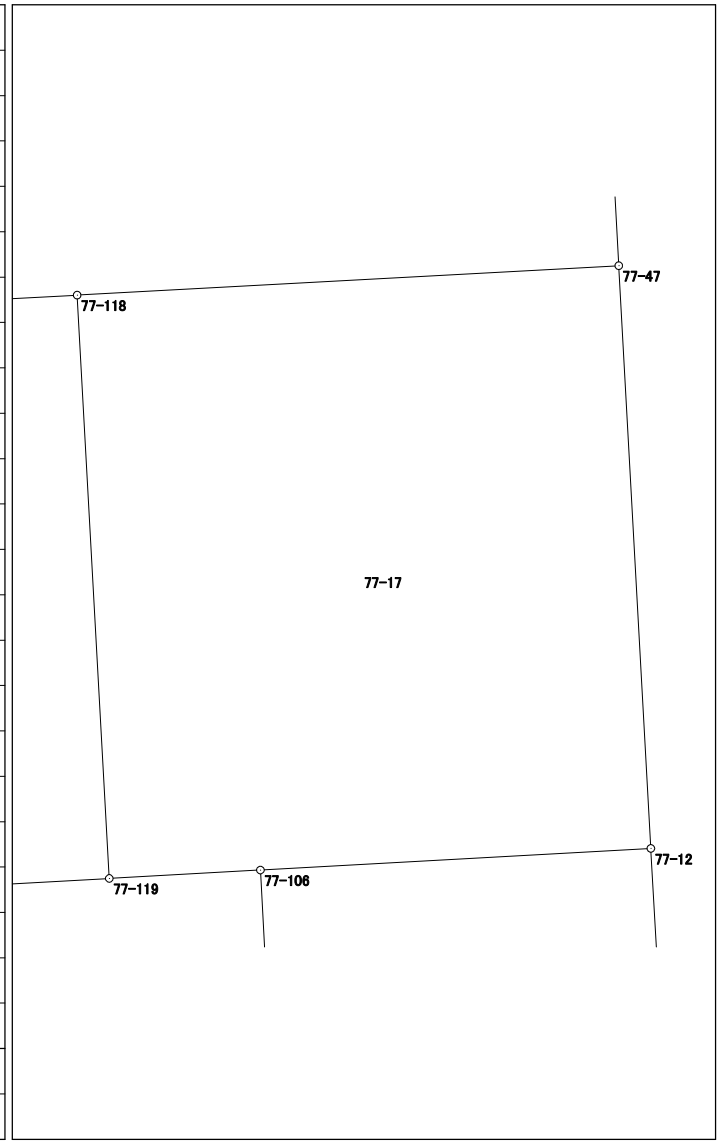


倍面積	661.682400
面積	330.8412000

面積計算書 (座標法)

世界測地系 (測地成果2011)

所在	地番	公簿地目	現況地目	地積	所有者
前橋市六供町二丁目	77-保-1			87.00 m ²	

点名	X座標	Y座標	辺長	方向角	測角	DX	倍積 (Y×DX)
77-11	41631.548	-67912.955	5.758	270-08-57	93-18-42	14.964	-1016249.458620
77-211	41631.563	-67918.713	15.301	176-50-03	86-41-06	-15.263	1036643.316519
77-212	41616.285	-67917.868	5.748	86-52-06	90-02-03	-14.964	1016322.976752
77-18	41616.599	-67912.129	14.972	356-50-15	89-58-09	15.263	-1036542.824927
						倍面積	174.009724
						面積	87.0048620

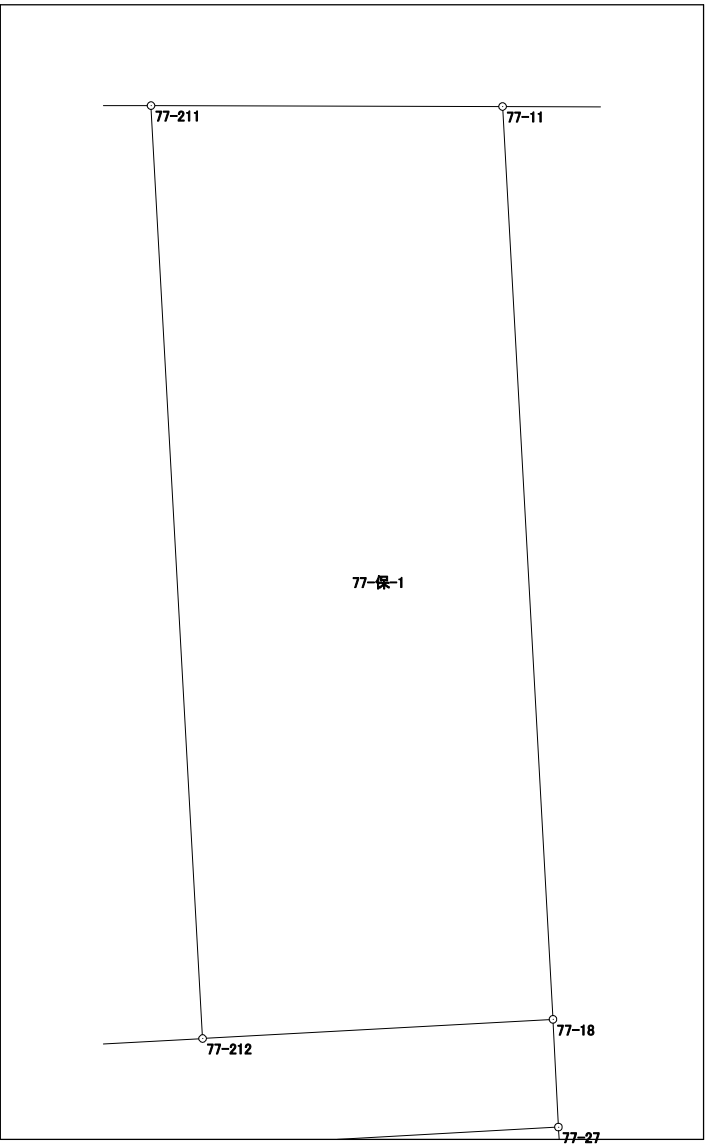


面積計算書 (座標法)

世界測地系 (測地成果2011)

所在	地番	公簿地目	現況地目	地積	所有者
前橋市六供町二丁目	77-保-2			45.00 m ²	

点名	X座標	Y座標	辺長	方向角	測角	DX	倍積 (Y×DX)
77-15	41552.596	-67929.182	29.928	86-51-04	90-05-24	0.142	-9645.943844
77-94	41554.240	-67899.299	1.503	356-45-32	89-54-28	3.145	-213543.295355
77-213	41555.741	-67899.384	29.928	266-51-11	90-05-39	-0.142	9641.712528
77-214	41554.098	-67929.267	1.504	176-45-40	89-54-29	-3.145	213637.544715
						倍面積	90.018044
						面積	45.0090220

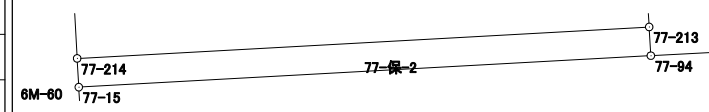

面積計算書（座標法）

世界測地系（測地成果2011）

所 在	地 番	公簿地目	現況地目	地 積	所 有 者
前橋市六供町二丁目	77-保-3			53.00 m ²	

点 名	X 座 標	Y 座 標	辺 長	方 向 角	測 角	DX	倍 積 (Y×DX)	Diagram
77-23	41541.409	-67873.846	3.479	356-51-11	89-57-40	4.300	-291857.537800	
77-207	41544.883	-67874.037	15.232	266-53-43	90-02-32	2.649	-179798.324013	
77-208	41544.058	-67889.247	3.480	176-53-13	89-59-30	-4.300	291923.762100	
77-40	41540.583	-67889.058	15.234	86-53-31	90-00-18	-2.649	179838.114642	


倍面積	106.014929
面 積	53.0074645

面積計算書 (座標法)

世界測地系 (測地成果2011)

所在	地番	公簿地目	現況地目	地積	所有者
前橋市六供町二丁目	77-保-5			109.00 m ²	

点名	X座標	Y座標	辺長	方向角	測角	DX	倍積 (Y×DX)
77-31	41471.464	-67901.651	6.000	356-54-50	87-35-43	6.055	-411144.496805
77-202	41477.455	-67901.974	14.388	356-54-59	180-00-09	20.358	-1382348.386692
77-32	41491.822	-67902.748	5.378	266-48-09	89-53-10	14.067	-955187.956116
77-205	41491.522	-67908.118	20.151	176-54-49	90-06-40	-20.422	1386819.585796
77-206	41471.400	-67907.033	5.382	89-19-07	92-24-18	-20.058	1362079.267914
						倍面積	218.014097
						面積	109.0070485

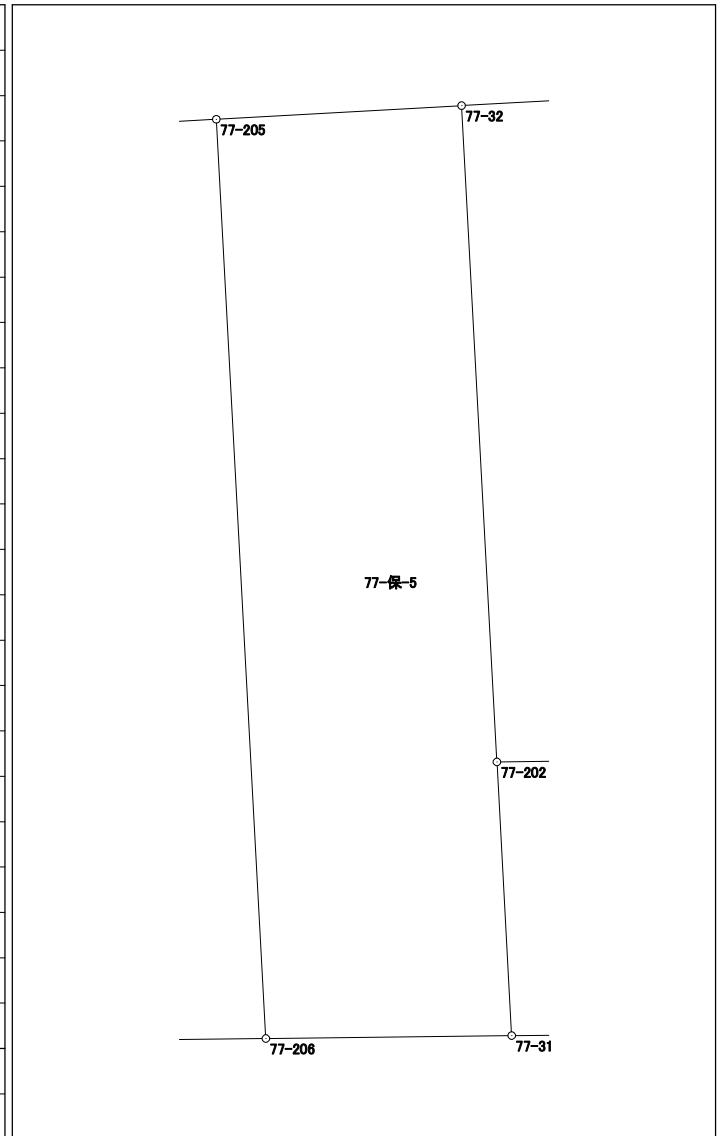


面積計算書 (座標法)

世界測地系 (測地成果2011)

所 在	地 番	公簿地目	現況地目	地 積	所 有 者
前橋市六供町二丁目	77-保-6			47.00 m ²	

点 名	X 座標	Y 座標	辺 長	方 向 角	測 角	DX	倍 積 (Y×DX)
77-202	41477.455	-67901.974	6.000	176-54-50	87-32-33	-6.077	412640.295998
77-31	41471.464	-67901.651	7.841	89-22-18	92-27-28	-5.905	400959.249155
77-203	41471.550	-67893.810	6.000	356-54-16	87-31-58	6.077	-412590.683370
77-204	41477.541	-67894.134	7.840	269-22-17	92-28-01	5.905	-400914.861270
						倍面積	94.000513
						面積	47.0002565

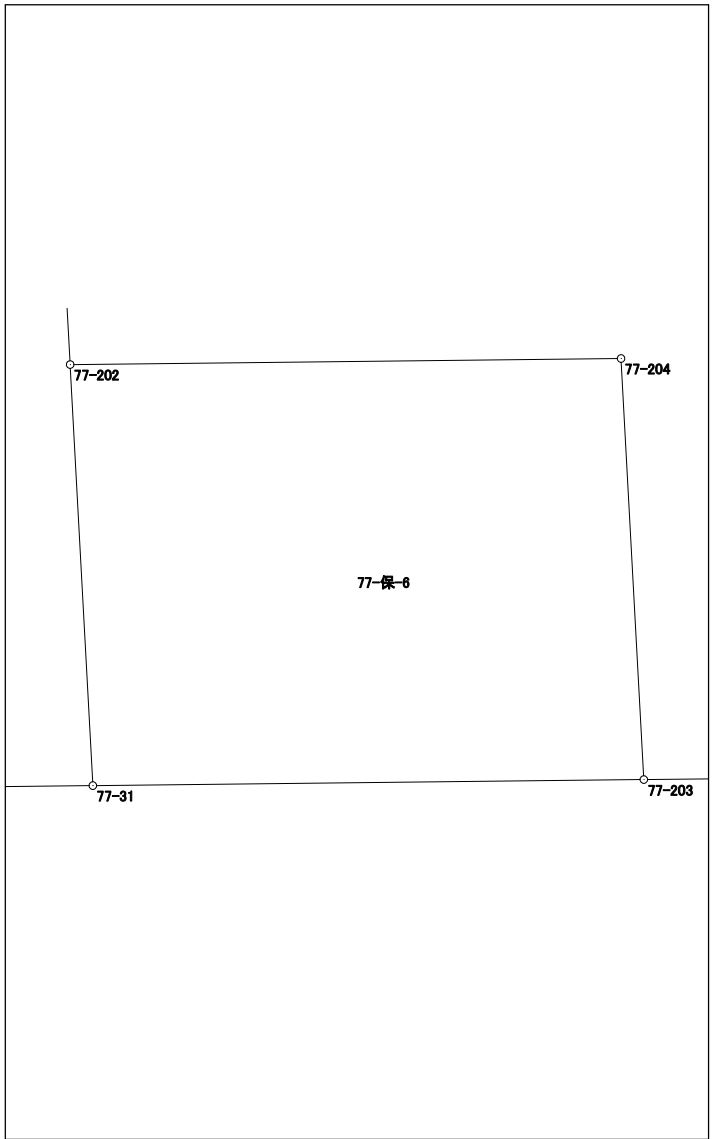

面積計算書（座標法）

世界測地系（測地成果2011）

所在	地番	公簿地目	現況地目	地積	所有者
前橋市六供町二丁目	77-保-7			36.34 m ²	


点名	X座標	Y座標	辺長	方向角	測角	DX	倍積 (Y×DX)		
77-17	41615.479	-67932.618	1.778	176-44-36	89-52-16	-2.581	175334.087058		
77-28	41613.704	-67932.517	20.508	86-50-19	90-05-43	-0.644	43748.540948		
77-27	41614.835	-67912.040	1.766	357-06-42	90-16-23	2.895	-196605.355800		
77-18	41616.599	-67912.129	5.748	266-52-06	89-45-24	1.450	-98472.587050		
77-212	41616.285	-67917.868	14.772	266-52-20	180-00-14	-1.120	76068.012160		
							倍面積		72.697316
							面積		36.3486580

面積計算書 (座標法)

世界測地系 (測地成果2011)

所在	地番	公簿地目	現況地目	地積	所有者
前橋市六供町二丁目	77-保-8			32.00 m ²	

点名	X座標	Y座標	辺長	方向角	測角	DX	倍積 (Y×DX)
77-215	41487.152	-67870.872	1.885	356-53-52	90-00-49	2.805	-190377.795960
77-217	41489.034	-67870.974	9.385	266-53-05	89-59-13	1.372	-93118.976328
77-219	41488.524	-67880.345	7.596	266-53-00	179-59-55	-0.923	62653.558435
77-218	41488.111	-67887.930	1.885	176-53-52	90-00-52	-2.295	155802.799350
77-216	41486.229	-67887.828	16.981	86-53-03	89-59-11	-0.959	65104.427052

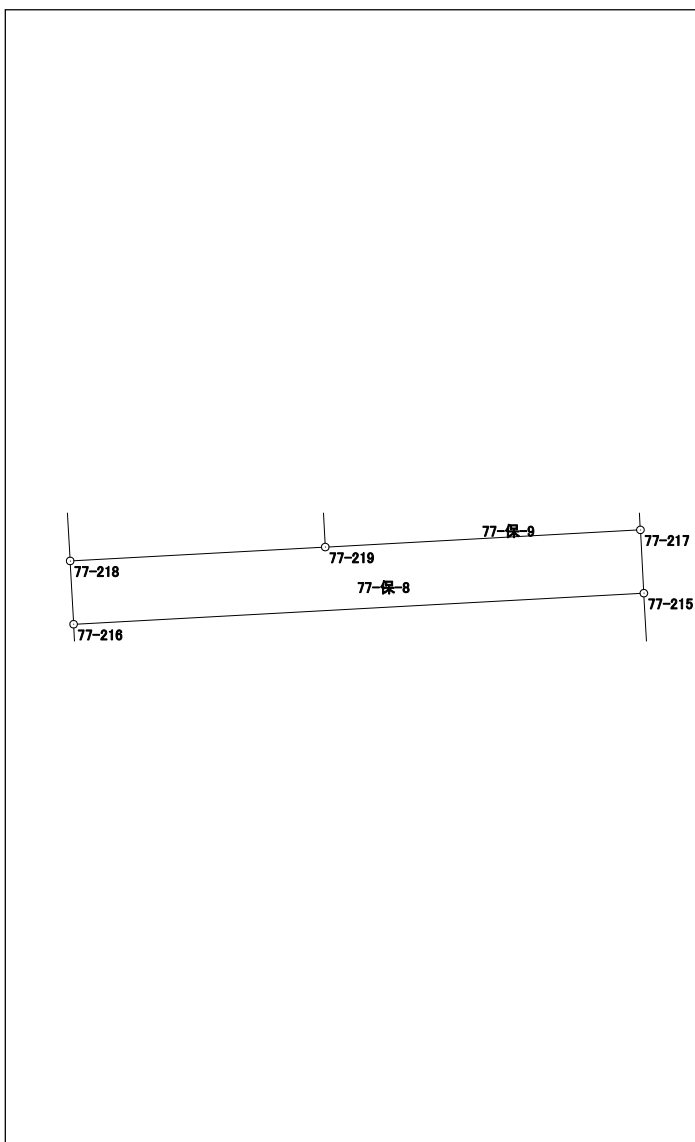

倍面積	64.012549
面積	32.0062745

