



79街区 画地出来形確認図 (2728.35m²)

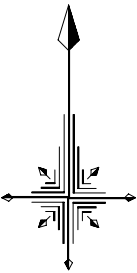

S=1/500

⊕ 4-345

⊕ 2-4

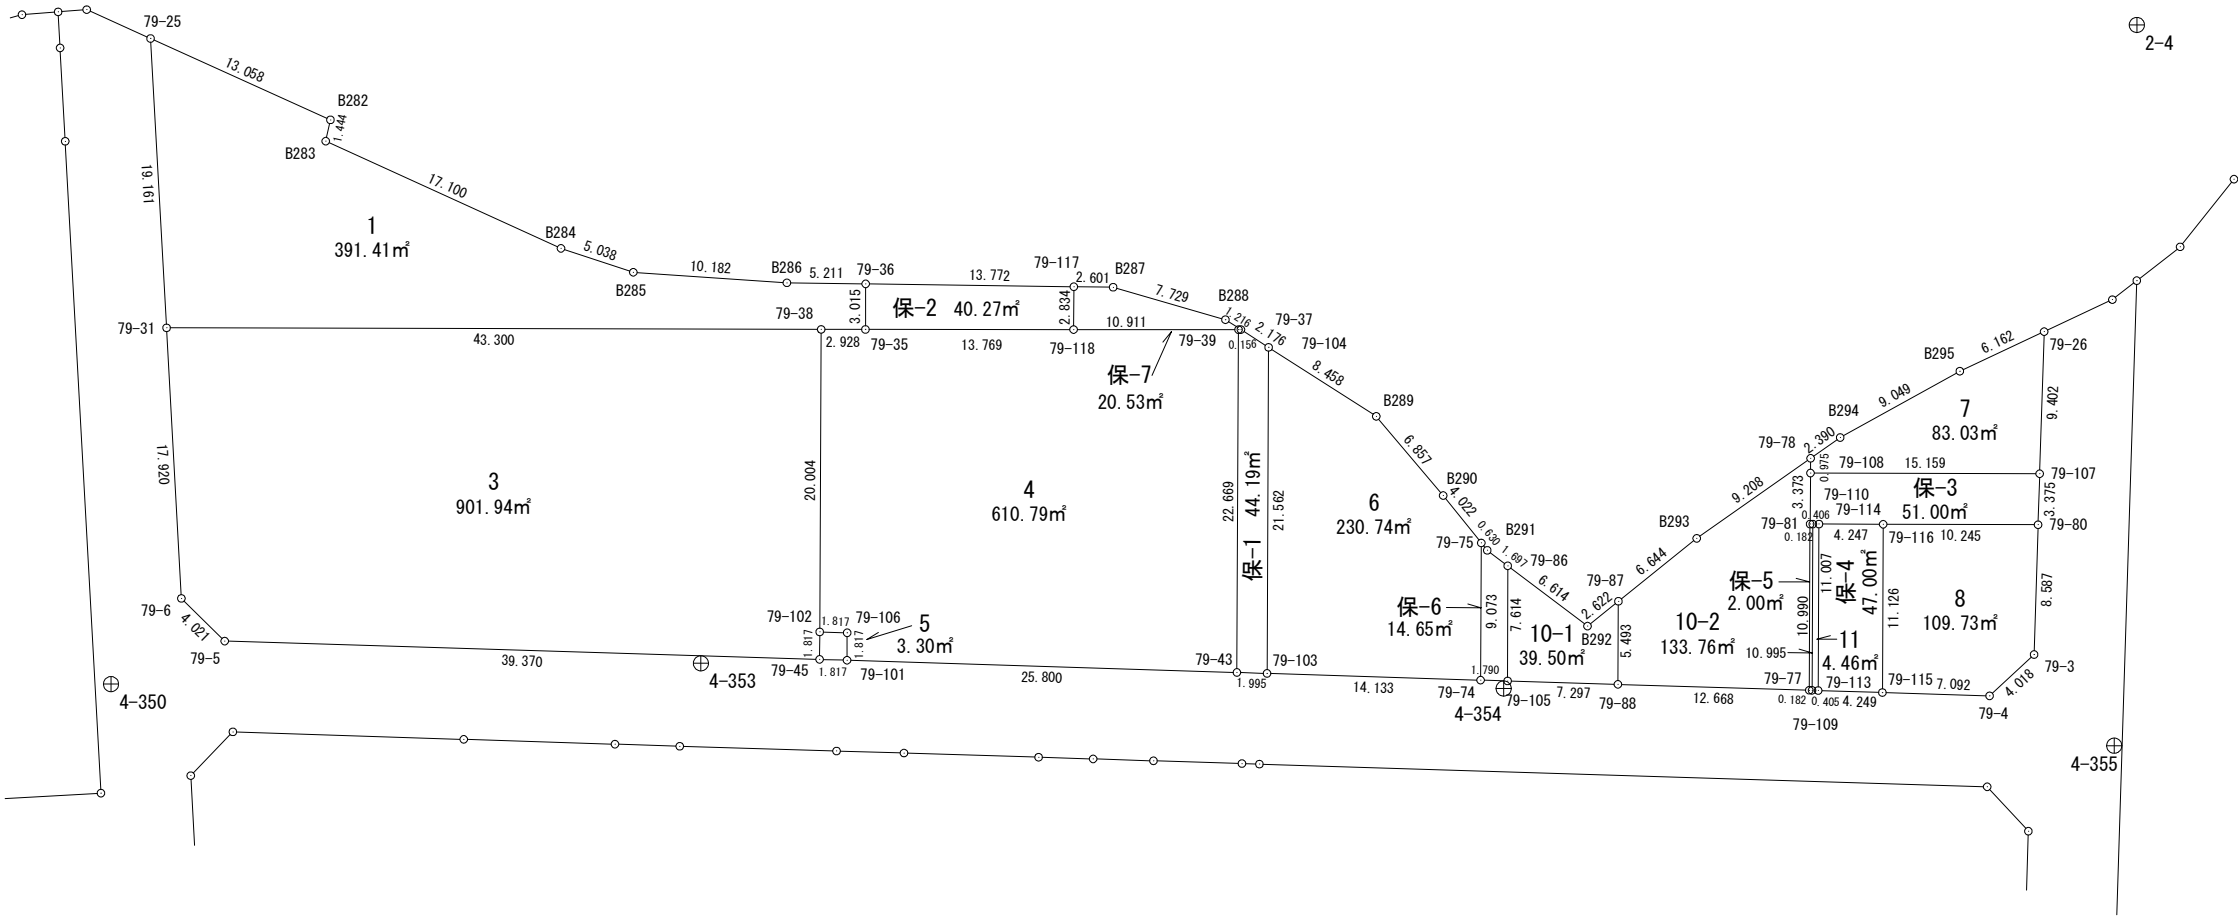

⊕ 4-350

⊕ 4-353

⊕ 4-354


⊕ 4-355

面積計算書（座標法）

世界測地系（測地成果2011）

| | | | | | |
|-----------|------|------|------|-----------------------|-----|
| 所在 | 地番 | 公簿地目 | 現況地目 | 地積 | 所有者 |
| 前橋市六供町四丁目 | 79-6 | | | 230.74 m ² | |

| 点名 | X座標 | Y座標 | 辺長 | 方向角 | 測角 | DX | 倍積 (Y×DX) |
|--------|-----------|------------|--------|-----------|-----------|---------|----------------|
| 79-103 | 41573.482 | -67732.511 | 14.133 | 91-48-01 | 91-31-26 | -22.006 | 1490521.637066 |
| 79-74 | 41573.038 | -67718.385 | 9.073 | 0-17-48 | 88-29-47 | 8.629 | -584341.944165 |
| 79-75 | 41582.111 | -67718.338 | 4.022 | 321-11-12 | 140-53-24 | 12.207 | -826637.751966 |
| B290 | 41585.245 | -67720.859 | 6.857 | 319-47-51 | 178-36-39 | 8.371 | -566891.310689 |
| B289 | 41590.482 | -67725.285 | 8.458 | 302-38-30 | 162-50-39 | 9.799 | -663640.067715 |
| 79-104 | 41595.044 | -67732.407 | 21.562 | 180-16-35 | 57-38-05 | -17.000 | 1151450.919000 |
| | | | | | | | |
| | | | | | | | |
| | | | | | | 倍面積 | 461.481531 |
| | | | | | | 面積 | 230.7407655 |

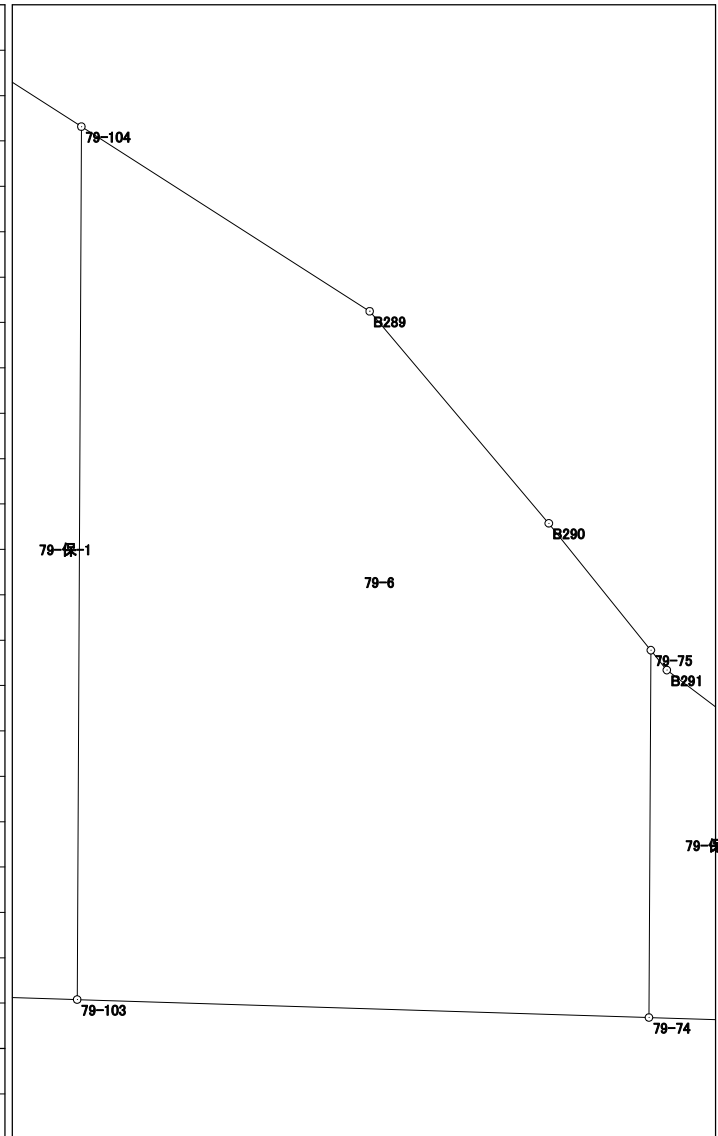


面積計算書（座標法）

世界測地系（測地成果2011）

| 所 在 | 地 番 | 公簿地目 | 現況地目 | 地 積 | 所 有 者 |
|-----------|------|------|------|----------------------|-------|
| 前橋市六供町四丁目 | 79-7 | | | 83.03 m ² | |

| 点 名 | X 座標 | Y 座標 | 辺 長 | 方 向 角 | 測 角 | DX | 倍 積 (Y×DX) |
|--------|-----------|------------|--------|-----------|-----------|--------|----------------|
| 79-107 | 41586.686 | -67681.403 | 9.402 | 1-48-37 | 91-38-25 | 9.352 | -632956.480856 |
| 79-26 | 41596.083 | -67681.106 | 6.162 | 244-52-41 | 63-04-04 | 6.781 | -458945.579786 |
| B295 | 41593.467 | -67686.685 | 9.049 | 240-59-56 | 176-07-15 | -7.003 | 474009.855055 |
| B294 | 41589.080 | -67694.599 | 2.390 | 234-54-00 | 173-54-04 | -5.761 | 389988.584839 |
| 79-78 | 41587.706 | -67696.554 | 0.975 | 180-28-12 | 125-34-12 | -2.349 | 159019.205346 |
| 79-108 | 41586.731 | -67696.562 | 15.159 | 90-10-12 | 89-42-00 | -1.020 | 69050.493240 |
| | | | | | | | |
| | | | | | | | |
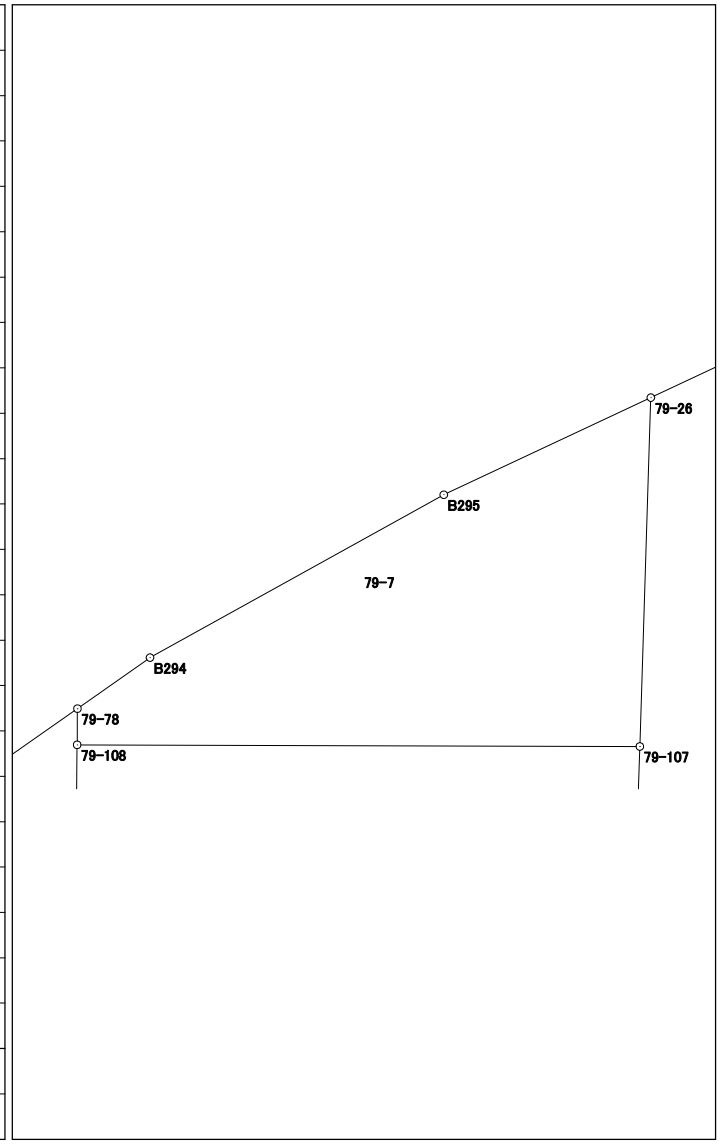


| | |
|-----|------------|
| 倍面積 | 166.077838 |
| 面 積 | 83.0389190 |

面積計算書（座標法）

世界測地系（測地成果2011）

| 所在 | 地番 | 公簿地目 | 現況地目 | 地積 | 所有者 |
|-----------|---------|------|------|-----------------------|-----|
| 前橋市六供町四丁目 | 79-10-2 | | | 133.76 m ² | |

| 点名 | X座標 | Y座標 | 辺長 | 方向角 | 測角 | DX | 倍積 (Y×DX) |
|--------|-----------|------------|--------|-----------|-----------|--------|----------------|
| 79-88 | 41572.758 | -67709.302 | 12.668 | 91-45-51 | 91-24-34 | -5.883 | 398333.823666 |
| 79-77 | 41572.368 | -67696.640 | 10.990 | 0-15-57 | 88-30-06 | 10.600 | -717584.384000 |
| 79-81 | 41583.358 | -67696.589 | 3.373 | 0-27-31 | 180-11-34 | 14.363 | -972326.107807 |
| 79-108 | 41586.731 | -67696.562 | 0.975 | 0-28-12 | 180-00-41 | 4.348 | -294344.651576 |
| 79-78 | 41587.706 | -67696.554 | 9.208 | 234-54-18 | 54-26-06 | -4.319 | 292381.416726 |
| B293 | 41582.412 | -67704.088 | 6.644 | 231-13-33 | 176-19-15 | -9.455 | 640142.152040 |
| 79-87 | 41578.251 | -67709.268 | 5.493 | 180-21-17 | 129-07-44 | -9.654 | 653665.273272 |
| | | | | | | | |
| | | | | | | | |
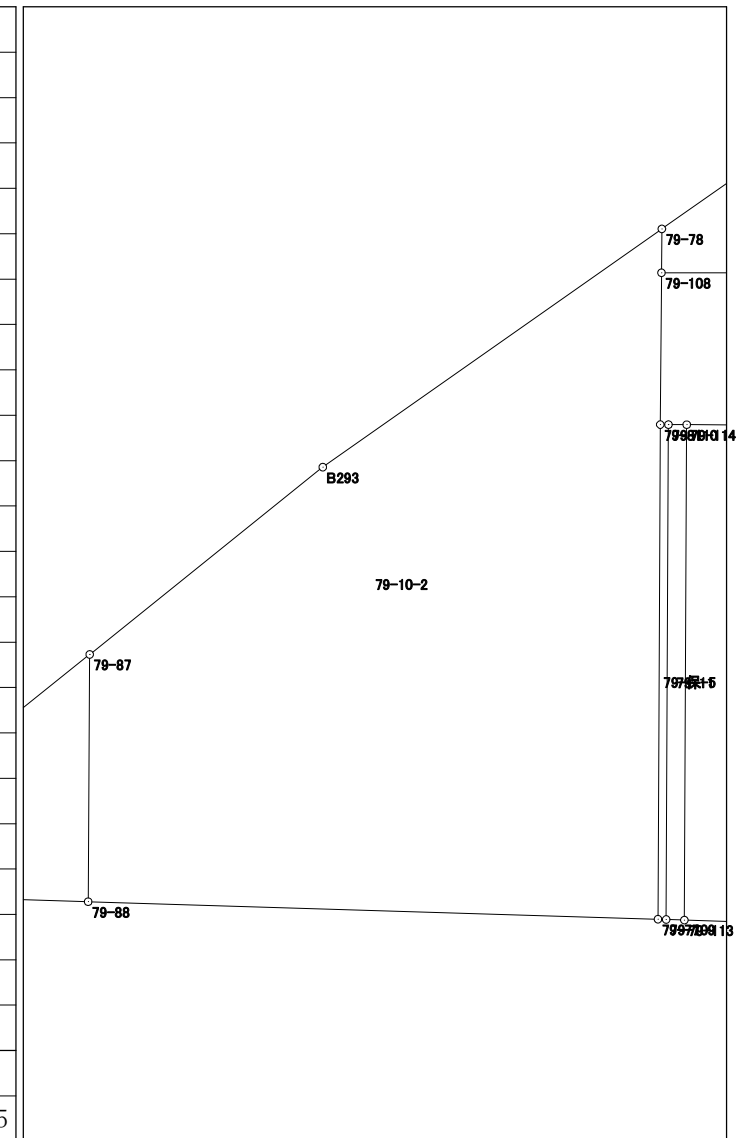


| | |
|-----|-------------|
| 倍面積 | 267.522321 |
| 面積 | 133.7611605 |

面積計算書 (座標法)

世界測地系 (測地成果2011)

| | | | | | |
|-----------|-------|------|------|---------------------|-----|
| 所在 | 地番 | 公簿地目 | 現況地目 | 地積 | 所有者 |
| 前橋市六供町四丁目 | 79-11 | | | 4.46 m ² | |

| 点名 | X座標 | Y座標 | 辺長 | 方向角 | 測角 | DX | 倍積 (Y×DX) |
|--------|-----------|------------|--------|-----------|----------|---------|----------------|
| 79-110 | 41583.357 | -67696.407 | 10.995 | 180-15-57 | 90-07-29 | -10.994 | 744254.298558 |
| 79-109 | 41572.362 | -67696.458 | 0.405 | 91-50-19 | 91-34-22 | -11.008 | 745202.609664 |
| 79-113 | 41572.349 | -67696.053 | 11.007 | 0-16-14 | 88-25-55 | 10.994 | -744250.406682 |
| 79-114 | 41583.356 | -67696.001 | 0.406 | 270-08-28 | 89-52-14 | 11.008 | -745197.579008 |
| | | | | | | | |
| | | | | | | | |
| | | | | | | 倍面積 | 8.922532 |
| | | | | | | 面積 | 4.4612660 |

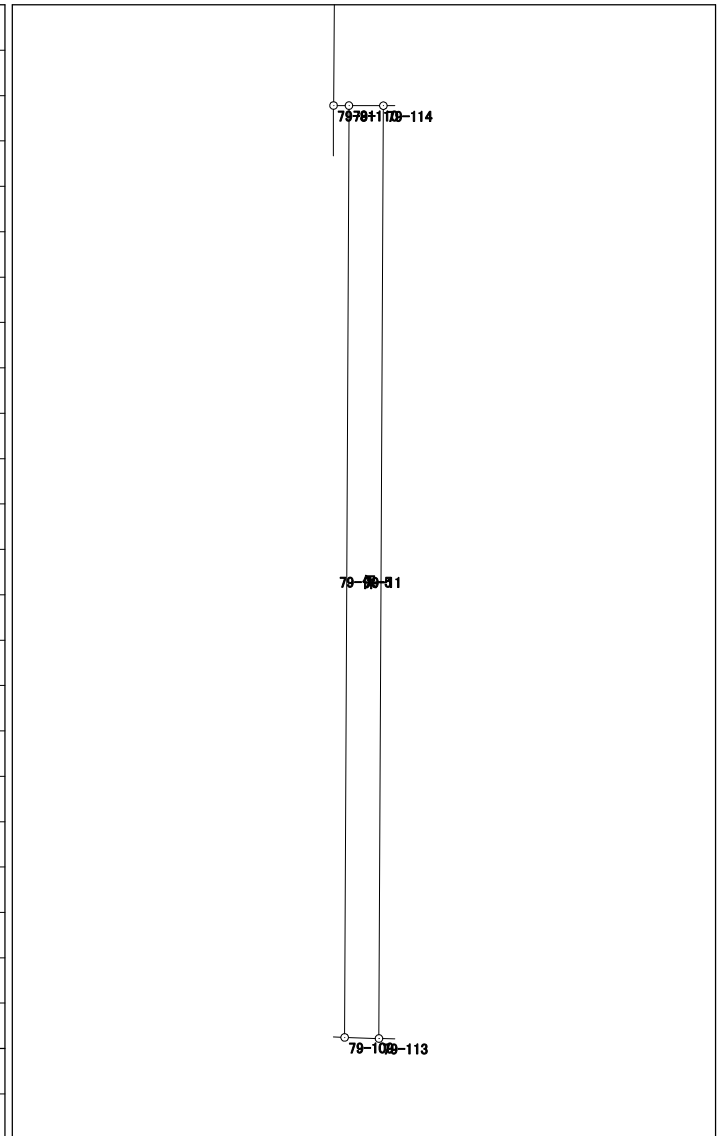


面積計算書 (座標法)

世界測地系 (測地成果2011)

| 所在 | 地番 | 公簿地目 | 現況地目 | 地積 | 所有者 |
|-----------|--------|------|------|----------------------|-----|
| 前橋市六供町四丁目 | 79-保-1 | | | 44.19 m ² | |

| 点名 | X座標 | Y座標 | 辺長 | 方向角 | 測角 | DX | 倍積 (Y×DX) | |
|--------|-----------|------------|--------|-----------|-----------|---------|-----------------|------------|
| 79-39 | 41596.214 | -67734.395 | 22.669 | 180-16-41 | 91-44-49 | -22.673 | 1535741.937835 | |
| 79-43 | 41573.545 | -67734.505 | 1.995 | 91-48-35 | 91-31-54 | -22.732 | 1539740.767660 | |
| 79-103 | 41573.482 | -67732.511 | 21.562 | 0-16-35 | 88-28-00 | 21.499 | -1456181.253989 | |
| 79-104 | 41595.044 | -67732.407 | 2.176 | 302-39-11 | 122-22-36 | 22.736 | -1539964.005552 | |
| 79-37 | 41596.218 | -67734.239 | 0.156 | 268-31-52 | 145-52-41 | 1.170 | -79249.059630 | |
| | | | | | | | | |
| | | | | | | | | |
| | | | | | | | 倍面積 | 88.386324 |
| | | | | | | | 面積 | 44.1931620 |

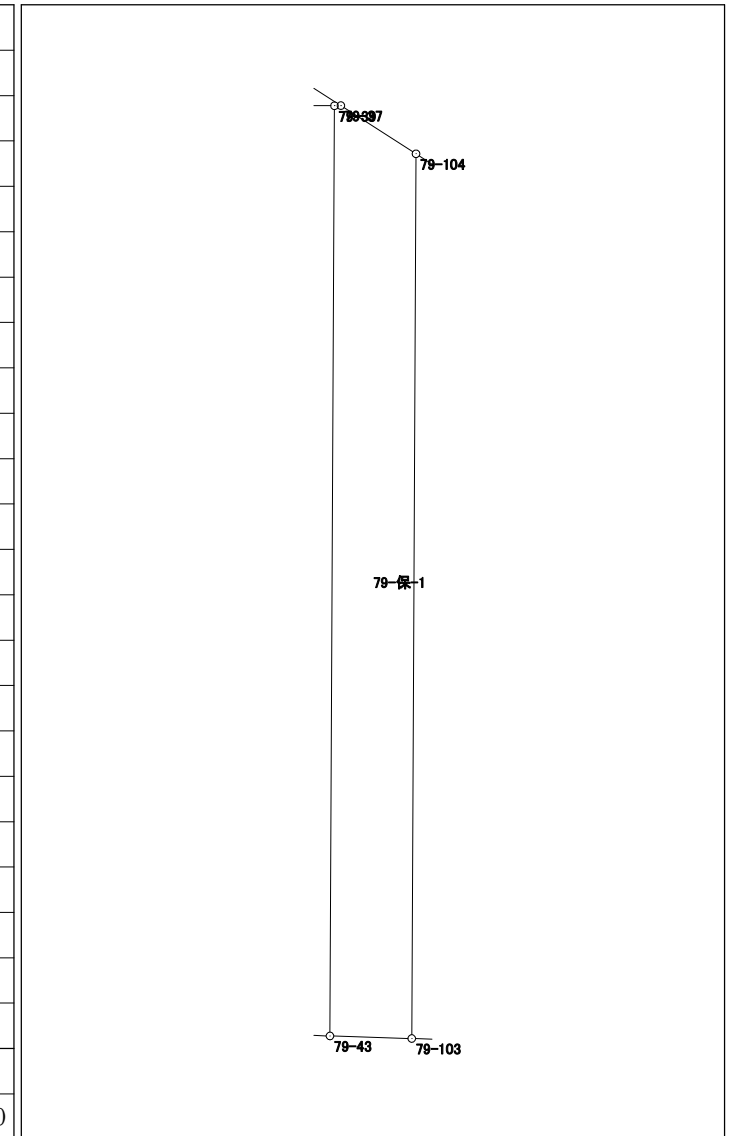

面積計算書（座標法）

世界測地系（測地成果2011）

| | | | | | |
|-----------|--------|------|------|---------------------|-------|
| 所 在 | 地 番 | 公簿地目 | 現況地目 | 地 積 | 所 有 者 |
| 前橋市六供町四丁目 | 79-保-5 | | | 2.00 m ² | |


| 点 名 | X 座標 | Y 座標 | 辺 長 | 方 向 角 | 測 角 | DX | 倍 積 (Y×DX) | |
|--------|-----------|------------|--------|-----------|----------|---------|----------------|-----------|
| 79-81 | 41583.358 | -67696.589 | 10.990 | 180-15-57 | 89-57-04 | -10.989 | 743917.816521 | |
| 79-77 | 41572.368 | -67696.640 | 0.182 | 91-53-17 | 91-37-20 | -10.996 | 744392.253440 | |
| 79-109 | 41572.362 | -67696.458 | 10.995 | 0-15-57 | 88-22-40 | 10.989 | -743916.376962 | |
| 79-110 | 41583.357 | -67696.407 | 0.182 | 270-18-53 | 90-02-56 | 10.996 | -744389.691372 | |
| | | | | | | | | |
| | | | | | | | | |
| | | | | | | | 倍面積 | |
| | | | | | | | 面 積 | 2.0008135 |

面積計算書（座標法）

世界測地系（測地成果2011）

| | | | | | |
|-----------|--------|------|------|----------------------|-----|
| 所在 | 地番 | 公簿地目 | 現況地目 | 地積 | 所有者 |
| 前橋市六供町四丁目 | 79-保-6 | | | 14.65 m ² | |

| 点名 | X座標 | Y座標 | 辺長 | 方向角 | 測角 | DX | 倍積 (Y×DX) |
|--------|-----------|------------|-------|-----------|-----------|--------|----------------|
| 79-75 | 41582.111 | -67718.338 | 9.073 | 180-17-48 | 39-06-46 | -8.582 | 581158.776716 |
| 79-74 | 41573.038 | -67718.385 | 1.790 | 91-45-39 | 91-27-51 | -9.128 | 618133.418280 |
| 79-105 | 41572.983 | -67716.596 | 7.614 | 0-03-10 | 88-17-31 | 7.559 | -511869.749164 |
| 79-86 | 41580.597 | -67716.589 | 1.697 | 307-04-21 | 127-01-11 | 8.637 | -584868.179193 |
| B291 | 41581.620 | -67717.943 | 0.630 | 321-11-02 | 194-06-41 | 1.514 | -102524.965702 |
| | | | | | | | |
| | | | | | | | |
| | | | | | | 倍面積 | 29.300937 |
| | | | | | | 面積 | 14.6504685 |

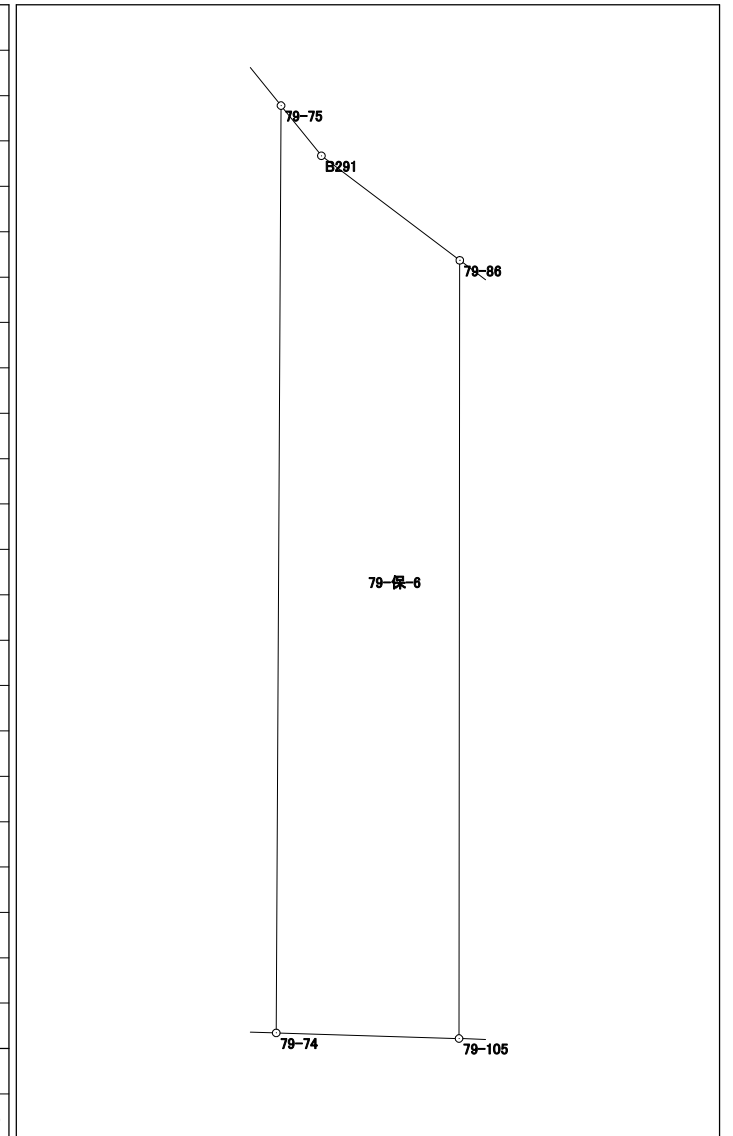

面積計算書 (座標法)

世界測地系 (測地成果2011)

| | | | | | |
|-----------|--------|------|------|----------------------|-------|
| 所 在 | 地 番 | 公簿地目 | 現況地目 | 地 積 | 所 有 者 |
| 前橋市六供町四丁目 | 79-保-7 | | | 20.53 m ² | |

| 点 名 | X 座標 | Y 座標 | 辺 長 | 方 向 角 | 測 角 | DX | 倍 積 (Y×DX) | |
|--------|-----------|------------|--------|-----------|-----------|--------|----------------|------------|
| 79-117 | 41599.053 | -67745.290 | 2.834 | 180-19-25 | 89-33-10 | -2.799 | 189619.066710 | |
| 79-118 | 41596.219 | -67745.306 | 10.911 | 90-01-35 | 89-42-10 | -2.839 | 192328.923734 | |
| 79-39 | 41596.214 | -67734.395 | 0.156 | 88-31-52 | 178-30-17 | -0.001 | 67.734395 | |
| 79-37 | 41596.218 | -67734.239 | 1.216 | 302-38-41 | 34-06-49 | 0.660 | -44704.597740 | |
| B288 | 41596.874 | -67735.263 | 7.729 | 286-06-15 | 163-27-34 | 2.800 | -189658.736400 | |
| B287 | 41599.018 | -67742.689 | 2.601 | 270-46-15 | 164-40-00 | 2.179 | -147611.319331 | |
| | | | | | | | | |
| | | | | | | | | |
| | | | | | | | 倍面積 | |
| | | | | | | | 面 積 | 20.5356840 |