



88街区 画地出来形確認図 (2415.90m²)

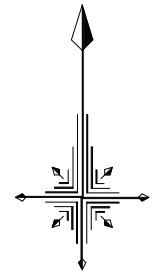

S=1/500

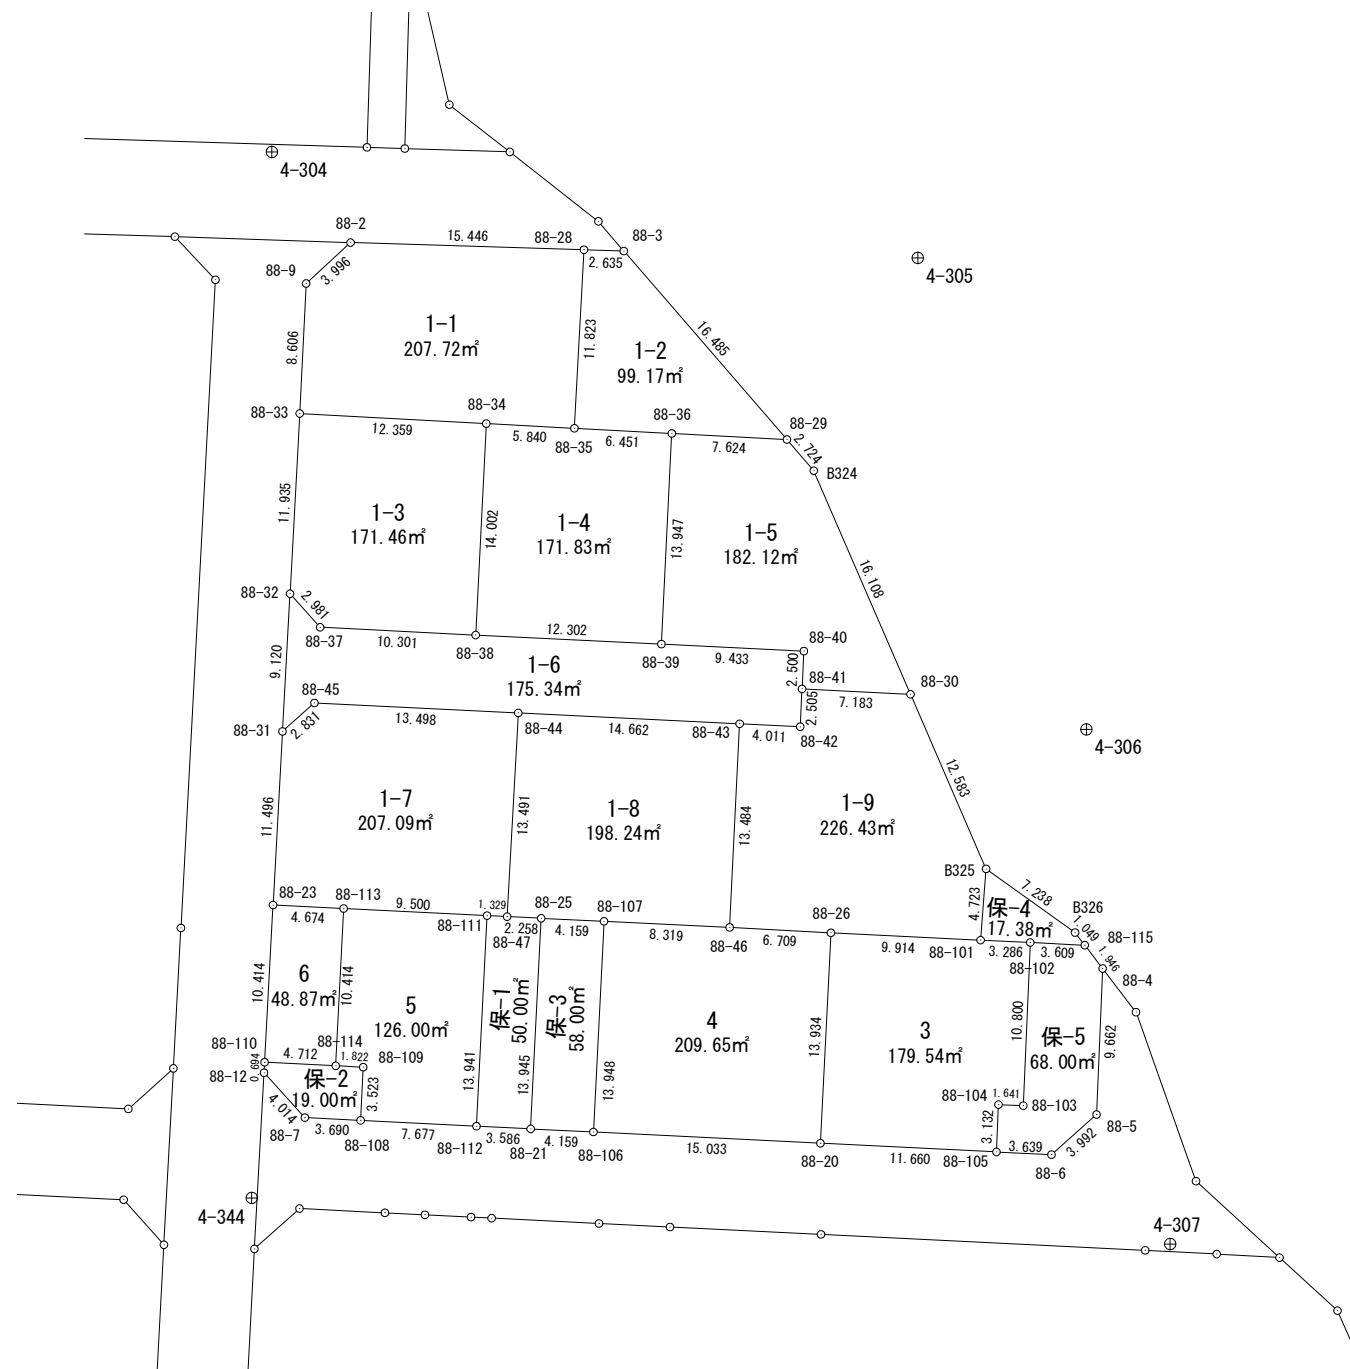


面積計算書（座標法）

世界測地系（測地成果2011）

所在	地番	公簿地目	現況地目	地積	所有者
前橋市天川原町一丁目	88-1-8			198.24 m ²	

点名	X座標	Y座標	辺長	方向角	測角	DX	倍積 (Y×DX)
88-44	41530.772	-67417.112	13.491	183-07-54	90-19-43	-12.754	859837.846448
88-47	41517.301	-67417.849	2.258	92-46-02	89-38-08	-13.580	915534.389420
88-25	41517.192	-67415.594	4.159	92-47-02	180-01-00	-0.311	20966.249734
88-107	41516.990	-67411.440	8.319	92-46-36	179-59-34	-0.605	40783.921200
88-46	41516.587	-67403.131	13.484	2-49-06	90-02-30	13.065	-880621.906515
88-43	41530.055	-67402.468	14.662	272-48-11	89-59-05	14.185	-956104.008580
						倍面積	396.491707
						面積	198.2458535

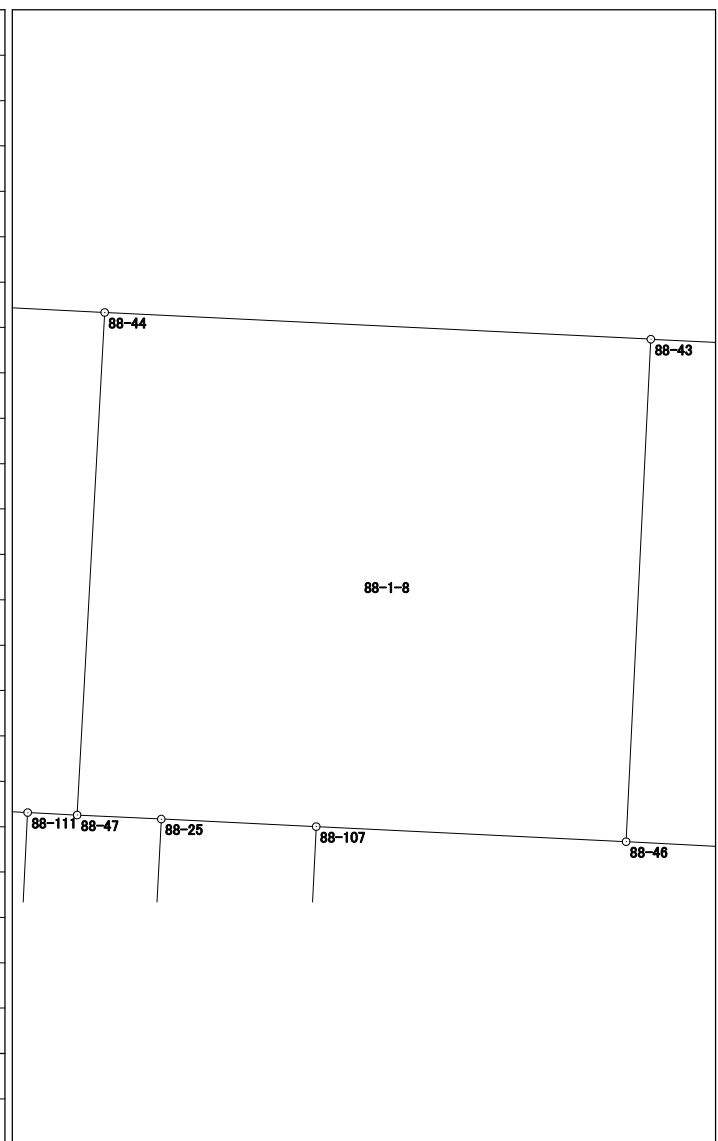


面積計算書（座標法）

世界測地系（測地成果2011）

所 在	地 番	公簿地目	現況地目	地 積	所 有 者
前橋市天川原町一丁目	88-1-9			226.43 m ²	

点 名	X 座標	Y 座標	辺 長	方 向 角	測 角	DX	倍 積 (Y×DX)
B325	41520.459	-67386.166	12.583	336-35-12	152-10-43	16.256	-1095429.514496
88-30	41532.006	-67391.166	7.183	272-49-59	116-14-47	11.902	-802089.657732
88-41	41532.361	-67398.340	2.505	182-47-30	89-57-31	-2.147	144704.235980
88-42	41529.859	-67398.462	4.011	272-48-04	270-00-34	-2.306	155420.853372
88-43	41530.055	-67402.468	13.484	182-49-06	90-01-02	-13.272	894565.555296
88-46	41516.587	-67403.131	6.709	93-00-57	90-11-51	-13.821	931578.673551
88-26	41516.234	-67396.431	9.914	92-47-54	179-46-57	-0.837	56410.812747
88-101	41515.750	-67386.529	4.723	4-24-29	91-36-35	4.225	-284708.085025

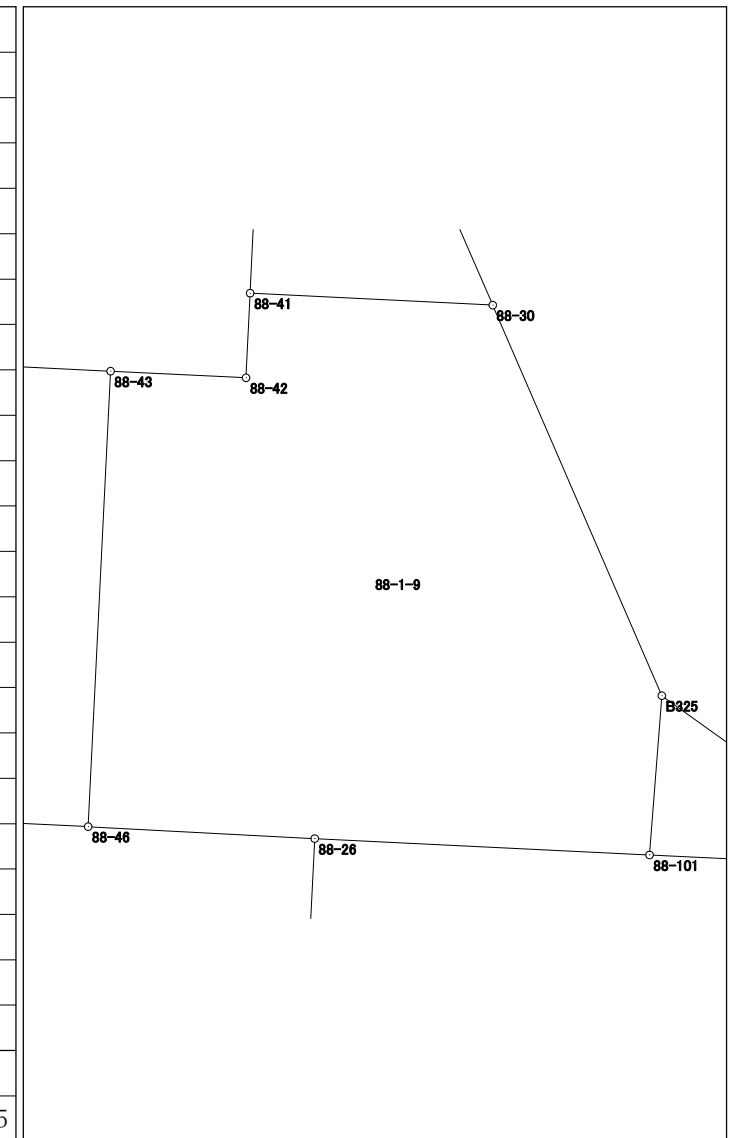


倍面積	452.873693
面 積	226.4368465

面積計算書 (座標法)

世界測地系 (測地成果2011)

所在	地番	公簿地目	現況地目	地積	所有者
前橋市天川原町一丁目	88-3			179.54 m ²	

点名	X座標	Y座標	辺長	方向角	測角	DX	倍積 (Y×DX)
88-26	41516.234	-67396.431	13.934	182-51-03	90-03-09	-13.433	905336.257623
88-20	41502.317	-67397.124	11.660	92-49-53	89-58-50	-14.493	976786.518132
88-105	41501.741	-67385.478	3.132	2-26-02	89-36-09	2.553	-172035.125334
88-104	41504.870	-67385.345	1.641	92-26-39	270-00-37	3.059	-206131.770355
88-103	41504.800	-67383.705	10.800	2-25-50	89-59-11	10.720	-722353.317600
88-102	41515.590	-67383.247	3.286	272-47-28	90-21-38	10.950	-737846.554650
88-101	41515.750	-67386.529	9.914	272-47-54	180-00-26	0.644	-43396.924676

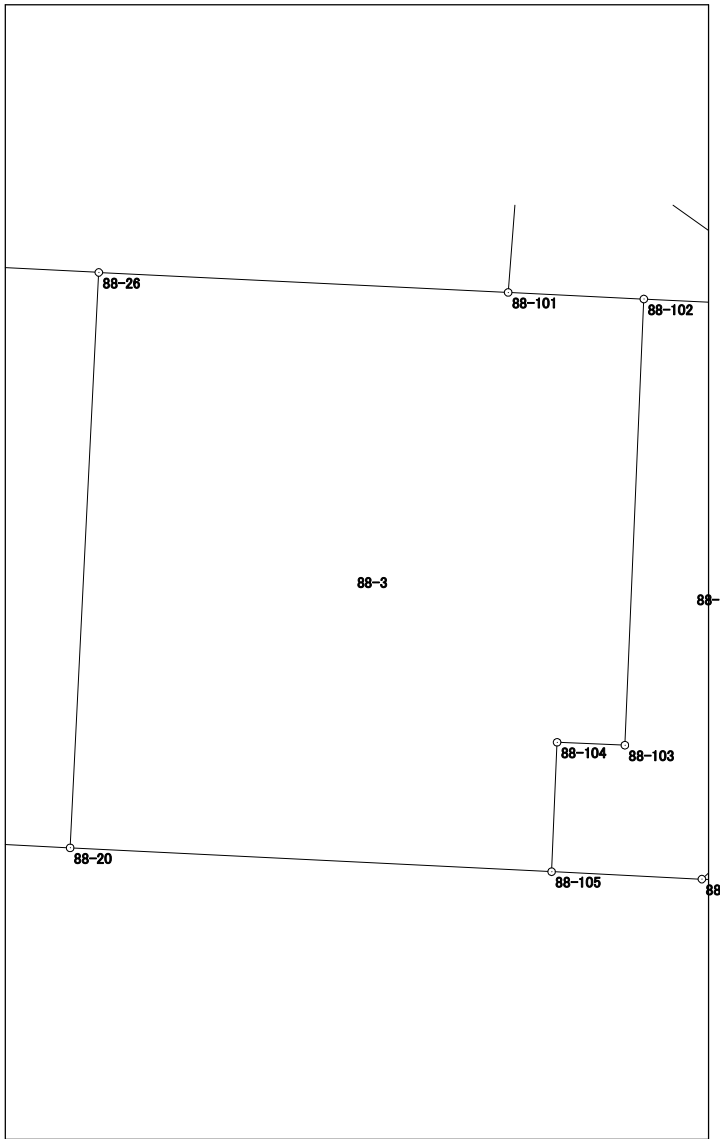

倍面積	359.083140
面積	179.5415700


面積計算書 (座標法)

世界測地系 (測地成果2011)

所在	地番	公簿地目	現況地目	地積	所有者
前橋市天川原町一丁目	88-4			209.65 m ²	

点名	X座標	Y座標	辺長	方向角	測角	DX	倍積 (Y×DX)
88-106	41503.060	-67412.139	15.033	92-49-58	89-57-36	-14.673	989138.315547
88-20	41502.317	-67397.124	13.934	2-51-03	90-01-05	13.174	-887889.711576
88-26	41516.234	-67396.431	6.709	273-00-57	90-09-54	14.270	-961747.070370
88-46	41516.587	-67403.131	8.319	272-46-36	179-45-39	0.756	-50956.767036
88-107	41516.990	-67411.440	13.948	182-52-22	90-05-46	-13.527	911874.548880

倍面積	419.315445
面積	209.6577225

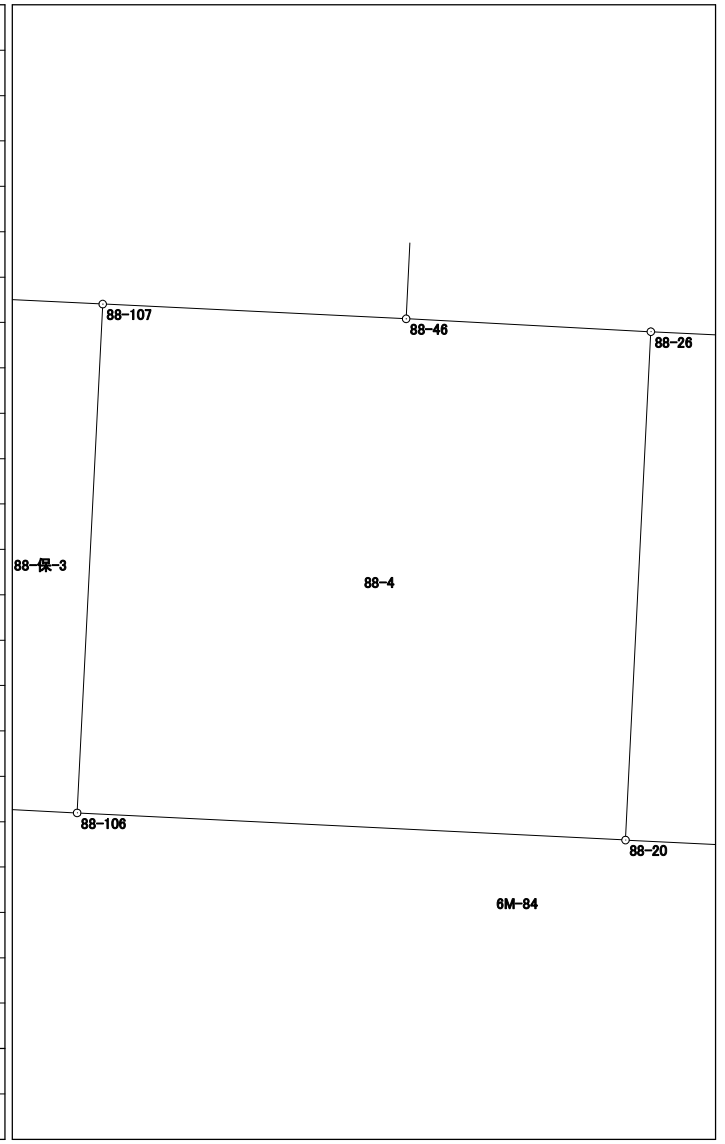

面積計算書 (座標法)

世界測地系 (測地成果2011)

所 在	地 番	公簿地目	現況地目	地 積	所 有 者
前橋市天川原町一丁目	88-5			126.00 m ²	


点 名	X 座標	Y 座標	辺 長	方 向 角	測 角	DX	倍 積 (Y×DX)		
88-112	41503.444	-67419.875	13.941	2-52-27	90-00-52	13.540	-912865.107500		
88-111	41517.367	-67419.176	9.500	272-50-31	89-58-04	14.394	-970431.619344		
88-113	41517.838	-67428.664	10.414	182-52-43	90-02-12	-9.930	669566.633520		
88-114	41507.437	-67429.187	1.822	92-51-45	89-59-02	-10.492	707467.030004		
88-109	41507.346	-67427.367	3.523	182-50-49	269-59-04	-3.610	243412.794870		
88-108	41503.827	-67427.542	7.677	92-51-35	90-00-46	-3.902	263102.268884		
							倍面積	252.000434	
							面 積	126.0002170	

面積計算書（座標法）

世界測地系（測地成果2011）

所 在	地 番	公簿地目	現況地目	地 積	所 有 者
前橋市天川原町一丁目	88-保-2			19.00 m ²	

点 名	X 座標	Y 座標	辺 長	方 向 角	測 角	DX	倍 積 (Y×DX)
88-7	41504.011	-67431.227	3.690	92-51-31	135-11-34	-3.151	212475.796277
88-108	41503.827	-67427.542	3.523	2-50-49	89-59-18	3.335	-224870.852570
88-109	41507.346	-67427.367	1.822	272-51-45	90-00-56	3.610	-243412.794870
88-114	41507.437	-67429.187	4.712	272-50-48	179-59-03	0.325	-21914.485775
88-110	41507.671	-67433.893	0.694	183-03-22	90-12-34	-0.459	30952.156887
88-12	41506.978	-67433.930	4.014	137-39-57	134-36-35	-3.660	246808.183800

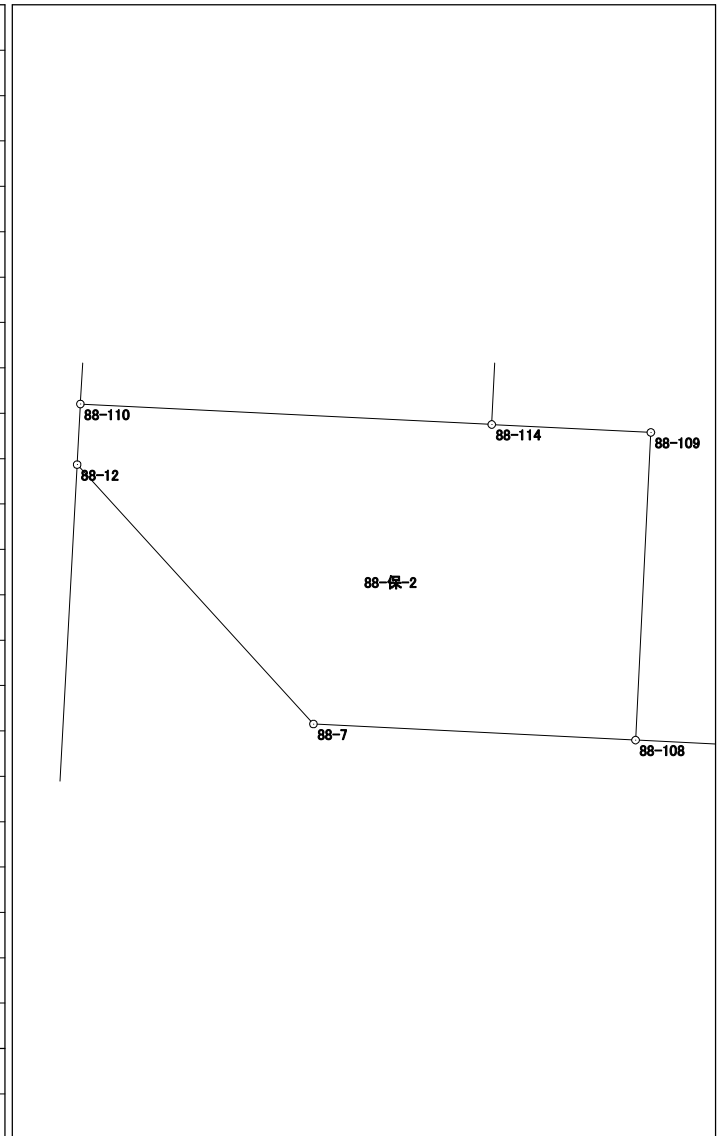


倍面積	38.003749
面 積	19.0018745

面積計算書 (座標法)

世界測地系 (測地成果2011)

所在	地番	公簿地目	現況地目	地積	所有者
前橋市天川原町一丁目	88-保-3			58.00 m ²	

点名	X座標	Y座標	辺長	方向角	測角	DX	倍積 (Y×DX)
88-25	41517.192	-67415.594	13.945	182-52-24	90-05-22	-13.725	925279.027650
88-21	41503.265	-67416.293	4.159	92-49-31	89-57-07	-14.132	952727.052676
88-106	41503.060	-67412.139	13.948	2-52-22	90-02-51	13.725	-925231.607775
88-107	41516.990	-67411.440	4.159	272-47-02	89-54-40	14.132	-952658.470080

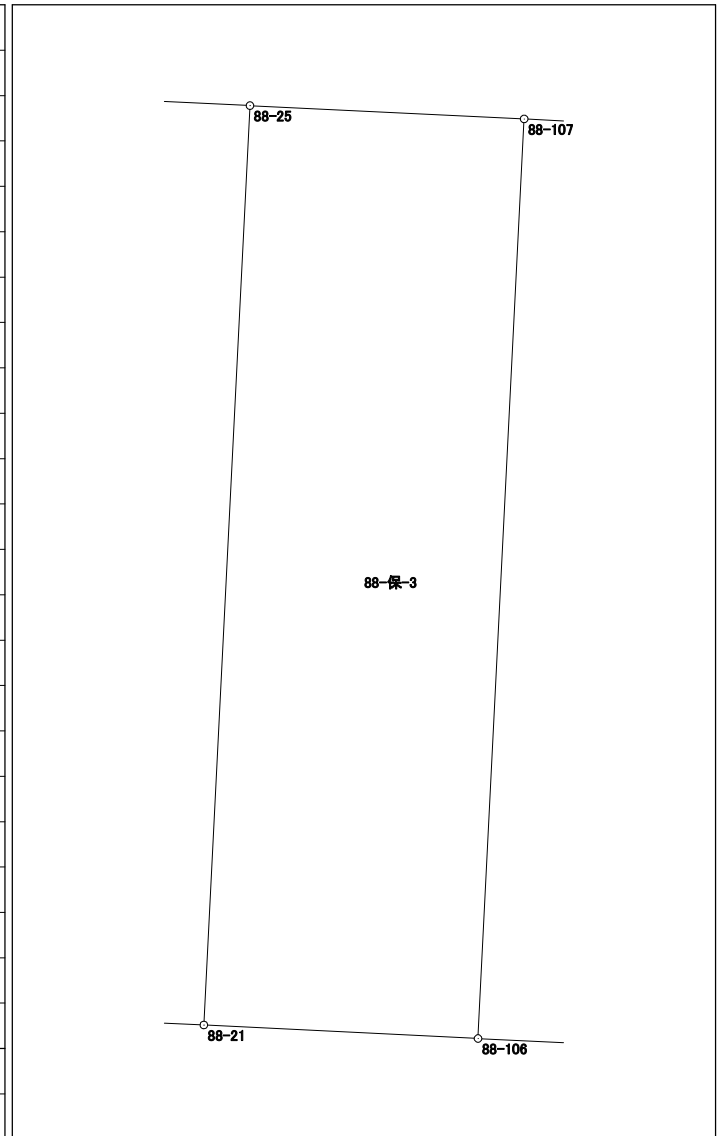


倍面積	116.002471
面積	58.0012355

面積計算書（座標法）

世界測地系（測地成果2011）

所在	地番	公簿地目	現況地目	地積	所有者
前橋市天川原町一丁目	88-保-4			17.38 m ²	

点名	X座標	Y座標	辺長	方向角	測角	DX	倍積(Y×DX)
B325	41520.459	-67386.166	4.723	184-24-29	58-48-51	-0.496	33423.538336
88-101	41515.750	-67386.529	3.286	92-47-28	88-22-59	-4.869	328105.009701
88-102	41515.590	-67383.247	3.609	92-48-39	180-01-11	-0.337	22708.154239
88-115	41515.413	-67379.642	1.049	322-33-05	49-44-26	0.656	-44201.045152
B326	41516.246	-67380.280	7.238	305-35-38	163-02-33	5.046	-340000.892880

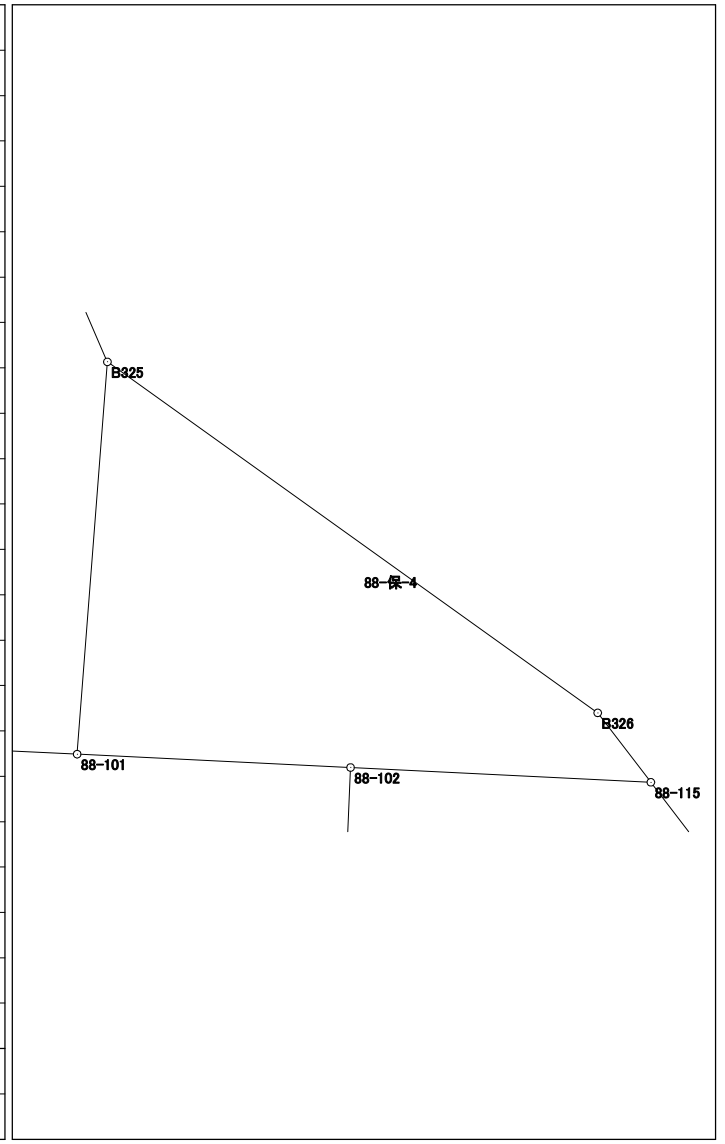

倍面積	34.764244
面積	17.3821220

面積計算書（座標法）

世界測地系（測地成果2011）

所 在	地 番	公簿地目	現況地目	地 積	所 有 者
前橋市天川原町一丁目	88-保-5			68.00 m ²	

点 名	X 座 標	Y 座 標	辺 長	方 向 角	測 角	DX	倍 積 (Y×DX)
88-115	41515.413	-67379.642	3.609	272-48-39	130-15-07	1.722	-116027.743524
88-102	41515.590	-67383.247	10.800	182-25-50	89-37-11	-10.613	715138.400411
88-103	41504.800	-67383.705	1.641	272-26-39	270-00-49	-10.720	722353.317600
88-104	41504.870	-67385.345	3.132	182-26-02	89-59-23	-3.059	206131.770355
88-105	41501.741	-67385.478	3.639	92-50-06	90-24-04	-3.309	222978.546702
88-6	41501.561	-67381.843	3.992	48-21-03	135-30-57	2.473	-166635.297739
88-5	41504.214	-67378.860	9.662	2-22-43	134-01-40	12.307	-829231.630020
88-4	41513.868	-67378.459	1.946	322-33-32	140-10-49	11.199	-754571.362341
						倍面積	136.001444
						面 積	68.0007220

