



9 1 街区 画地出来形確認図 (1816.77m²)

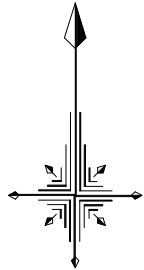

S=1/500

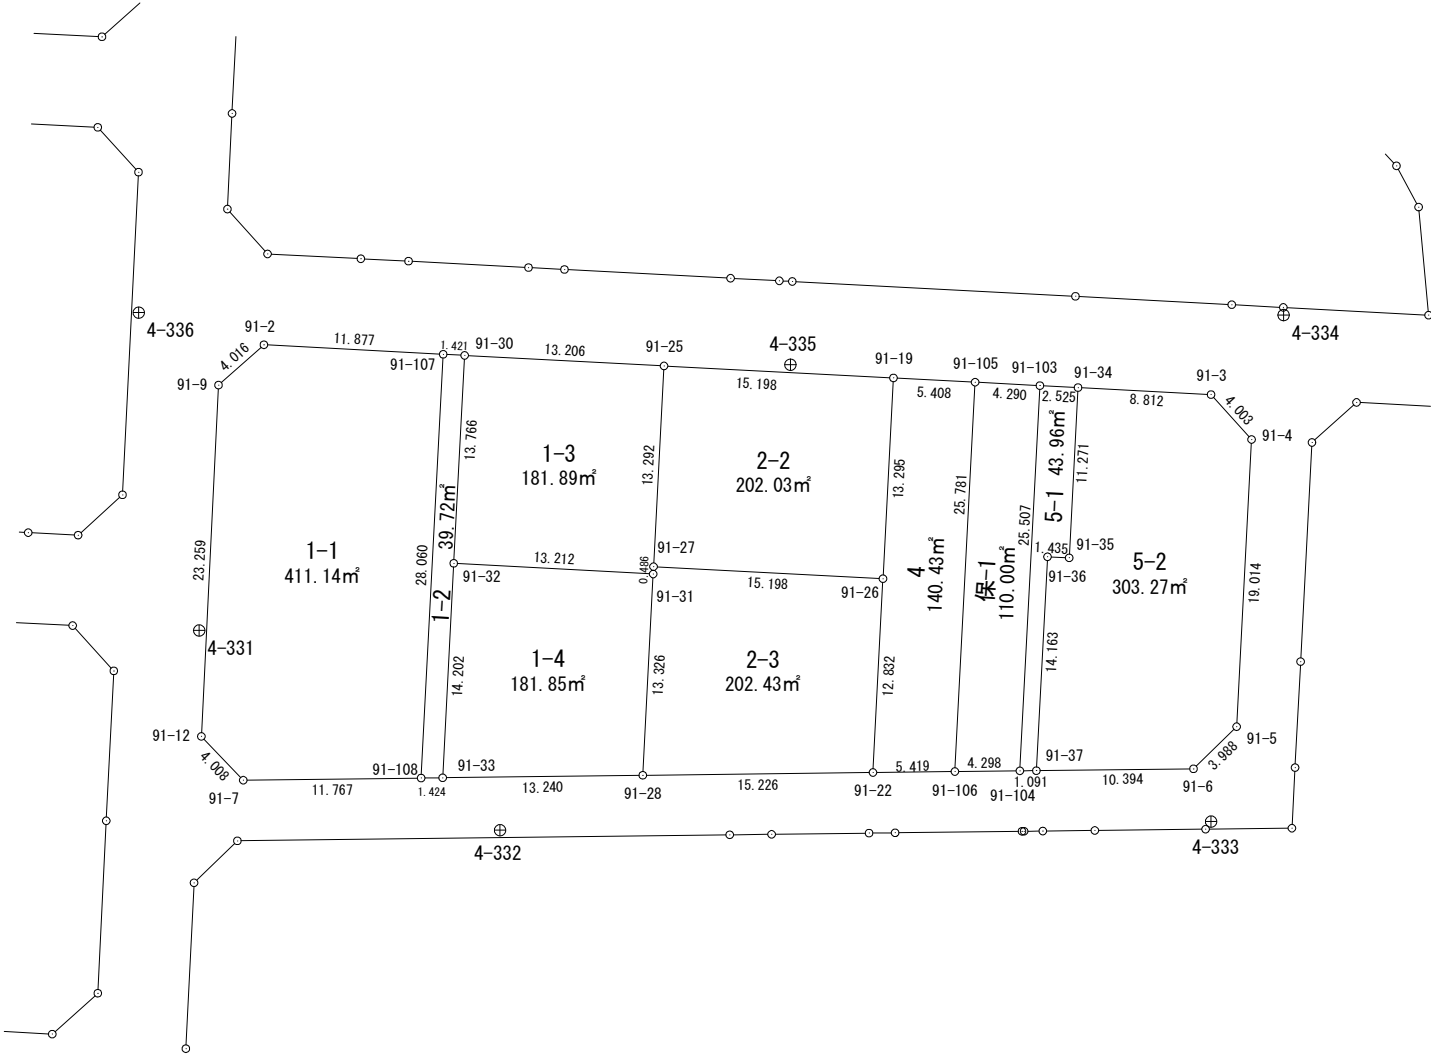


面積計算書 (座標法)

世界測地系 (測地成果2011)

所在	地番	公簿地目	現況地目	地積	所有者
前橋市六供町四丁目	91-1-1			411.14 m ²	

点名	X座標	Y座標	辺長	方向角	測角	DX	倍積 (Y×DX)
91-107	41397.377	-67397.980	11.877	273-02-26	90-03-29	28.652	-1931086.922960
91-2	41398.007	-67409.840	4.016	228-22-55	135-20-29	-2.037	137313.844080
91-9	41395.340	-67412.842	23.259	182-47-32	134-24-37	-25.898	1745857.782116
91-12	41372.109	-67413.975	4.008	136-18-14	133-30-42	-26.129	1761459.752775
91-7	41369.211	-67411.206	11.767	89-17-56	132-59-42	-2.754	185650.461324
91-108	41369.355	-67399.440	28.060	2-58-57	93-41-01	28.166	-1898372.627040
						倍面積	822.290295
						面積	411.1451475

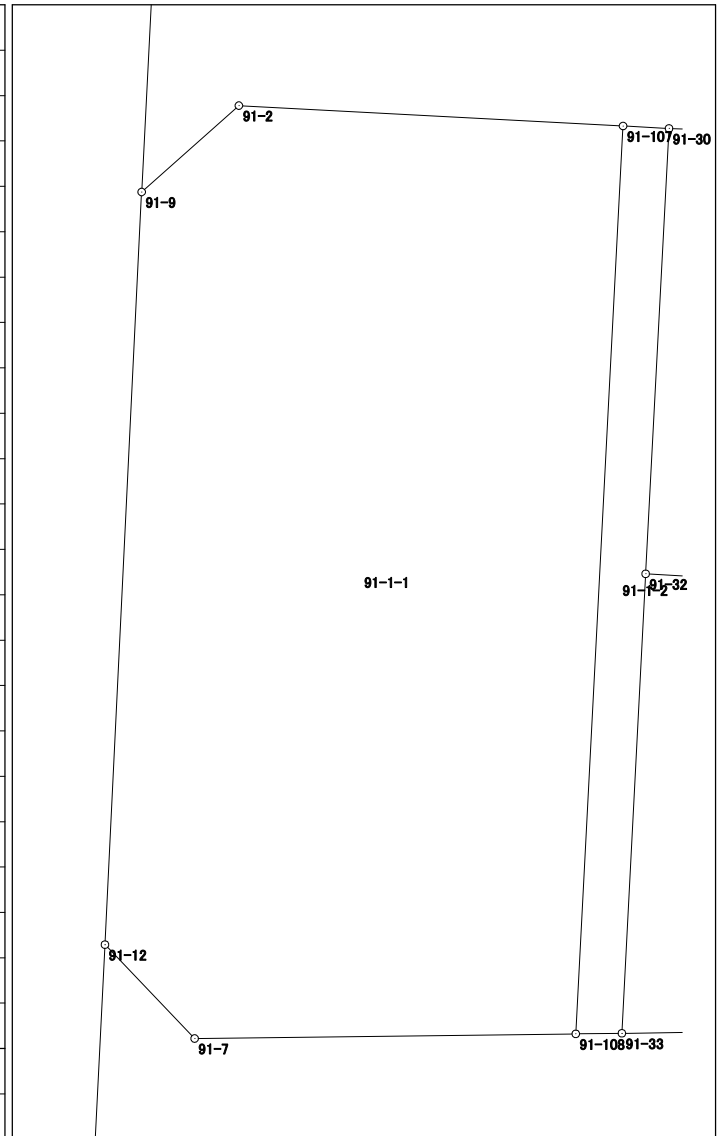


面積計算書（座標法）

世界測地系（測地成果2011）

所 在	地 番	公簿地目	現況地目	地 積	所 有 者
前橋市六供町四丁目	91-1-2			39.72 m ²	

点 名	X 座標	Y 座標	辺 長	方 向 角	測 角	DX	倍 積 (Y×DX)
91-30	41397.302	-67396.561	1.421	273-01-32	90-01-09	13.822	-931555.266142
91-107	41397.377	-67397.980	28.060	182-58-57	89-57-25	-27.947	1883571.347060
91-108	41369.355	-67399.440	1.424	89-18-58	86-20-01	-28.005	1887521.317200
91-33	41369.372	-67398.016	14.202	2-57-31	93-38-33	14.200	-957051.827200
91-32	41383.555	-67397.283	13.766	3-00-23	180-02-52	27.930	-1882406.114190
						倍面積	79.456728
						面 積	39.7283640

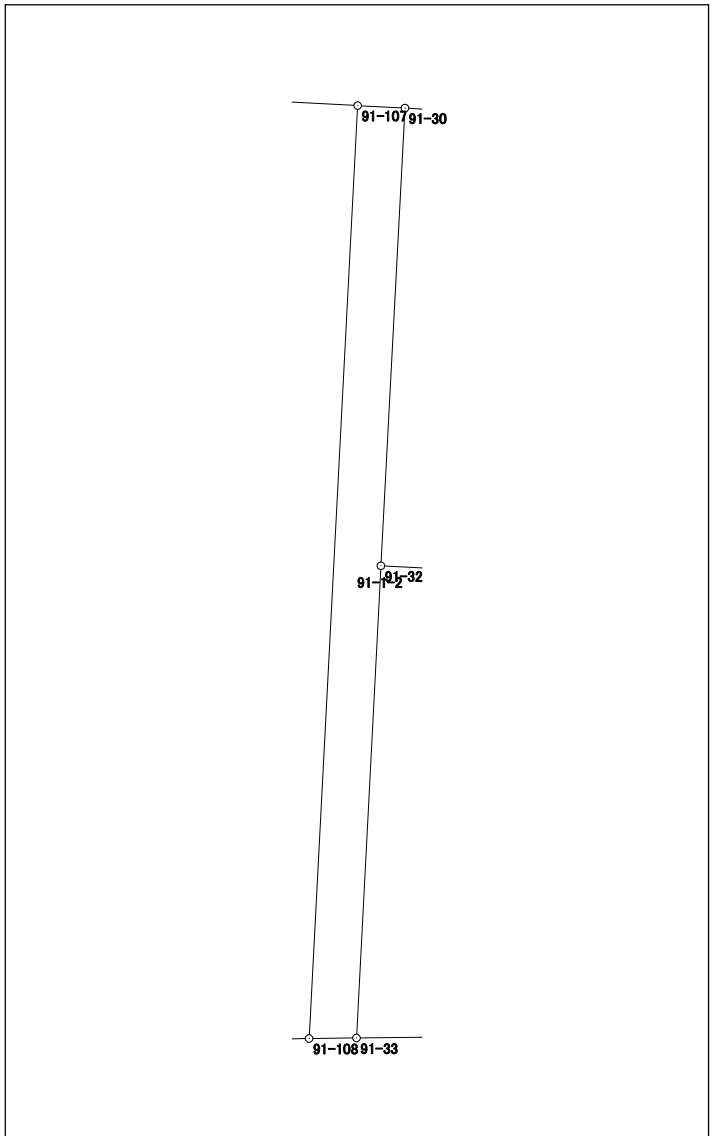

面積計算書（座標法）

世界測地系（測地成果2011）

所 在	地 番	公簿地目	現況地目	地 積	所 有 者
前橋市六供町四丁目	91-2-3			202.43 m ²	


点 名	X 座標	Y 座標	辺 長	方 向 角	測 角	DX	倍 積 (Y×DX)		
91-27	41383.332	-67384.068	0.486	182-35-31	89-35-36	0.309	-20821.677012		
91-31	41382.846	-67384.090	13.326	182-57-19	180-21-48	-13.794	929496.137460		
91-28	41369.538	-67384.777	15.226	89-18-27	86-21-08	-13.124	884357.813348		
91-22	41369.722	-67369.552	12.832	2-57-10	93-38-43	12.999	-875736.806448		
91-26	41382.537	-67368.891	15.198	272-59-55	90-02-45	13.610	-916890.606510		
							倍面積		404.860838
							面 積		202.4304190

面積計算書 (座標法)

世界測地系 (測地成果2011)

所在	地番	公簿地目	現況地目	地積	所有者
前橋市六供町四丁目	91-4			140.43 m ²	

点名	X座標	Y座標	辺長	方向角	測角	DX	倍積 (Y×DX)
91-105	41395.530	-67362.795	5.408	273-00-36	90-02-06	26.030	-1753453.553850
91-19	41395.814	-67368.196	13.295	182-59-47	89-59-11	-12.993	875314.970628
91-26	41382.537	-67368.891	12.832	182-57-10	179-57-23	-26.092	1757789.103972
91-22	41369.722	-67369.552	5.419	89-20-40	86-23-30	-12.753	859163.896656
91-106	41369.784	-67364.133	25.781	2-58-30	93-37-50	25.808	-1738533.544464
						倍面積	280.872942
						面積	140.4364710

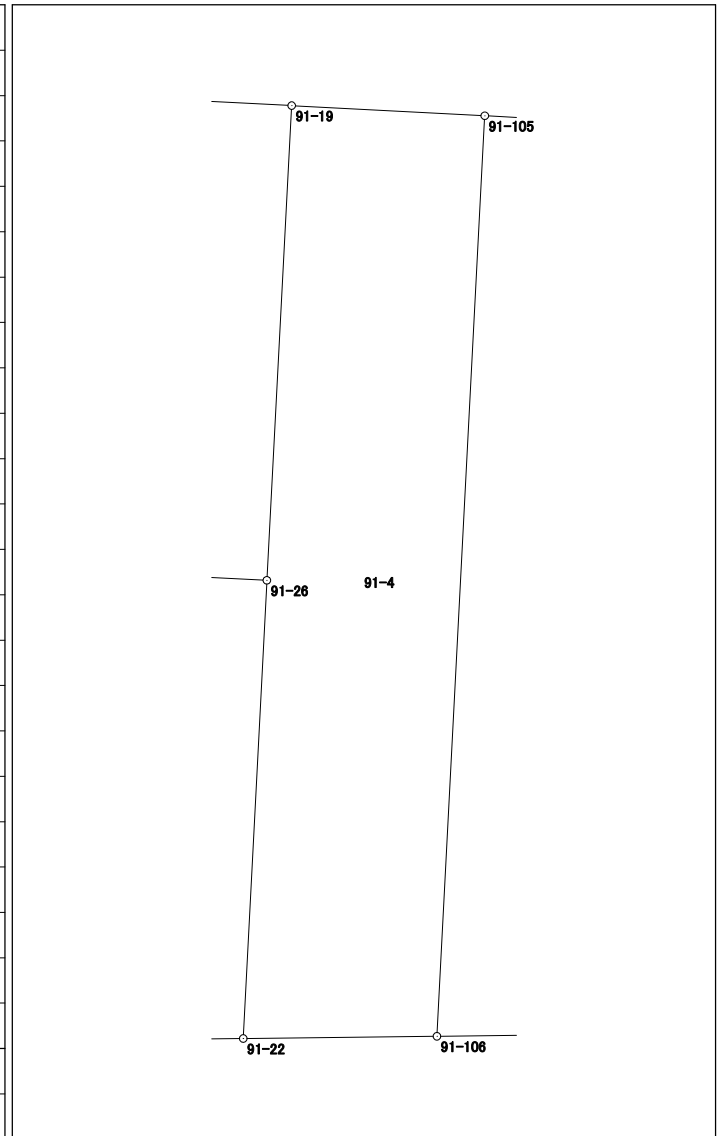

面積計算書（座標法）

世界測地系（測地成果2011）

所 在	地 番	公簿地目	現況地目	地 積	所 有 者
前橋市六供町四丁目	91-5-1			43.96 m ²	

点 名	X 座標	Y 座標	辺 長	方 向 角	測 角	DX	倍 積 (Y×DX)
91-103	41395.306	-67358.511	25.507	182-58-31	89-58-45	-25.341	1706932.027251
91-104	41369.833	-67359.835	1.091	89-31-38	86-33-07	-25.464	1715250.838440
91-37	41369.842	-67358.744	14.163	2-59-13	93-27-35	14.153	-953328.303832
91-36	41383.986	-67358.006	1.435	92-43-01	269-43-48	14.076	-948131.292456
91-35	41383.918	-67356.573	11.271	2-58-12	90-15-11	11.188	-753585.338724
91-34	41395.174	-67355.989	2.525	272-59-46	90-01-34	11.388	-767050.002732
						倍面積	87.927947
						面 積	43.9639735

