


計画図

図 2

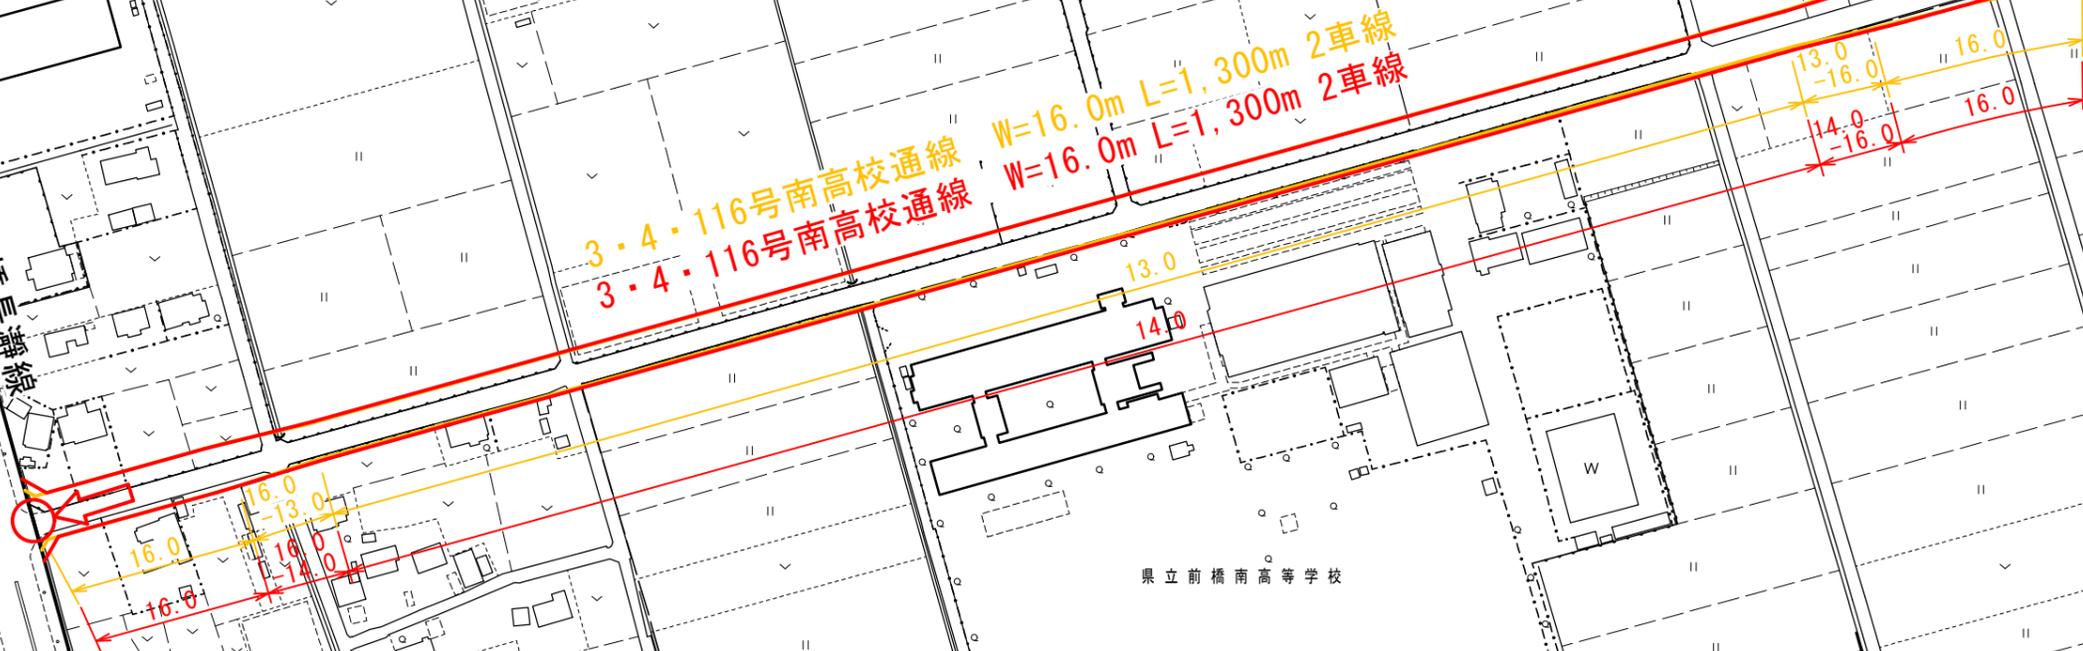

S=1:2,500 (A3)
0 10 50 100m



凡例

	変更前
	変更後
	変更しない区間