


令和2年11月5日現在

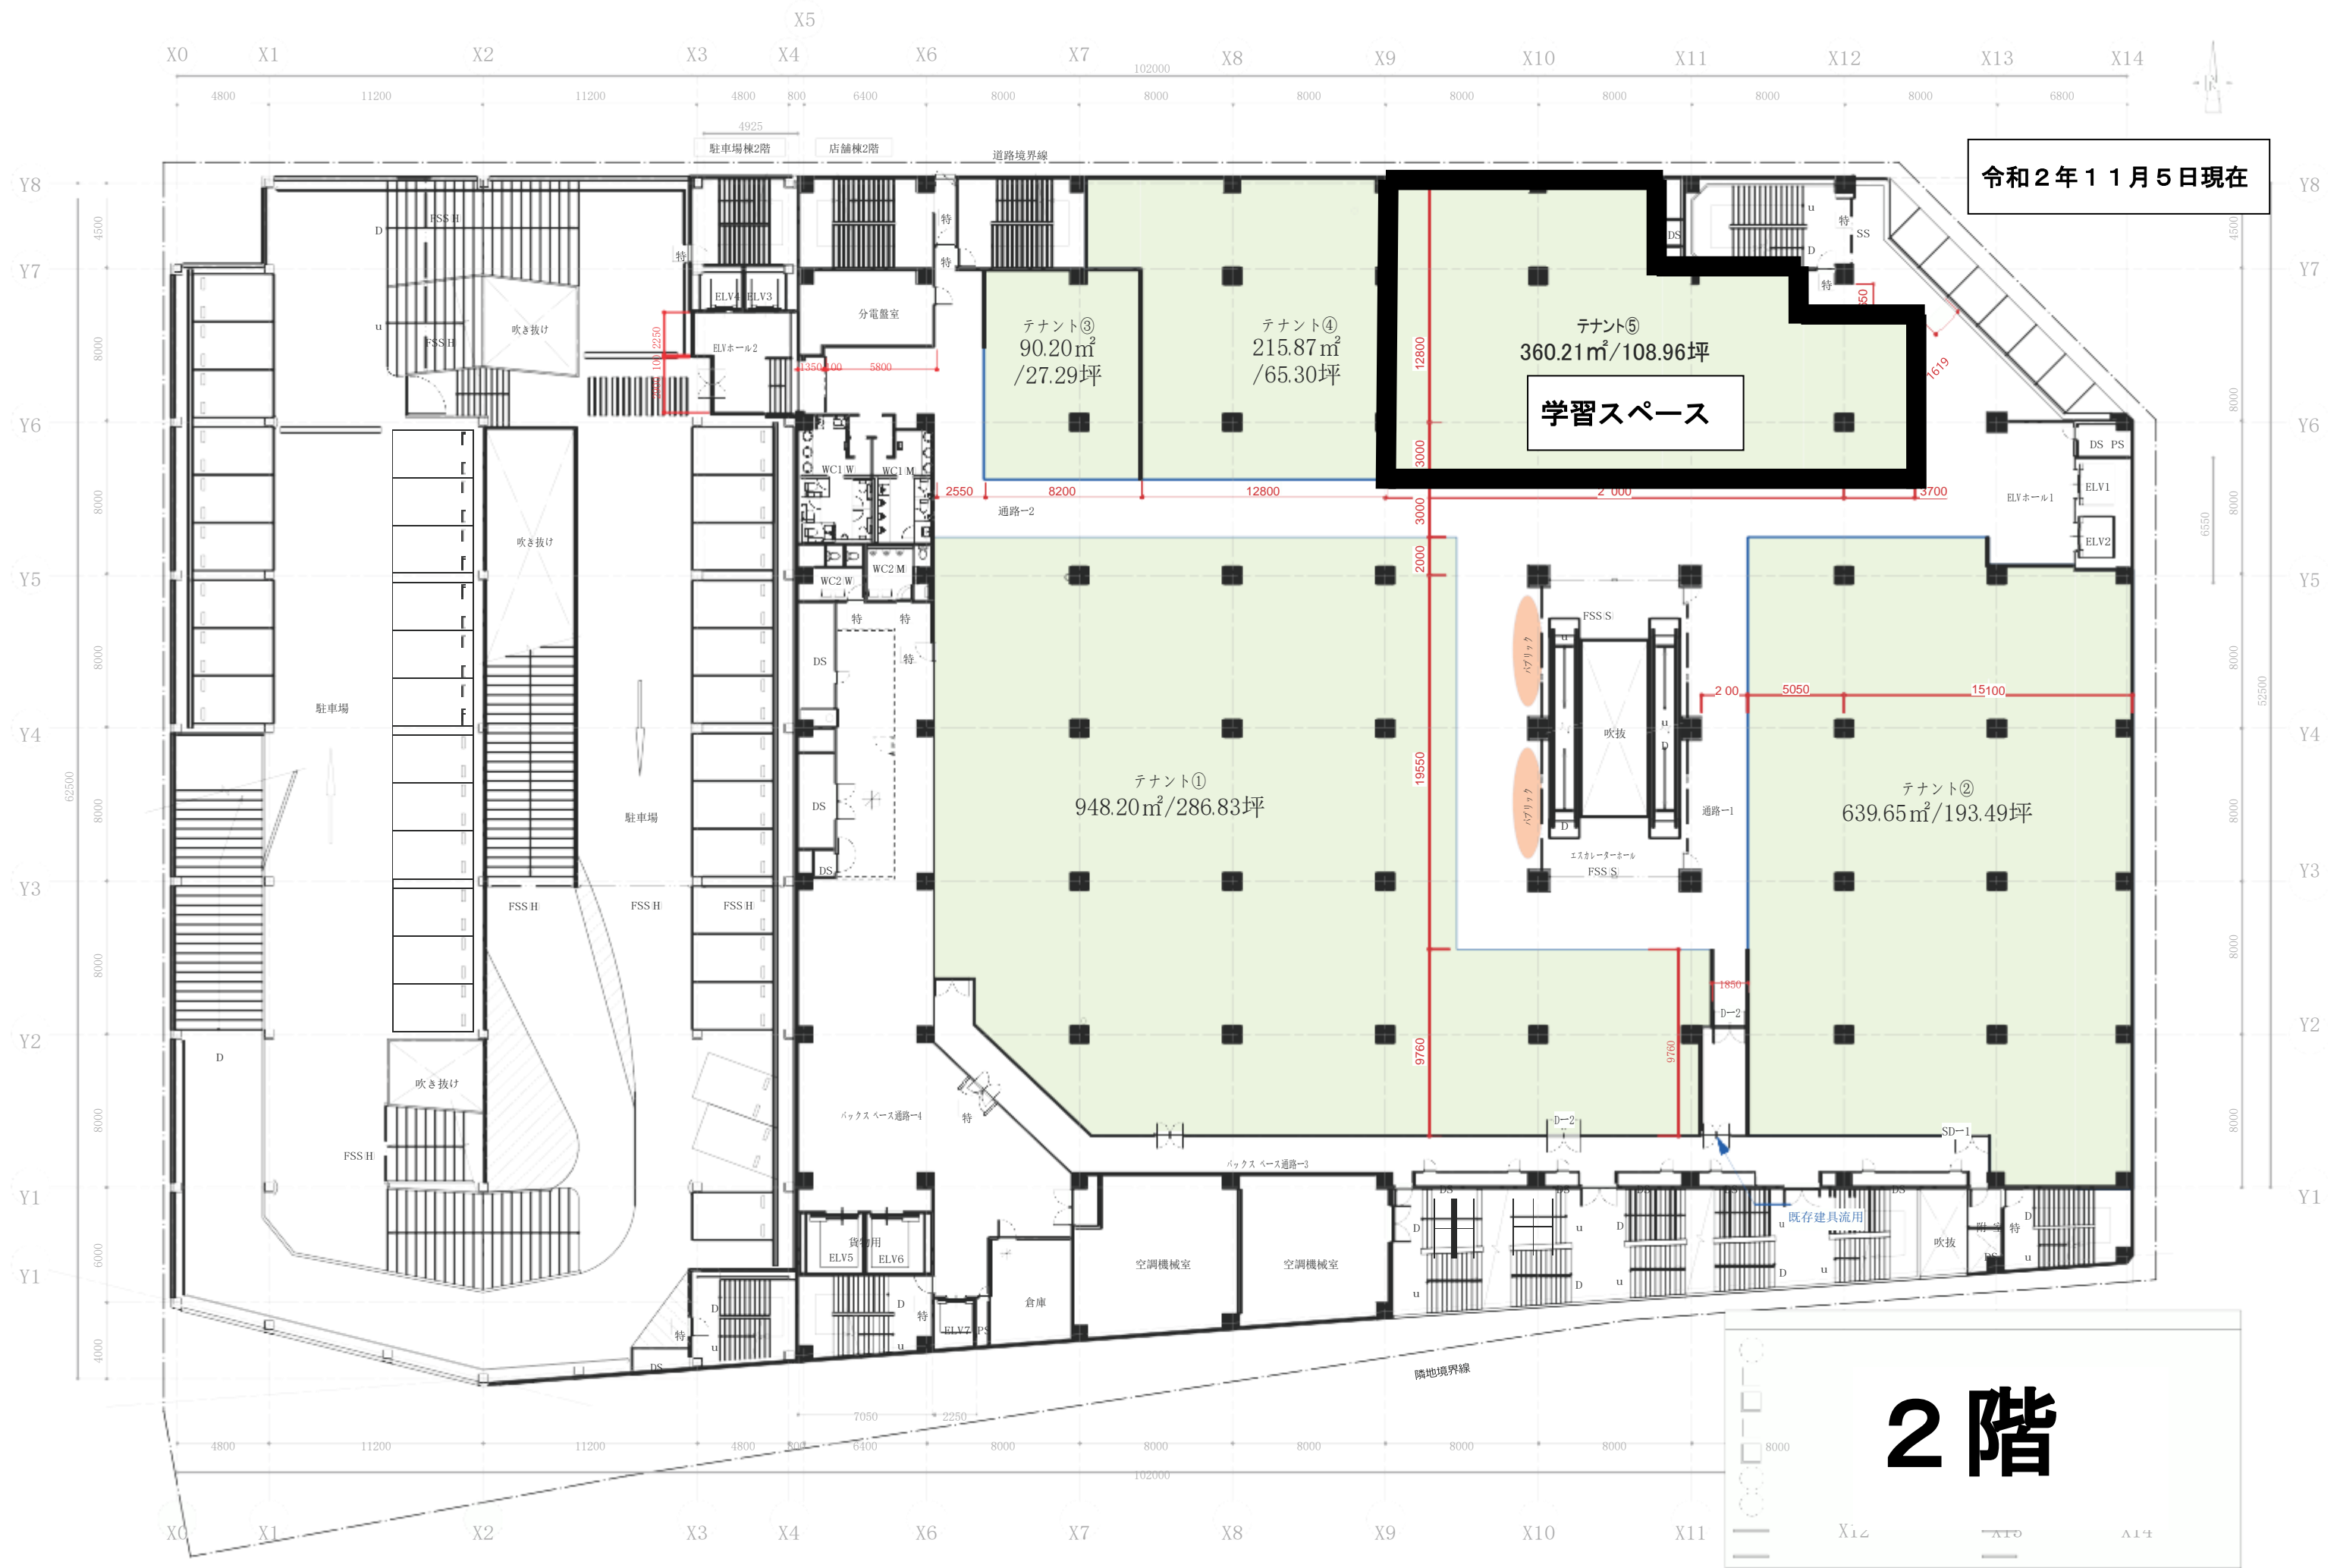

2階

