


既設電路

S=1/500

- 埋設電路_高圧幹線
- 埋設電路_施工図ルートと一致(ただし増改築あり)
- 埋設電路_図面と現地不整合の疑いあり
- 電気ハンドホール

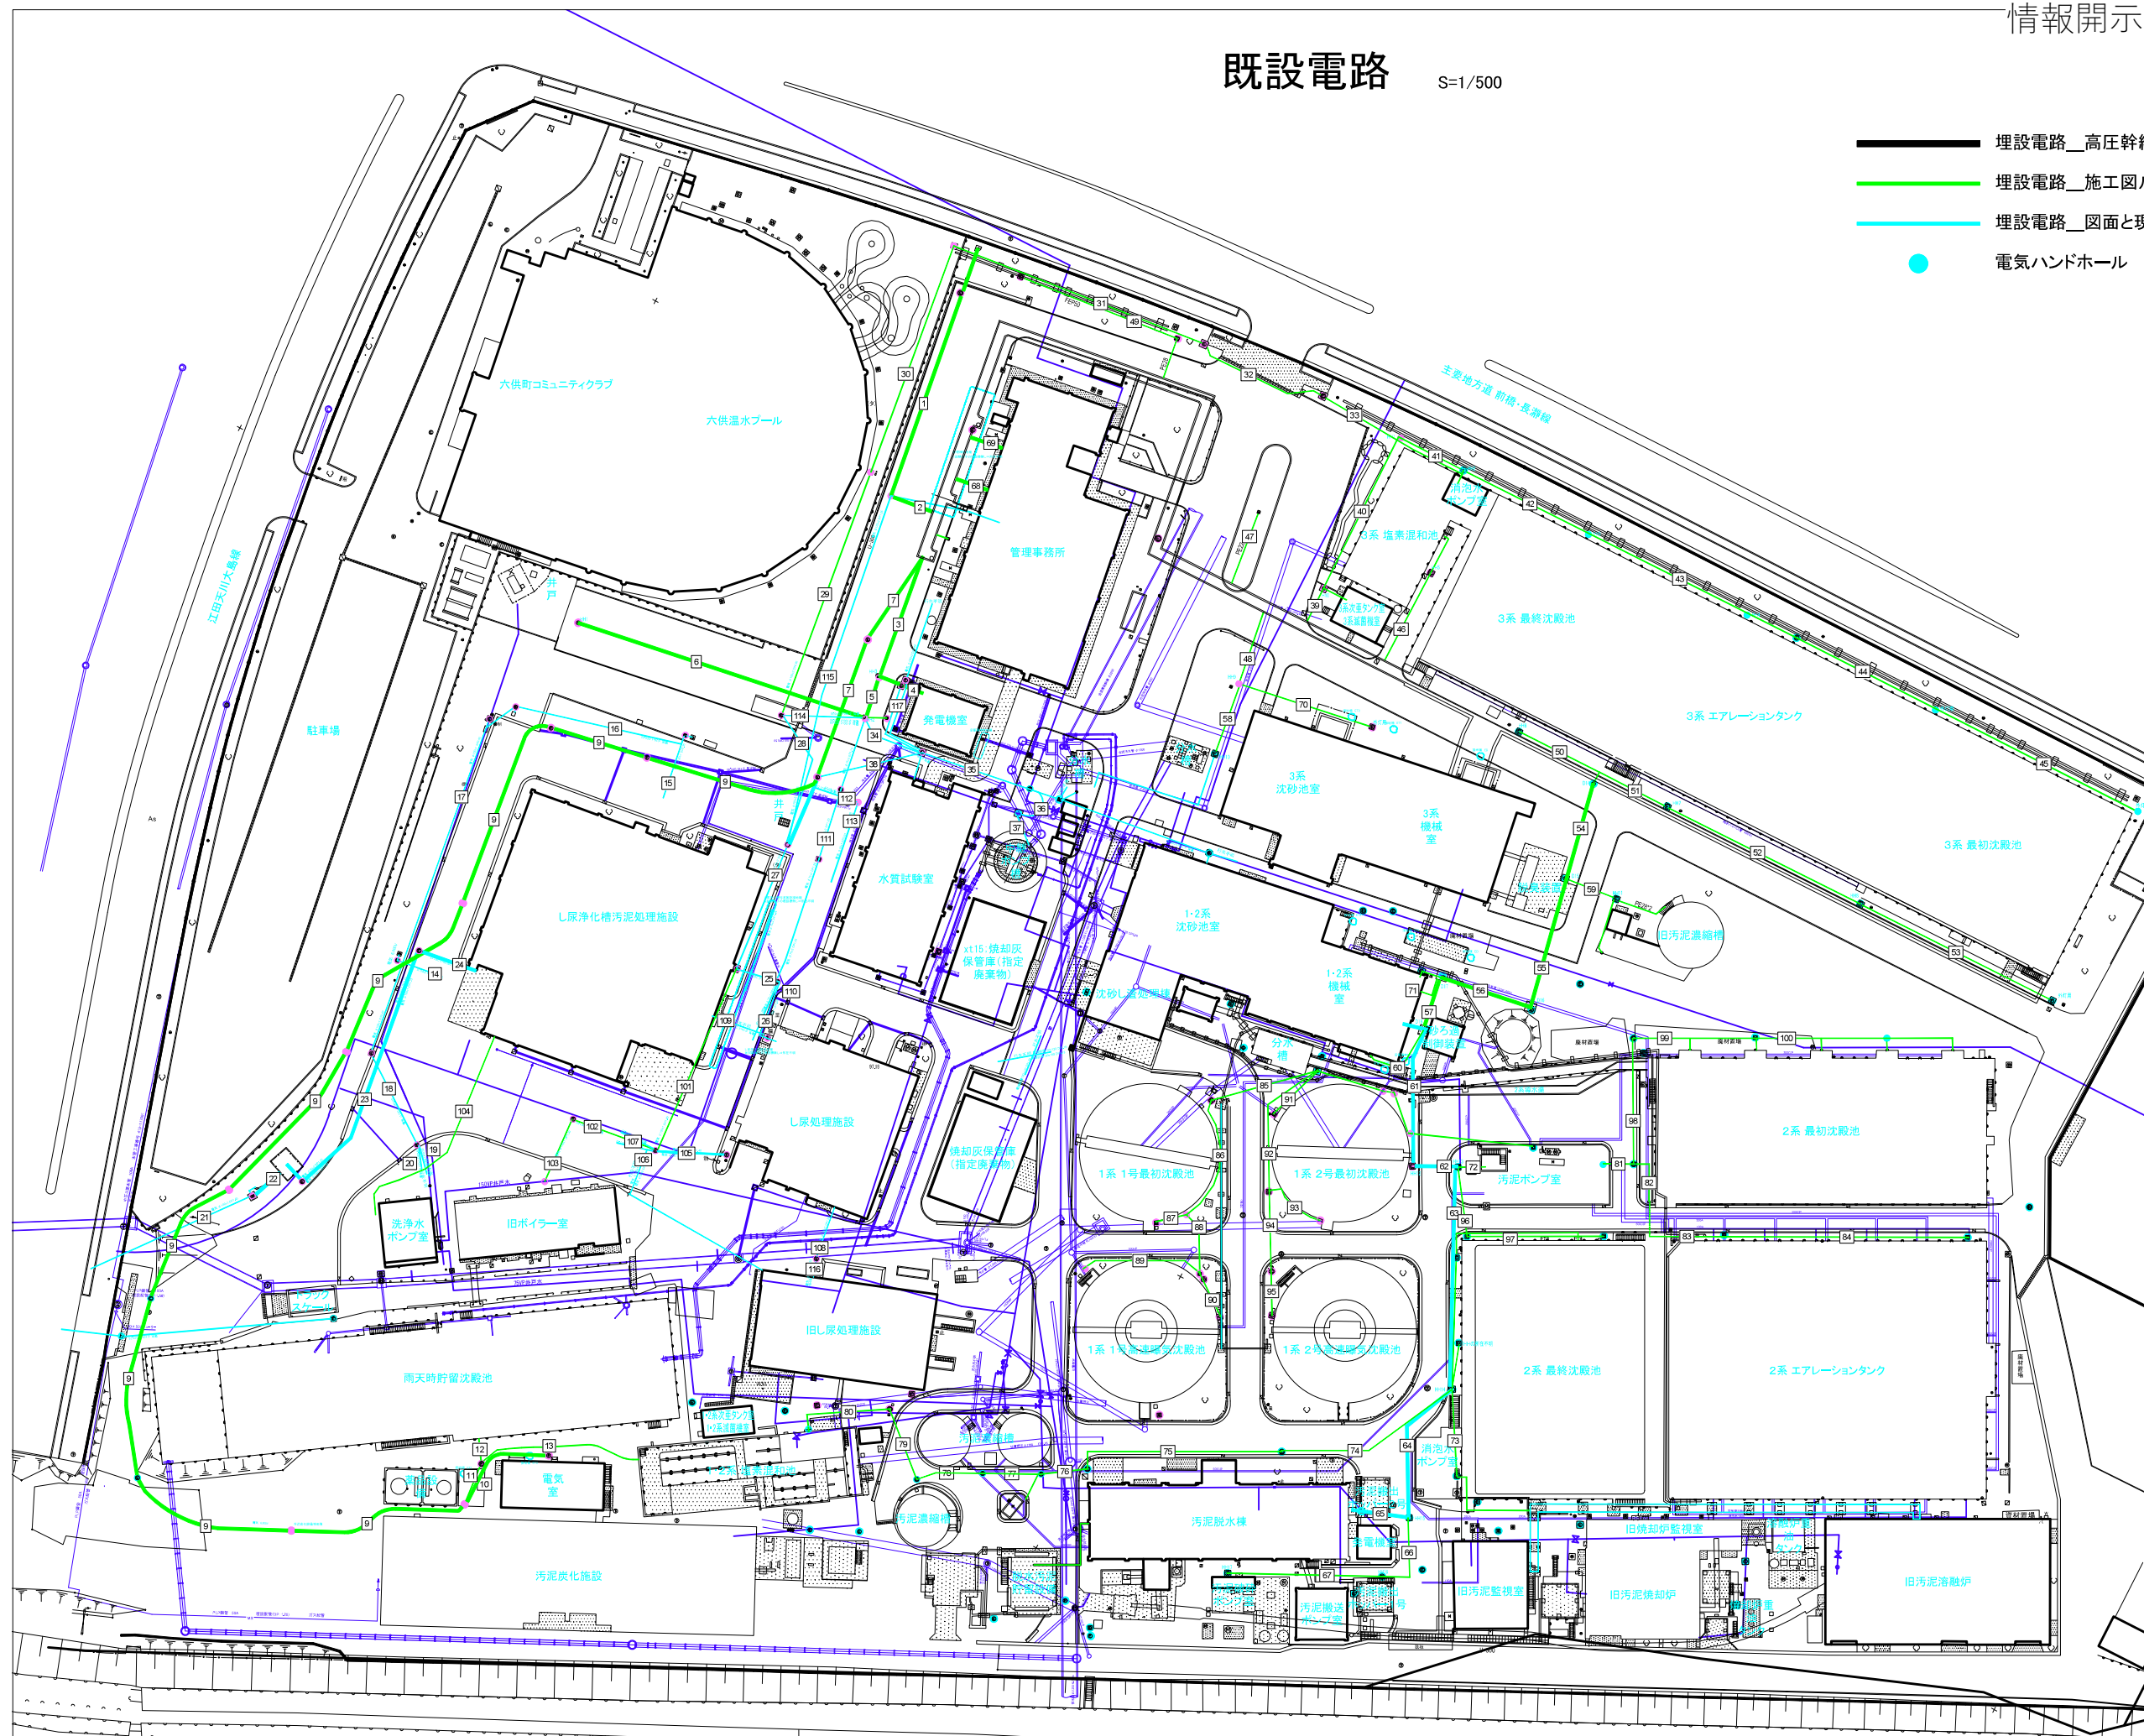

埋設管情報 ※線は現地不整合の疑いあり												
FEP	400V	200	150	125	100	80	65	50	40	30	1.8	
1	1200											
2	1200	1	4									E1-2186
3	1000		2	3			2	1				E1-2449
4	800											E1-2186
5	1200	1	2	1			2	1				E1-2186
6	1200		1	1								E1-2186
7	800		1	1	2	2		1				E1-2449
8	800											E1-2186
9	800		3	2	2	2						E1-2449
10	800		1	2	1							E1-2449
11	800		1	2	2	2						E1-2449
12	800		2	1	1	1						E1-2449
13	800		2	1	1	2						E1-2449
14	800											E1-2186
15	800											E1-2186
16	800											E1-2186
17	800											E1-2186
18	800											E1-2186
19	800											E1-2186
20	800											E1-2186
21	1200											E1-2186
22	1200											E1-2186
23	1200											E1-2186
24	1200											E1-2186
25	1200											E1-2186
26	1200											E1-2186
27	1200											E1-2186
28	1200											E1-2186
29	800											E1-2186
30	800											E1-2186
31	800											E1-2186
32	1200											E1-2186
33	1200											E1-2186
34	1000											E1-2449
35	1000											E1-2449
36	1000											E1-2449
37	800											E1-2186
38	800											E1-2186
39	800											E1-2186
40	800											E1-2186
41	800											E1-2186
42	800											E1-2186
43	800											E1-2186
44	800											E1-2186
45	800											E1-2186
46	800											E1-2186
47	800											E1-2186
48	800											E1-2186
49	800											E1-2186
50	800											E1-2186
51	800											E1-2186
52	800											E1-2186
53	800											E1-2186
54	1200											E1-2186
55	1200											E1-2186
56	800											E1-2186
57	800											E1-2186
58	800											E1-2186
59	1200											E1-2186
60	800											E1-2186
61	800											E1-2186
62	800											E1-2186
63	800											E1-2186
64	800											E1-2186
65	800											E1-2186
66	800											E1-2186
67	800											E1-2186
68	800											E1-2186
69	800											E1-2186
70	800											E1-2186
71	800											E1-2186
72	800											E1-2186
73	800											E1-2186
74	1200											E1-2186
75	1200											E1-2186
76	800											E1-2186
77	750											E1-2186
78	750											E1-2186
79	800											E1-2186
80	400											E1-2186
81	800											E1-2186
82	800											E1-2186
83	800											E1-2186
84	1200											E1-2186
85	800											E1-2186
86	800											E1-2186
87	800											E1-2186
88	800											E1-2186
89	800											E1-2186
90	800											E1-2186
91	800											E1-2186
92	800											E1-2186
93	800											E1-2186
94	800											E1-2186
95	800											E1-2186
96	800											E1-2186
97	800											E1-2186
98	800											E1-2186
99	800											E1-2186
100	800											E1-2186
101	800											E1-2186
102	800											E1-2186
103	800											E1-2186
104	800											E1-2186
105	800											E1-2186
106	800											E1-2186
107	800											E1-2186
108	800											E1-2186
109	800											E1-2186
110	800											E1-2186
111	1200											E1-2186
112	800											E1-2186
113	800											E1-2186
114	800											E1-2186
115	1200											E1-2186
116	800											E1-2186
117	800											E1-2186

